


CONTRACTORS SHALL VERIFY DIMENSIONS BEFORE ANY JOB COMMENCES. ALL SHOP DRAWINGS SHALL BE SUBMITTED TO THE SUPERINTENDENT AND MANUFACTURER SHALL NOT COMMENCE PRIOR TO THE RETURN OF APPROVED SHOP DRAWINGS. BY THE CONSULTANT. FIGURED DIMENSIONS SHALL TAKE PRECEDENCE OVER SCALES. THIS DRAWING SHOULD BE READ IN CONJUNCTION WITH ALL RELEVANT CONTRACT SPECIFICATIONS AND DRAWINGS COPYRIGHT OF THIS DRAWING IS VESTED IN HANDLE.

General Notes

REFER ARCHITECTURAL DRAWINGS:

FAÇADE SETOUT	AR1502-AR1507
PRECAST SETOUT	AR1512-AR1517
SCREEN SETOUT	AR1502-AR1507
SCREEN DETAILS	AR6500-AR6504

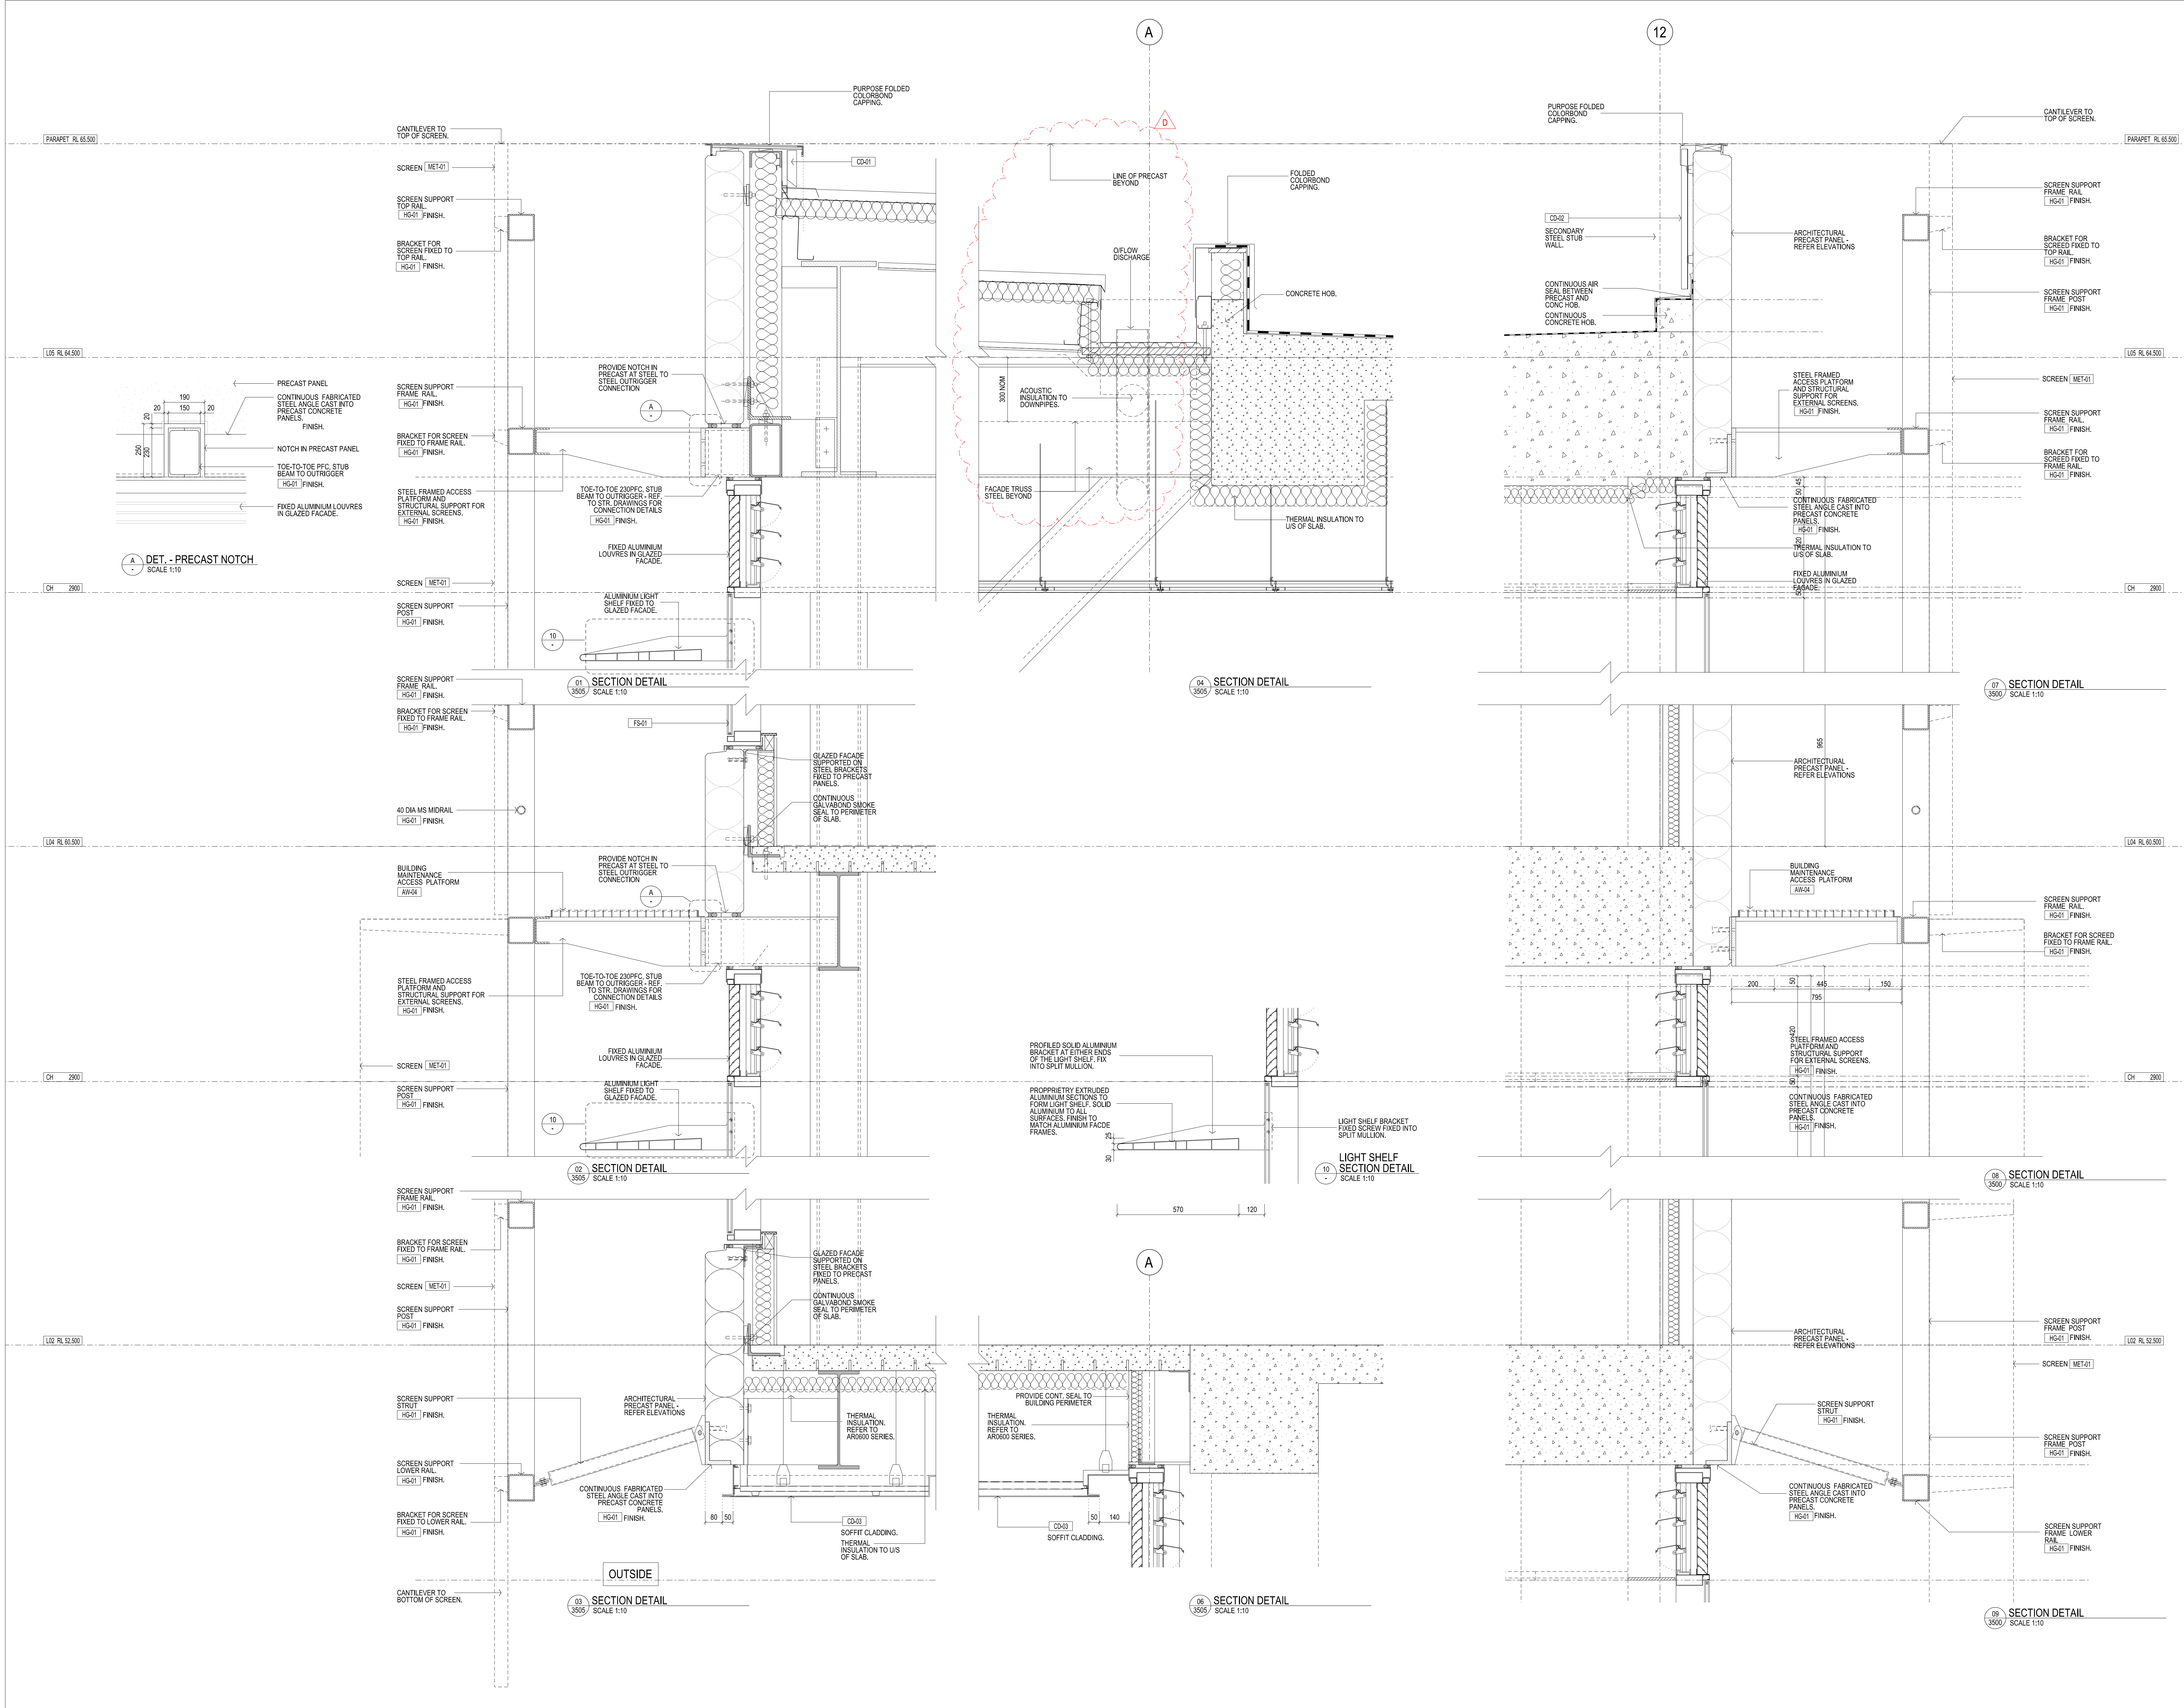

Rev	Issue	Revision Description	And	Date
D	SG	O/FLOW DETAIL ADDED		10.10.13
C	SG	DET 10 AMENDED, EXT STEEL FINISHES HG-01.		23.09.13
B	SG	UPDATES AS CLOUDED		20.09.13
A	SG	LIGHT SHELF DETAIL 10 ADDED.		21.08.13
		REV. TO SUIT STR. DETAIL @ OUTRIGGER CAPINGS AND PARAPET CLADDINGS AMENDED.		
07	SG	TENDER ISSUE		16.04.13
06	SG	VALUE MANAGEMENT ISSUE		28.03.13
05	SG	PRECAST REVIEW		21.03.13
04	SG	100% CD - TENDER ISSUE		07.09.12
03	SG	90% CD ISSUE		10.08.12
02	SG	75% CD ISSUE		13.07.12
01	SG	55% CD ISSUE		08.06.12



NADAAA
 NADAAA
 1520 Washington Street No.2 Boston Massachusetts 02118 USA
 Telephone +1 817 442 8232 Facsimile +1 888 442 1417 Email nad@nadaaa.com

John Wardle Architects
 25 Rokeby Street, Collingwood, Victoria 3066 Australia
 Tel: +61 3 8662 0400 www.johnwardlearchitects.com
 © 2012 John Wardle Architects ABN 83 006 814 268

Client **University of Melbourne Parkville Campus**
 Project **Faculty of Architecture Building and Planning**

Title **SECTION DETAILS SHEET 15**

Project No.	0913	Scale	1:10 @ A0 1:20 @ A2
Drawing No.	AR6114	Revision	D

Date: Dec 2011 Dwn - Co-Ord - Chk -

FILENAME - \$FILES

FOR CONSTRUCTION