


CONTRACTORS SHALL VERIFY DIMENSIONS BEFORE ANY JOB COMMENCES. ALL SHOP DRAWINGS SHALL BE SUBMITTED TO THE SUPERINTENDENT AND MANUFACTURER SHALL NOT COMMENCE FROM THE RETURN OF DRAWINGS SHOWN. BY THE CONSULTANT FOUR-DIMENSIONAL SHALL TAKE PRECEDENCE OVER SCALED. THIS DRAWING SHALL BE READ IN CONJUNCTION WITH ALL RELEVANT CONTRACT SPECIFICATIONS AND DRAWINGS COPYRIGHT OF THIS DRAWING IS VESTED IN WARDLE

General Notes



Rev	Issue	Revision Description	And	Date
A	SG	ISSUED FOR CONSTRUCTION	-	10.01.14
10	SG	VALUE MANAGEMENT ISSUE	-	28.03.13
09	SG	TENDER ADDENDUM 4	-	08.10.12
08	SG	TENDER ADDENDUM 3	-	02.10.12
07	SG	100% CD - TENDER ISSUE	-	07.09.12
06	SG	90% CD ISSUE	-	10.08.12
05	SG	75% CD ISSUE	-	13.07.12
04	SG	50% CD ISSUE	-	08.06.12
03	SG	25% CD ISSUE	-	20.04.12
02	SG	FINAL CD ISSUE	-	24.02.12
01	SG	DD UPDATE	-	20.01.12

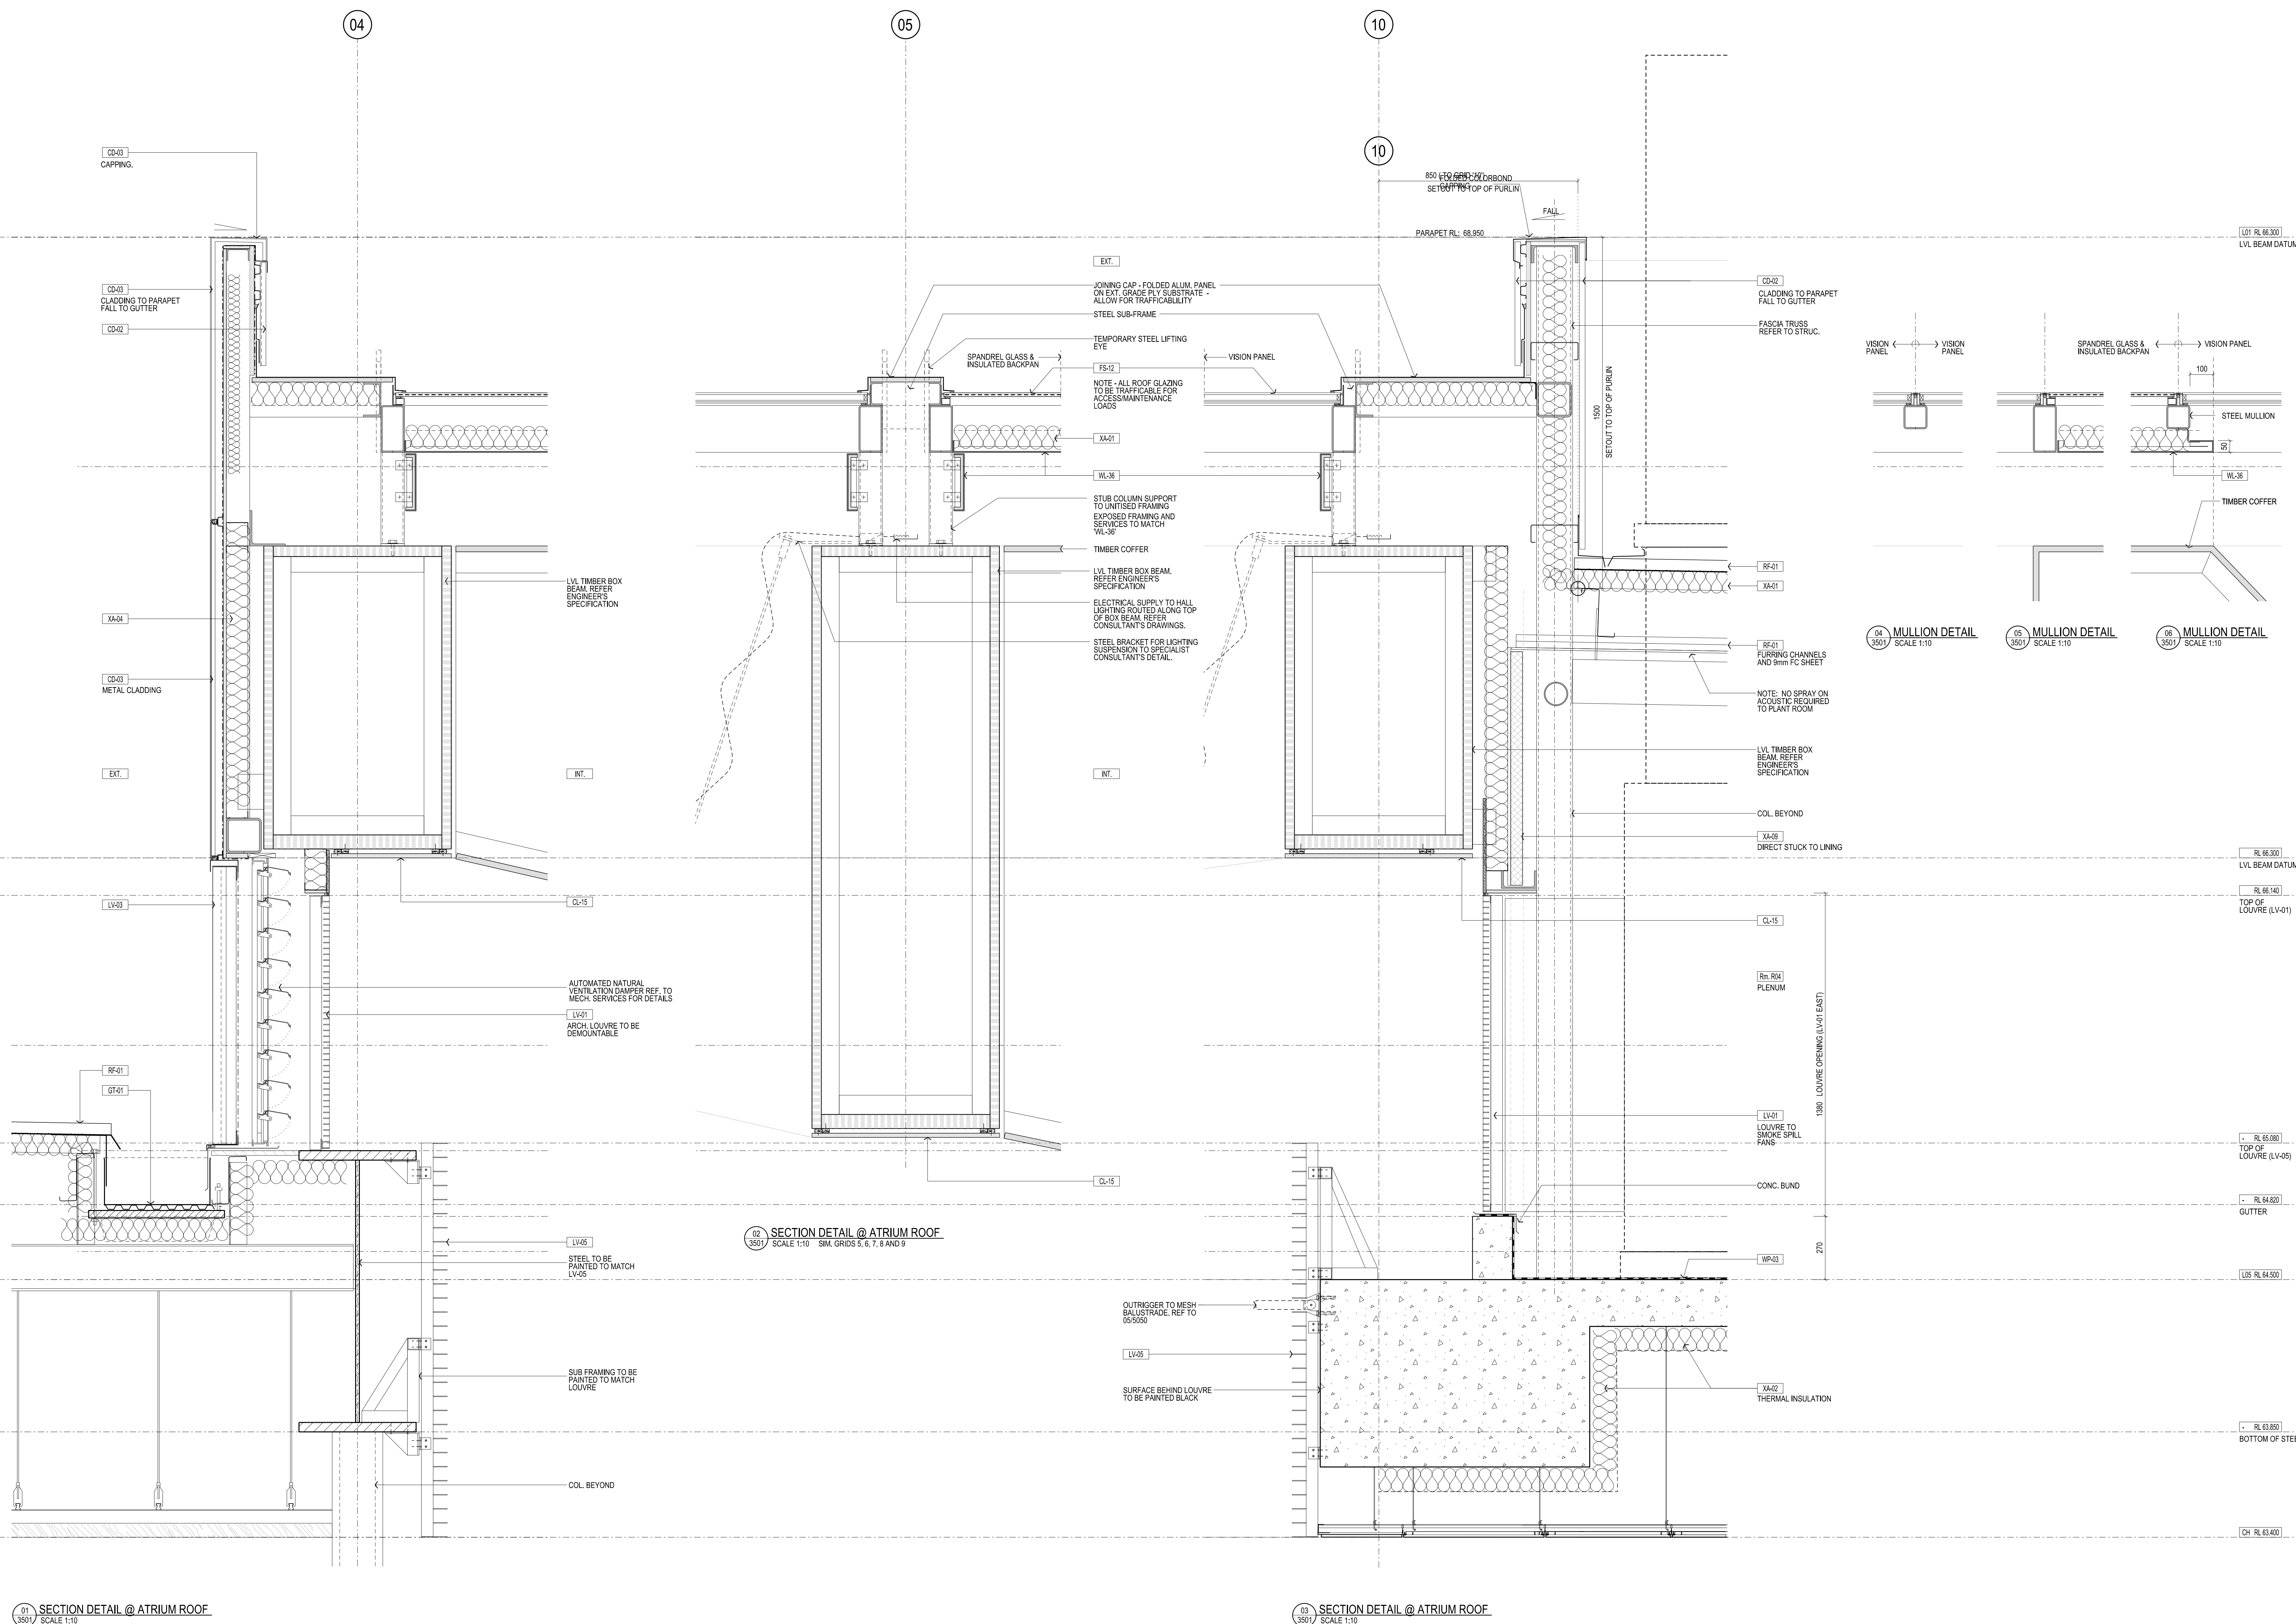

**NADAAA**  
 NADAAA  
 1920 Washington Street No.2 Boston Massachusetts 02118 USA  
 Telephone +1 617 442 8232 Facsimile +1 688 442 1417 Email nadaaa@nadaaa.com

**John Wardle Architects**  
 25 Rokeby Street, Collingwood, Victoria 3066 Australia  
 Tel: +61 3 8662 0400 www.johnwardlearchitects.com  
 © 2012 John Wardle Architects ABN 83 006 814 268

Client **University of Melbourne Parkville Campus**  
 Project **Faculty of Architecture Building and Planning**

Title **ROOF DETAILS ROOF SECTIONS - SHEET 1**

Project No.	<b>0913</b>	Scale	1:10 @ A0 1:20 @ A2
Drawing No.	<b>AR6200</b>	Revision	<b>A</b>

Date: Dec 2011 Dwn - Co-Ord - Chk -

FILENAME - \$FILES

**FOR CONSTRUCTION**

01 SECTION DETAIL @ ATRIUM ROOF SCALE 1:10

02 SECTION DETAIL @ ATRIUM ROOF SCALE 1:10 SIM. GRIDS 5, 6, 7, 8 AND 9

03 SECTION DETAIL @ ATRIUM ROOF SCALE 1:10