


CONTRACTORS SHALL VERIFY JOB DIMENSIONS BEFORE ANY JOB COMMENCES. ALL SHOP DRAWINGS SHALL BE SUBMITTED TO THE SUPERINTENDENT AND MANUFACTURERS SHALL NOT COMMENCE PRIOR TO THE RETURN OF DIMENSIONS SHOP DRAWINGS REVIEWED BY THE CONSULTANT. FOUR-DIGIT DIMENSIONS SHALL TAKE PRECEDENCE OVER SCALED. THIS DRAWING SHOULD BE READ IN CONJUNCTION WITH ALL RELEVANT CONTRACT SPECIFICATIONS AND DRAWINGS COPYRIGHT OF THIS DRAWING IS VESTED IN HANDLE.

General Notes



Rev	Issue	Revision Description	And	Date
B	SG	ISSUE FOR CONSTRUCTION	-	22.10.13
A	SG	VALUE MANAGEMENT ISSUE	-	10.10.13
02	SG	VALUE MANAGEMENT ISSUE	-	28.03.13
01	SG	100% CD - TENDER ISSUE	-	07.09.12

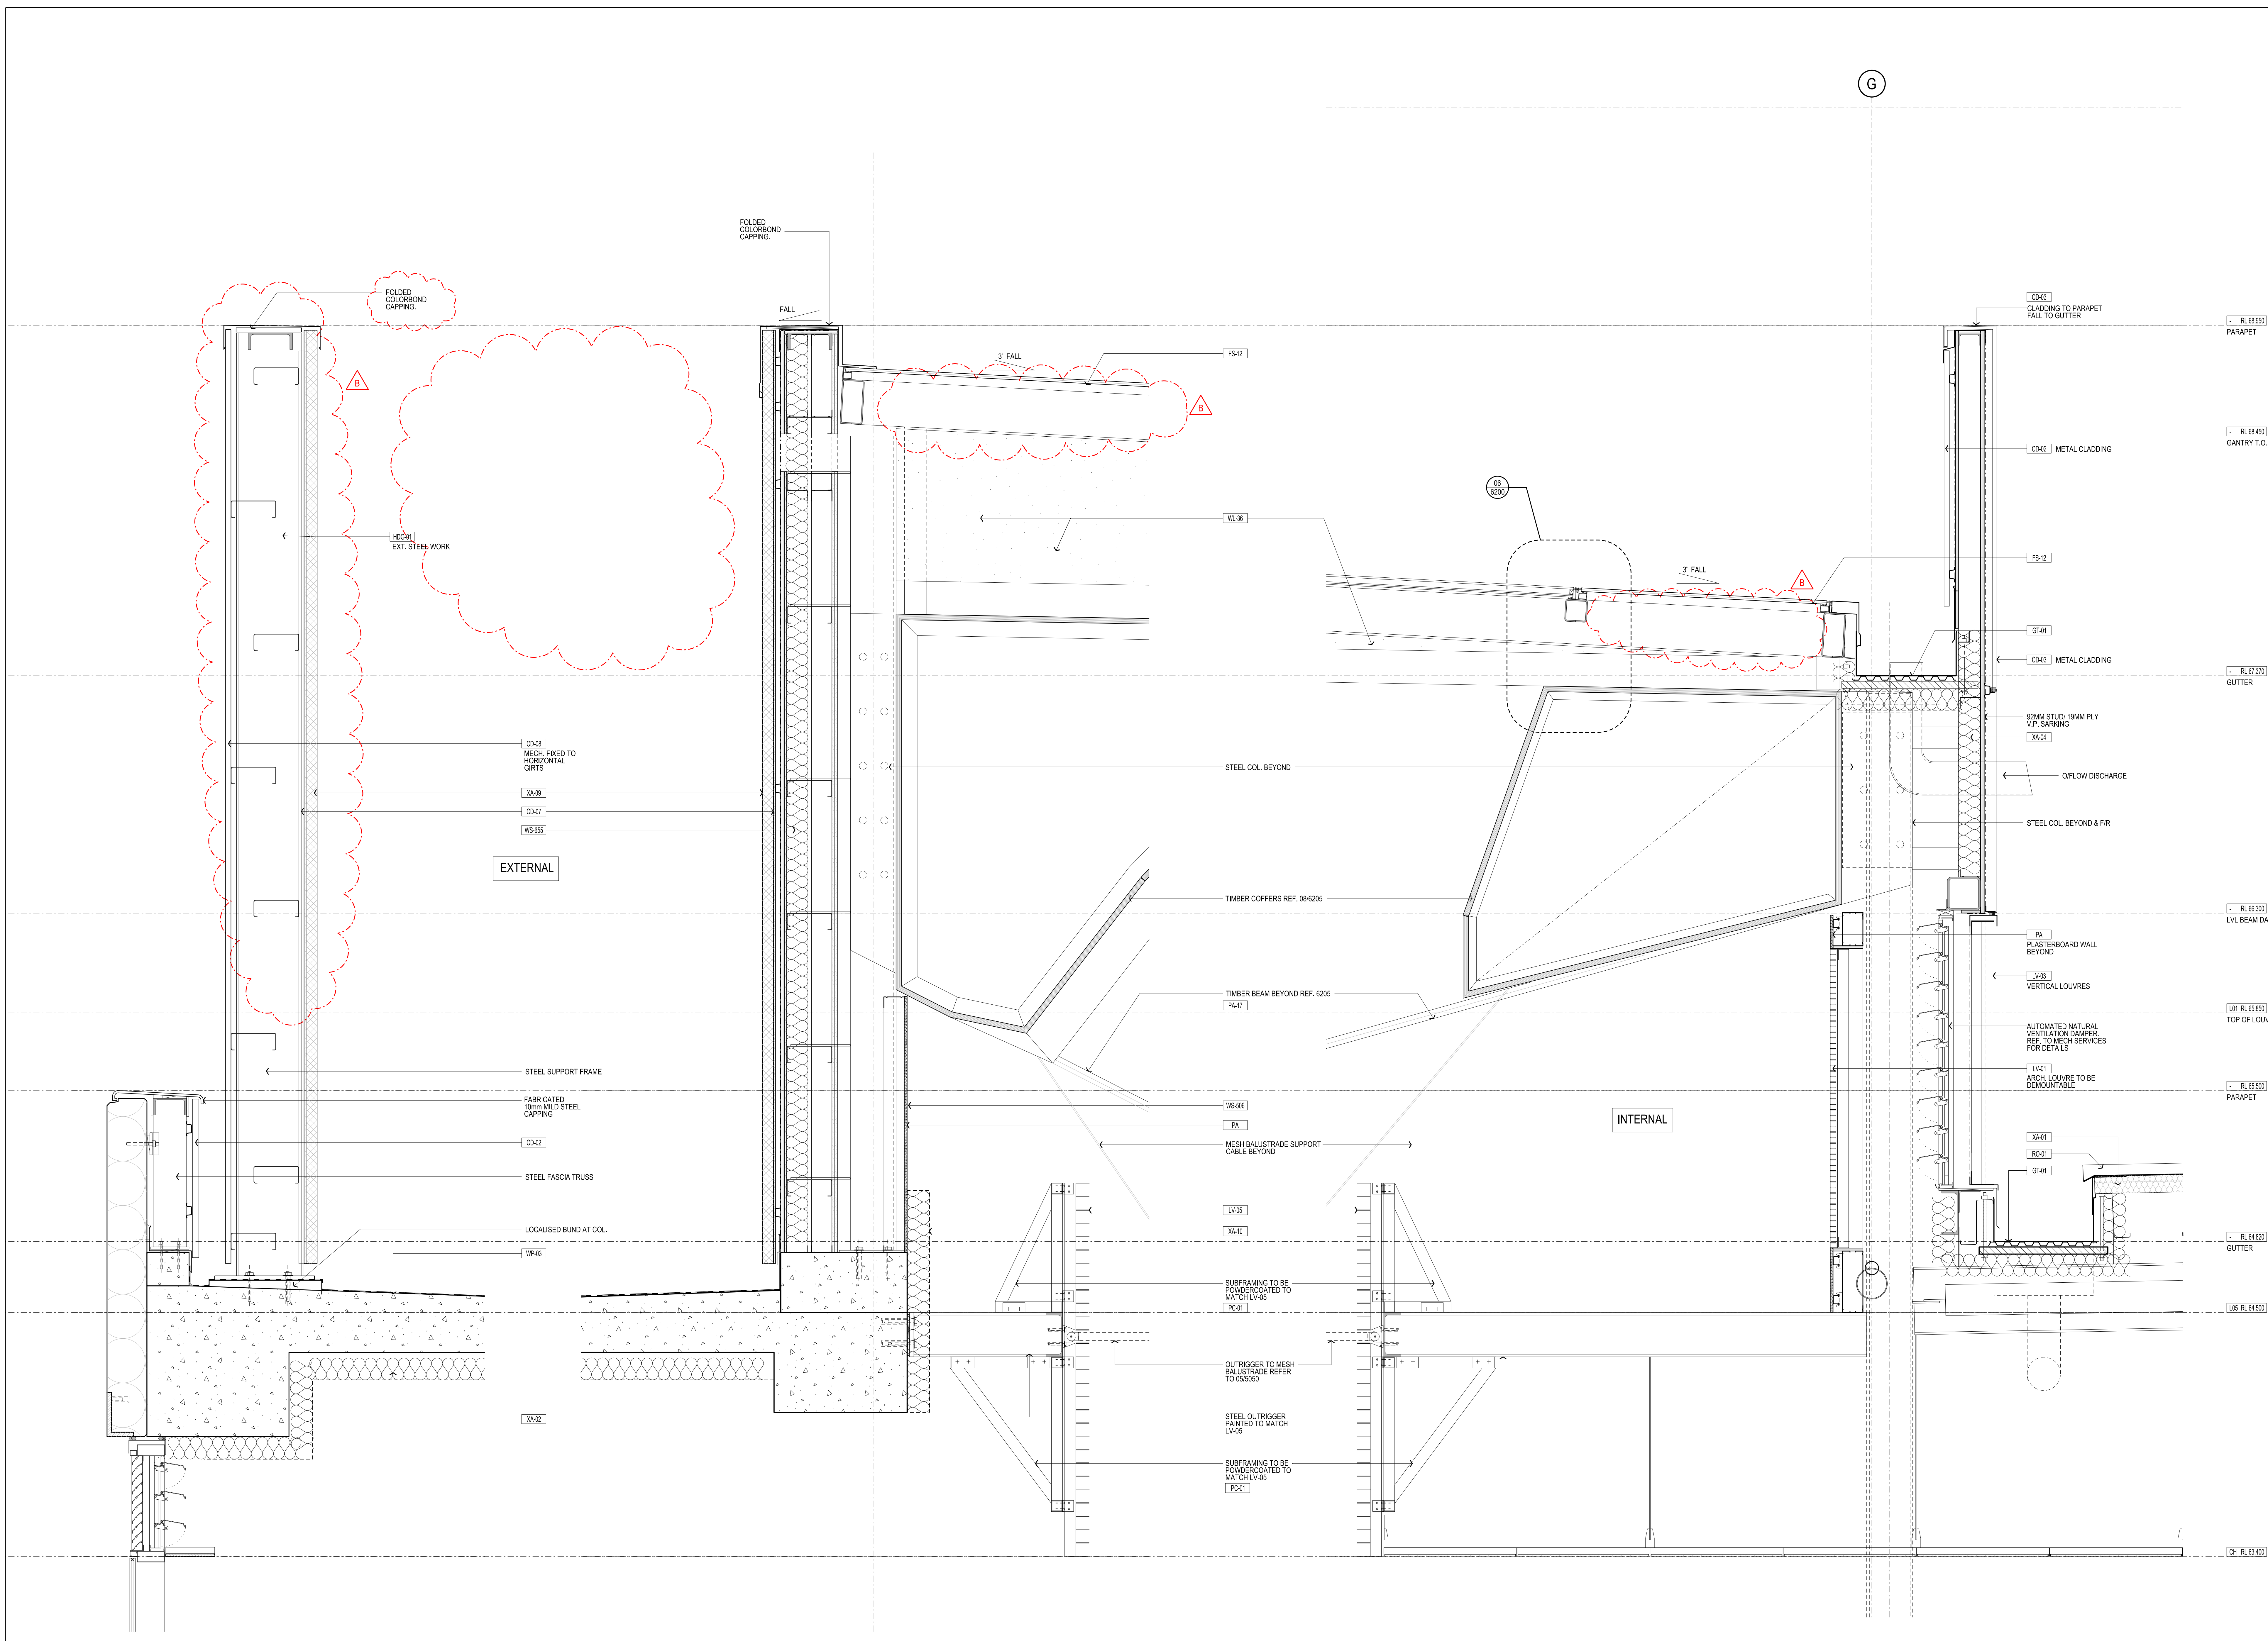

NADAAA
 NADAAA
 1020 Washington Street No.2
 Boston Massachusetts 02118 USA
 Telephone +1 617 442 8232
 Facsimile +1 688 442 1417
 Email nad@nadaaa.com

John Wardle Architects
 25 Rokeby Street, Collingwood, Victoria 3066 Australia
 Tel: +61 3 8662 0400 www.johnwardlearchitects.com
 © 2012 John Wardle Architects ABN 83 006 814 268

Client **University of Melbourne Parkville Campus**

Project **Faculty of Architecture Building and Planning**

Title **ROOF DETAILS ROOF SECTIONS - SHEET 2**

Project No.	0913	Scale	1:10 @ A0 1:20 @ A2
Drawing No.	AR6202	Revision	B

Date: Dec 2011 Drawn: Co-Ord: Chk:

FILENAME - \$FILES

FOR CONSTRUCTION

01 SECTION DETAIL @ ROOF SCALE 1:10

02 SECTION DETAIL @ ATRIUM ROOF SCALE 1:10

03 SECTION DETAIL @ ATRIUM ROOF SCALE 1:10