

THIS DRAWING IS AN UNCONTROLLED COPY UNLESS STAMPED OTHERWISE

CONTRACTORS SHALL VERIFY JOB DIMENSIONS BEFORE ANY JOB COMMENCES. ALL SHOP DRAWINGS SHALL BE SUBMITTED TO THE SUPERINTENDENT AND MANUFACTURER SHALL NOT COMMENCE PRIOR TO THE RETURN OF SIGNED SHOP DRAWINGS. BY THE CONSULTANT FOLDING DIMENSIONS SHALL TAKE PRECEDENCE OVER SCALES. THIS DRAWING SHOULD BE READ IN CONJUNCTION WITH ALL RELEVANT CONTRACT SPECIFICATIONS AND DRAWINGS COPYRIGHT OF THIS DRAWING IS VESTED IN HANDLE.

General Notes

REFER ARCHITECTURAL DRAWINGS:

FACADE SETOUT AR1502-AR1507
 PRECAST SETOUT AR1512-AR1517
 SCREEN SETOUT AR1502-AR1517
 SCREEN DETAILS AR6550-AR6554

R. B. 030
 PARAPET

R. B. 180

R. B. 580

R. B. 080

B	SG	STEEL / PARAPET REV. TO SUIT STR.	-	22.10.13
A	SG	O/FLOW DETAIL ADDED	-	10.10.13
03	SG	VALUE MANAGEMENT ISSUE	-	28.03.13
02	SG	100% CD - TENDER ISSUE	-	07.09.12
		PREV. ISSUED AS ATRIUM ROOF SHADING		

Rev	Issue	Revision Description	Amd	Date
-----	-------	----------------------	-----	------



NADAAA
 NADAAA
 1520 Washington Street No.2 Boston Massachusetts 02118 USA
 Telephone +1 617 442 8232
 Facsimile +1 688 442 1417
 Email nadaa@nadaaa.com

John Wardle Architects
 25 Rokeby Street, Collingwood, Victoria 3066 Australia
 Tel: +61 3 8662 0400 www.johnwardlearchitects.com
 © 2012 John Wardle Architects ABN 83 006 814 268

Client **University of Melbourne Parkville Campus**

Project **Faculty of Architecture Building and Planning**


Title **ROOF DETAILS ROOF SECTIONS - SHEET 4**

Project No.	0913	Scale	1:10 @ A0 1:20 @ A2
Drawing No.	AR6203	Revision	B


Date: Dec 2011 Drawn: Co-Ord: Check:

FILENAME: \$FILES

FOR CONSTRUCTION

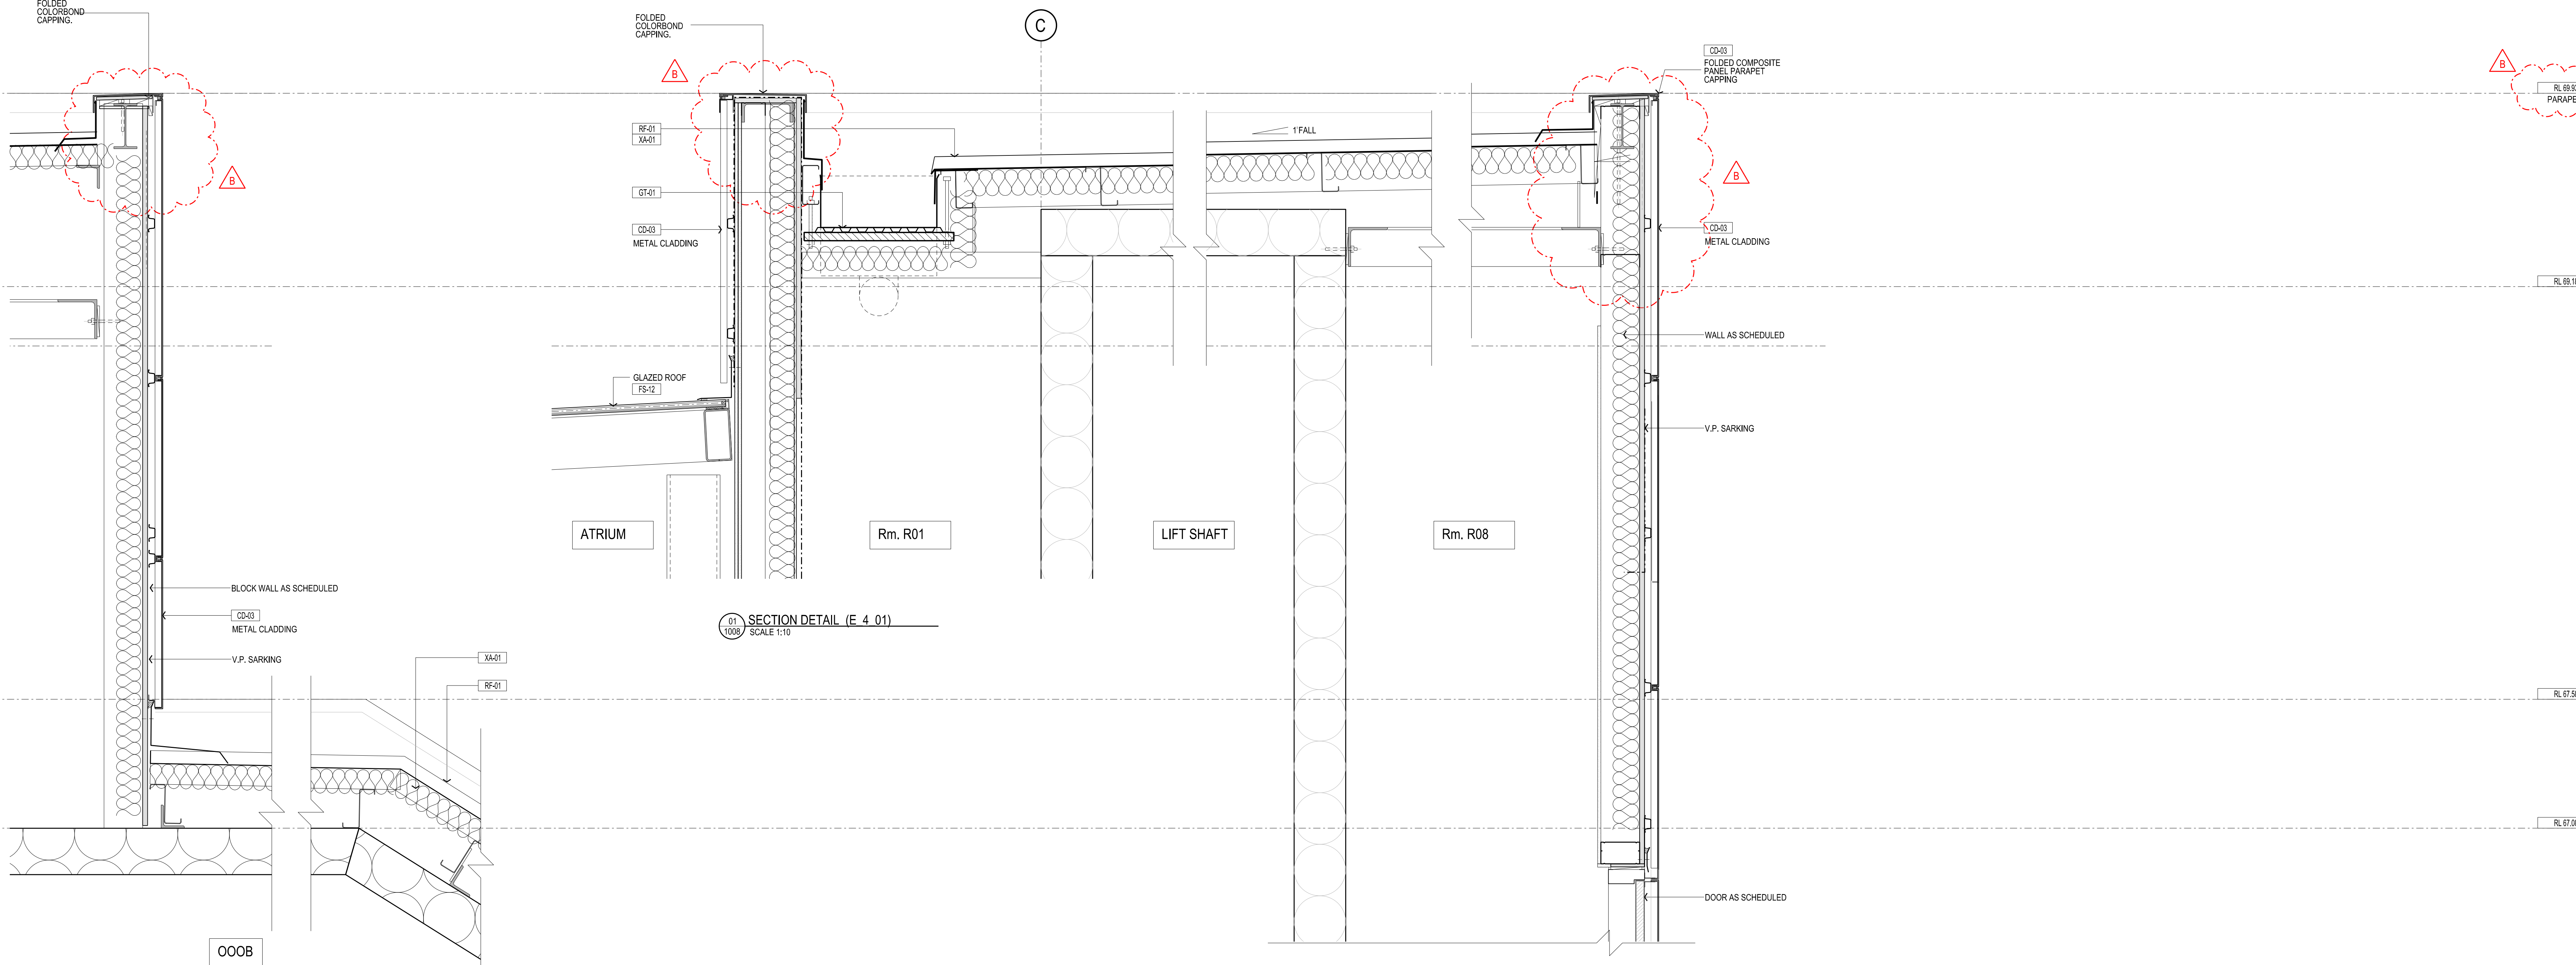

15 SECTION DETAIL SCALE 1:10

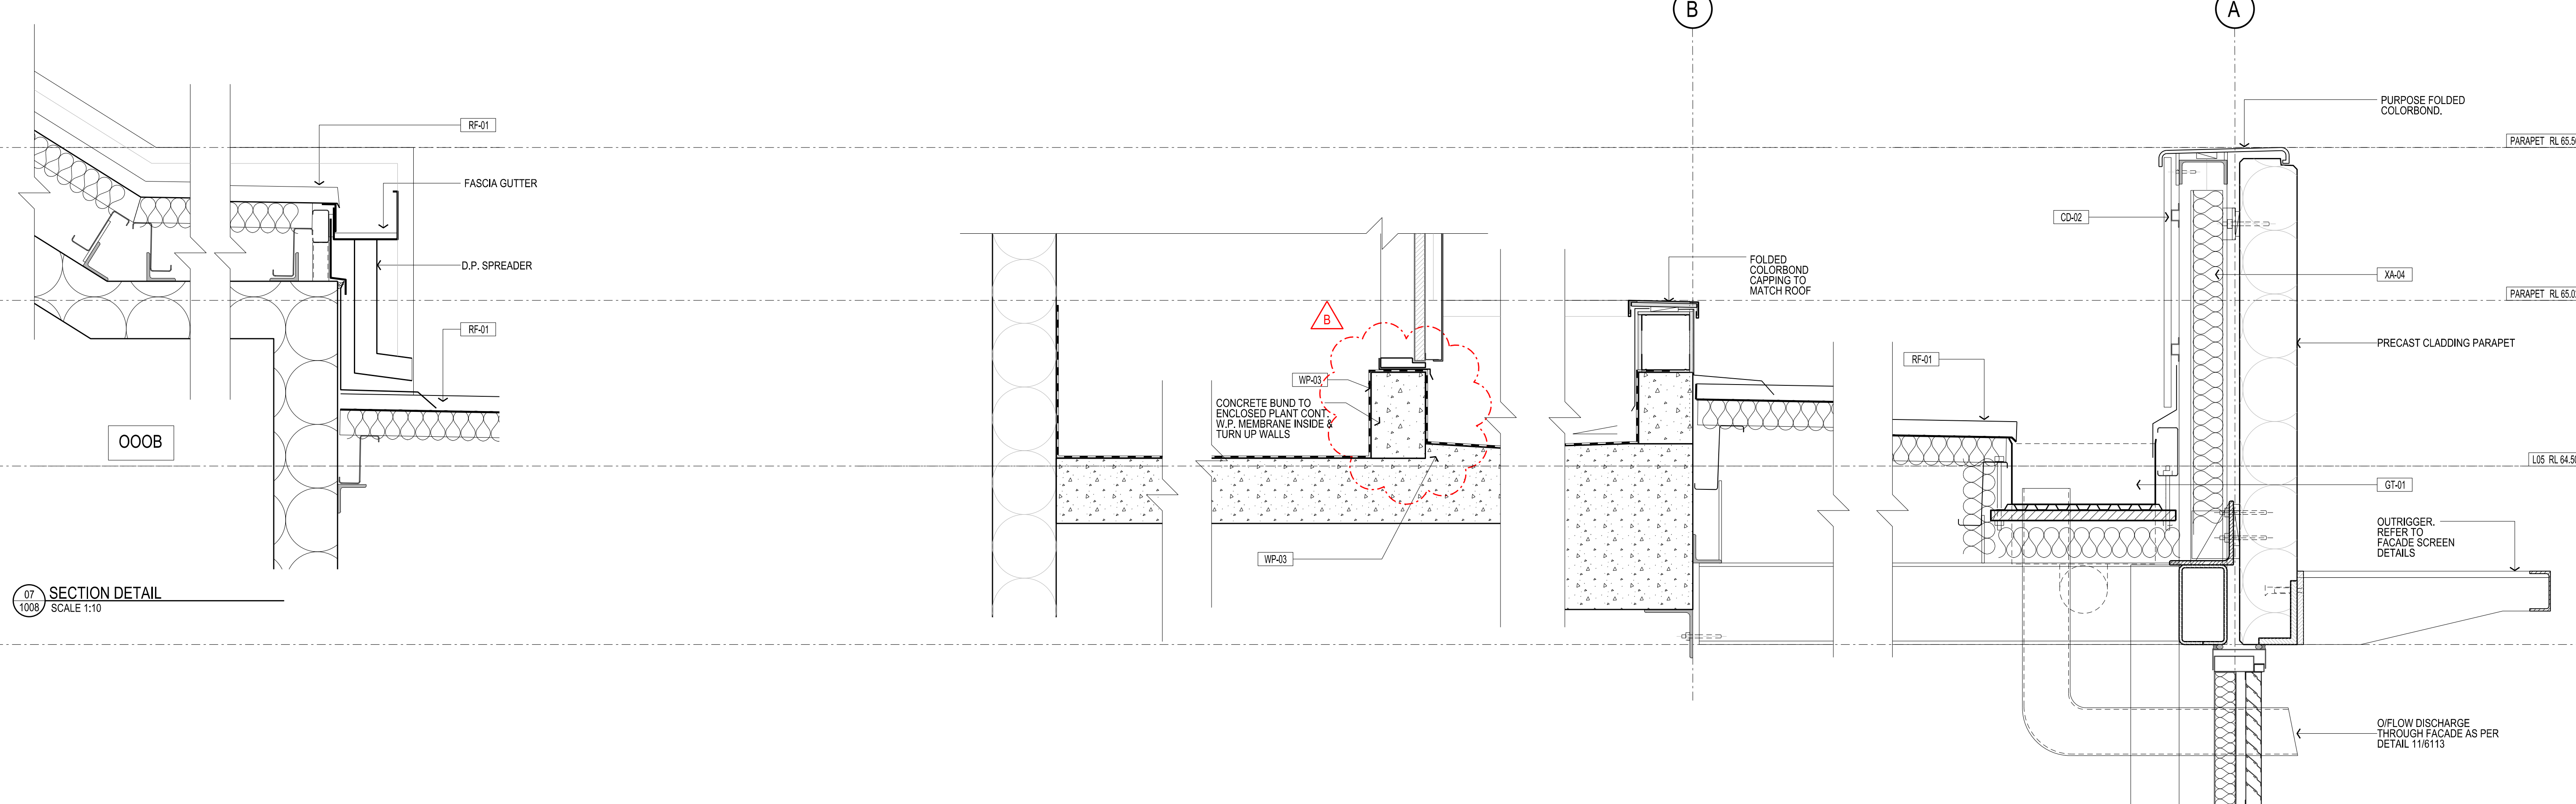

07 SECTION DETAIL SCALE 1:10

12 SECTION DETAIL SCALE 1:10

01 SECTION DETAIL SCALE 1:10

14 SECTION DETAIL SCALE 1:10

