



CONTRACTORS SHALL VERIFY JOB DIMENSIONS BEFORE ANY JOB COMMENCES. ALL SHOP DRAWINGS SHALL BE SUBMITTED TO THE SUPERINTENDENT AND MANUFACTURER SHALL NOT COMMENCE PRIOR TO THE RETURN OF DIMENSIONED SHOP DRAWINGS. BY THE CONTRACTOR. DIMENSIONS SHALL TAKE PRECEDENCE OVER SCALES. THIS DRAWING SHALL BE READ IN CONJUNCTION WITH ALL RELEVANT CONTRACT SPECIFICATIONS AND DRAWINGS COPYRIGHT OF THIS DRAWING IS VESTED IN WARDLE.


General Notes

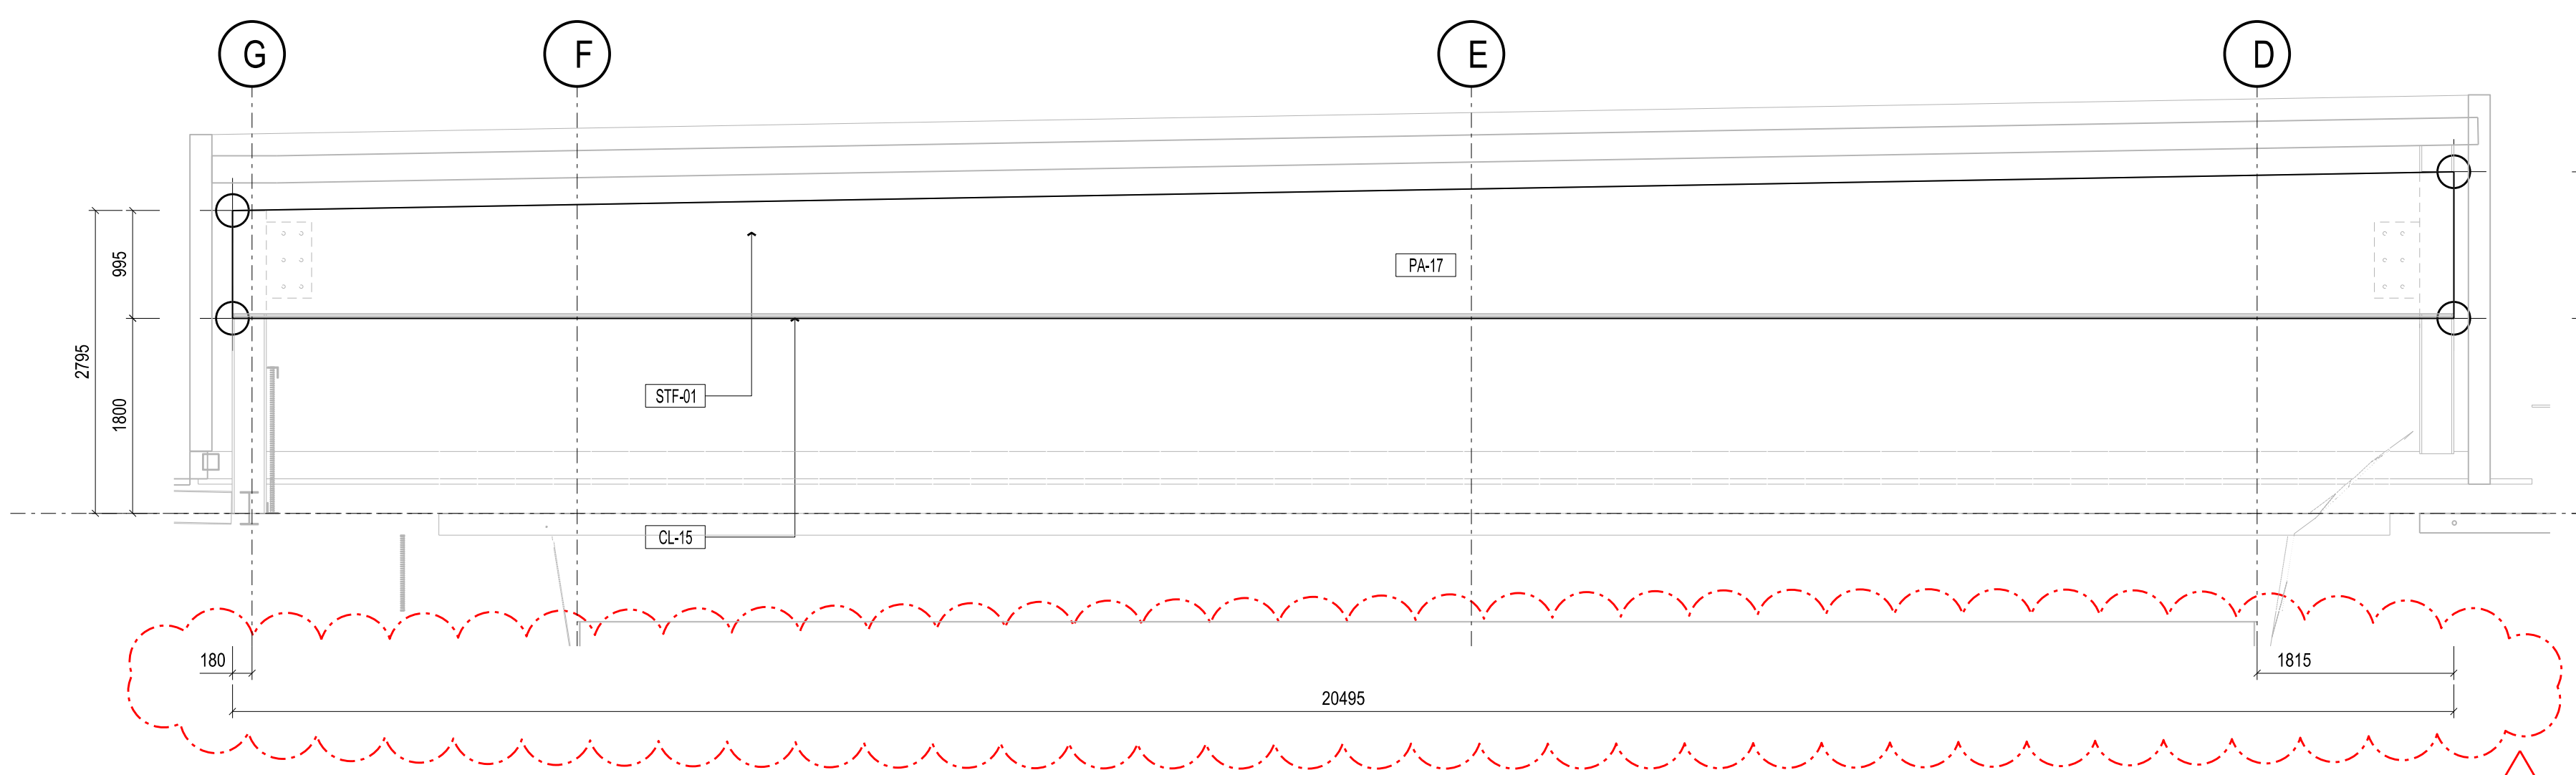


01 ROOF BEAM @ GRID LINE 04
SCALE 1:50

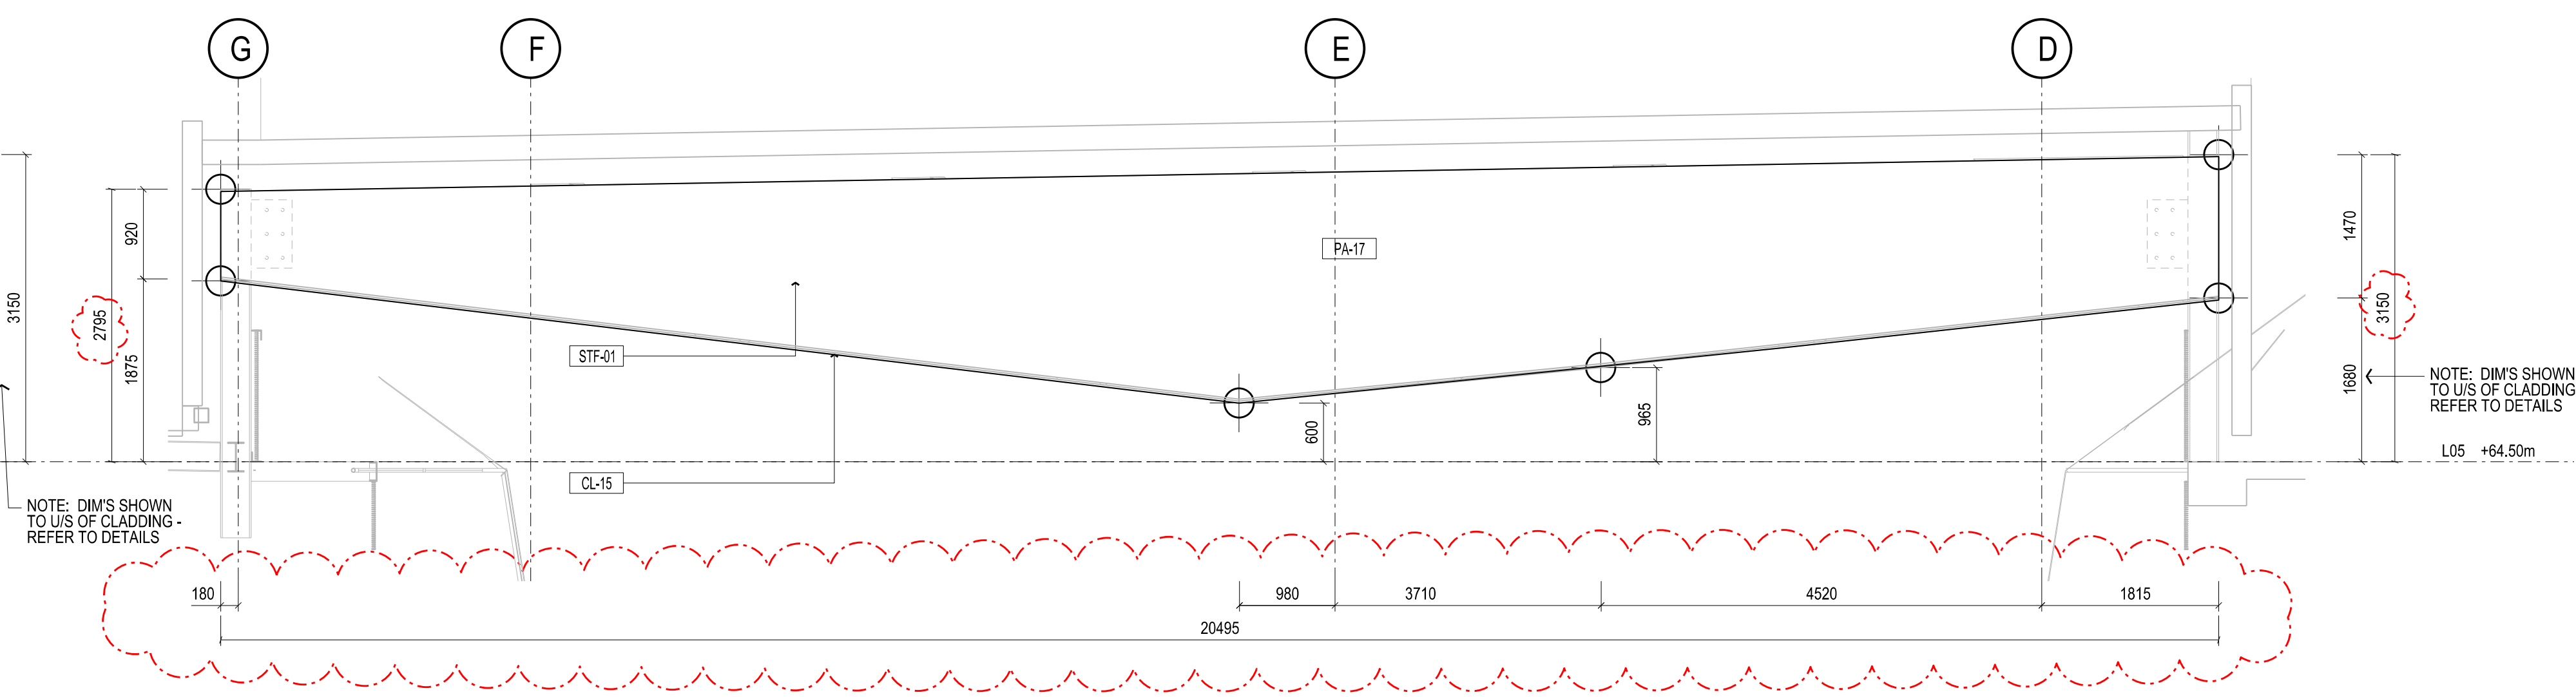


02 ROOF BEAM @ GRID LINE 05
SCALE 1:50

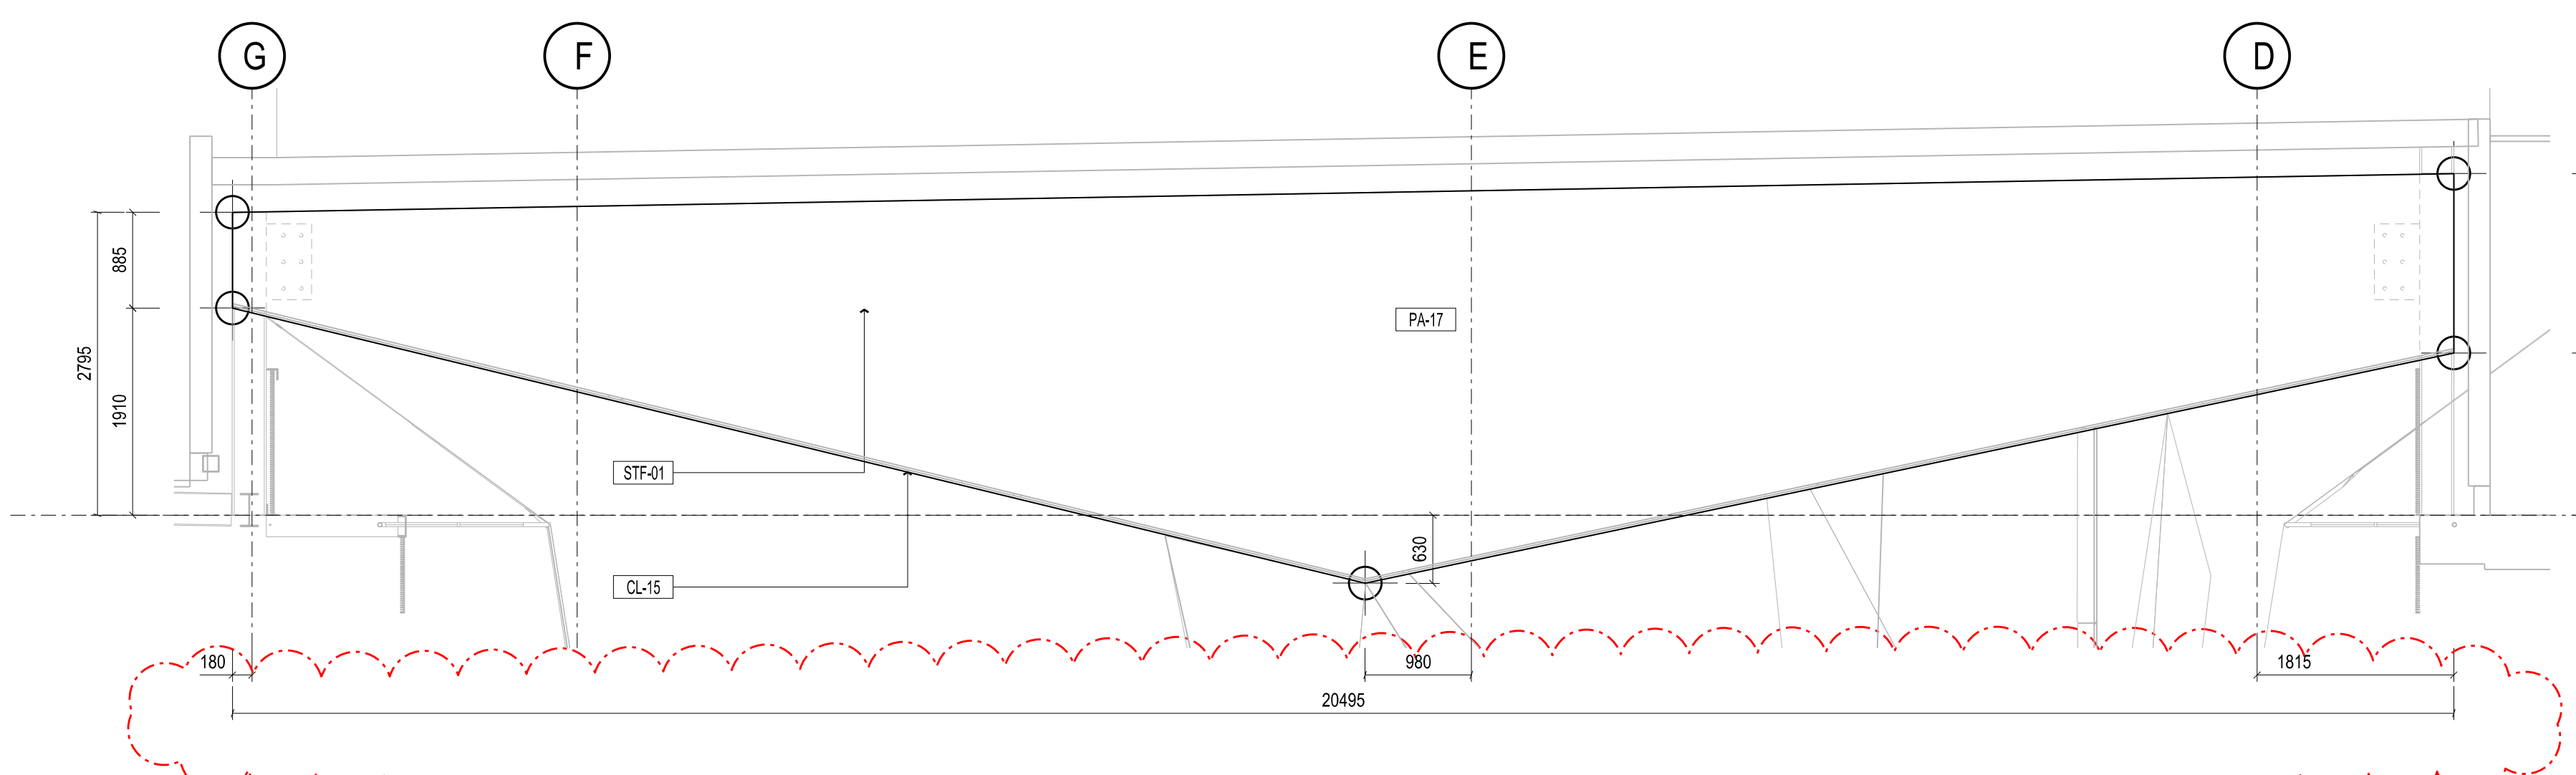


03 ROOF BEAM @ GRID LINE 06
SCALE 1:50

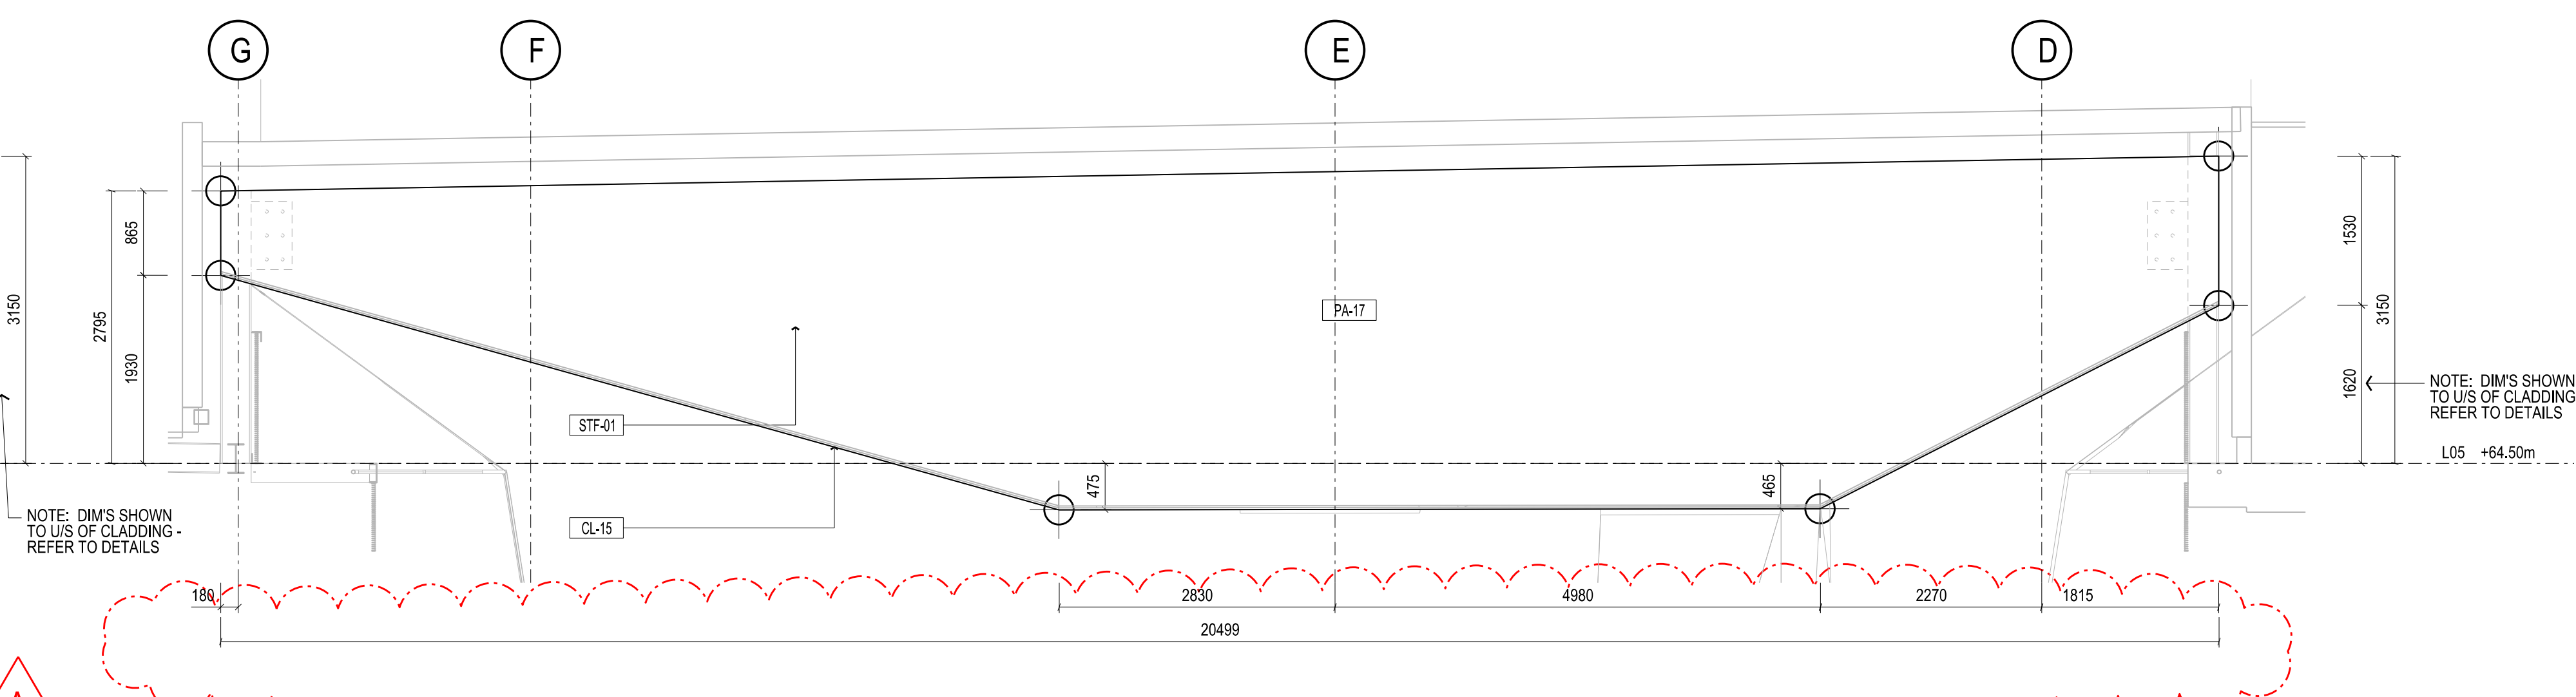


04 ROOF BEAM @ GRID LINE 07
SCALE 1:50

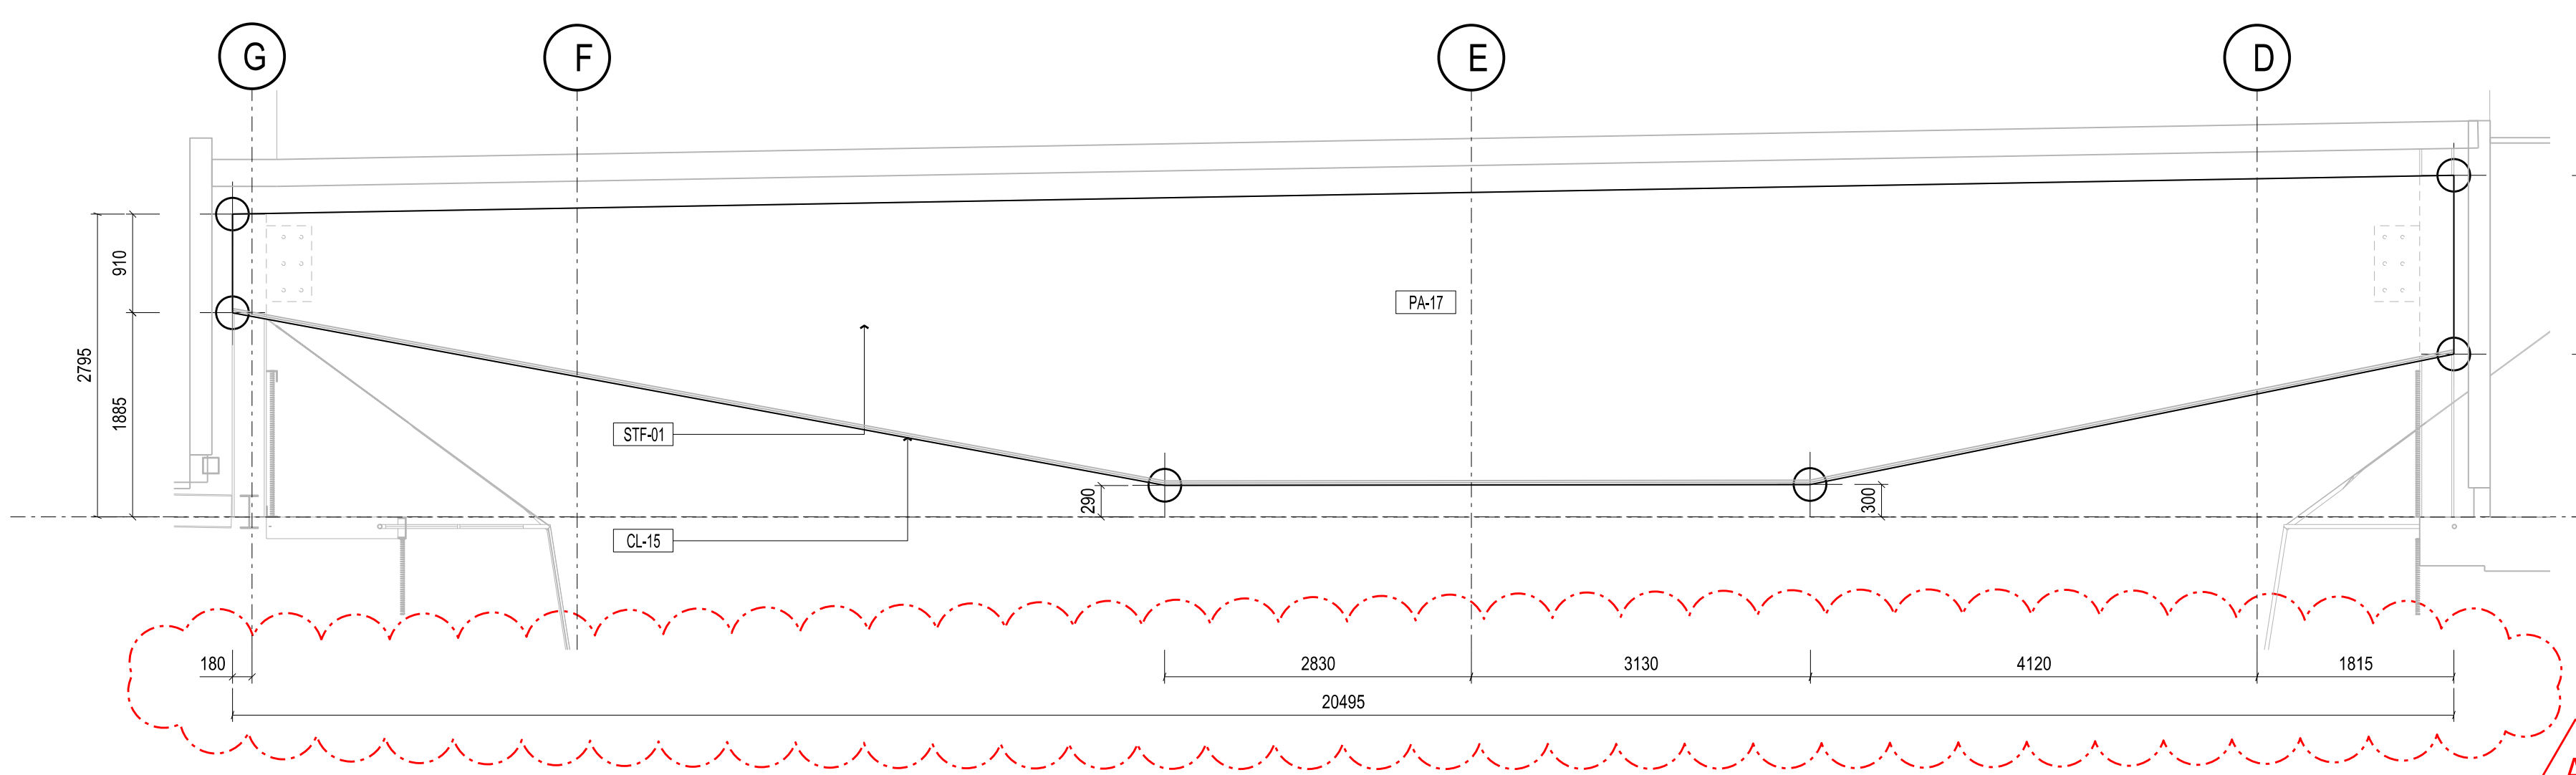


05 ROOF BEAM @ GRID LINE 08
SCALE 1:50

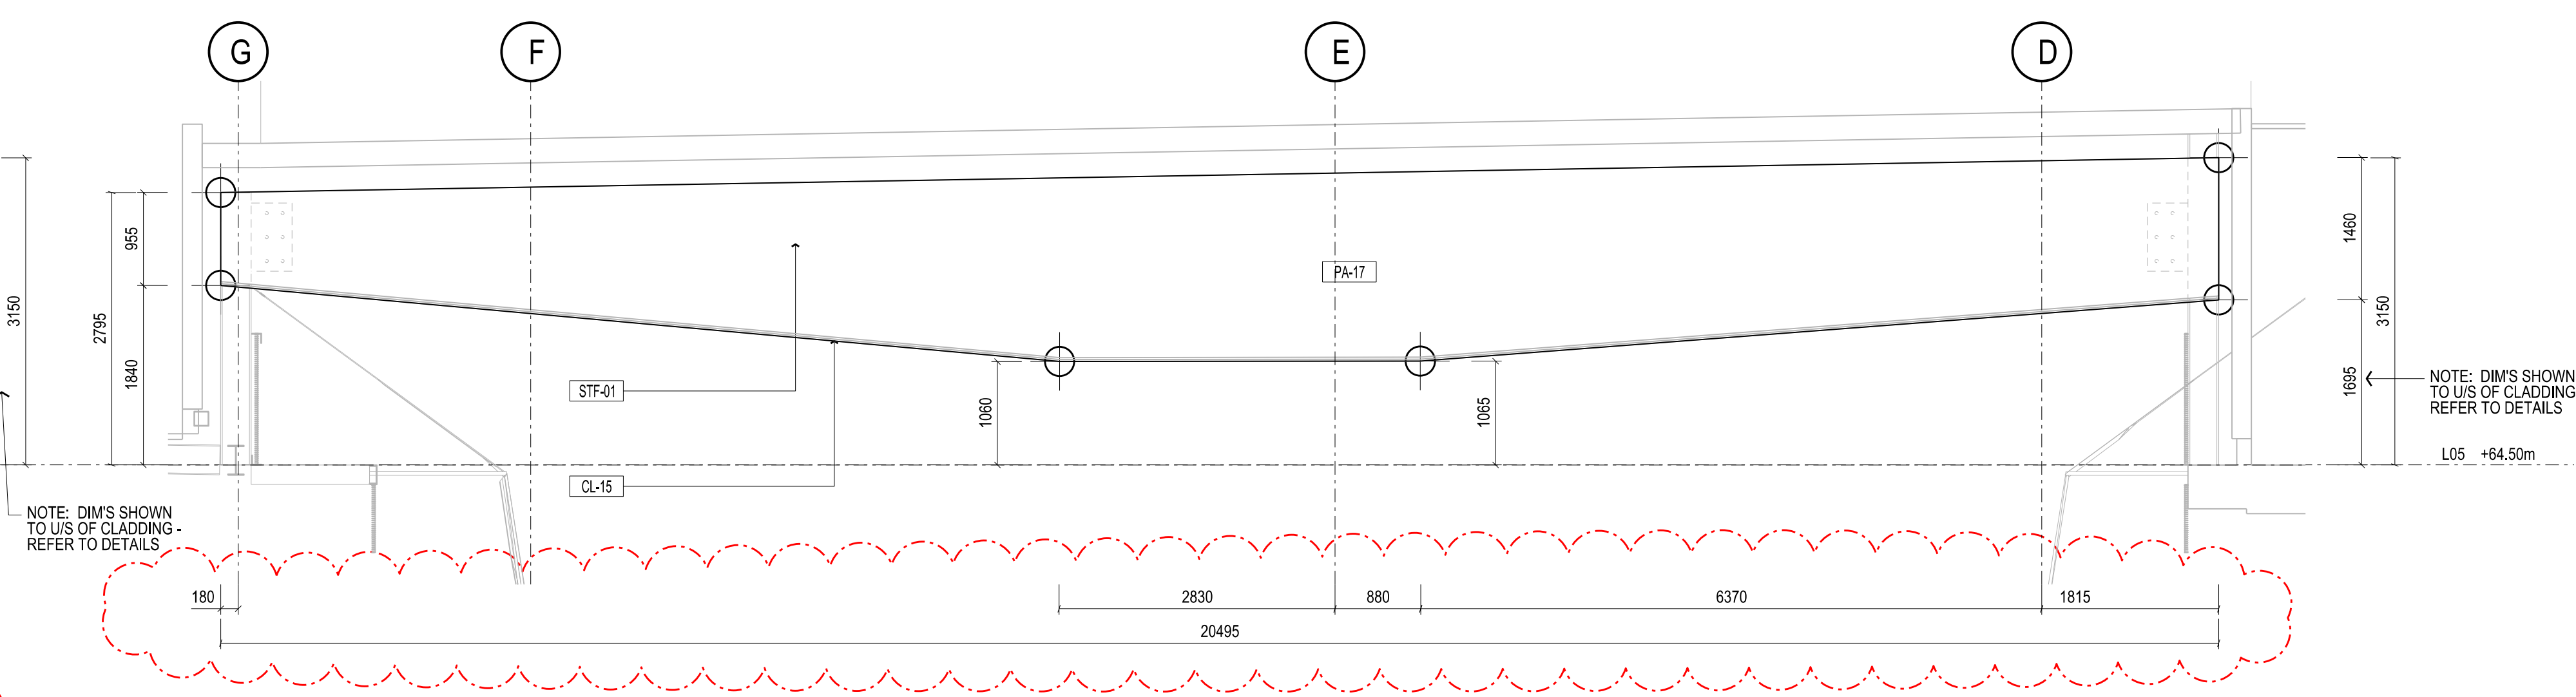

06 ROOF BEAM @ GRID LINE 09
SCALE 1:50

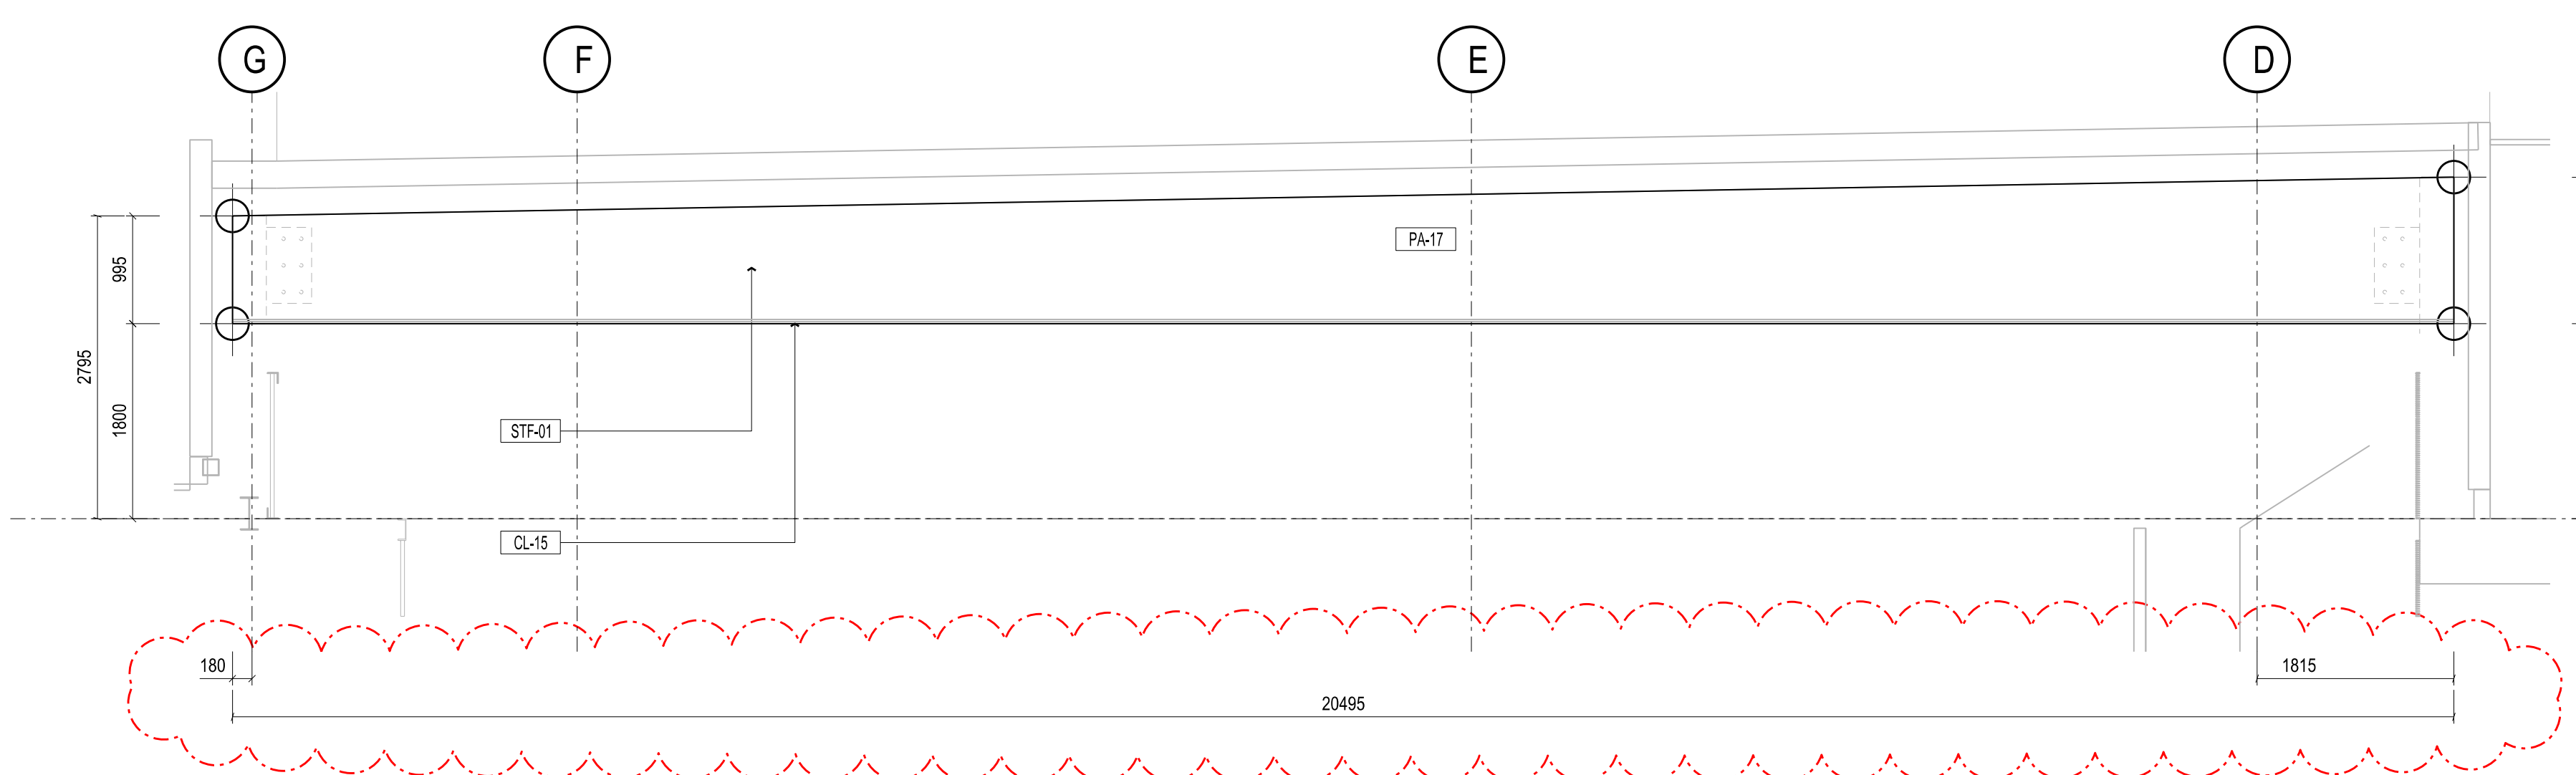

07 ROOF BEAM @ GRID LINE 10
SCALE 1:50

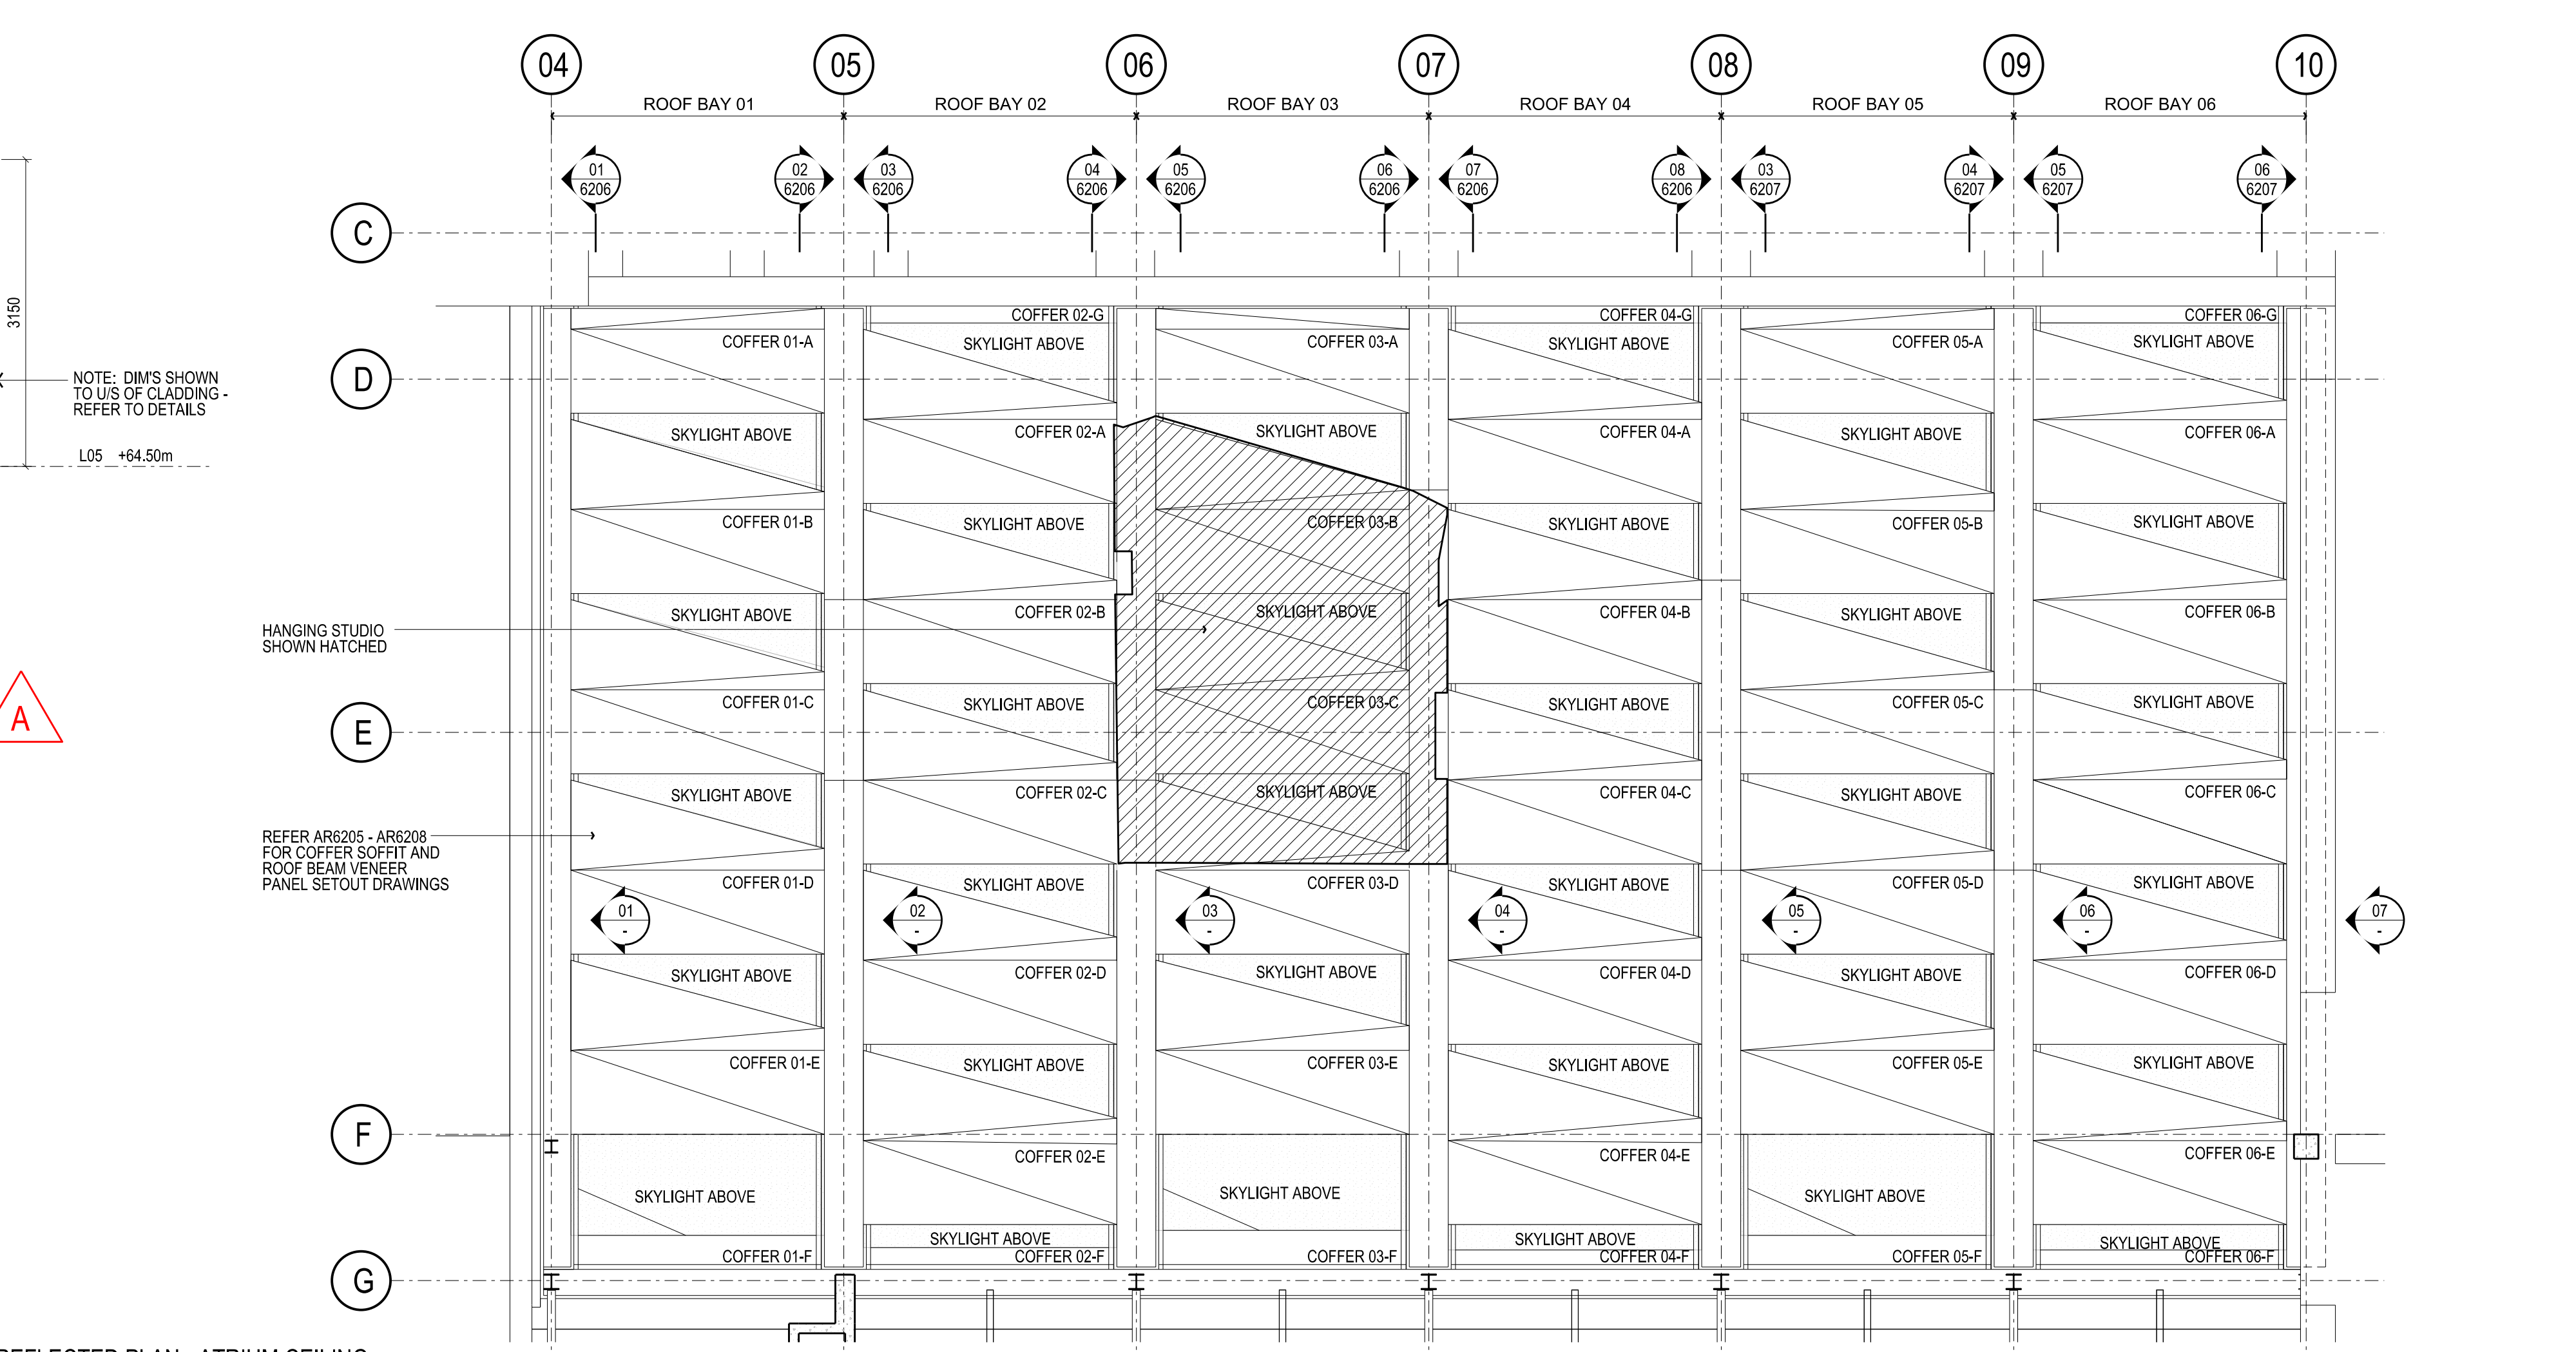

08 PARTIAL REFLECTED PLAN - ATRIUM CEILING
SCALE 1:100

Rev	Issue	Revision Description	Amd	Date
		DIMS REVISED TO SUIT GRIDS		
A	SG	ISSUED FOR CONSTRUCTION		05.09.13
04	SG	TENDER ADDENDUM 4		08.10.12
03	SG	100% CD - TENDER ISSUE		07.09.12
02	SG	90% CD ISSUE		10.08.12
01	SG	75% CD ISSUE		13.07.12



NADAAA
 NADAAA
 1920 Washington Street No.2
 Boston Massachusetts 02118 USA
 Telephone +1 617 442 8232
 Facsimile +1 688 442 1417
 Email nads@nadaaa.com

John Wardle Architects
 25 Rokeby Street, Collingwood, Victoria 3066 Australia
 Tel: +61 3 8662 0400 www.johnwardlearchitects.com
 © 2012 John Wardle Architects ABN 83 006 814 268

Client **University of Melbourne Parkville Campus**
 Project **Faculty of Architecture Building and Planning**

Title **ROOF DETAILS ATRIUM ROOF - BEAM SETOUT**

Project No. **0913** Scale: 1:50 @ A0
 Drawing No. **AR6205** Revision **A**

Date: June 2012 Drawn: BS Co-Ord: - Check: -

FILENAME - \$FILES
FOR CONSTRUCTION