



CONTRACTORS SHALL VERIFY DIMENSIONS BEFORE ANY JOB COMMENCES. ALL SHOP DRAWINGS SHALL BE SUBMITTED TO THE SUPERINTENDENT AND MANUFACTURER. SHALL NOT COMMENCE PRIOR TO THE RETURN OF DIMENSIONS SHOP DRAWINGS REVIEWED BY THE CONSULTANT. DIMENSIONS SHALL TAKE PRECEDENCE OVER SCALES. THIS DRAWING SHOULD BE READ IN CONJUNCTION WITH ALL RELEVANT CONTRACT SPECIFICATIONS AND DRAWINGS COPYRIGHT OF THIS DRAWING IS VESTED IN WARDLE.

General Notes


- NOTES:
1. ALL DIMENSIONS SHOWN AT GEOMETRIC JUNCTION TO LVL TIMBER TRUSS MEMBER
 2. REFER TO AR6205 FOR LVL TIMBER BEAM SETOUTS
 3. ALL DIMENSIONS TO OUTSIDE FACE INCLUDING ANY SECONDARY CLADDING MATERIAL.
 4. FURTHER COFFER SETOUTS ON AR6207.

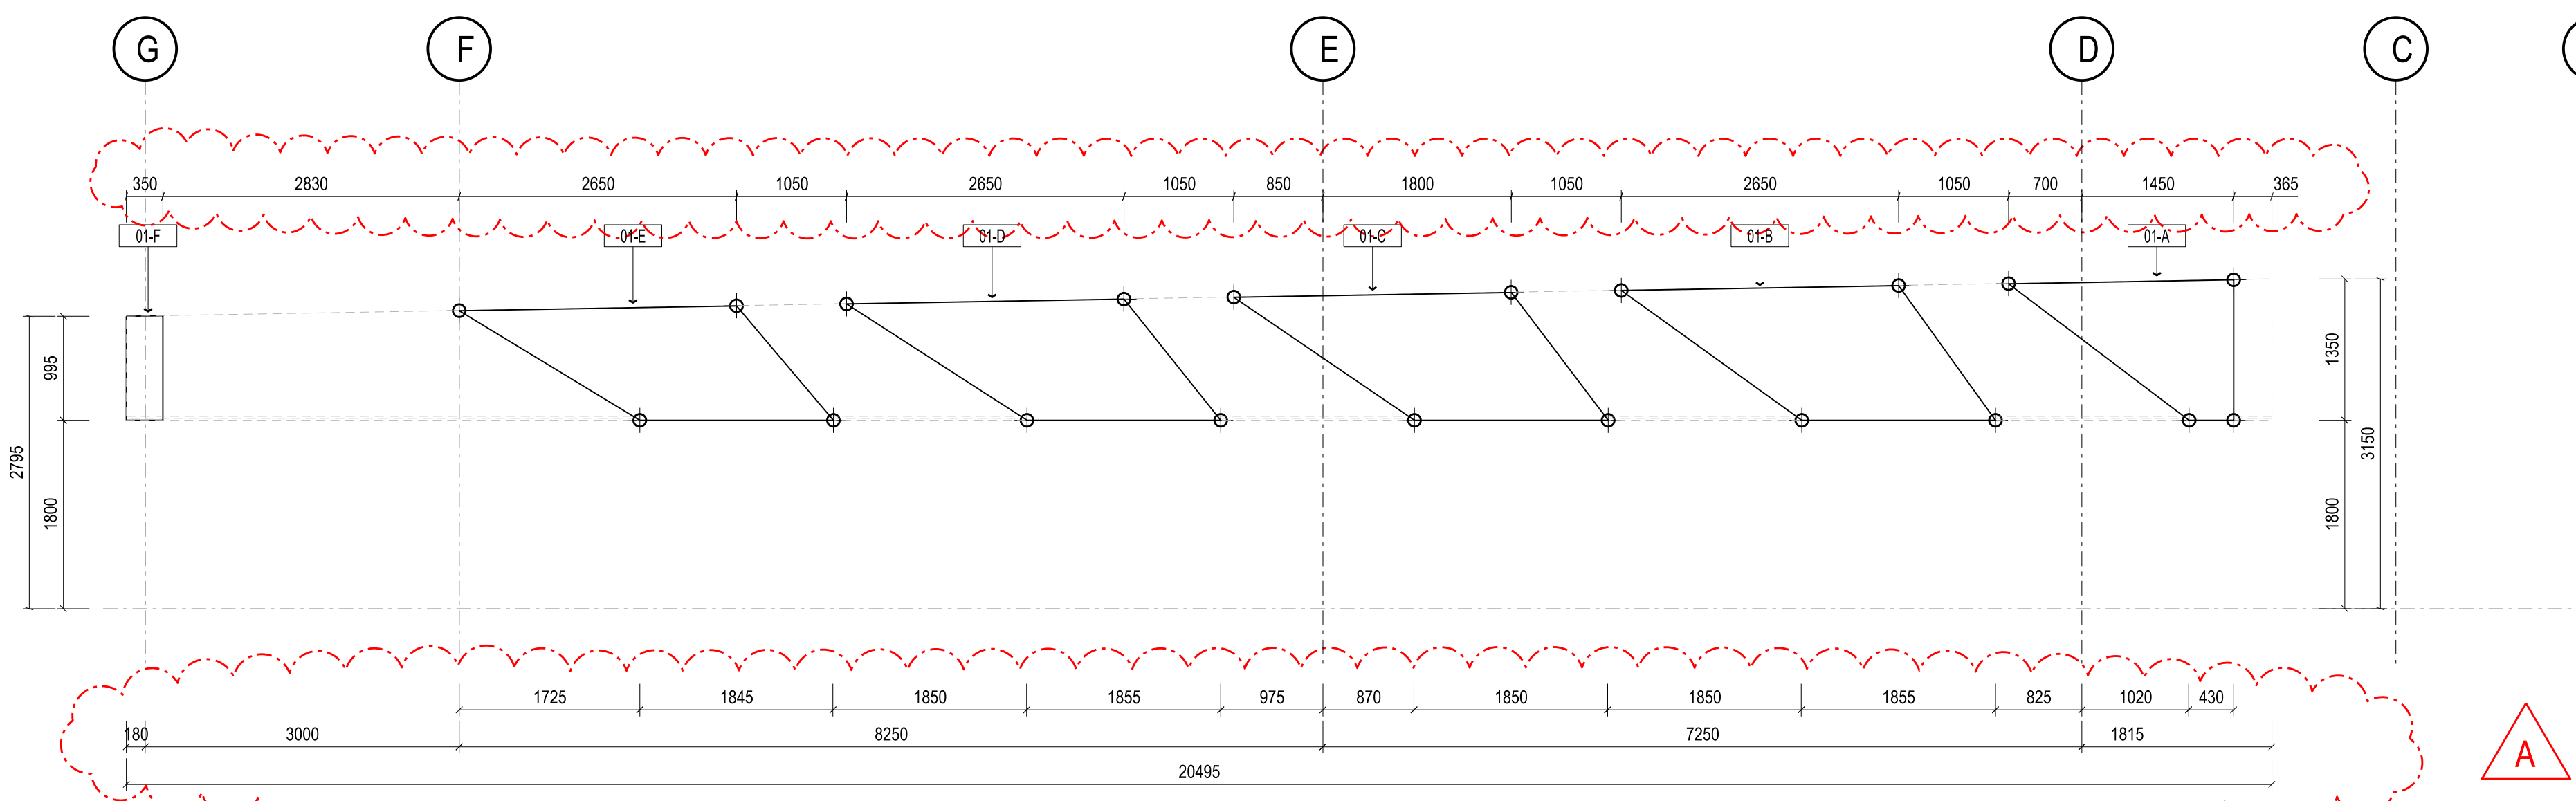


01 ROOF BAY 01 COFFERS - WEST SETOUT
SCALE 1:50

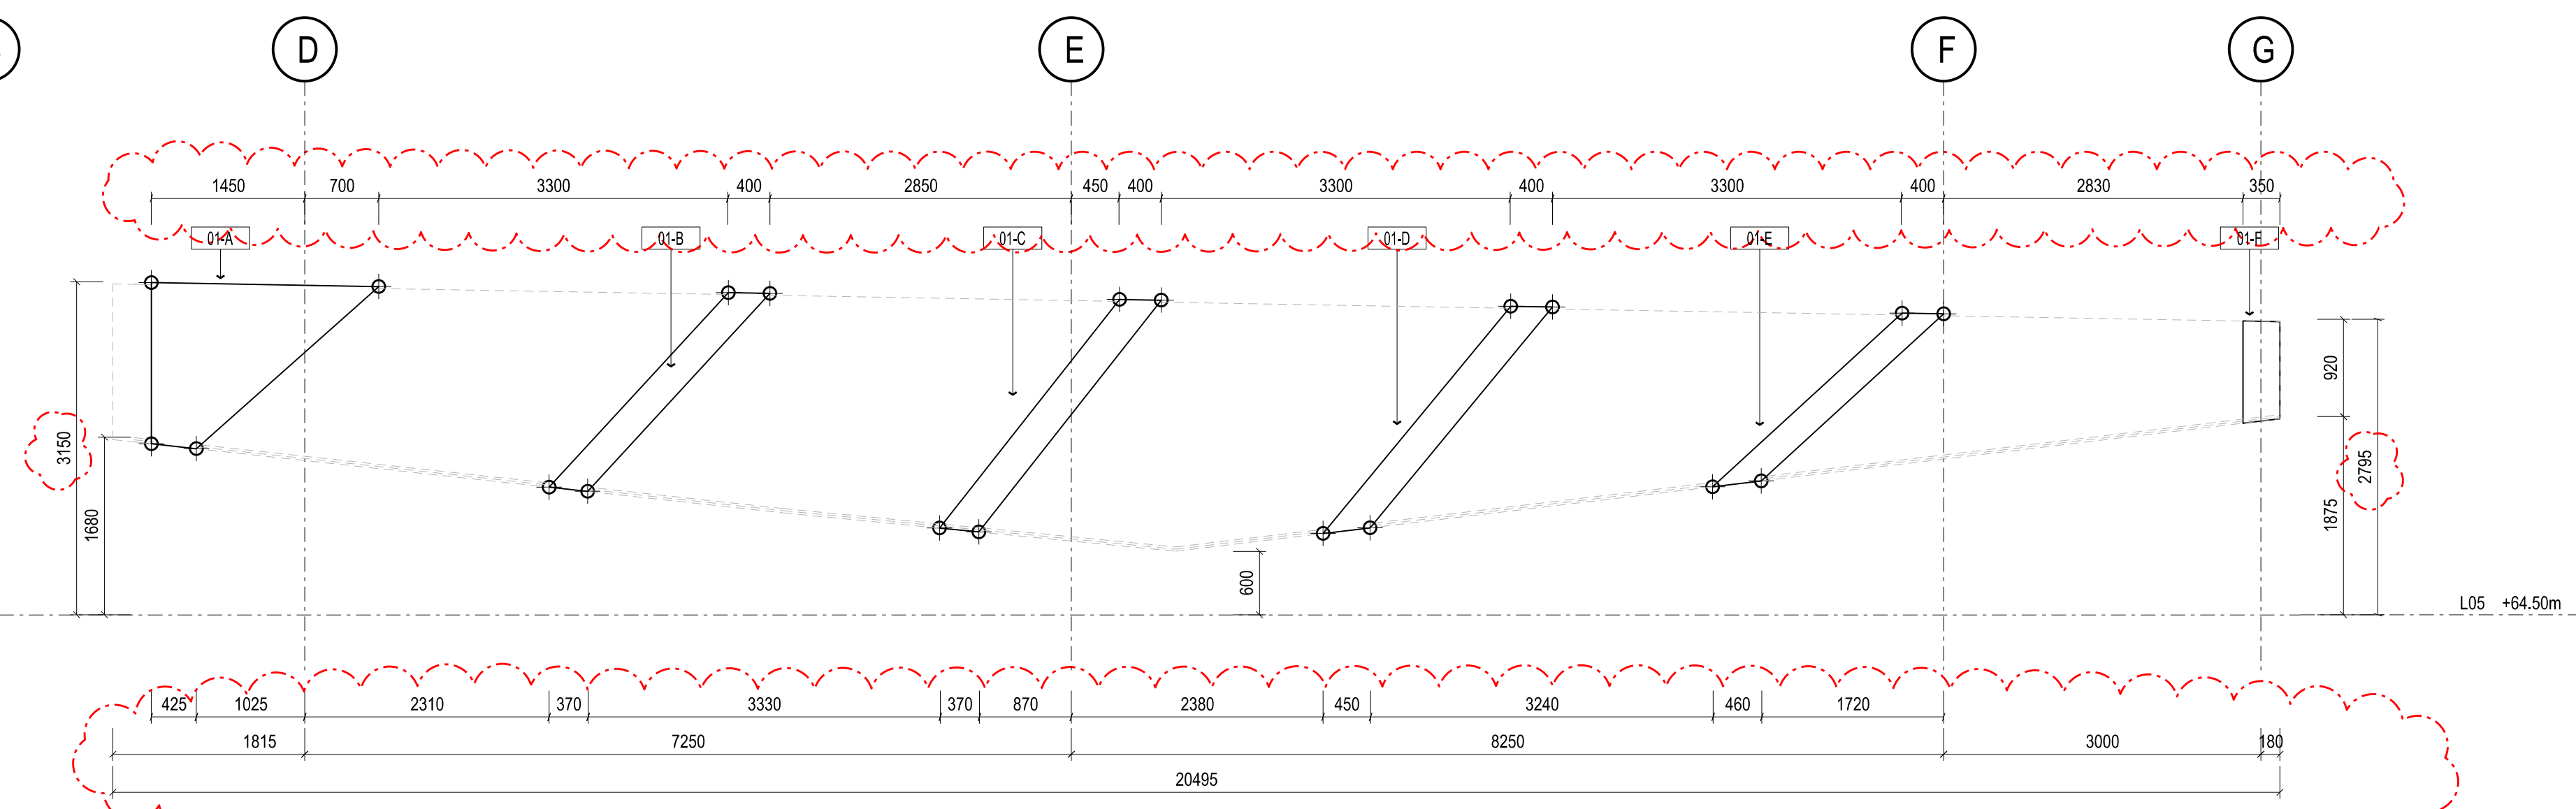


02 ROOF BAY 01 COFFERS - EAST SETOUT
SCALE 1:50

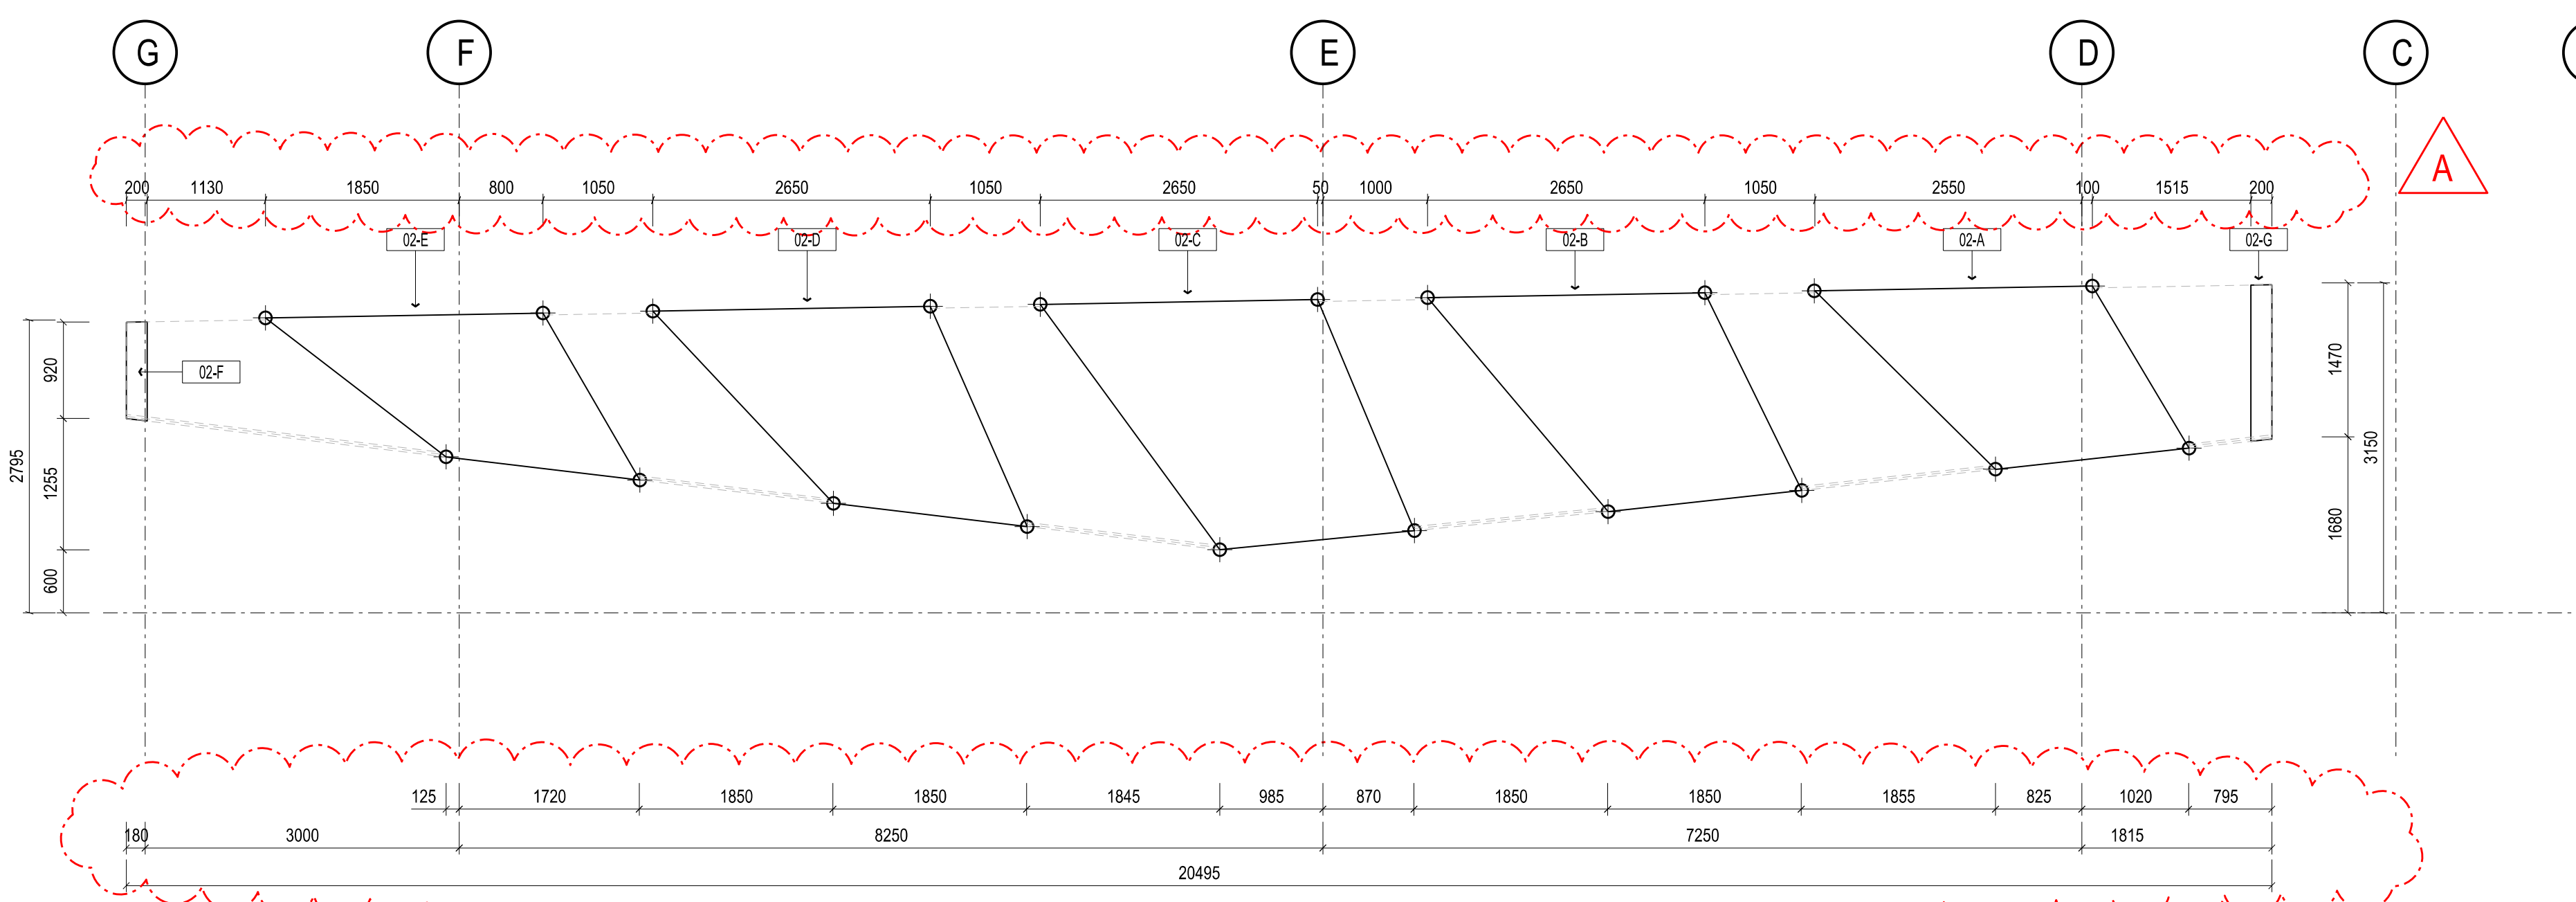


03 ROOF BAY 02 COFFERS - WEST SETOUT
SCALE 1:50

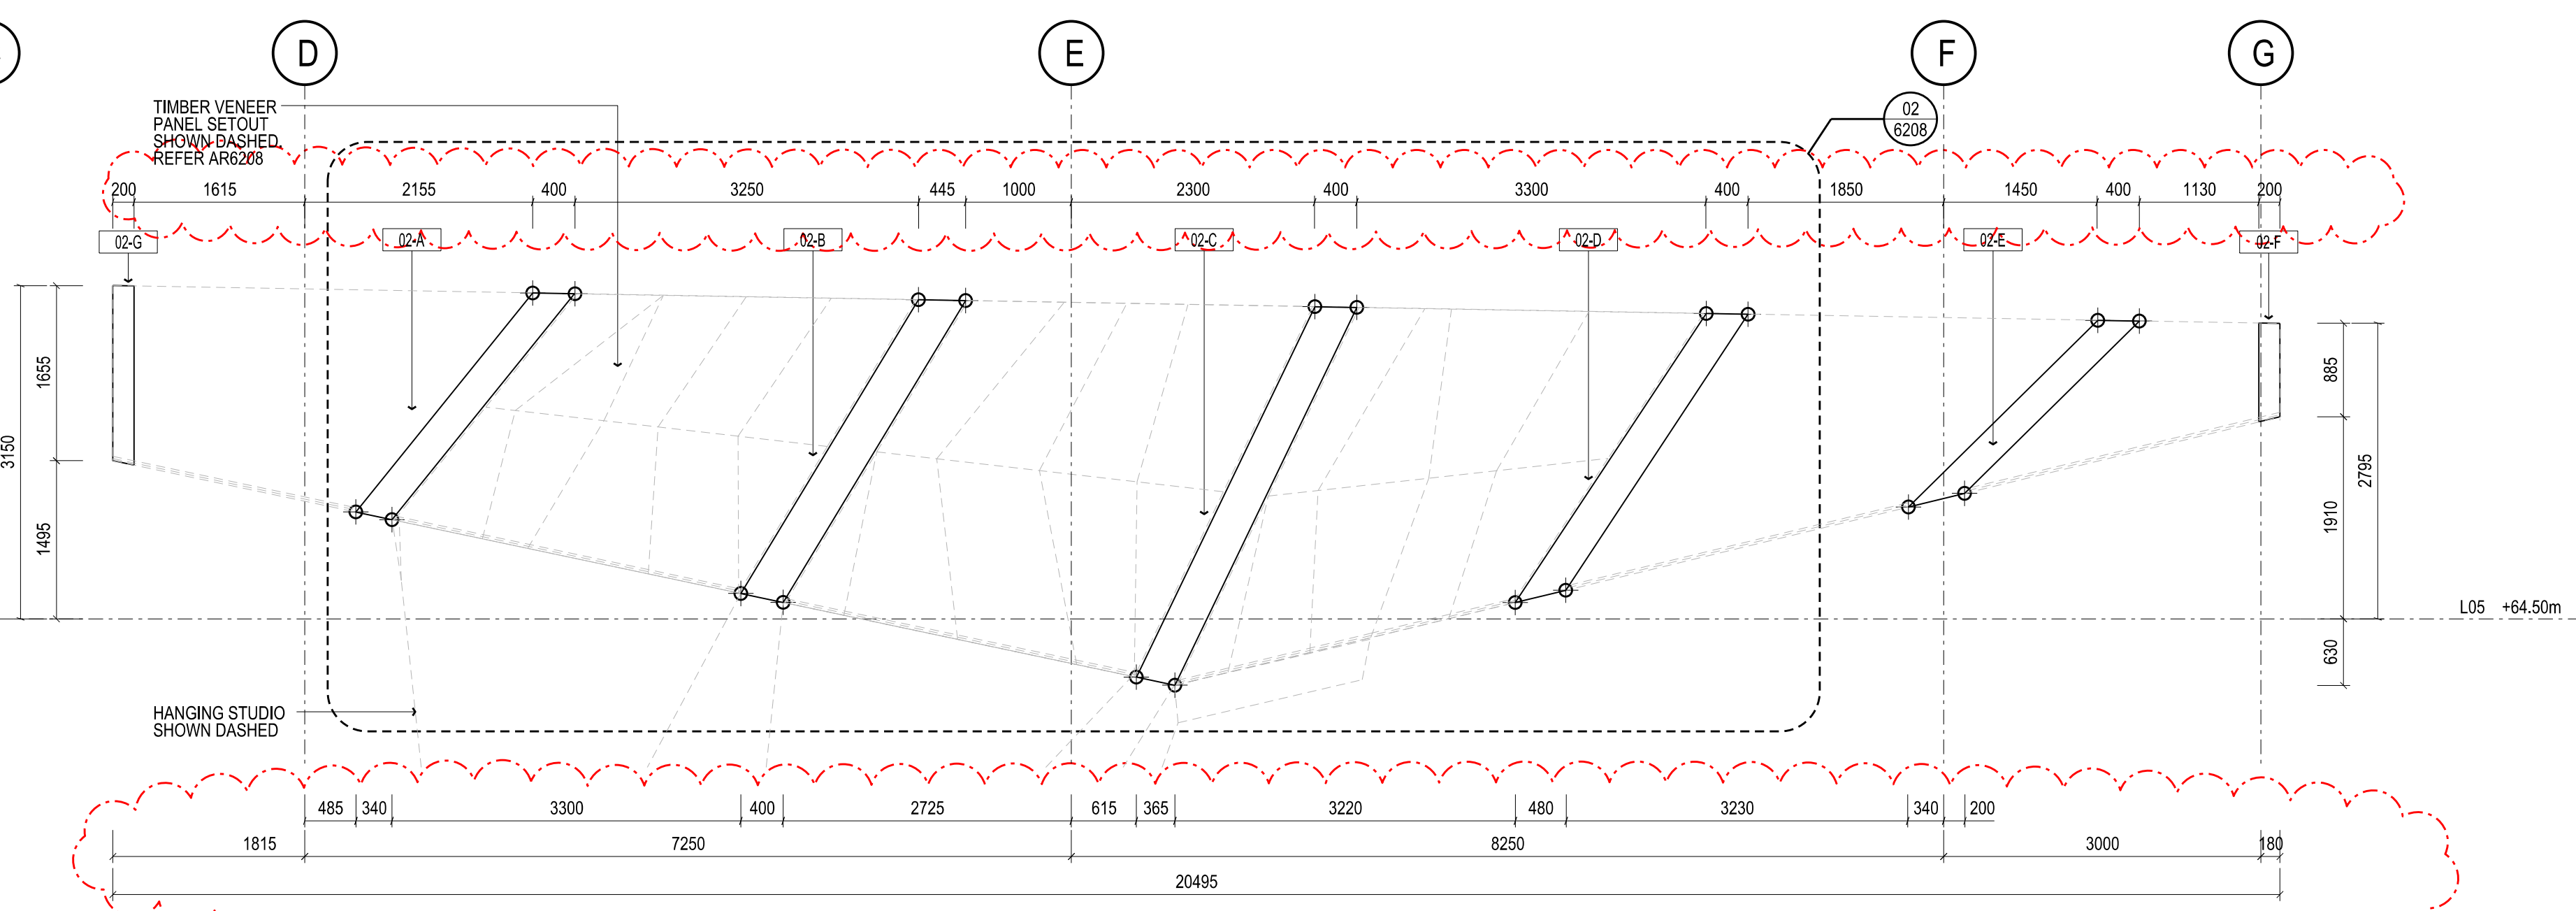


04 ROOF BAY 02 COFFERS - EAST SETOUT
SCALE 1:50

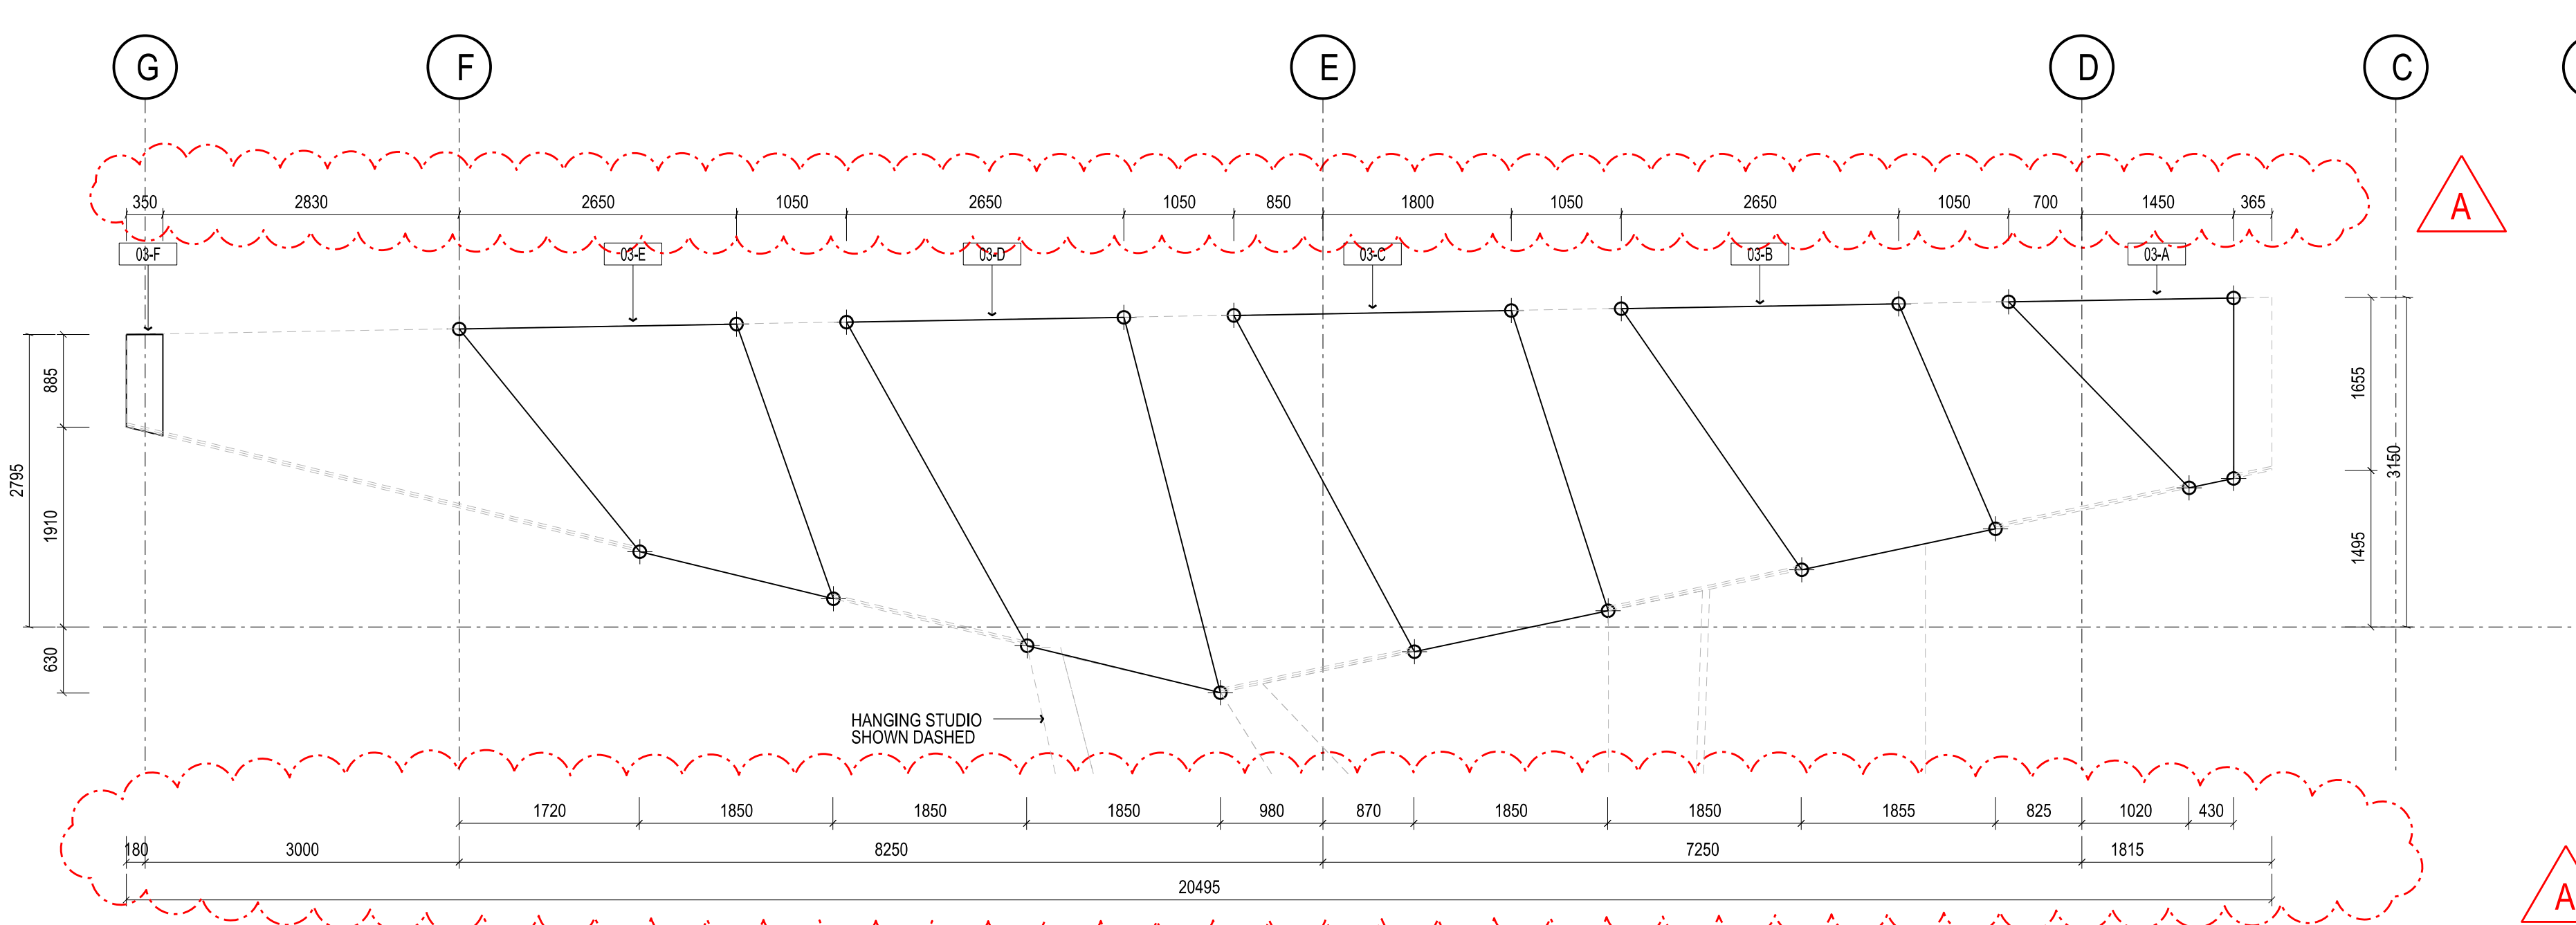


05 ROOF BAY 03 COFFERS - WEST SETOUT
SCALE 1:50

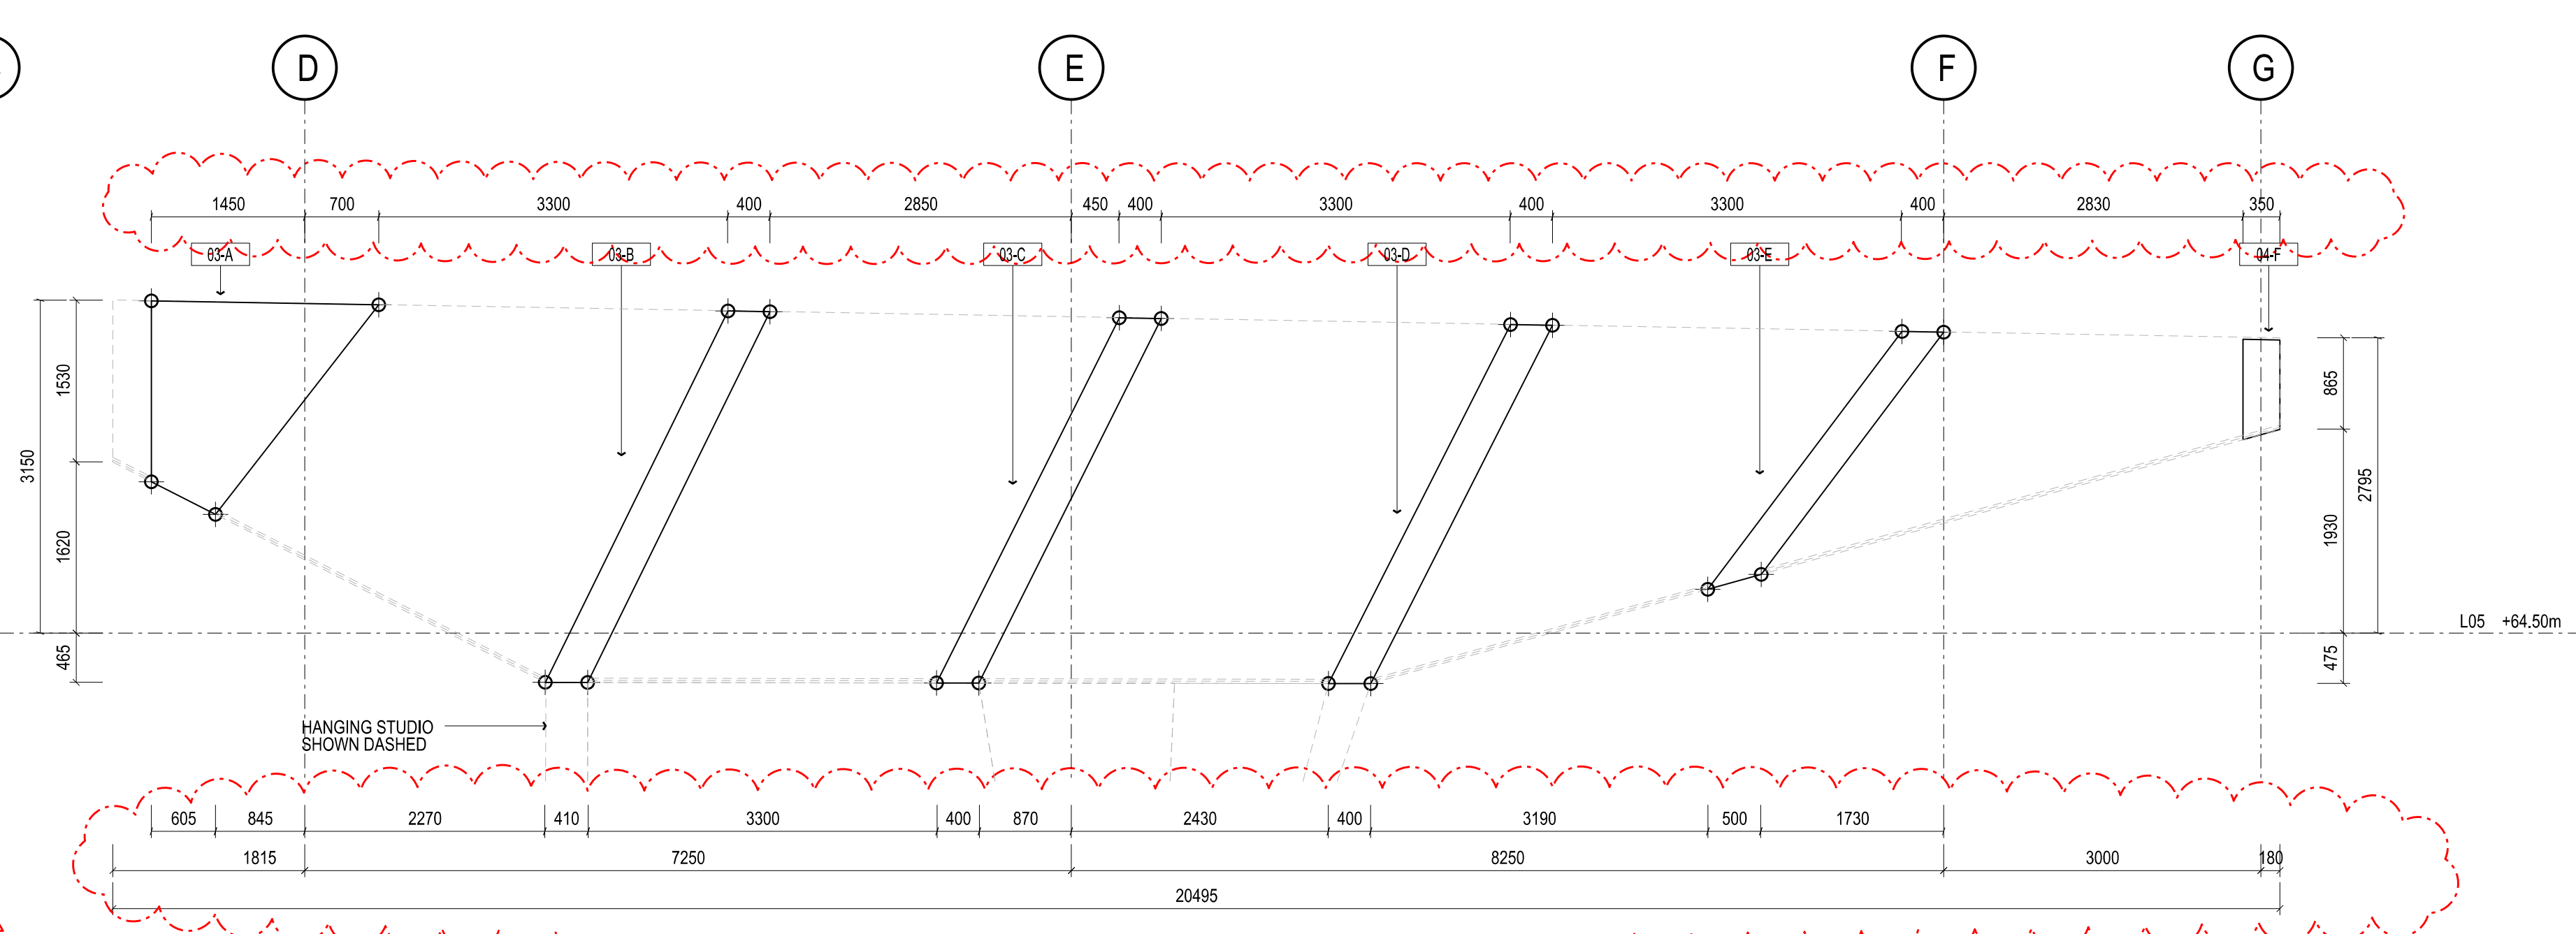

06 ROOF BAY 03 COFFERS - EAST SETOUT
SCALE 1:50

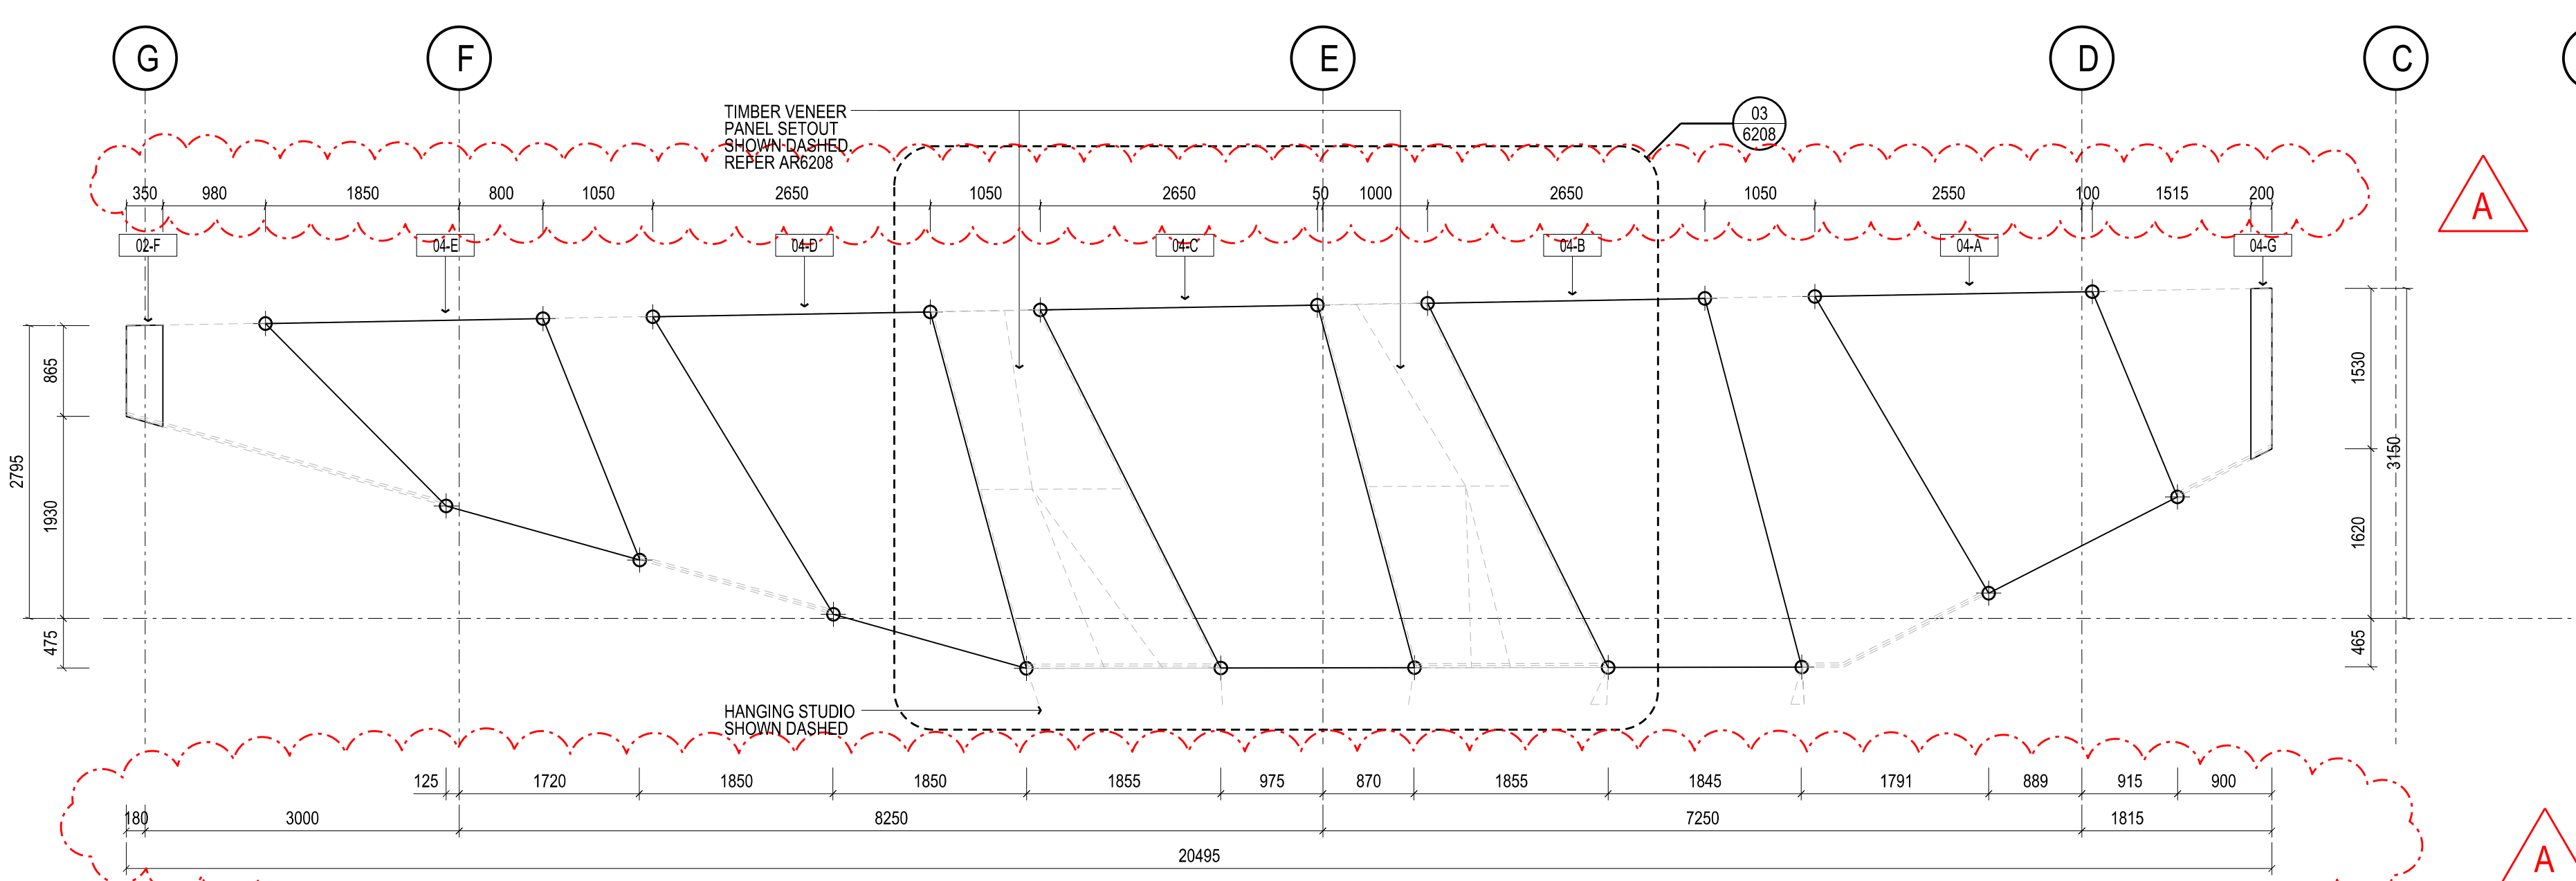

07 ROOF BAY 04 COFFERS - WEST SETOUT
SCALE 1:50

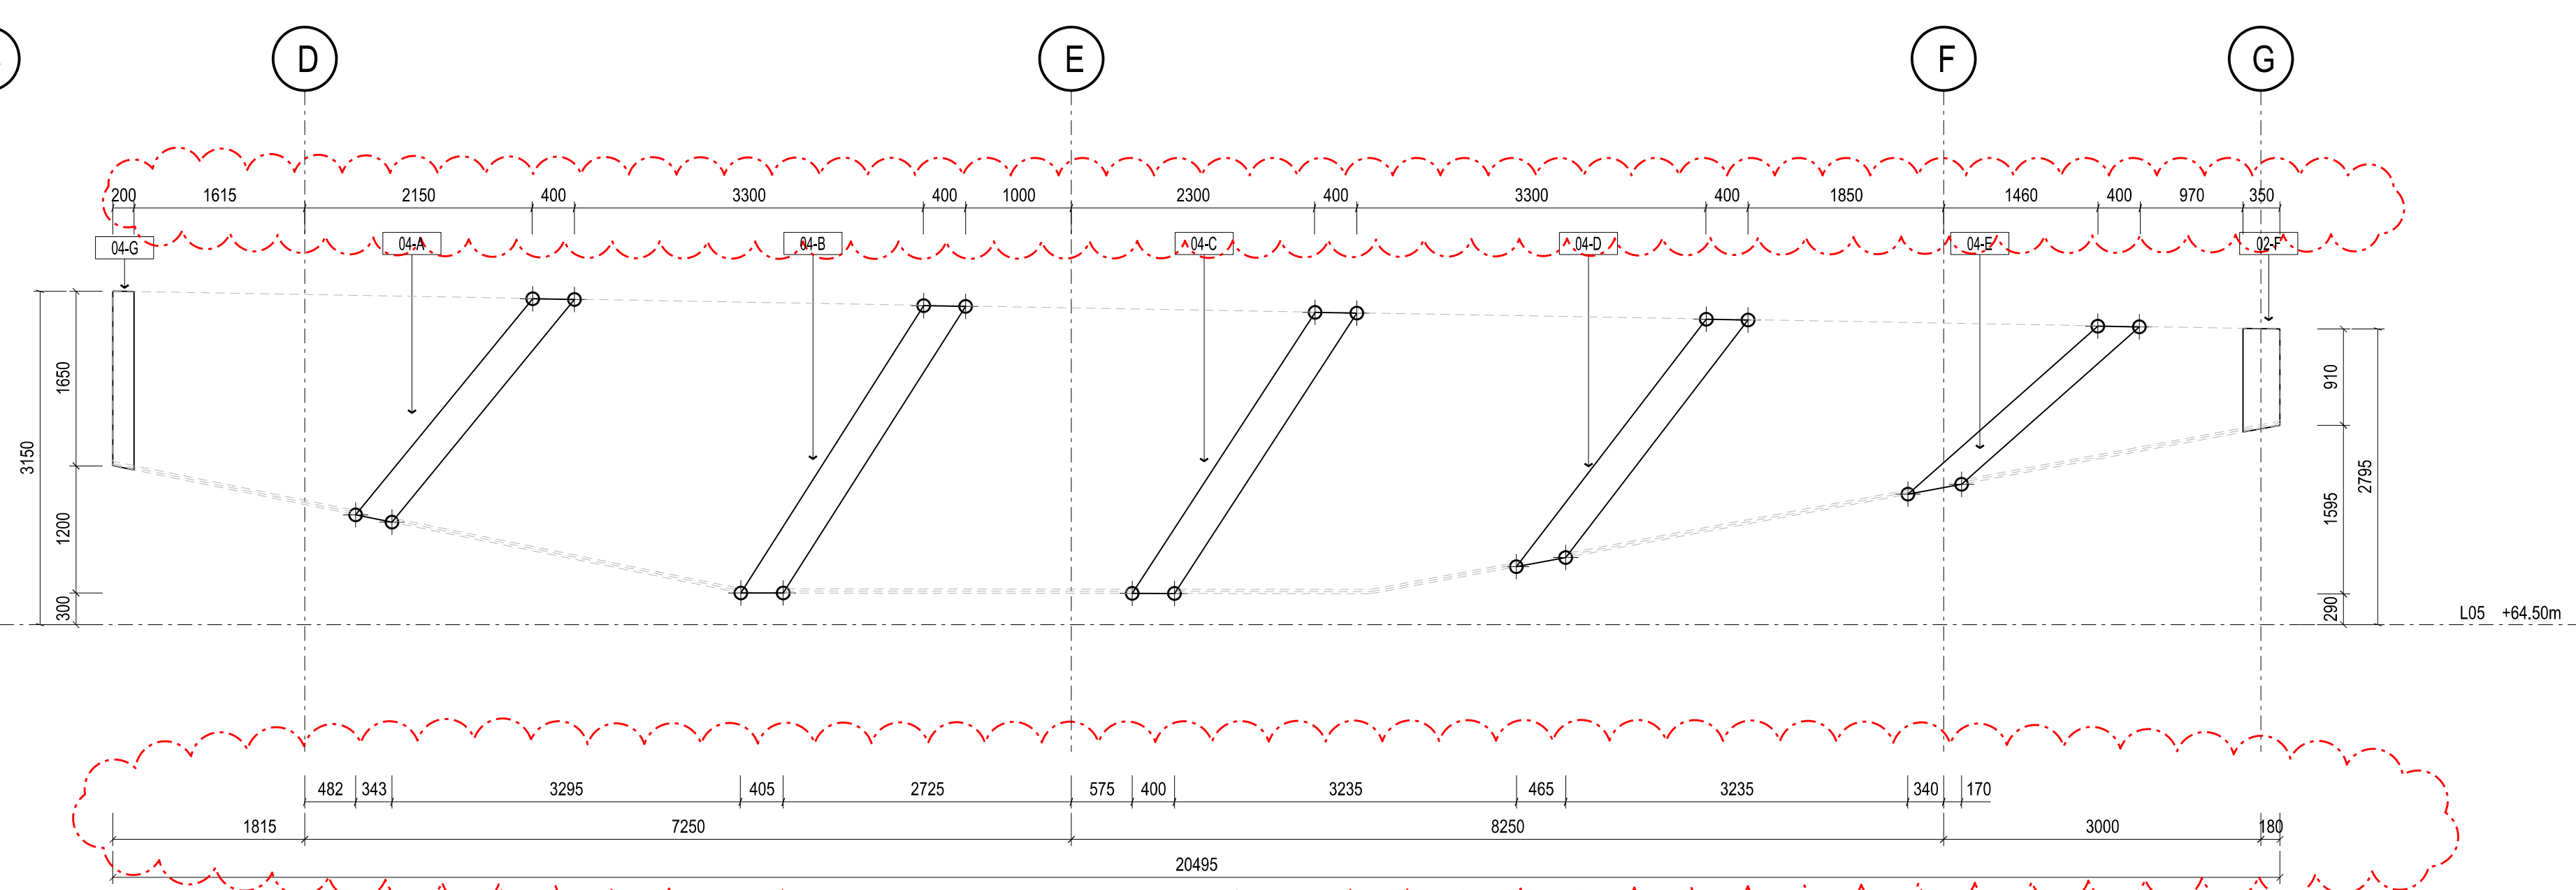

08 ROOF BAY 04 COFFERS - EAST SETOUT
SCALE 1:50

Rev	Issue	Revision Description	And	Date
A	SG	ISSUED FOR CONSTRUCTION	-	05.09.13
03	SG	100% CD - TENDER ISSUE	-	07.09.12
02	SG	90% CD ISSUE	-	10.08.12
01	SG	75% CD ISSUE	-	13.07.12



NADAAA
 NADAAA
 1920 Wellington Street No.2
 Boston Massachusetts
 02118 USA
 Telephone +1 617 442 2332
 Facsimile +1 888 442 1417
 Email nadaa@nadaaa.com

John Wardle Architects
 25 Rokeby Street, Collingwood, Victoria 3066 Australia
 Tel: +61 3 8662 0400 www.johnwardlearchitects.com
 © 2012 John Wardle Architects ABN 83 006 814 268

Client **University of Melbourne Parkville Campus**
 Project **Faculty of Architecture Building and Planning**

Title **ROOF DETAILS ATRIUM ROOF - COFFER SETOUT**

Project No.	0913	Scale	1:50 @ A0
Drawing No.	AR6206	Revision	A

Date: June 2012 Drawn: Co-Ord: Check:

FILENAME: SFILES
FOR CONSTRUCTION