










CONTRACTORS SHALL VERIFY JOB DIMENSIONS BEFORE ANY JOB COMMENCES. ALL SHOP DRAWINGS SHALL BE SUBMITTED TO THE SUPERINTENDENT AND MANUFACTURER SHALL NOT COMMENCE FROM THE RETURN OF DIMENSIONS SHOP DRAWINGS ISSUED BY THE CONSULTANT. FIGURED DIMENSIONS SHALL TAKE PRECEDENCE OVER SCALED. THIS DRAWING SHOULD BE READ IN CONJUNCTION WITH ALL RELEVANT CONTRACT SPECIFICATIONS AND DRAWINGS COPYRIGHT OF THIS DRAWING IS VESTED IN WARDLE.

General Notes

- 10mm SHADOWLINE TO ALL PANEL JOINTS UNLESS NOTED OTHERWISE
- ALL SETOUT DIMENSIONS TAKEN FROM CENTRELINE OF PANEL JOINT SHADOWLINE
- ALL DIMENSIONS ARE NOMINAL. PANEL SETOUT TO ALIGN WITH SETOUT OF CEILING COFFER SOFFIT PANELS.
- HJ - DENOTES HARLINE JOINT TO VENEERED CLADDING PANEL.
- EJ - DENOTES 10MM EXPRESSED JOINT BETWEEN VENEERED CLADDING PANELS.

↑ DENOTES GRAIN DIRECTION

▨ DENOTES OUTLINE OF COFFER TO OPPOSITE SIDE OF LVL BEAM

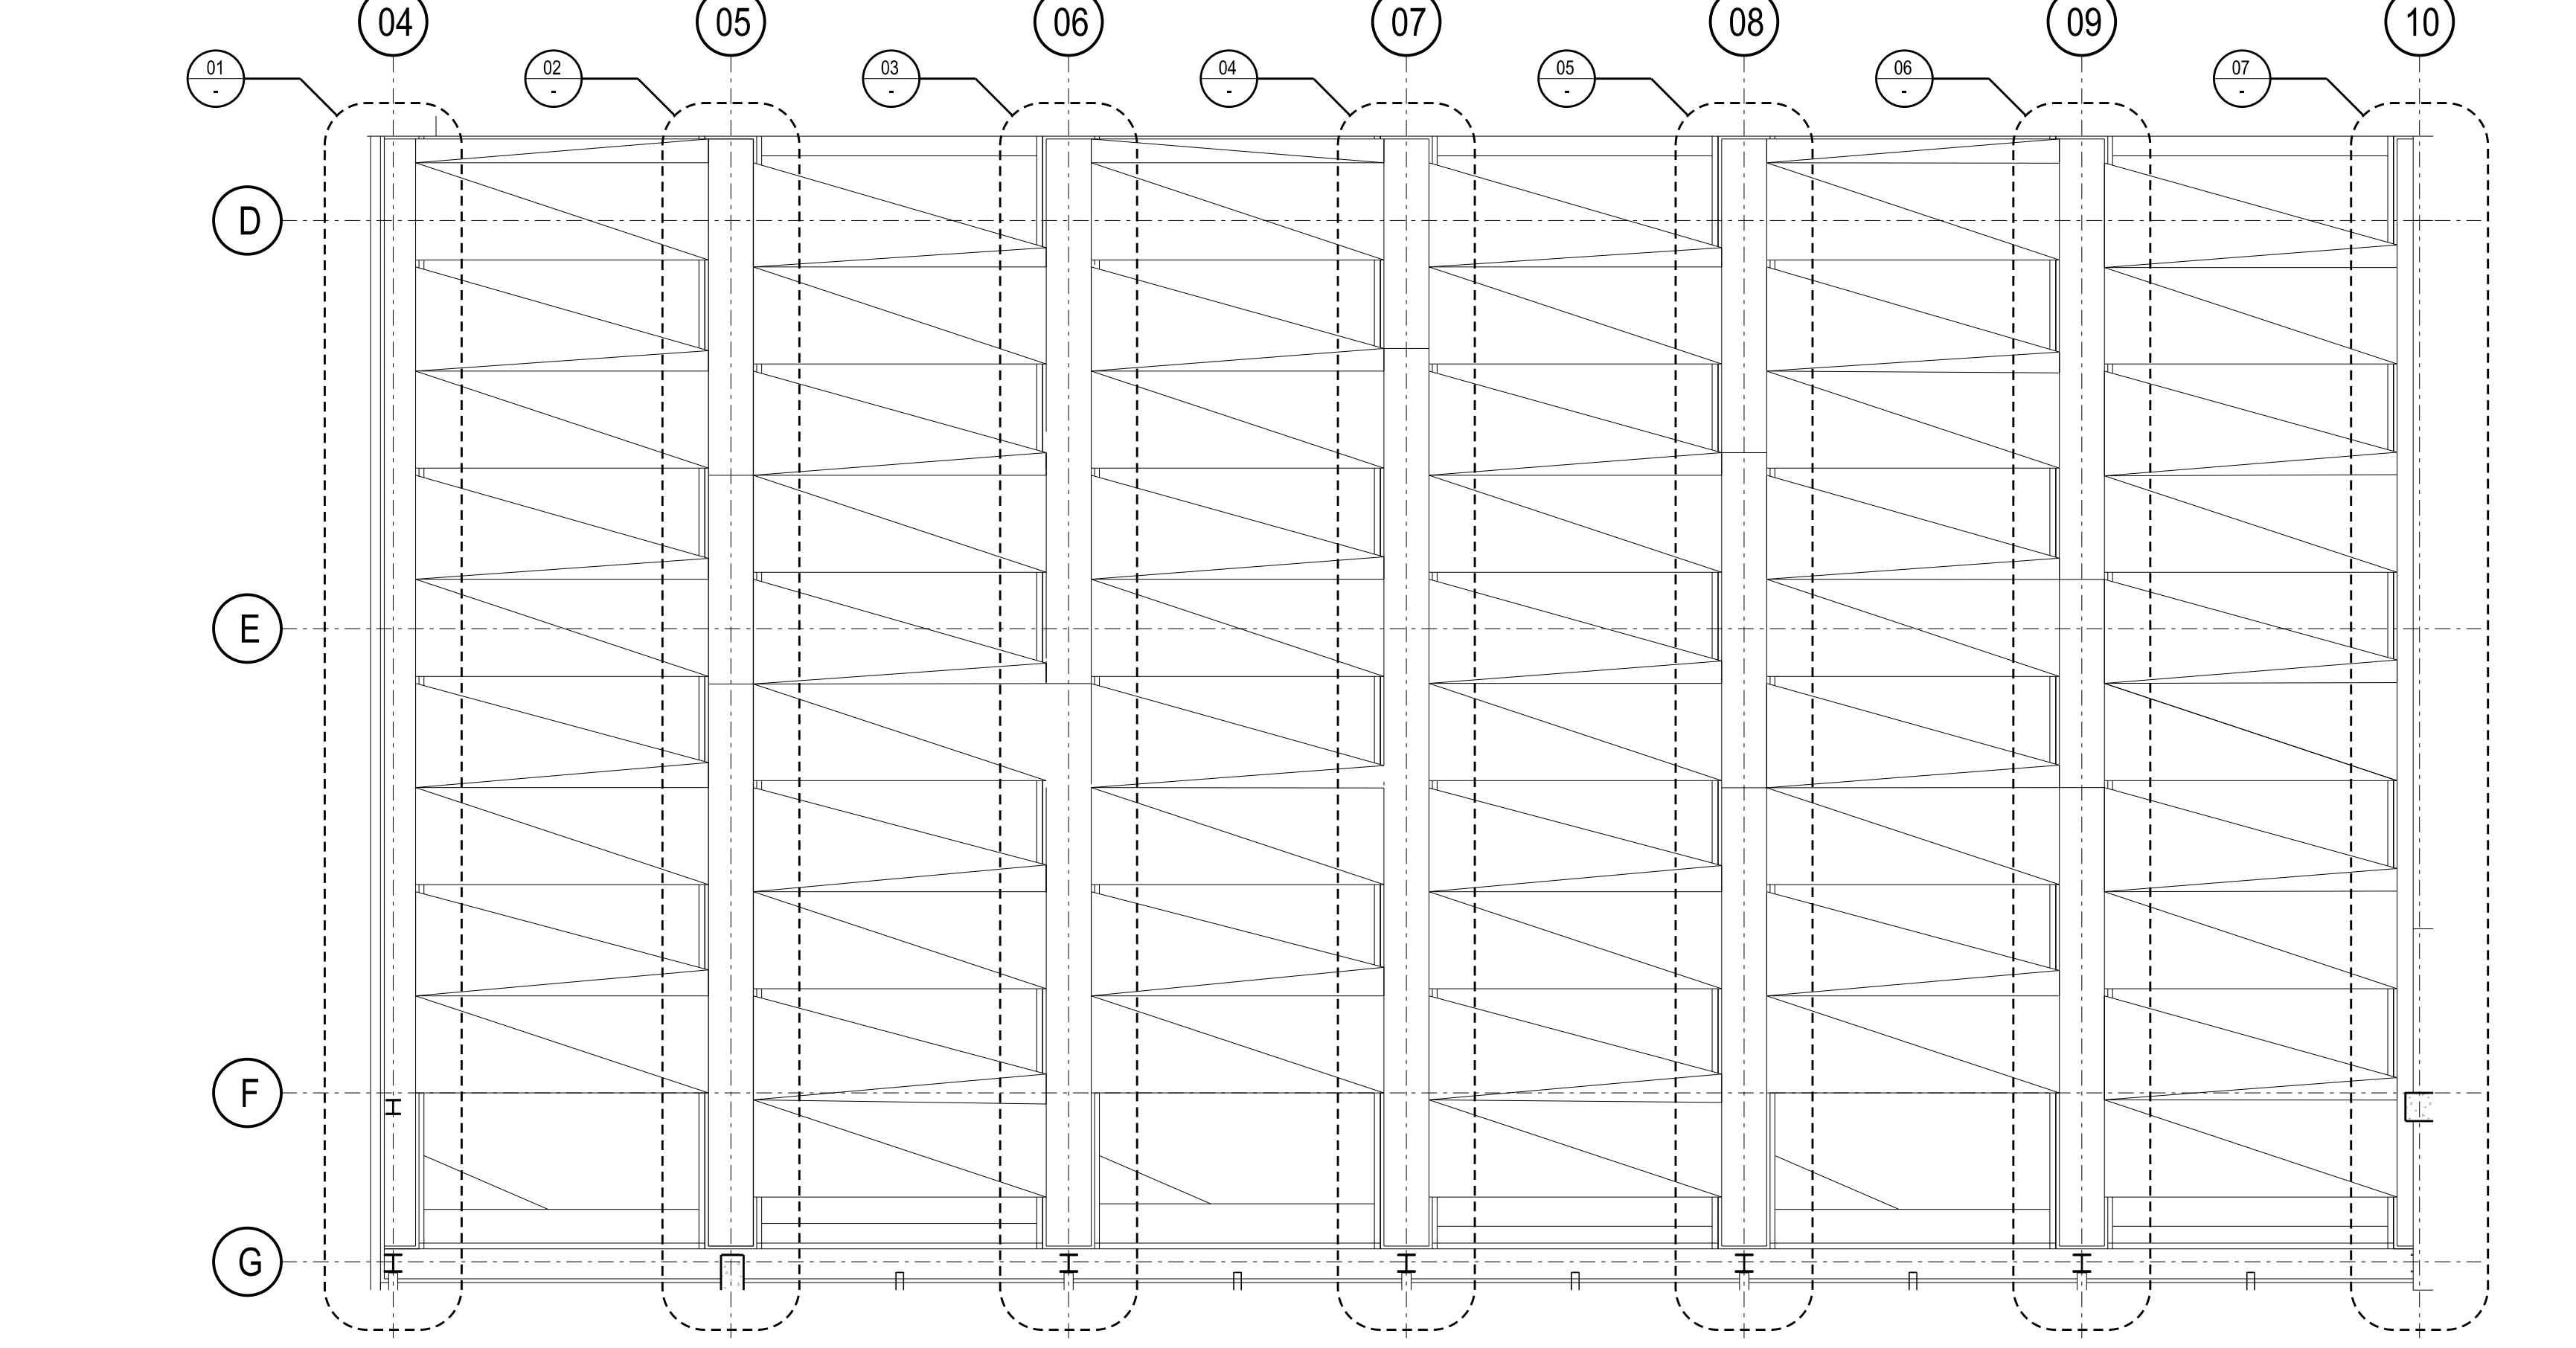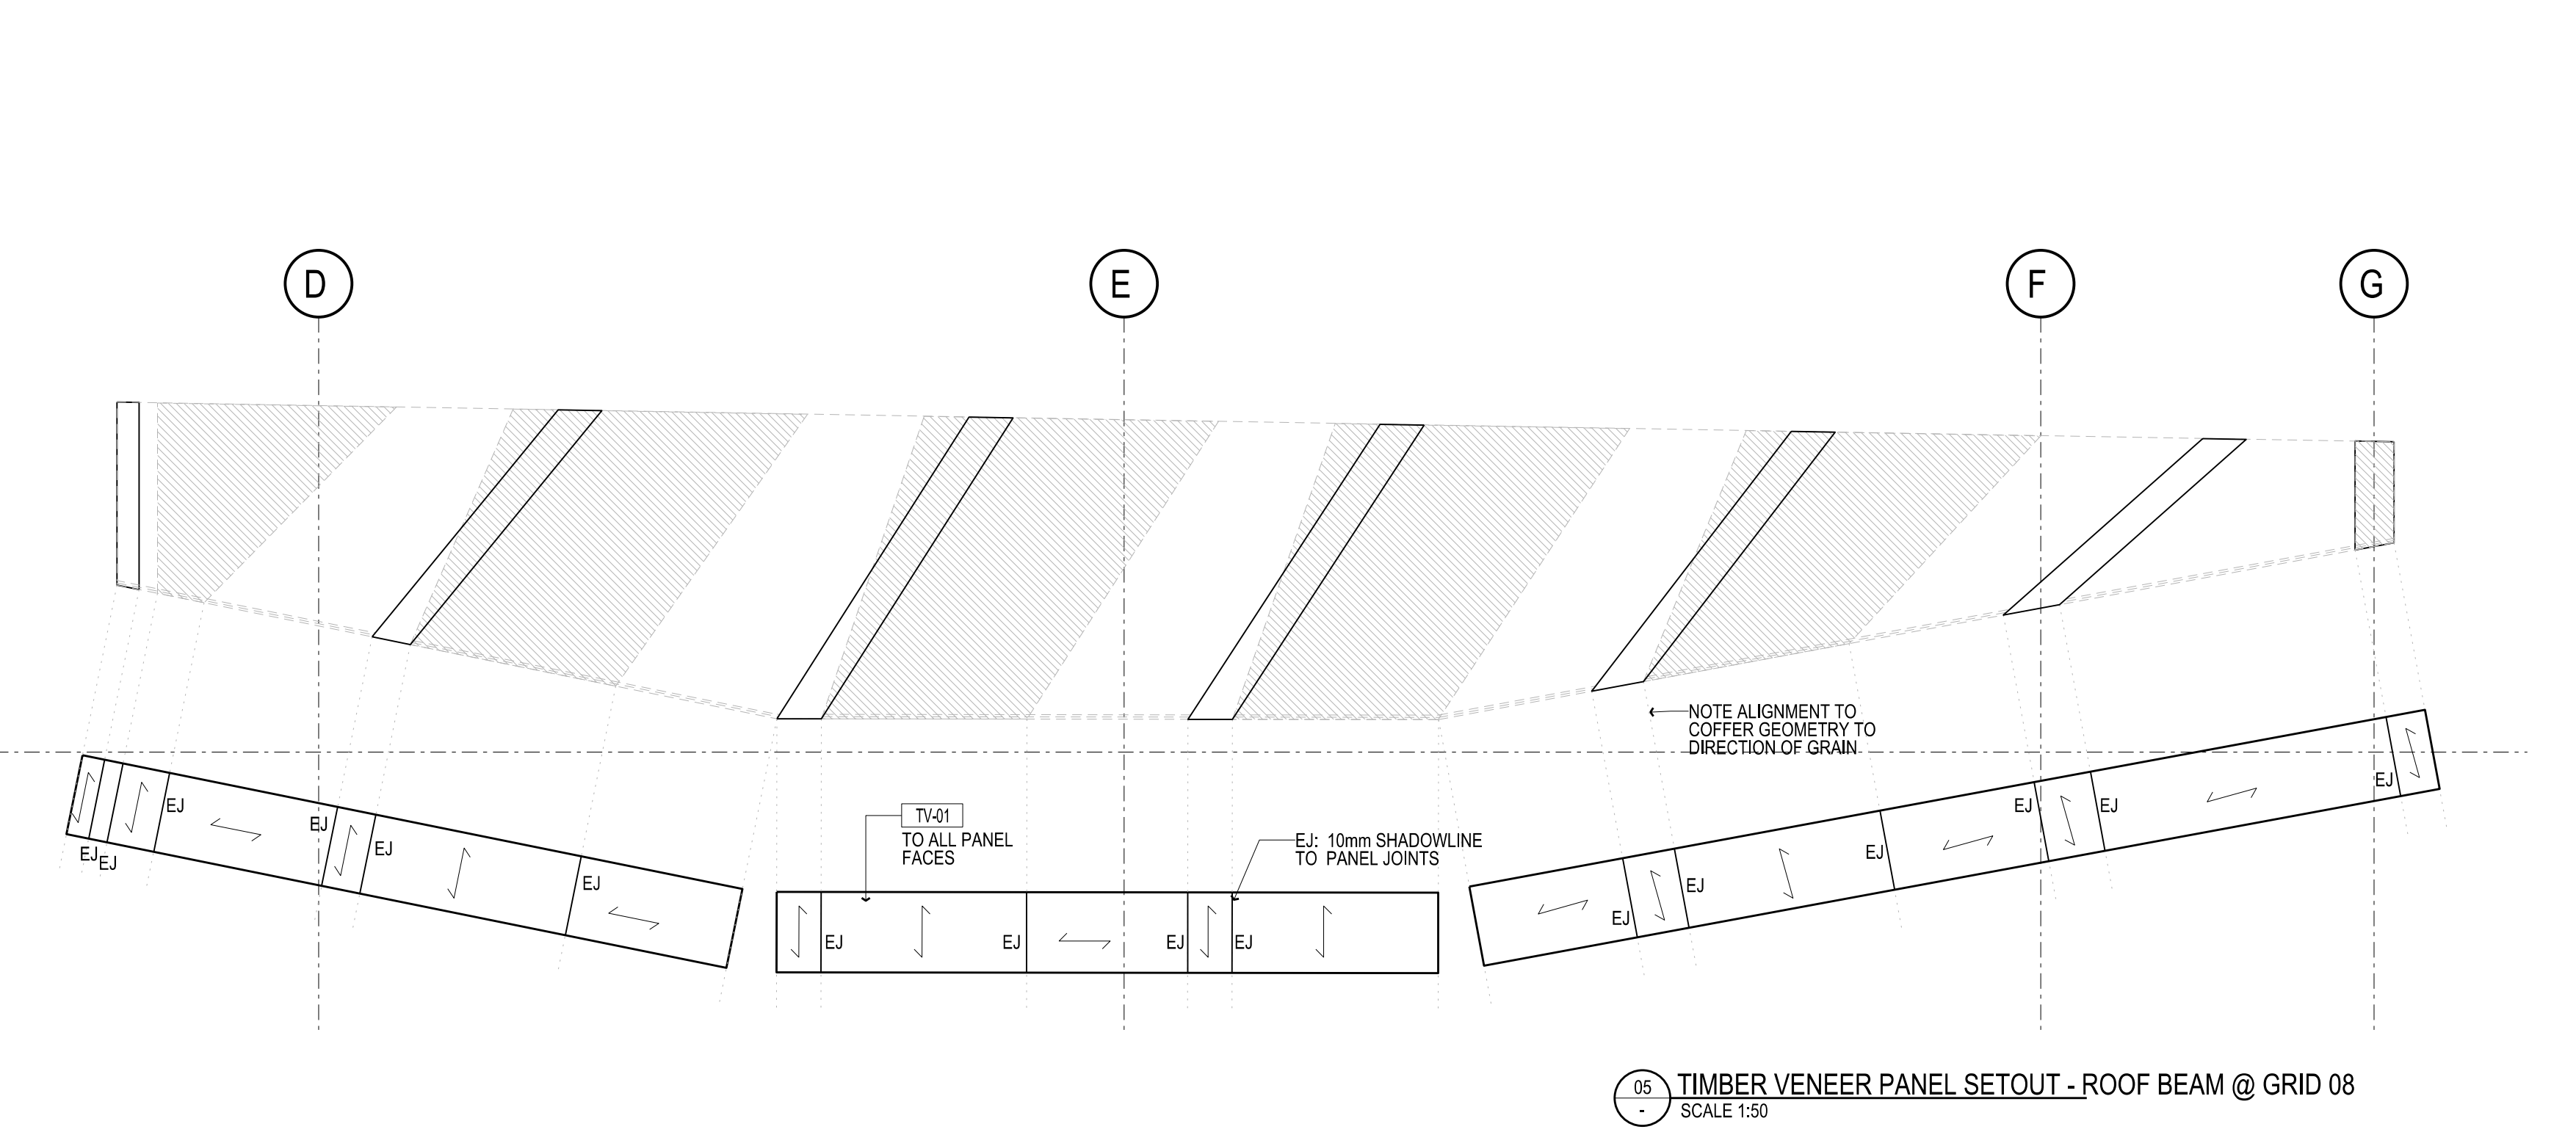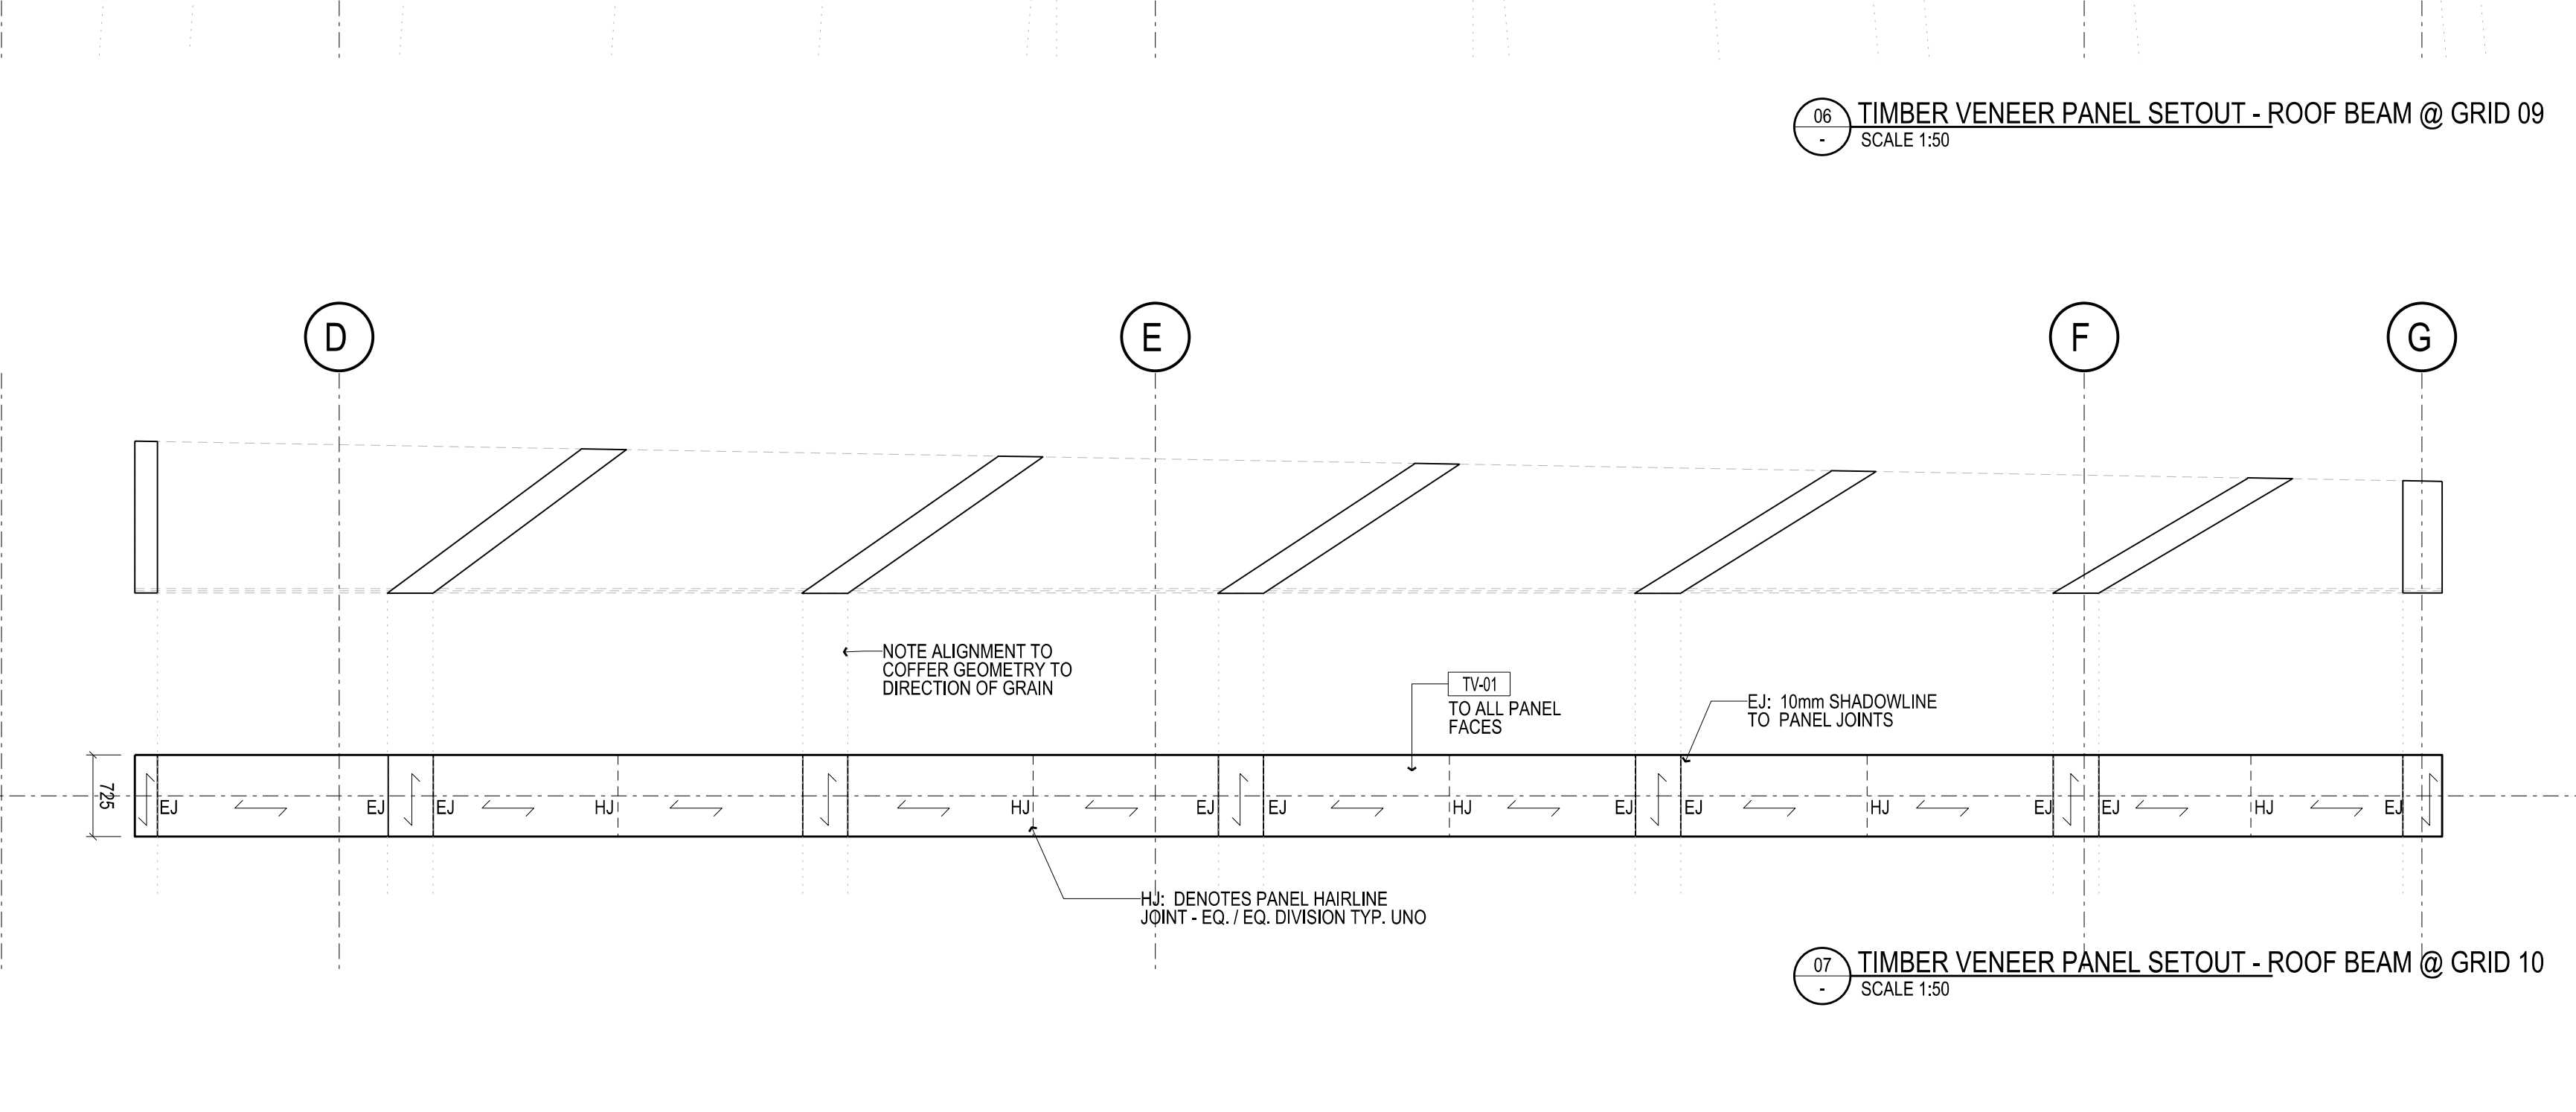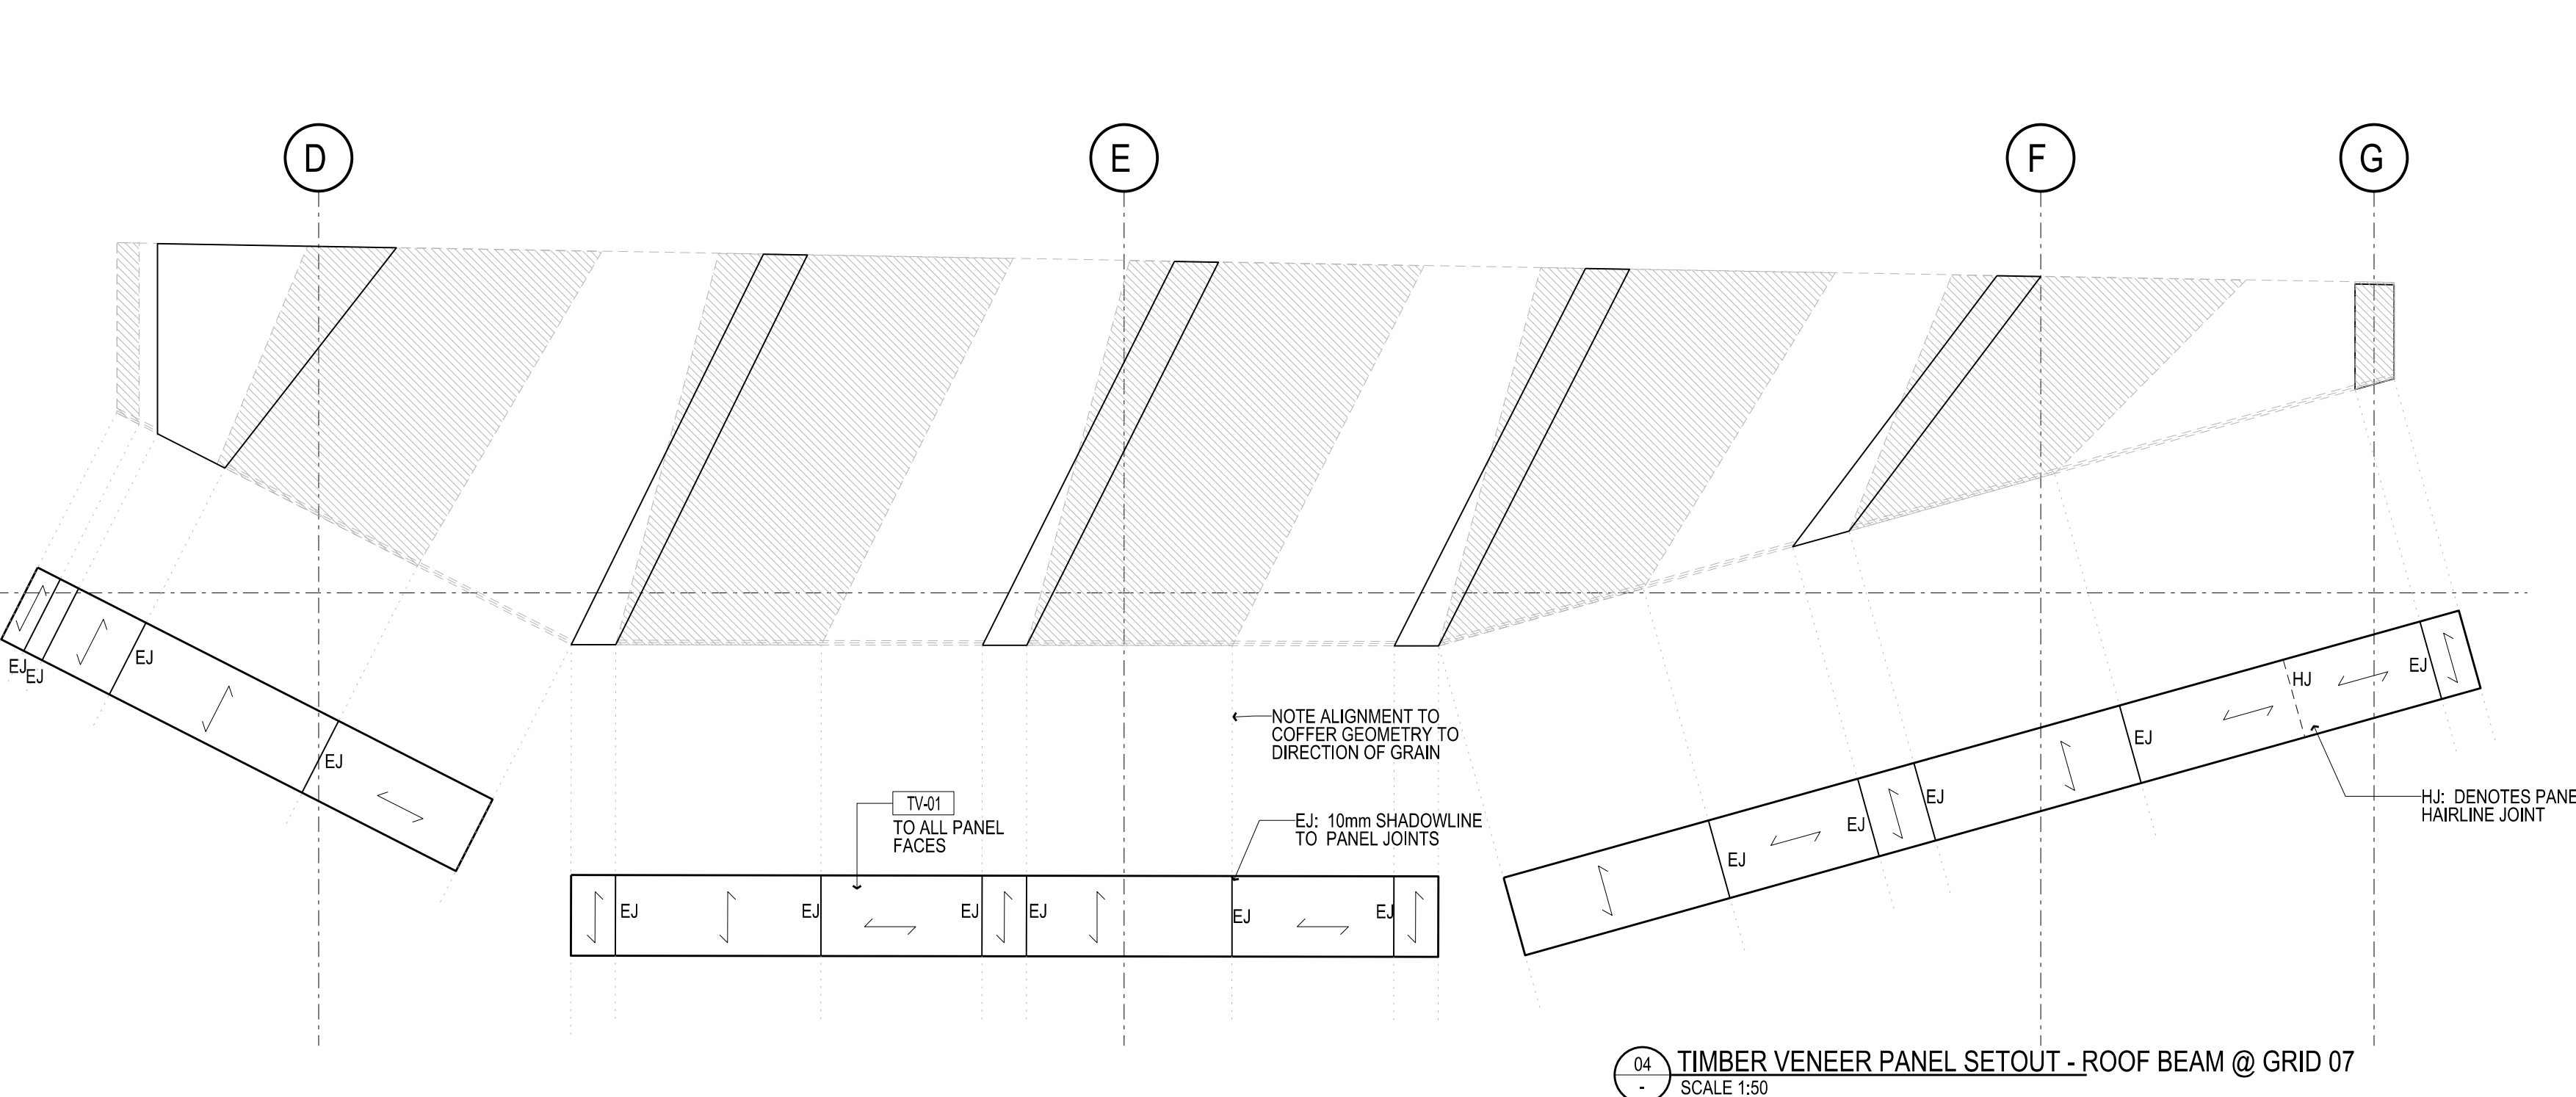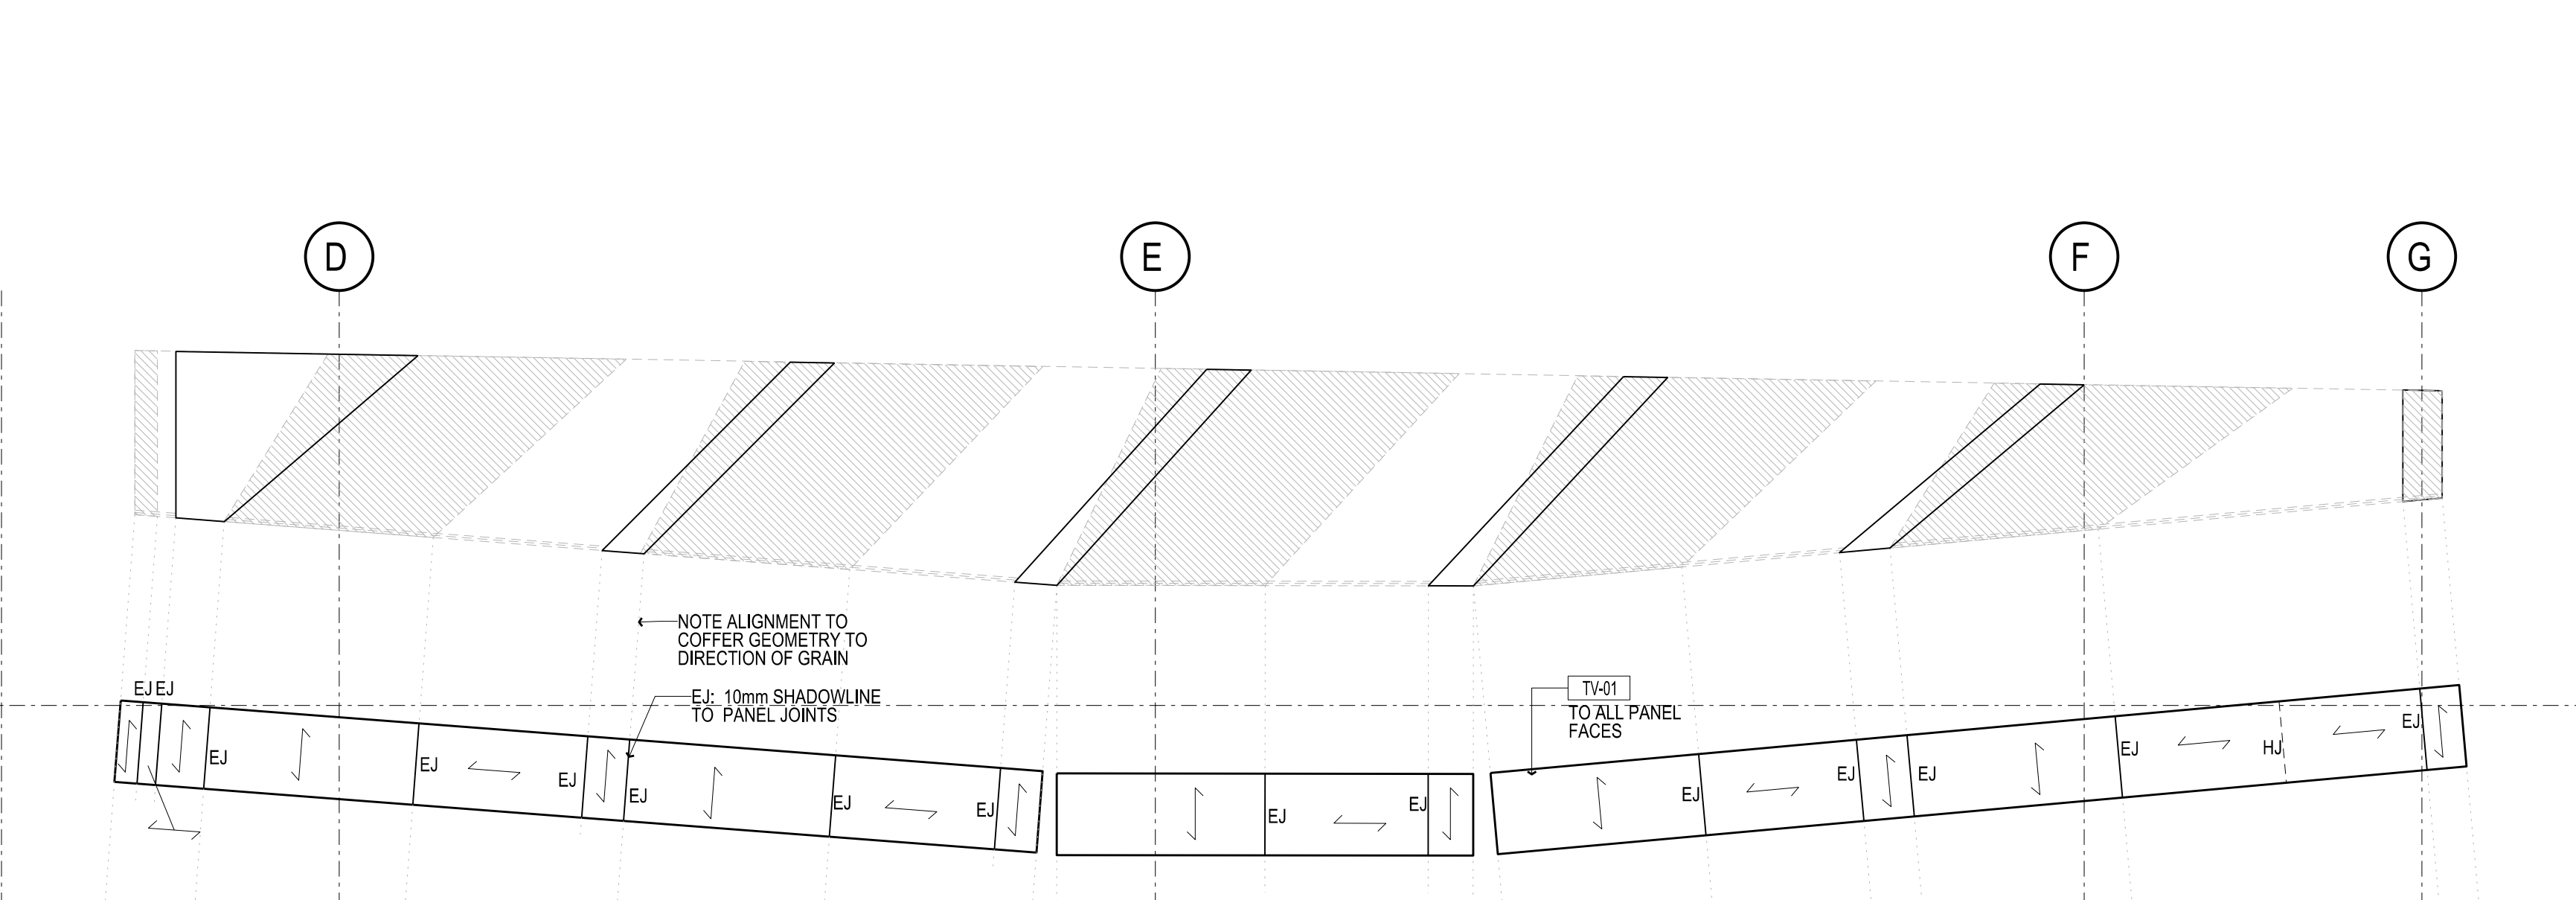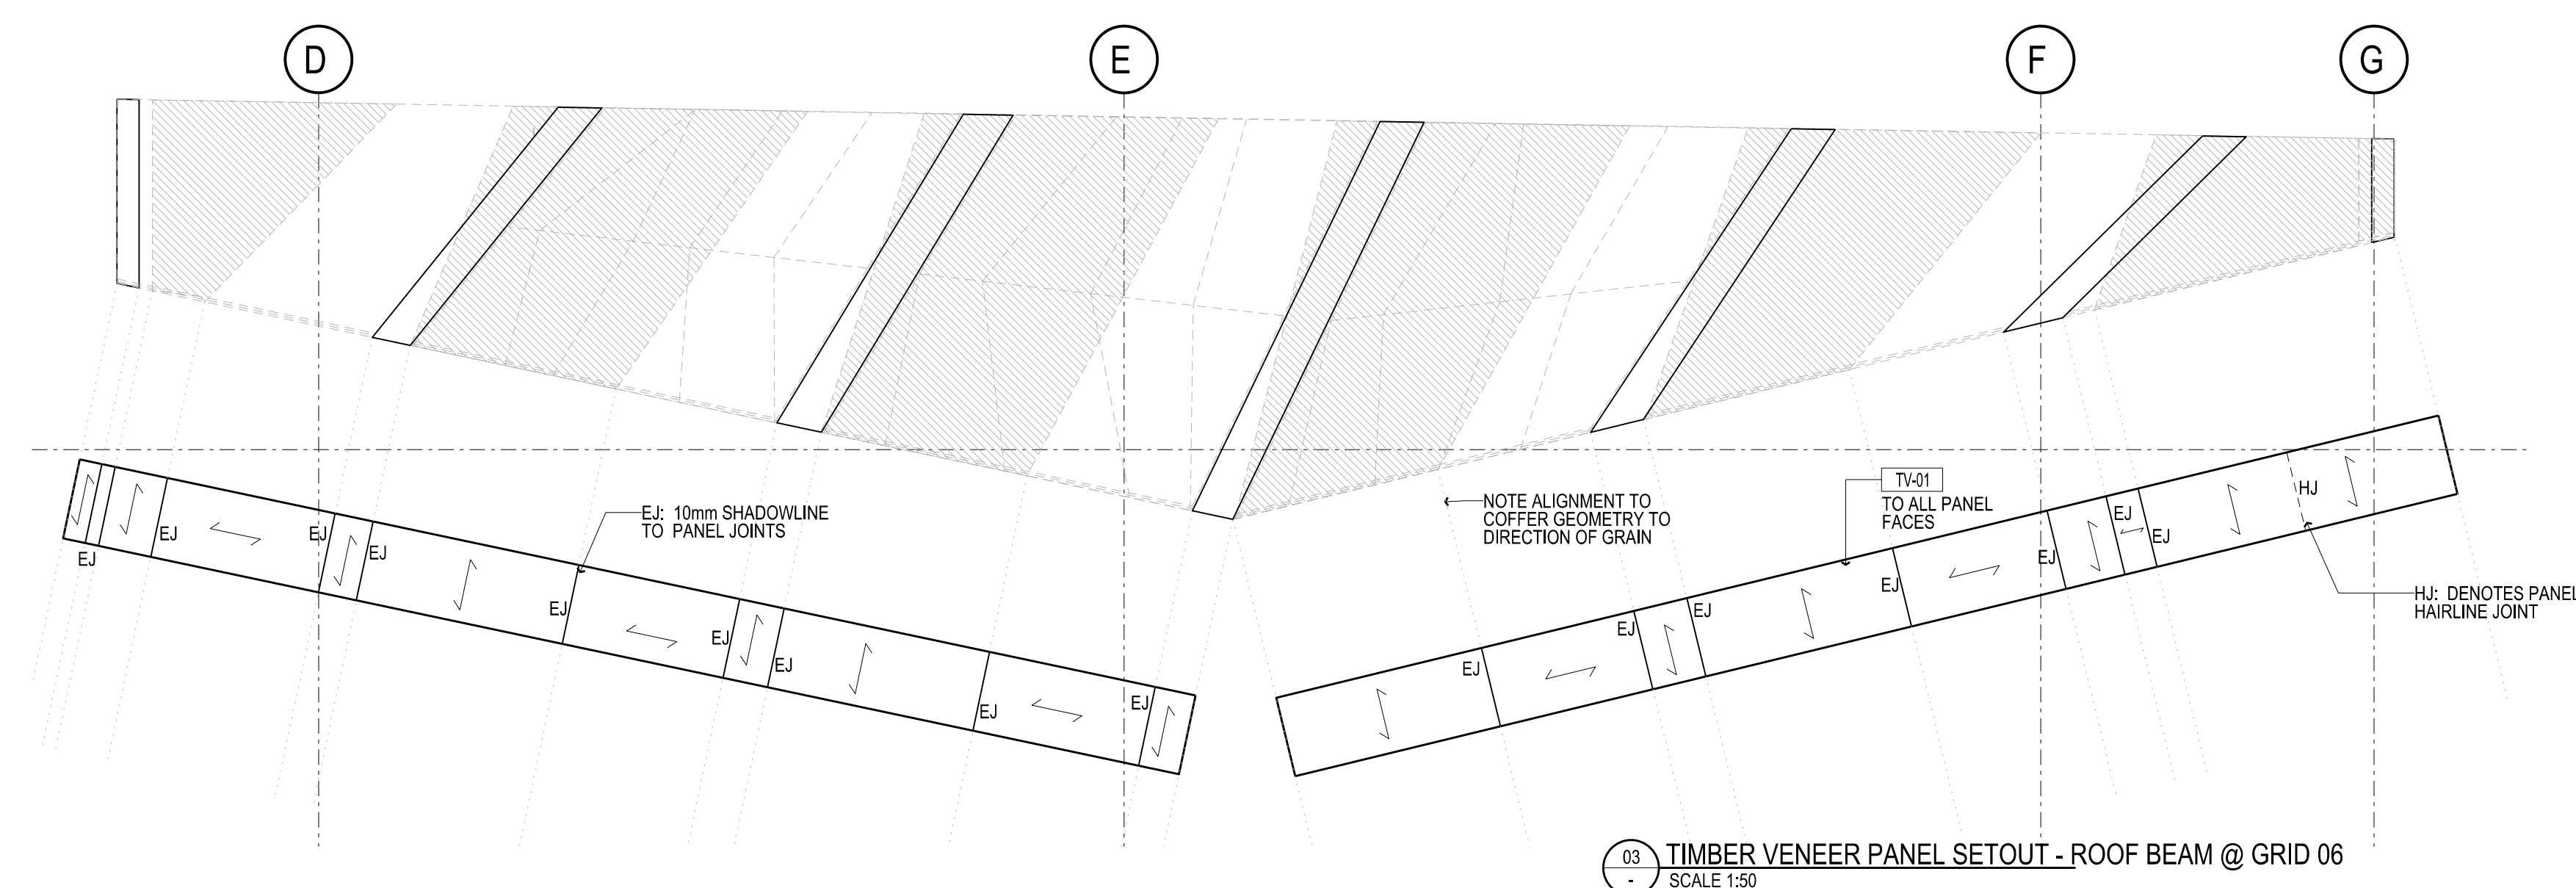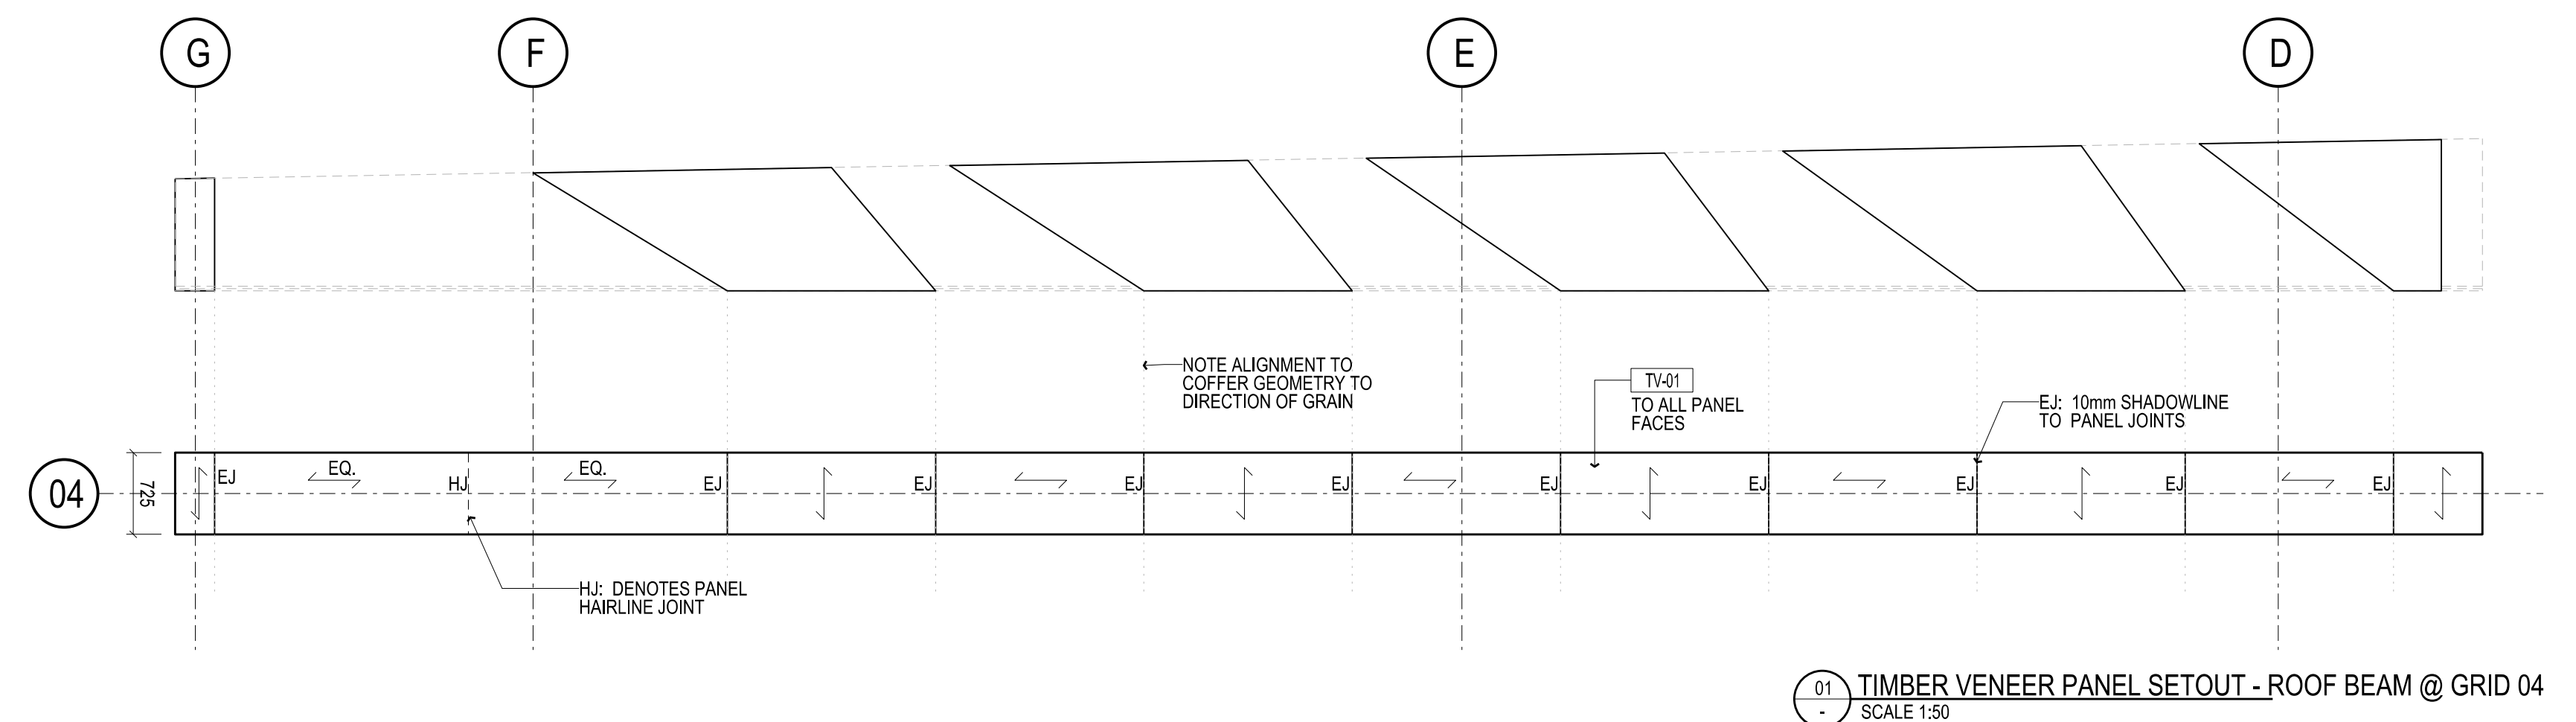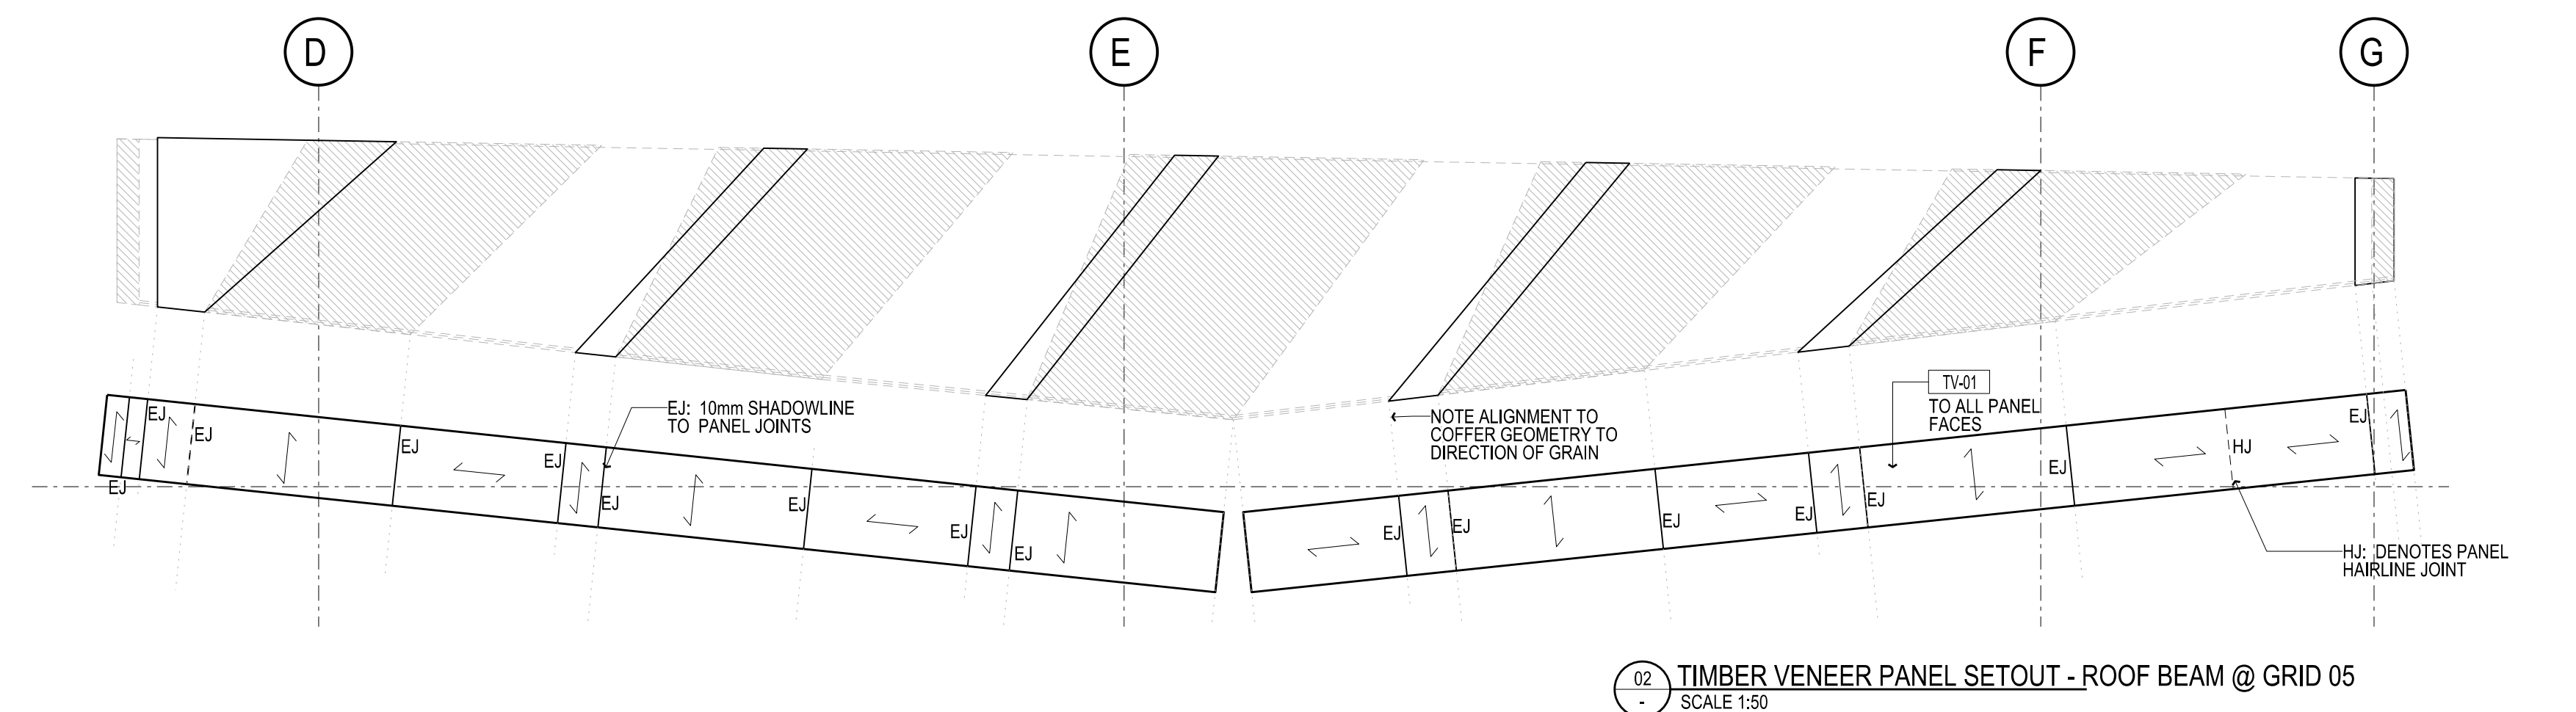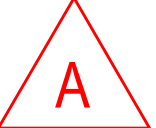

Rev	Issue	Revision Description	And	Date
		GRAIN DIRECTION CLARIFIED		21.11.13
A	SG	ISSUED FOR CONSTRUCTION		08.10.12
04	SG	TENDER ADDENDUM 4		08.10.12
03	SG	100% CD - TENDER ISSUE		07.09.12
02	SG	90% CD ISSUE		10.08.12
01	SG	75% CD ISSUE		13.07.12



NADAAA
 NADAAA
 1520 Washington Street No.2 Boston Massachusetts 02118 USA
 Telephone +1 617 442 8232 Facsimile +1 688 442 1417 Email nadaaa@nadaaa.com

John Wardle Architects
 25 Rokeby Street, Collingwood, Victoria 3066 Australia
 Tel: +61 3 8662 0400 www.johnwardlearchitects.com
 © 2012 John Wardle Architects ABN 83 006 814 268

Client **University of Melbourne Parkville Campus**

Project **Faculty of Architecture Building and Planning**

Title **ROOF DETAILS TIMBER VENEER PANEL SETOUT**

Project No.	0913	Scale	1:50 @ A0
Drawing No.	AR6209	Revision	A

Date: June 2012 Dwn: BS Co-Ord: - Chk: -

FILENAME: - \$FILES

FOR CONSTRUCTION