




General Notes

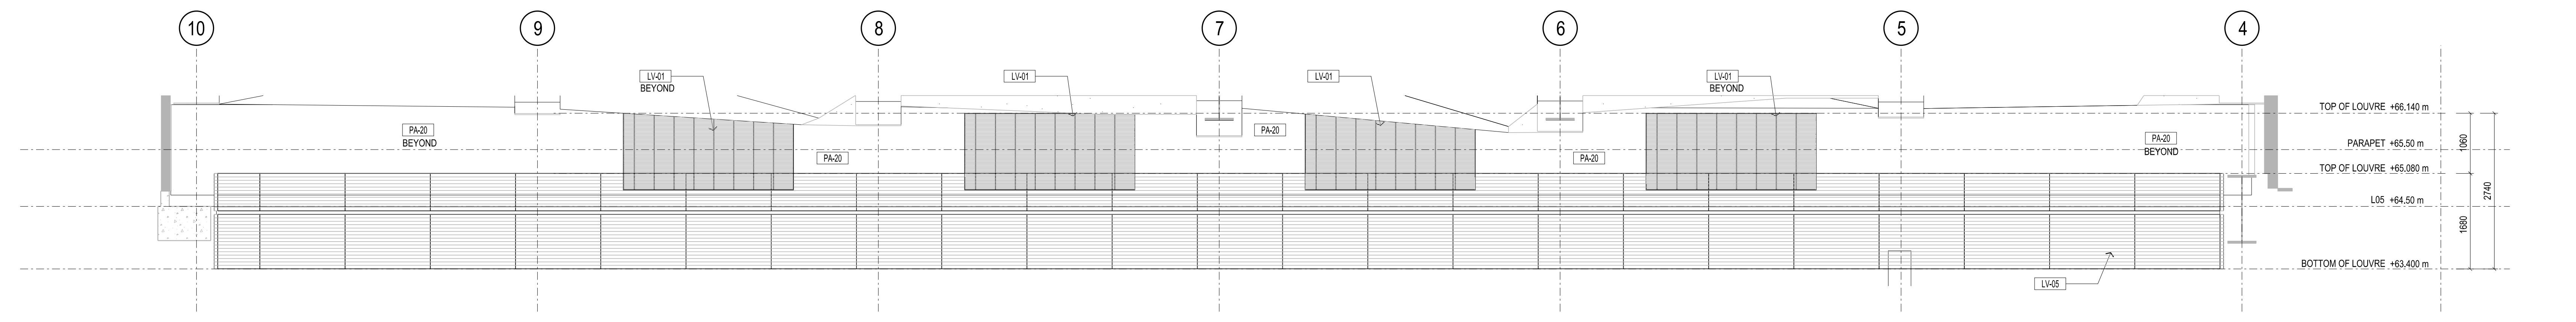


01 ATRIUM ROOF INTERNAL APRON - SOUTH
SCALE 1:50

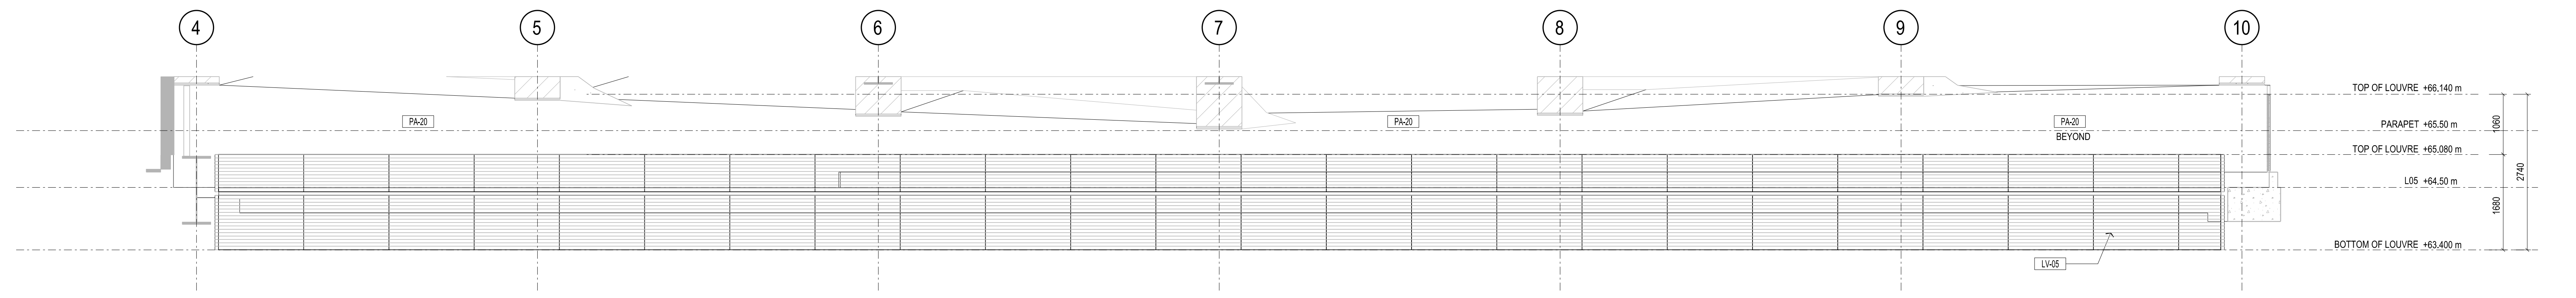


02 ATRIUM ROOF INTERNAL APRON - NORTH
SCALE 1:50

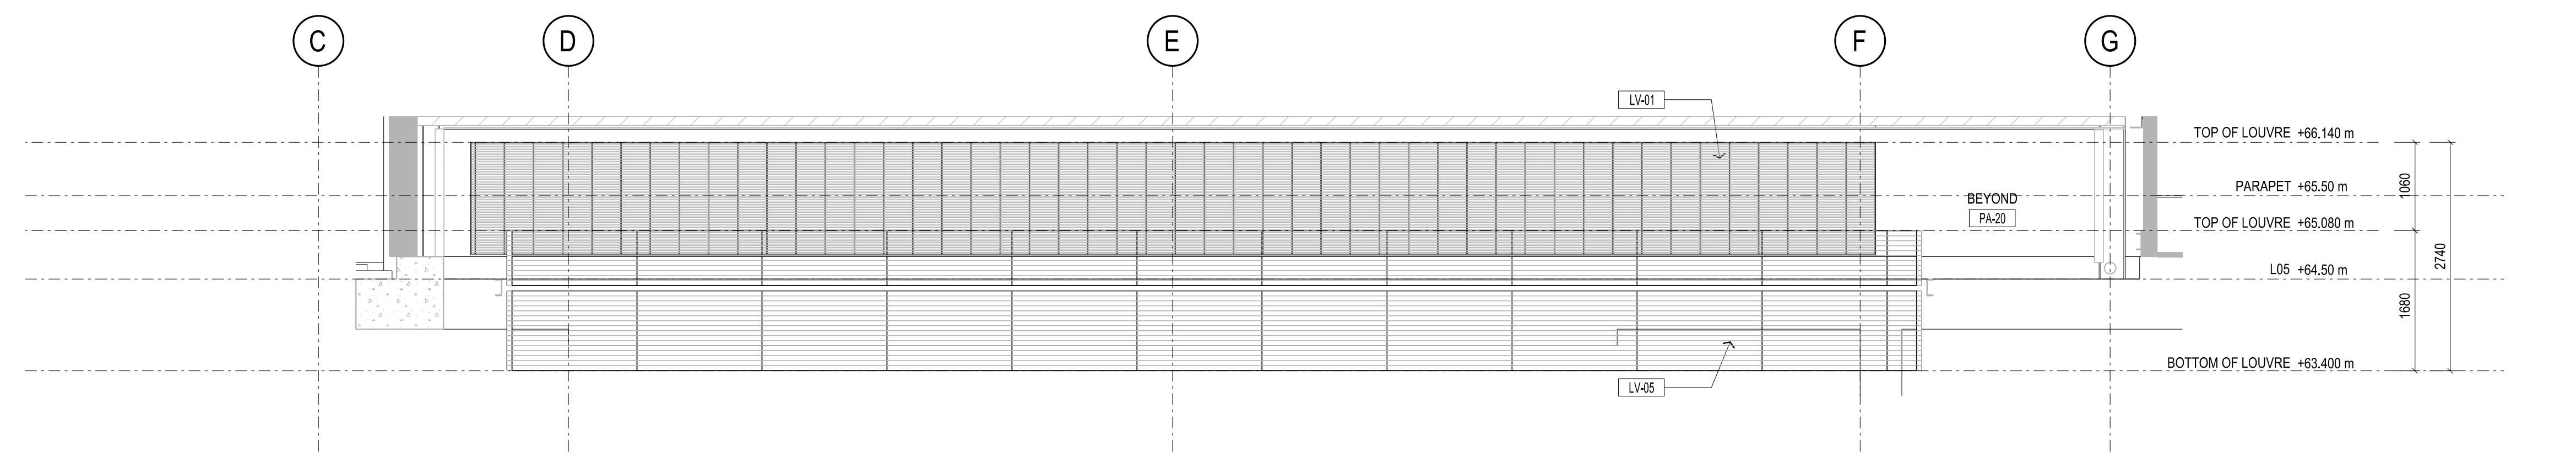

03 ATRIUM ROOF INTERNAL APRON - EAST
SCALE 1:50

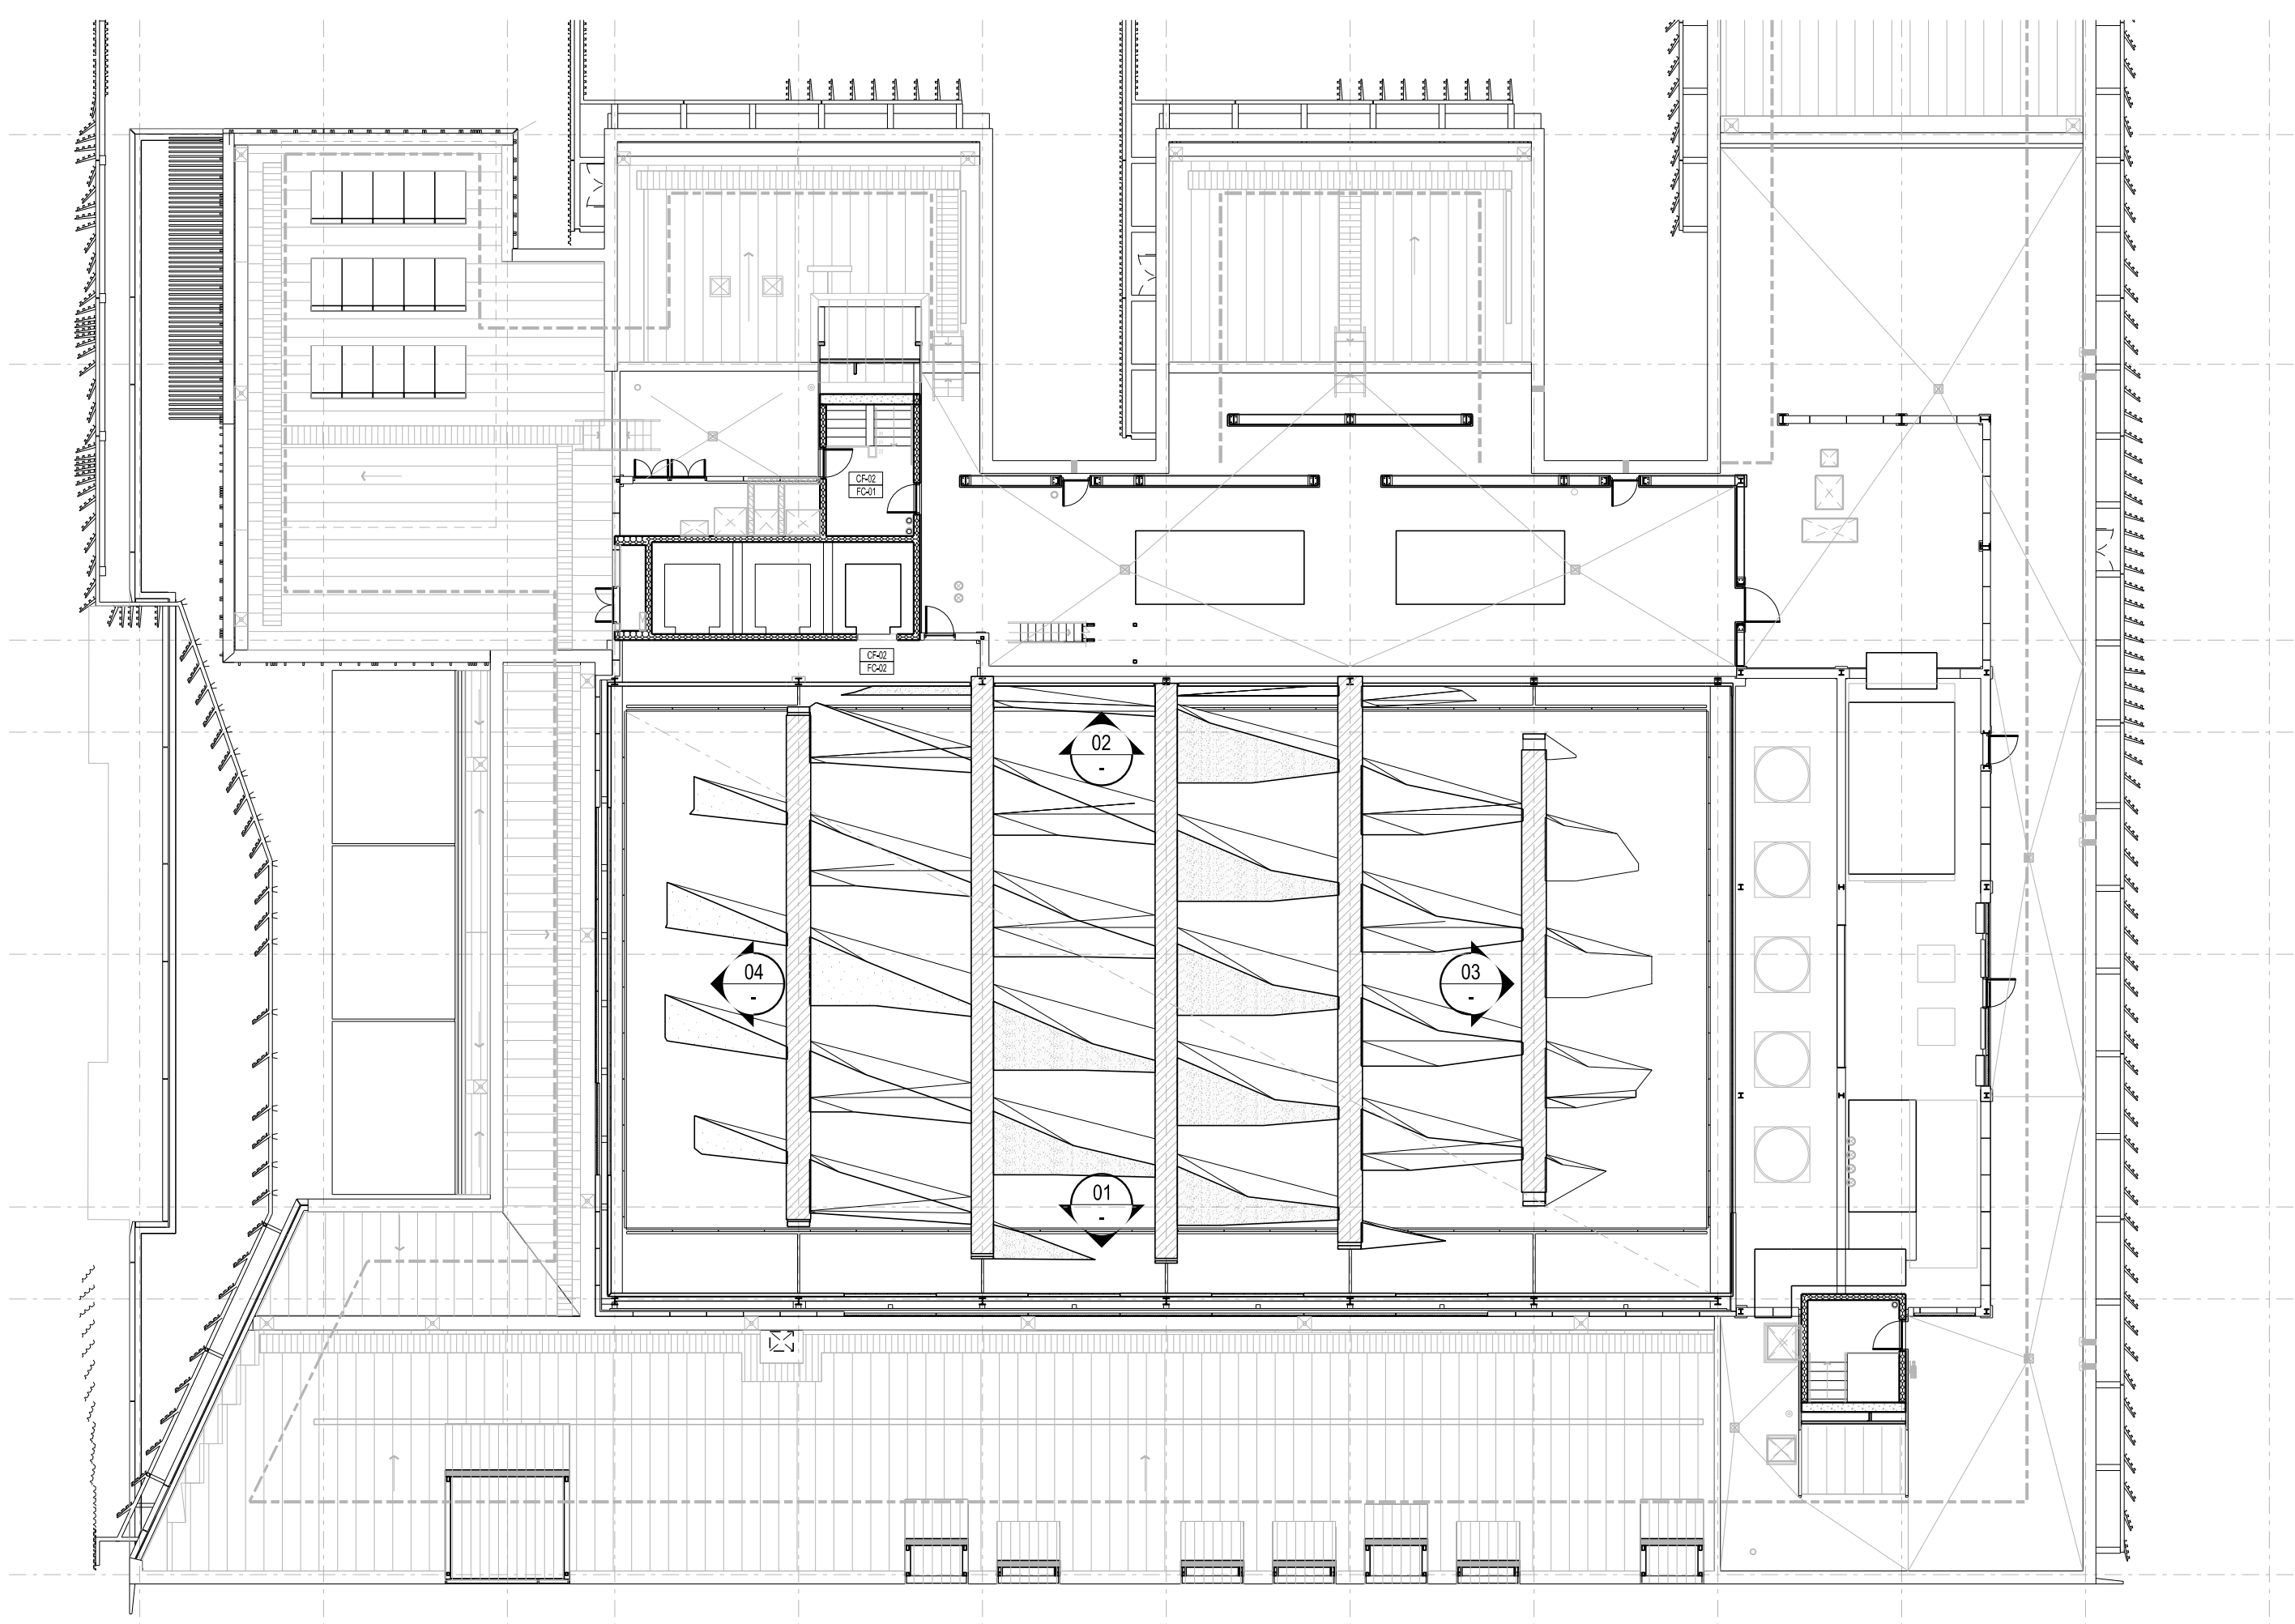

A KEYPLAN - ATRIUM CEILING
1:NTS

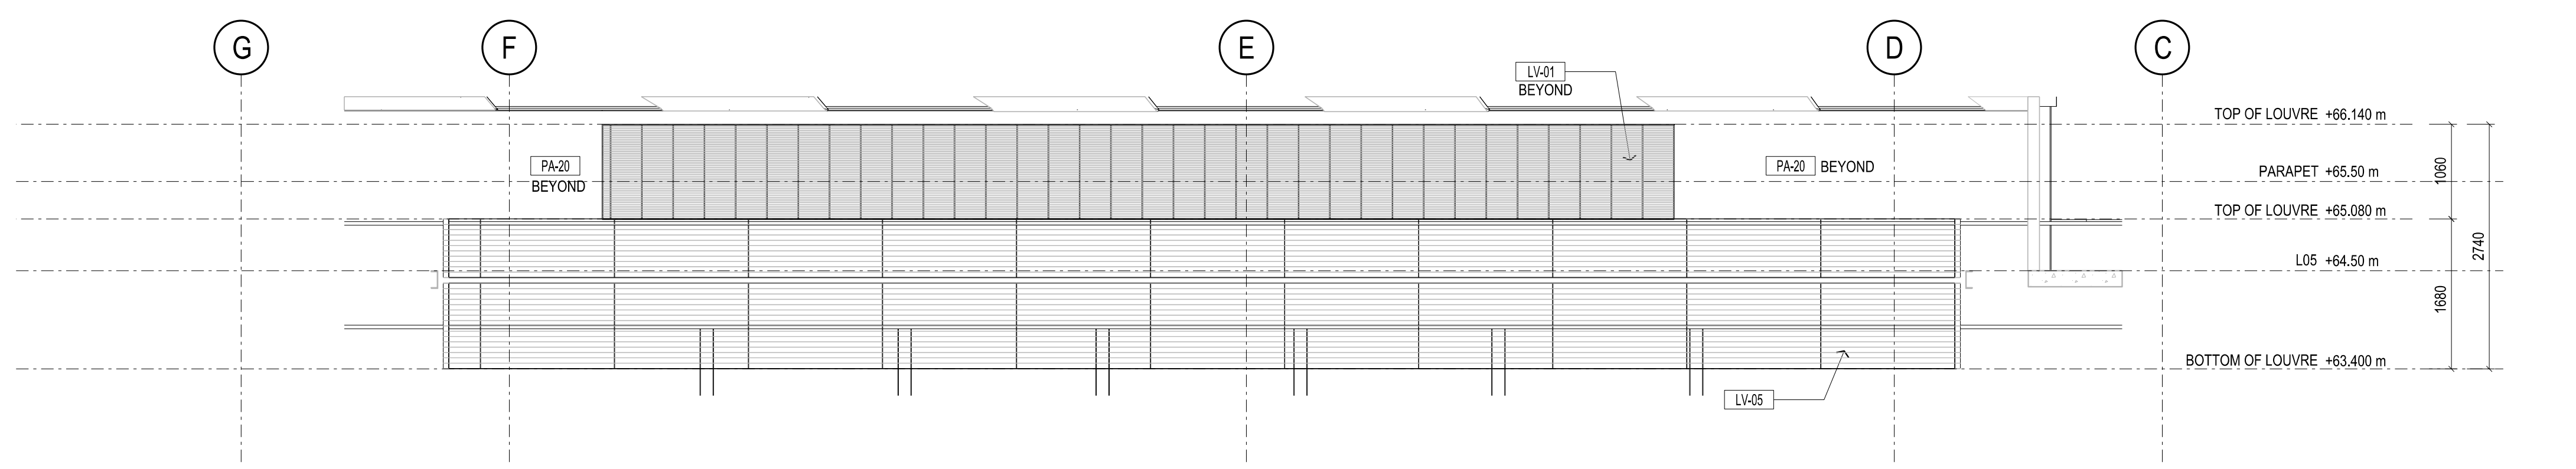

04 ATRIUM ROOF INTERNAL APRON - WEST
SCALE 1:50

A	SG	ISSUED FOR CONSTRUCTION	-	10.01.14
01	SG	100% CO - TENDER ISSUE	-	07.09.12



NADAAA
 NADAAA
 1520 Washington Street No.2 Boston Massachusetts 02118 USA
 Telephone +1 617 442 8232 Facsimile +1 688 442 1417 Email nadaaa@nadaaa.com

John Wardle Architects
 25 Rokeby Street, Collingwood, Victoria 3066 Australia
 Tel: +61 3 8662 0400 www.johnwardlearchitects.com
 © 2012 John Wardle Architects ABN 83 006 814 268

Client **University of Melbourne Parkville Campus**
 Project **Faculty of Architecture Building and Planning**

Title **ROOF DETAILS ATRIUM ROOF - APRON ELEVATIONS**

Project No.	0913	Scale	1:50 @ A0
Drawing No.	AR6220	Revision	A

Date	Aug 2012	Dwn	AK	Co-Ord	-	Chk	-
------	----------	-----	----	--------	---	-----	---

FILENAME - SFILES
FOR CONSTRUCTION