



CONTRACTORS SHALL VERIFY JOB DIMENSIONS BEFORE ANY JOB COMMENCES. ALL SHOP DRAWINGS SHALL BE SUBMITTED TO THE SUPERINTENDENT AND MANUFACTURER SHALL NOT COMMENCE FROM THE RETURN OF DIMENSIONS SHOP DRAWINGS ISSUED BY THE CONSULTANT. FIGURED DIMENSIONS SHALL TAKE PRECEDENCE OVER SCALES. THIS DRAWING SHALL BE READ IN CONJUNCTION WITH ALL RELEVANT CONTRACT SPECIFICATIONS AND DRAWINGS COPYRIGHT OF THIS DRAWING IS VESTED IN NADAAA


General Notes & Legend

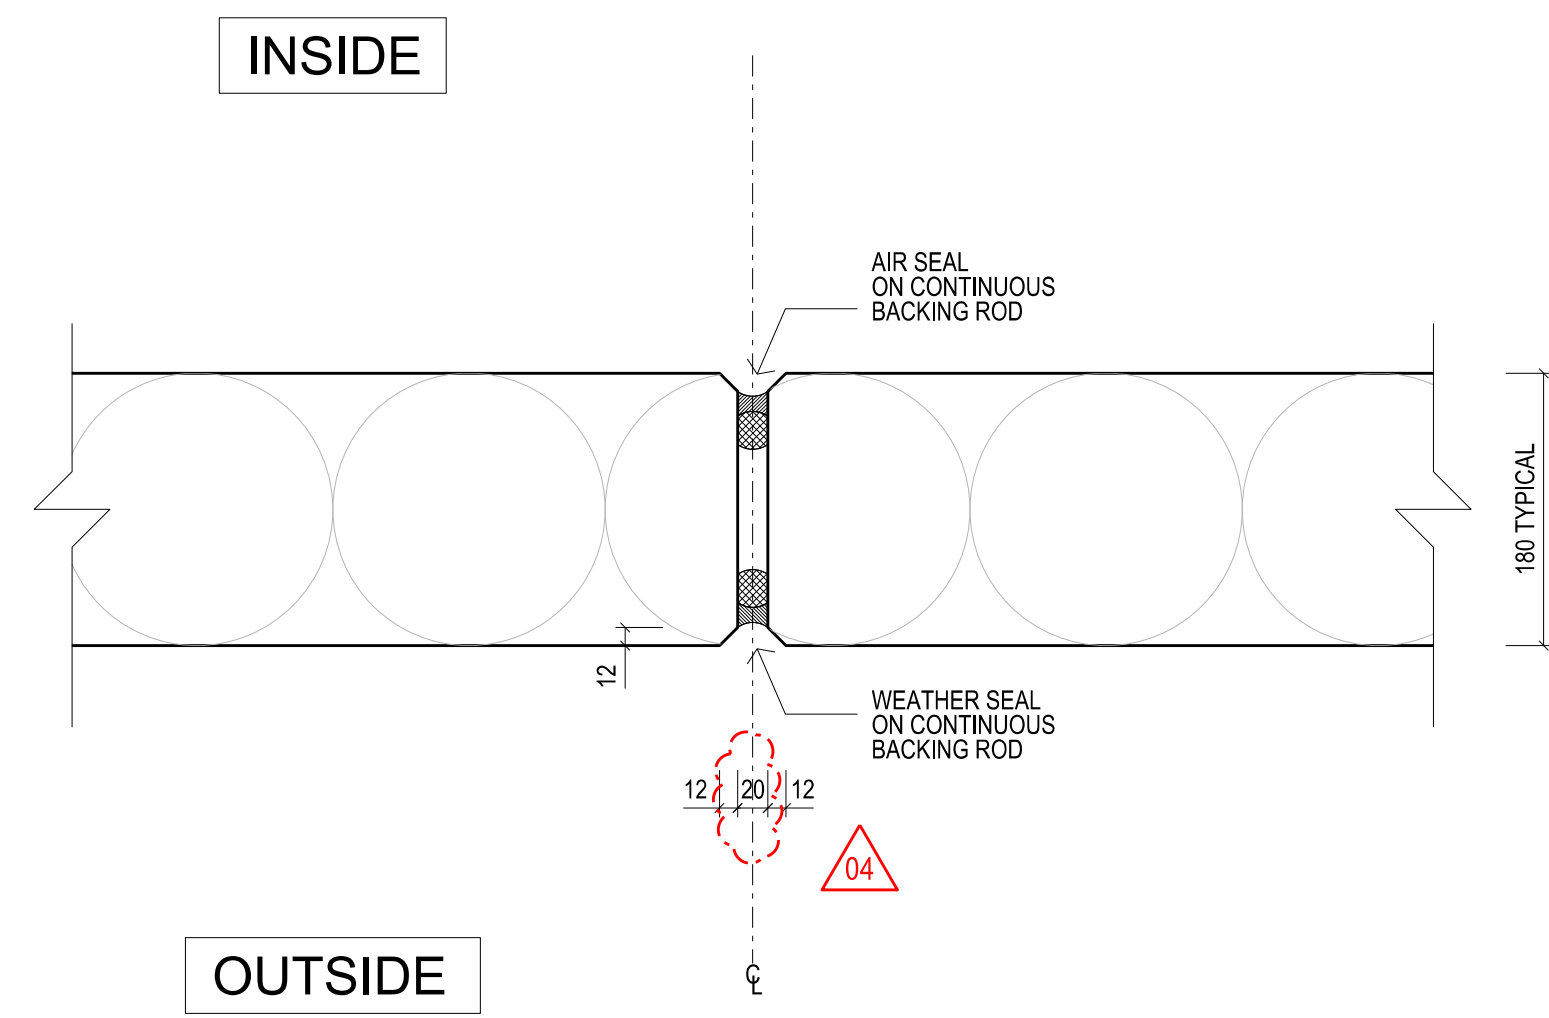


01 PLAN DETAIL TYPICAL VERTICAL JOINT SCALE 1:5

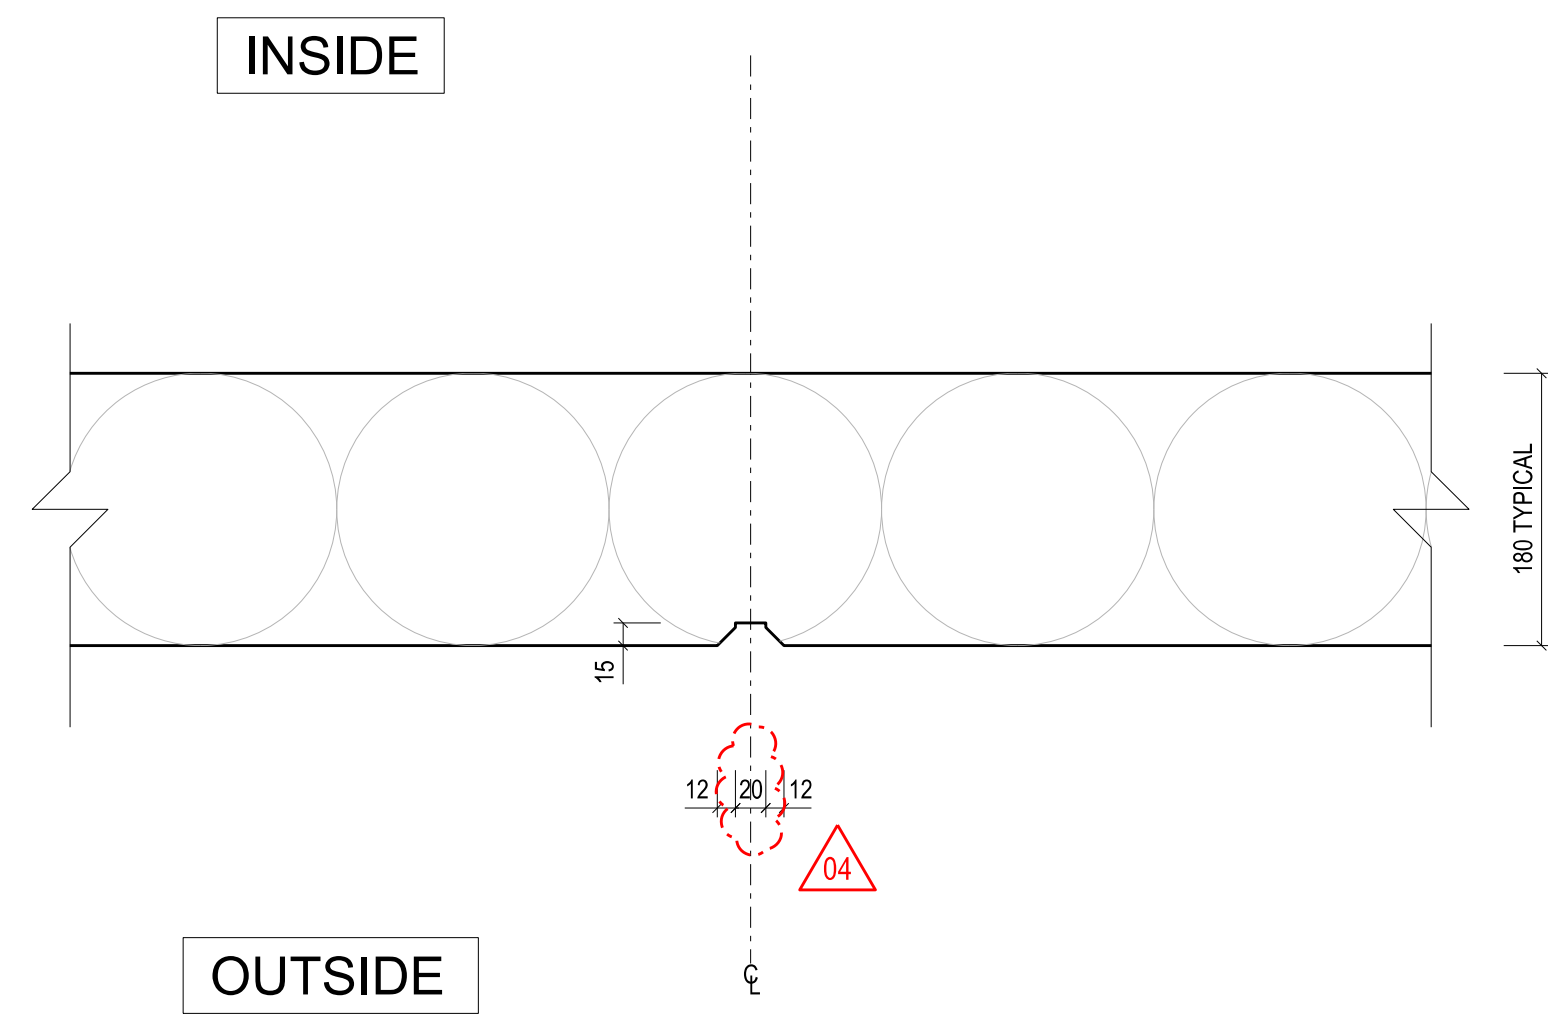


02 PLAN DETAIL TYPICAL VERTICAL FALSE JOINT SCALE 1:5

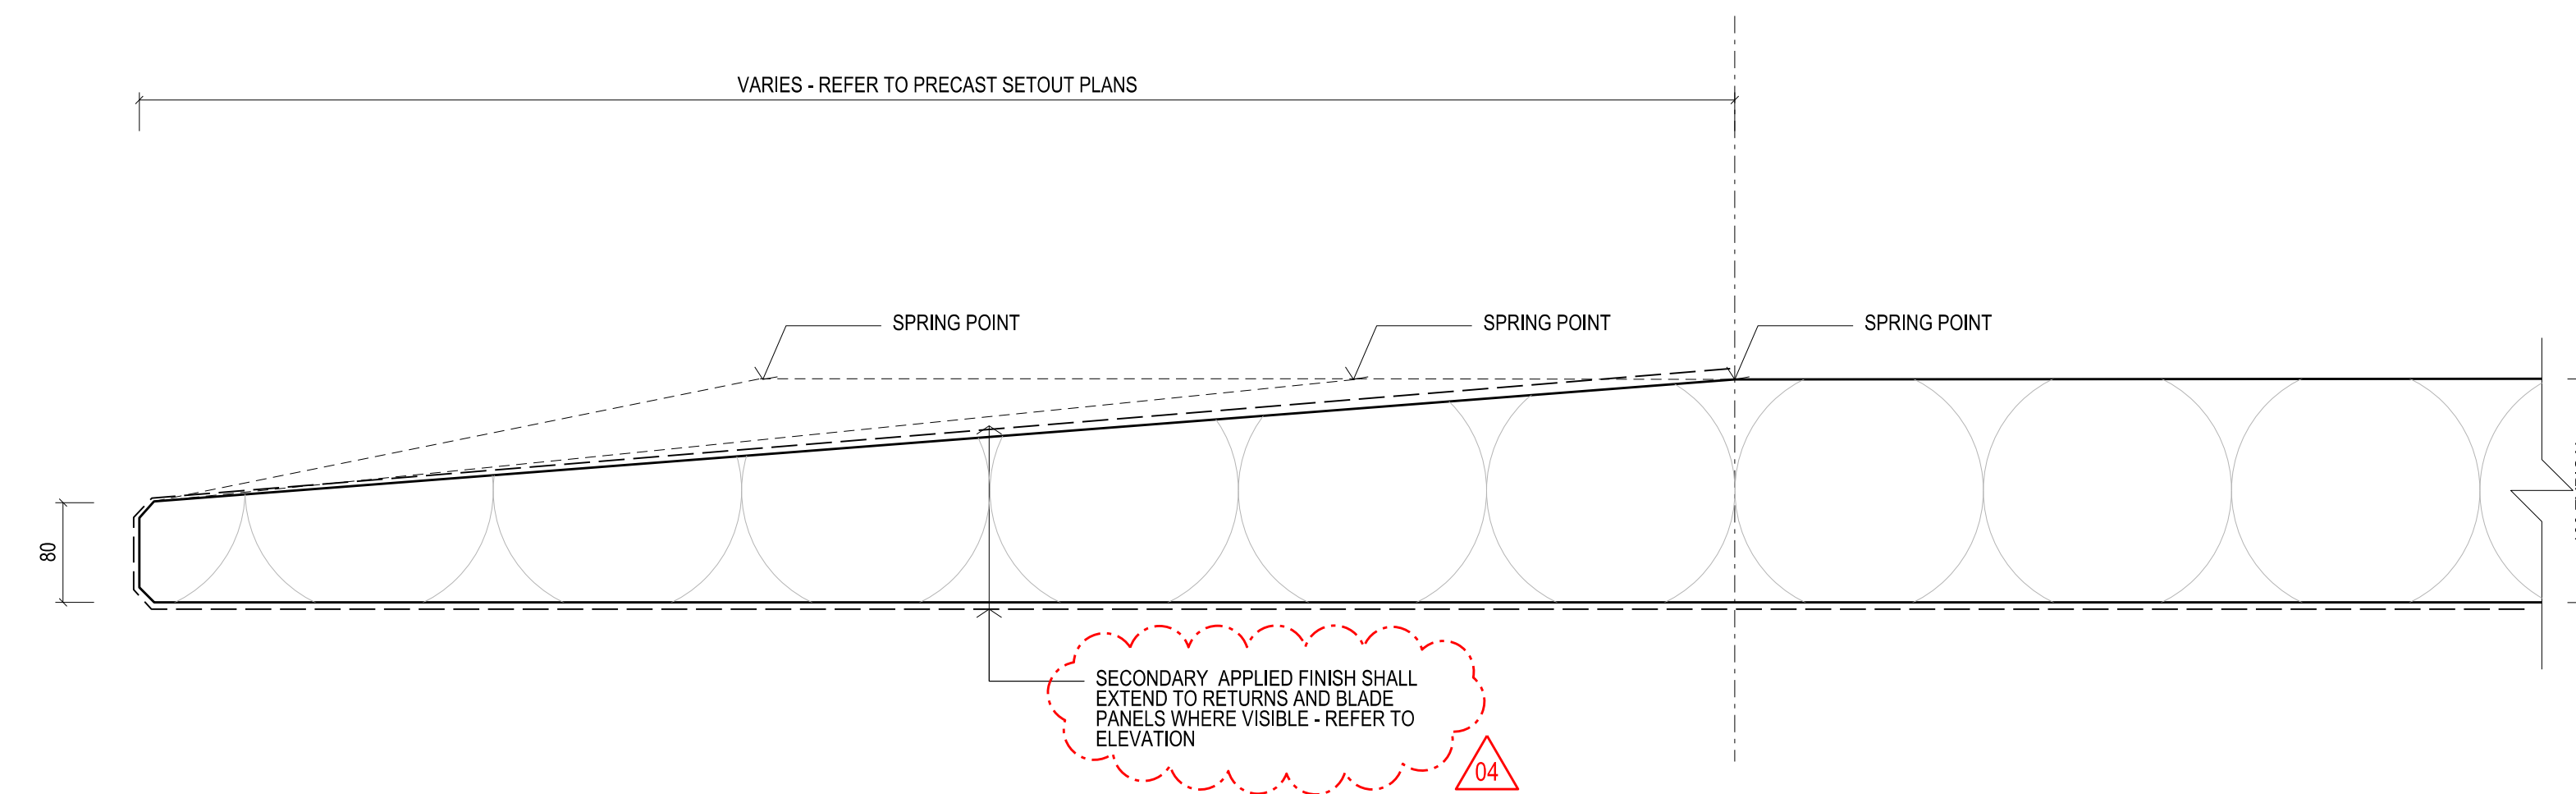


03 PLAN DETAIL TYPICAL HORIZONTAL TAPERING PROFILE SCALE 1:5

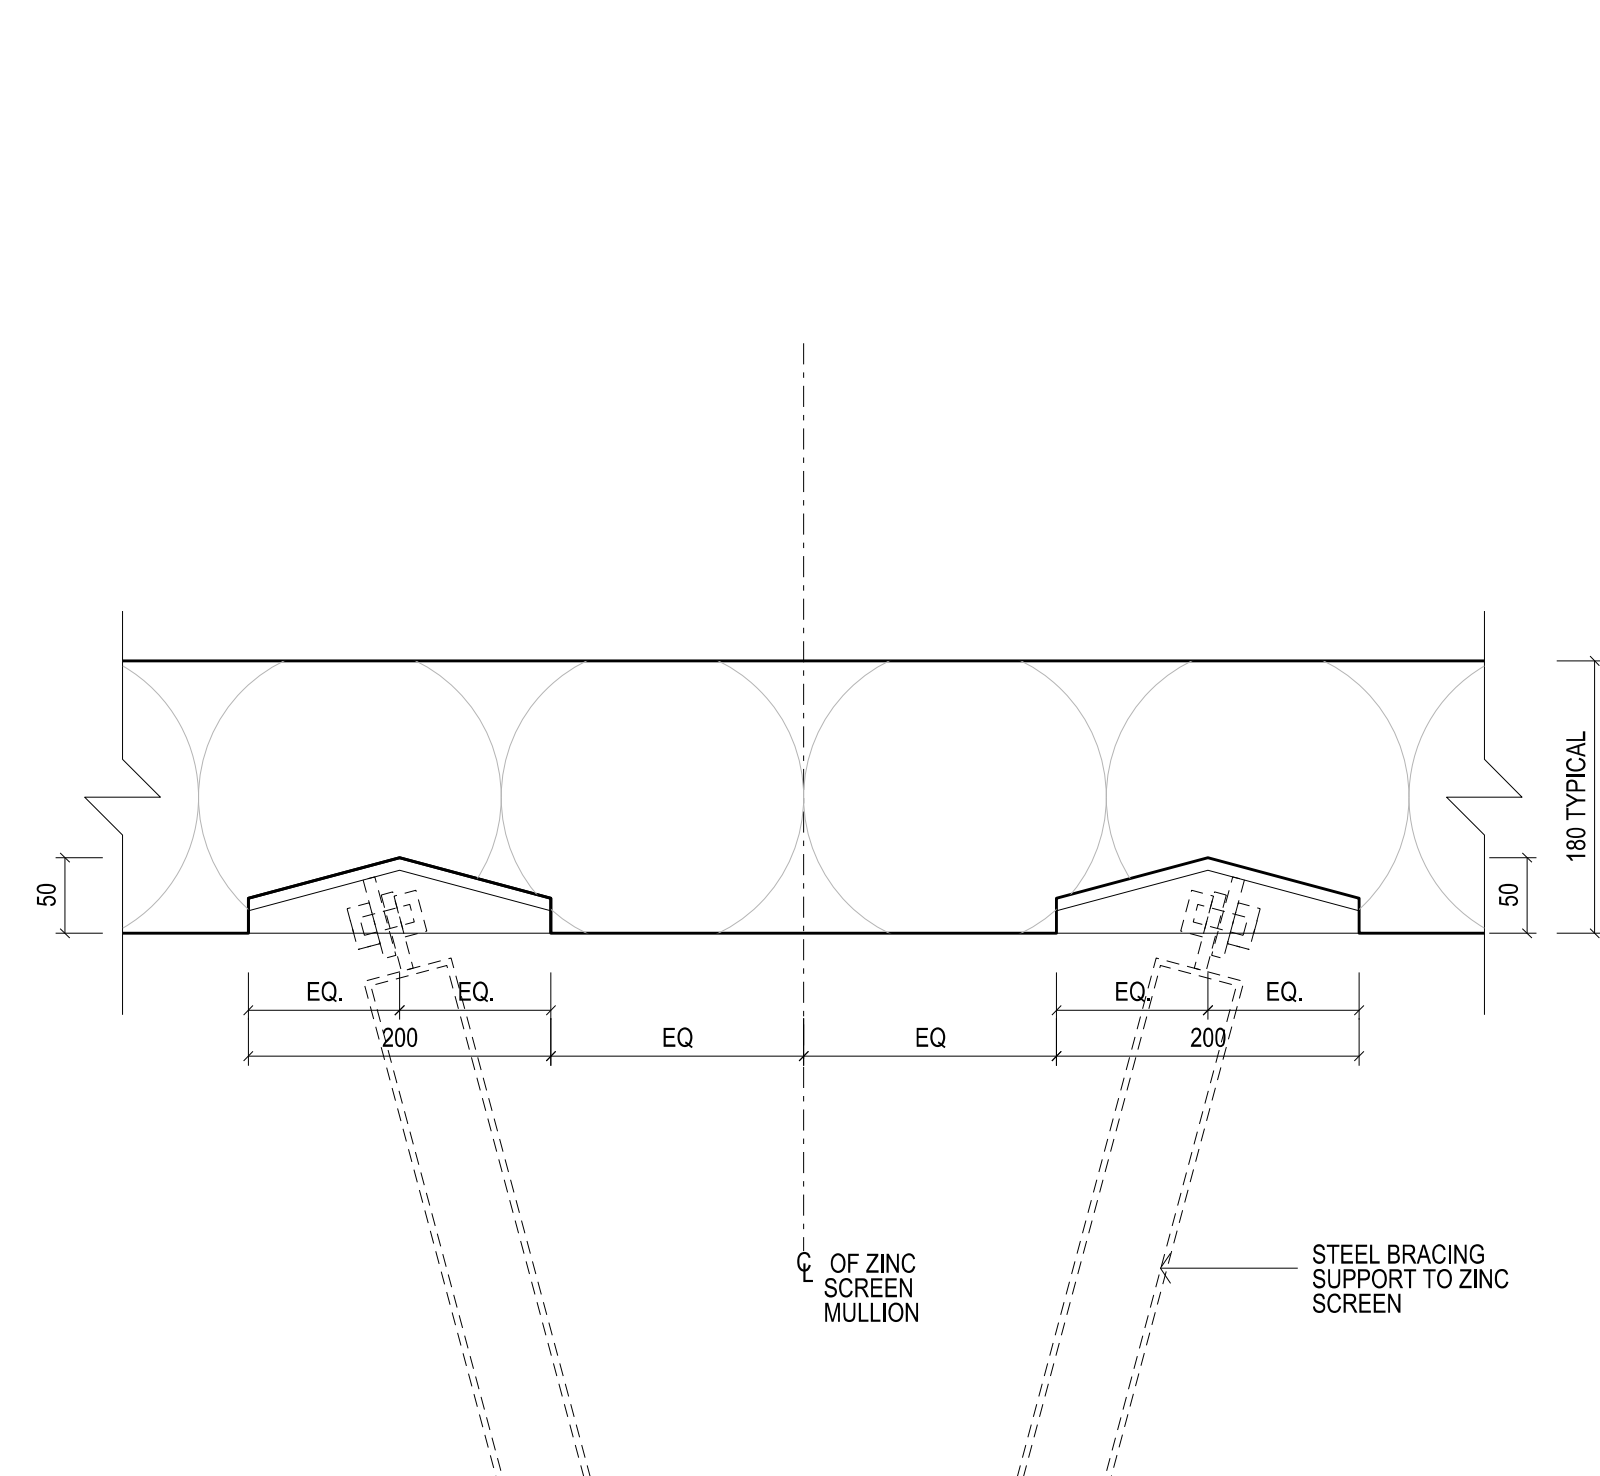


04 PLAN DETAIL TYPICAL REBATE PROFILE AT SCREEN OUTRIGGERS SCALE 1:5

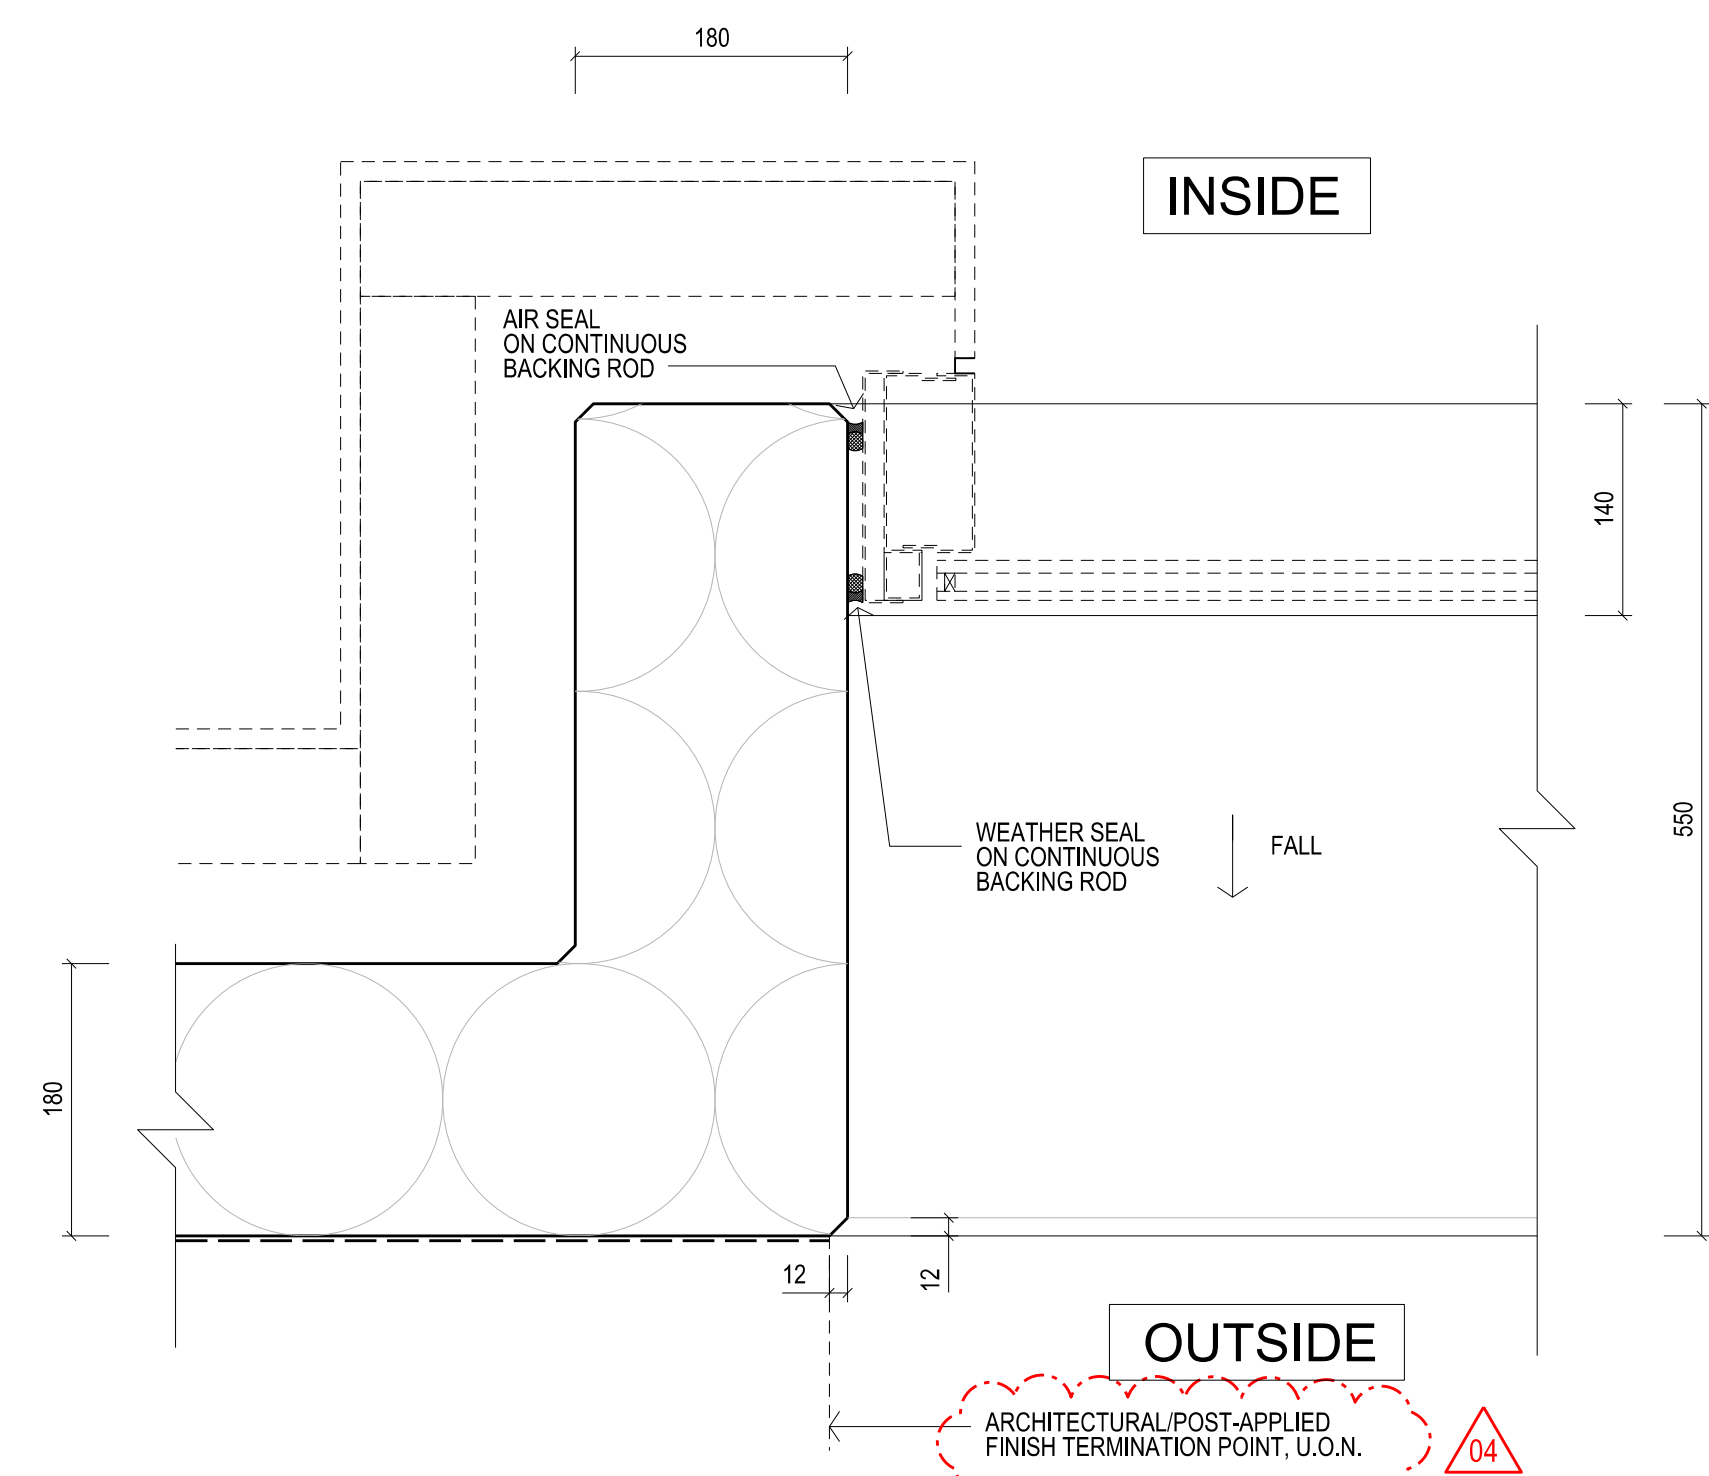


05 PLAN DETAIL TYPICAL JAMB DETAIL AT FOLDED PANEL SCALE 1:5

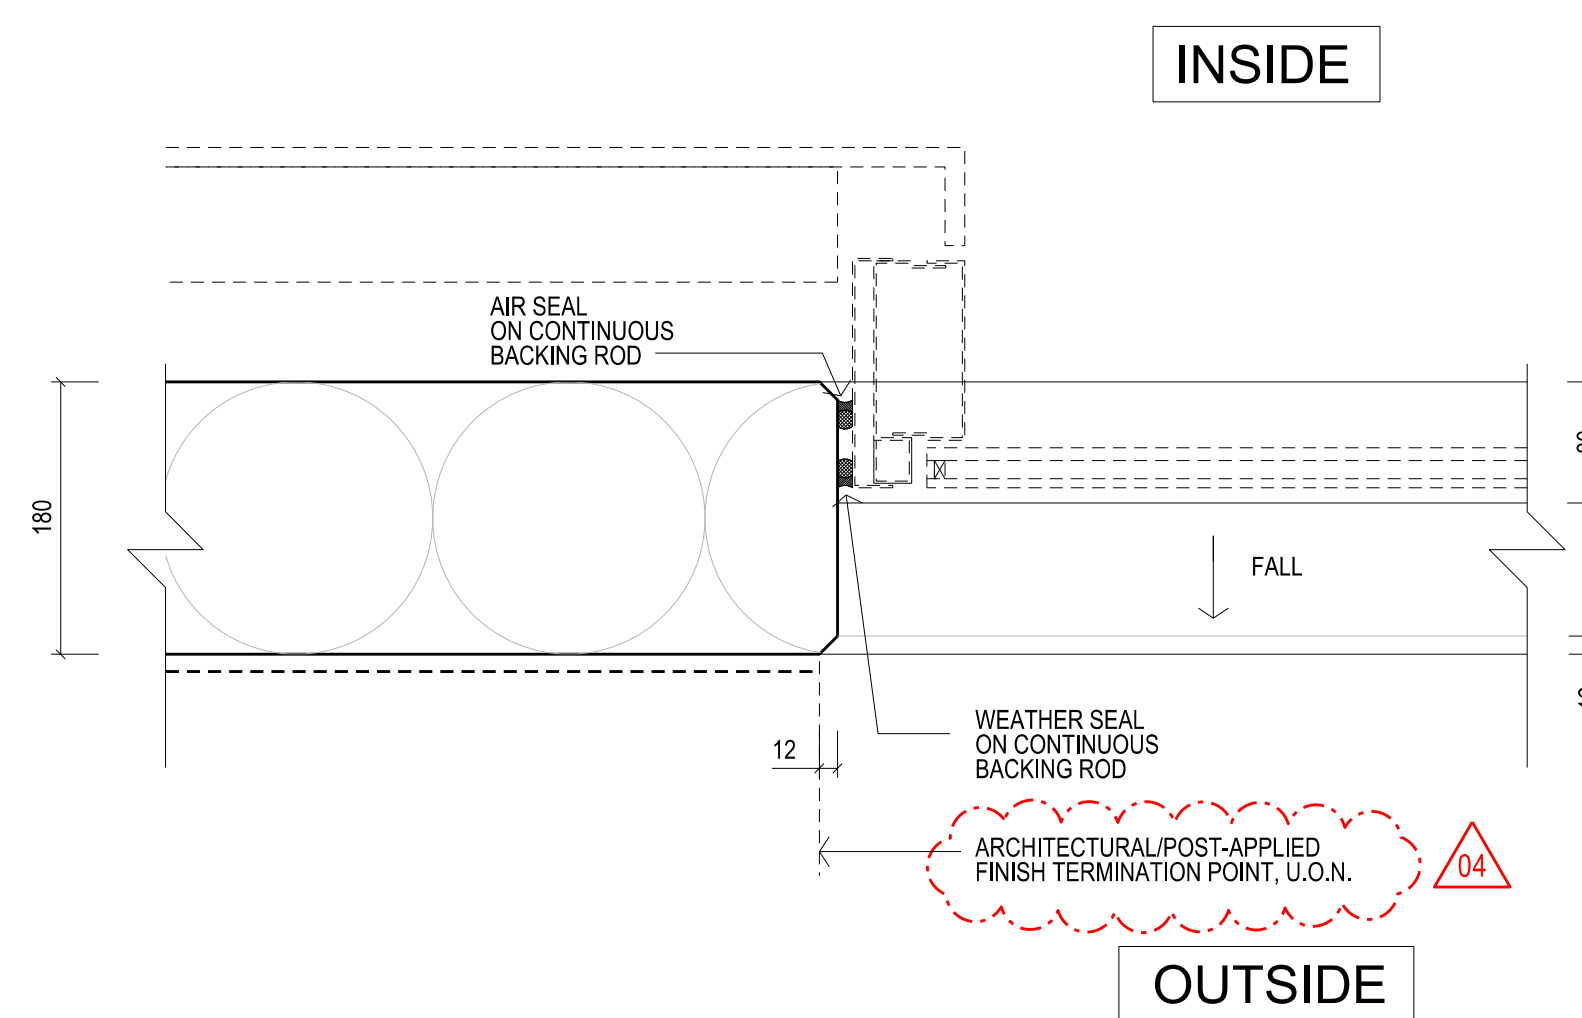


06 PLAN DETAIL TYPICAL JAMB DETAIL SCALE 1:5

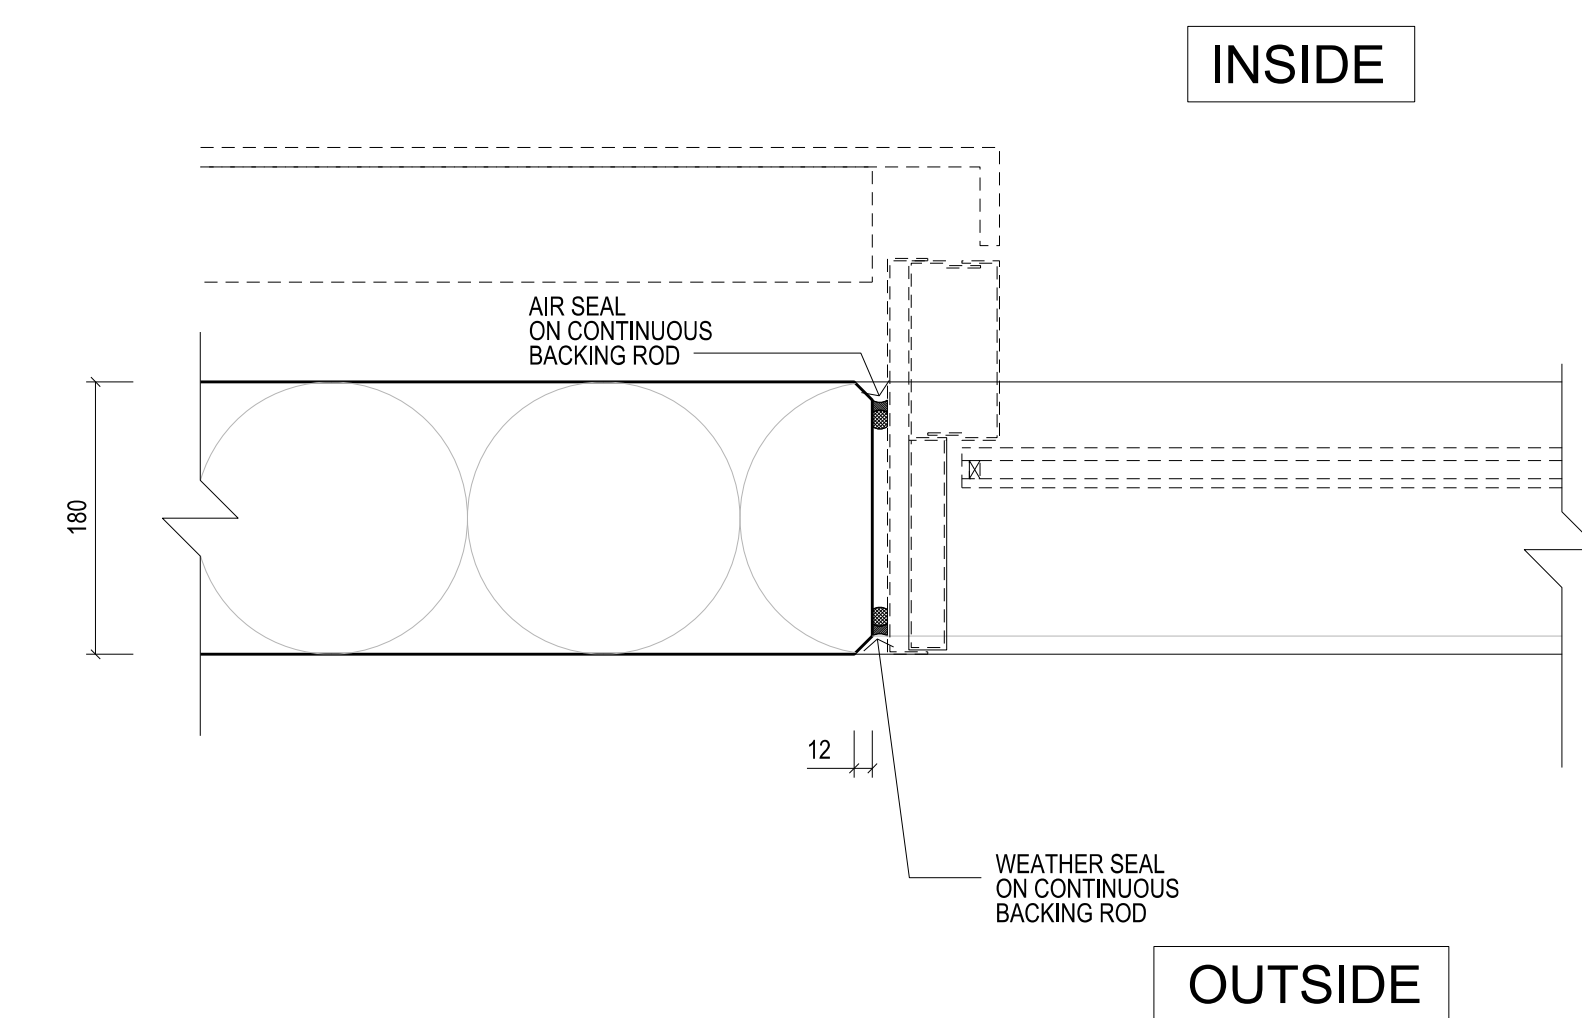


07 PLAN DETAIL TYPICAL JAMB DETAIL AT SOUTH ELEVATION SCALE 1:5

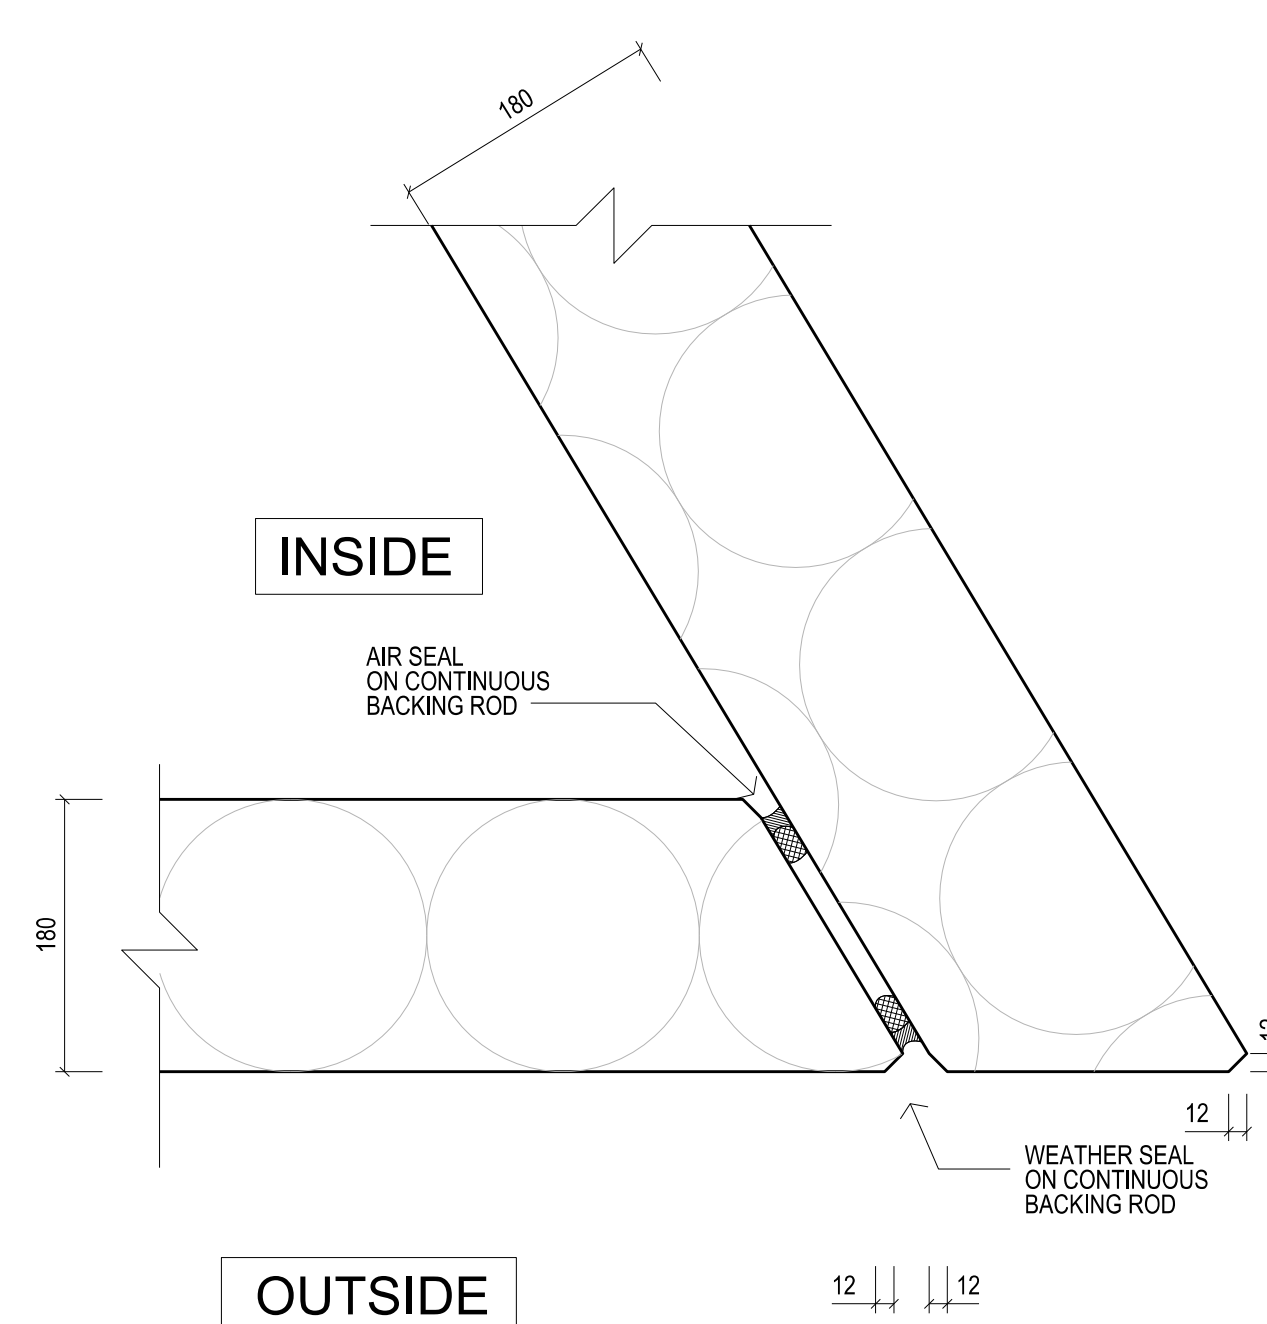

08 PLAN DETAIL CORNER DETAIL AT PANELS WITH DIFFERENT HEIGHT SCALE 1:5

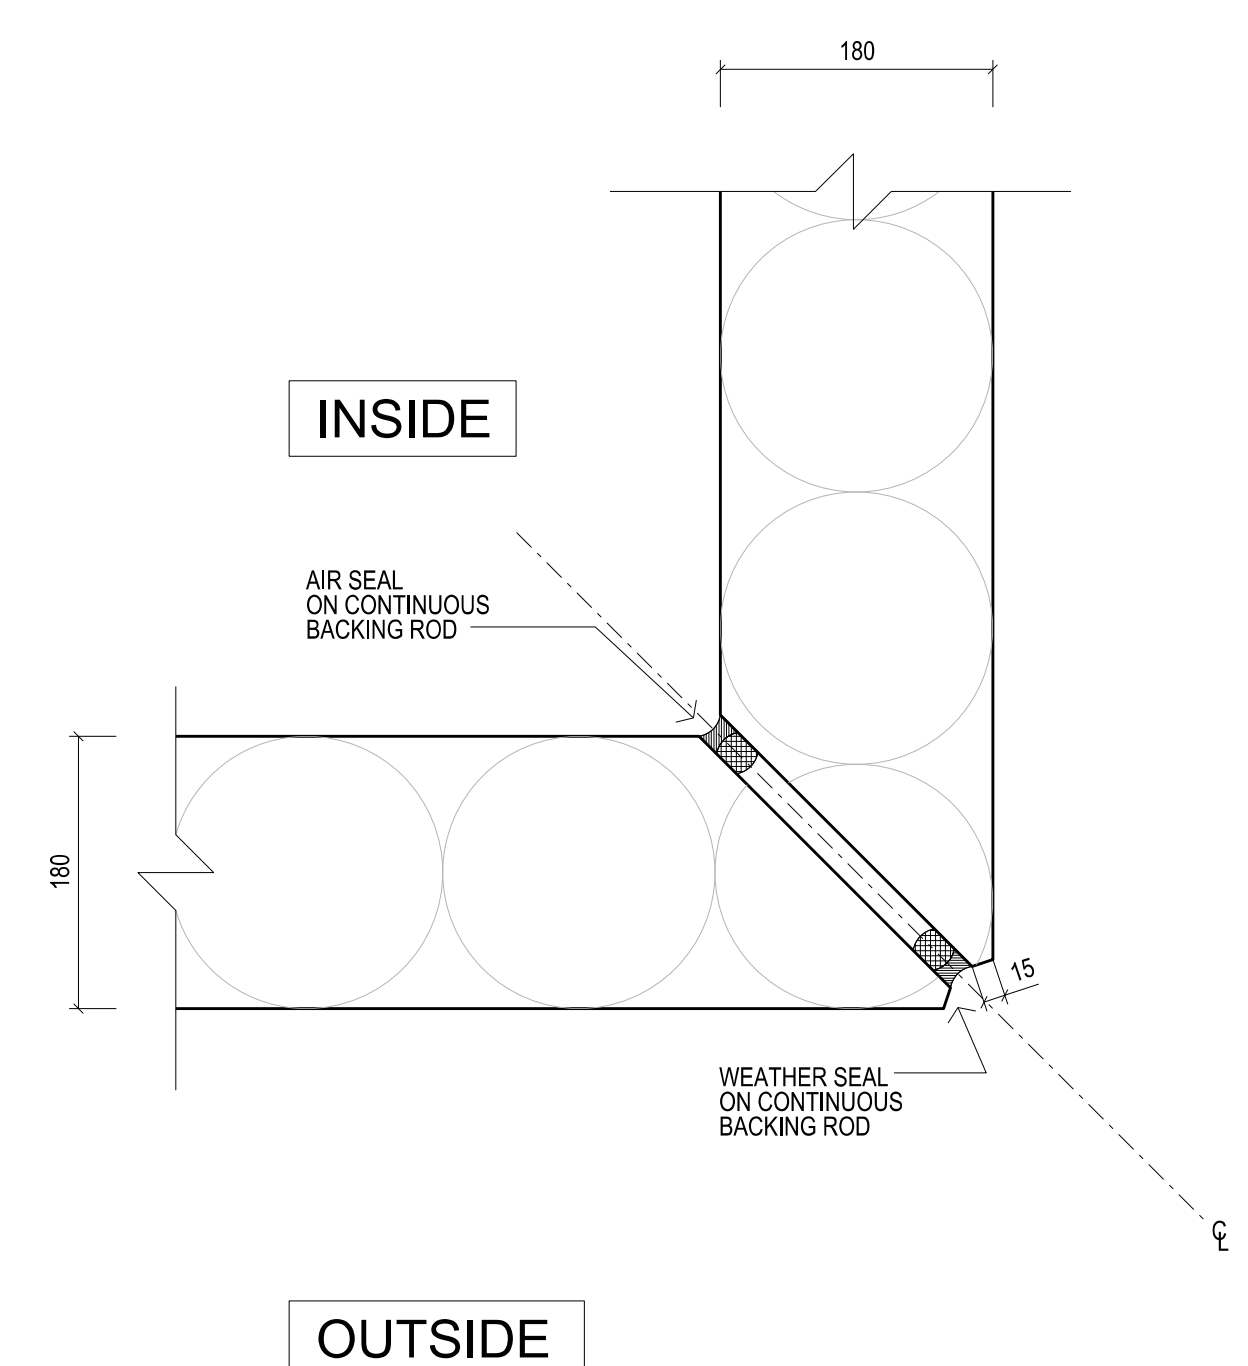

09 PLAN DETAIL TYPICAL CORNER DETAIL SCALE 1:5

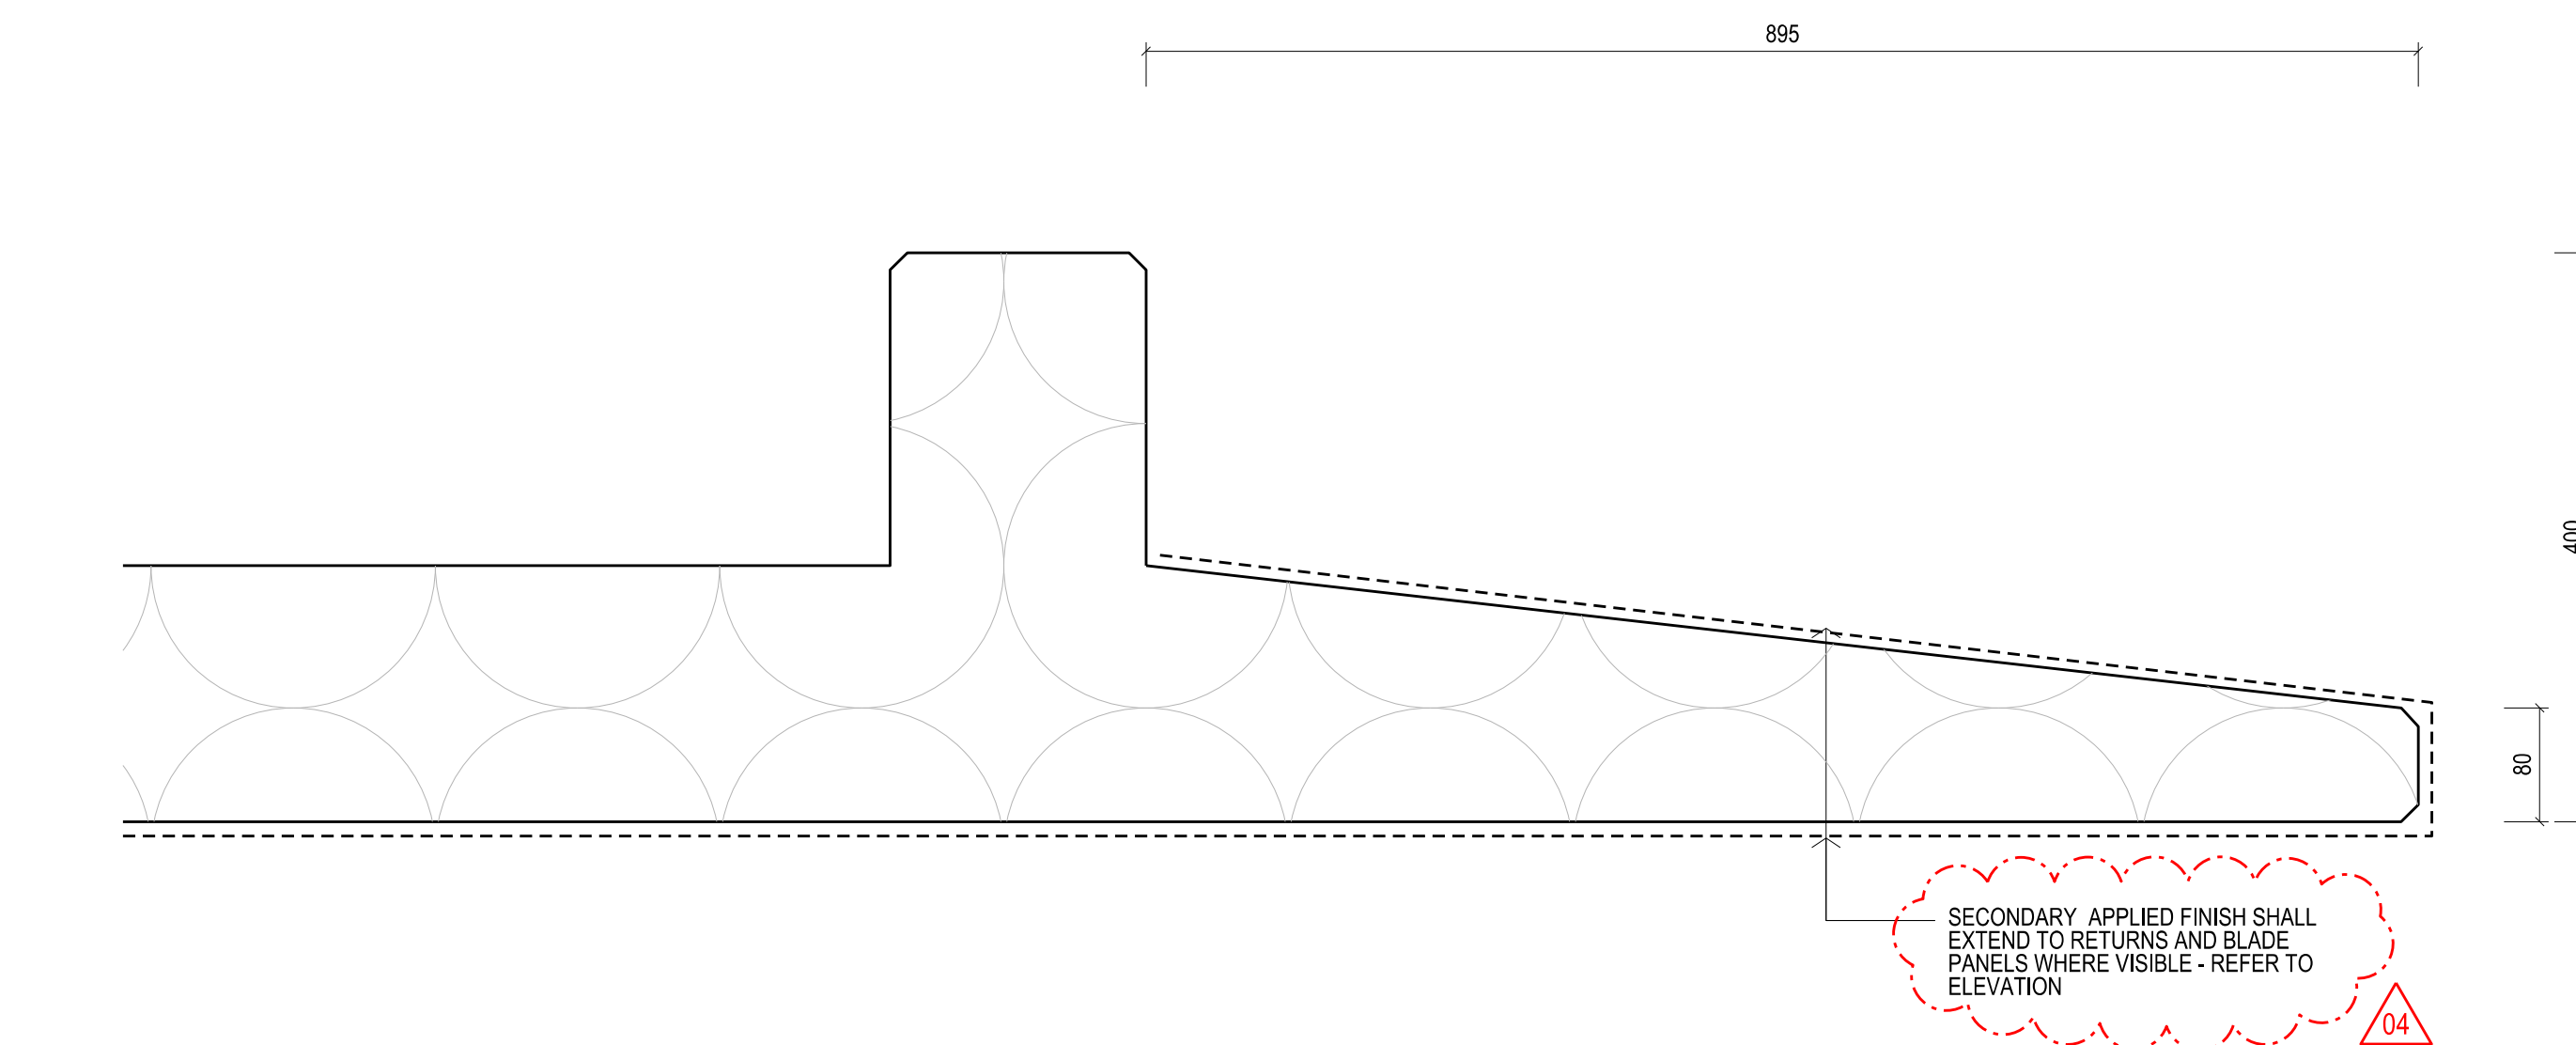

10 PLAN DETAIL TYP. HORIZONTAL TAPERING PROFILE (SOUTH-EAST) SCALE 1:5

Rev	Issue	Revision Description	And	Date
04	SG	VALUE MANAGEMENT ISSUE	-	28.03.13
03	SG	PRECAST REVIEW	-	21.03.13
02	SG	TENDER ADDENDUM 3	-	02.10.12
01	SG	100% CO - TENDER ISSUE	-	07.09.12

**NADAAA**

NADAAA  
1320 Washington Street No.2  
Boston  
Massachusetts  
02118 USA

Telephone  
+1 617 442 8232  
Facsimile  
+1 688 442 1417  
Email  
nadaa@nadaaa.com

**John Wardle Architects**

25 Rokeby Street, Collingwood, Victoria 3066 Australia  
Tel : +61 3 8662 0400 www.johnwardlearchitects.com  
© 2012 John Wardle Architects ABN 83 006 814 268

Client **University of Melbourne Parkville Campus**

Project **Faculty of Architecture Building and Planning**

Title **TYPICAL PRECAST DETAILS SHEET 1**

Project No.	<b>0913</b>	Scale	1:5 @ A0 1:10 @ A2
Drawing No.	<b>AR 6300</b>	Revision	<b>04</b>

Date Sep 2012 Drawn Co-Ord Check

FILENAME - \$FILES

**VM ISSUE**