



CONTRACTORS SHALL VERIFY JOB DIMENSIONS BEFORE ANY JOB COMMENCES. ALL SHOP DRAWINGS SHALL BE SUBMITTED TO THE SUPERINTENDENT AND MANUFACTURER SHALL NOT COMMENCE FROM THE RETURN OF DIMENSIONS SHOP DRAWINGS ISSUED BY THE CONSULTANT. REQUIRED DIMENSIONS SHALL TAKE PRECEDENCE OVER SCALED. THIS DRAWING SHALL BE USED IN CONSTRUCTION WITH ALL RELEVANT CONTRACT SPECIFICATIONS AND DRAWINGS COPYRIGHT OF THIS DRAWING IS VESTED IN HANDLE.


General Notes

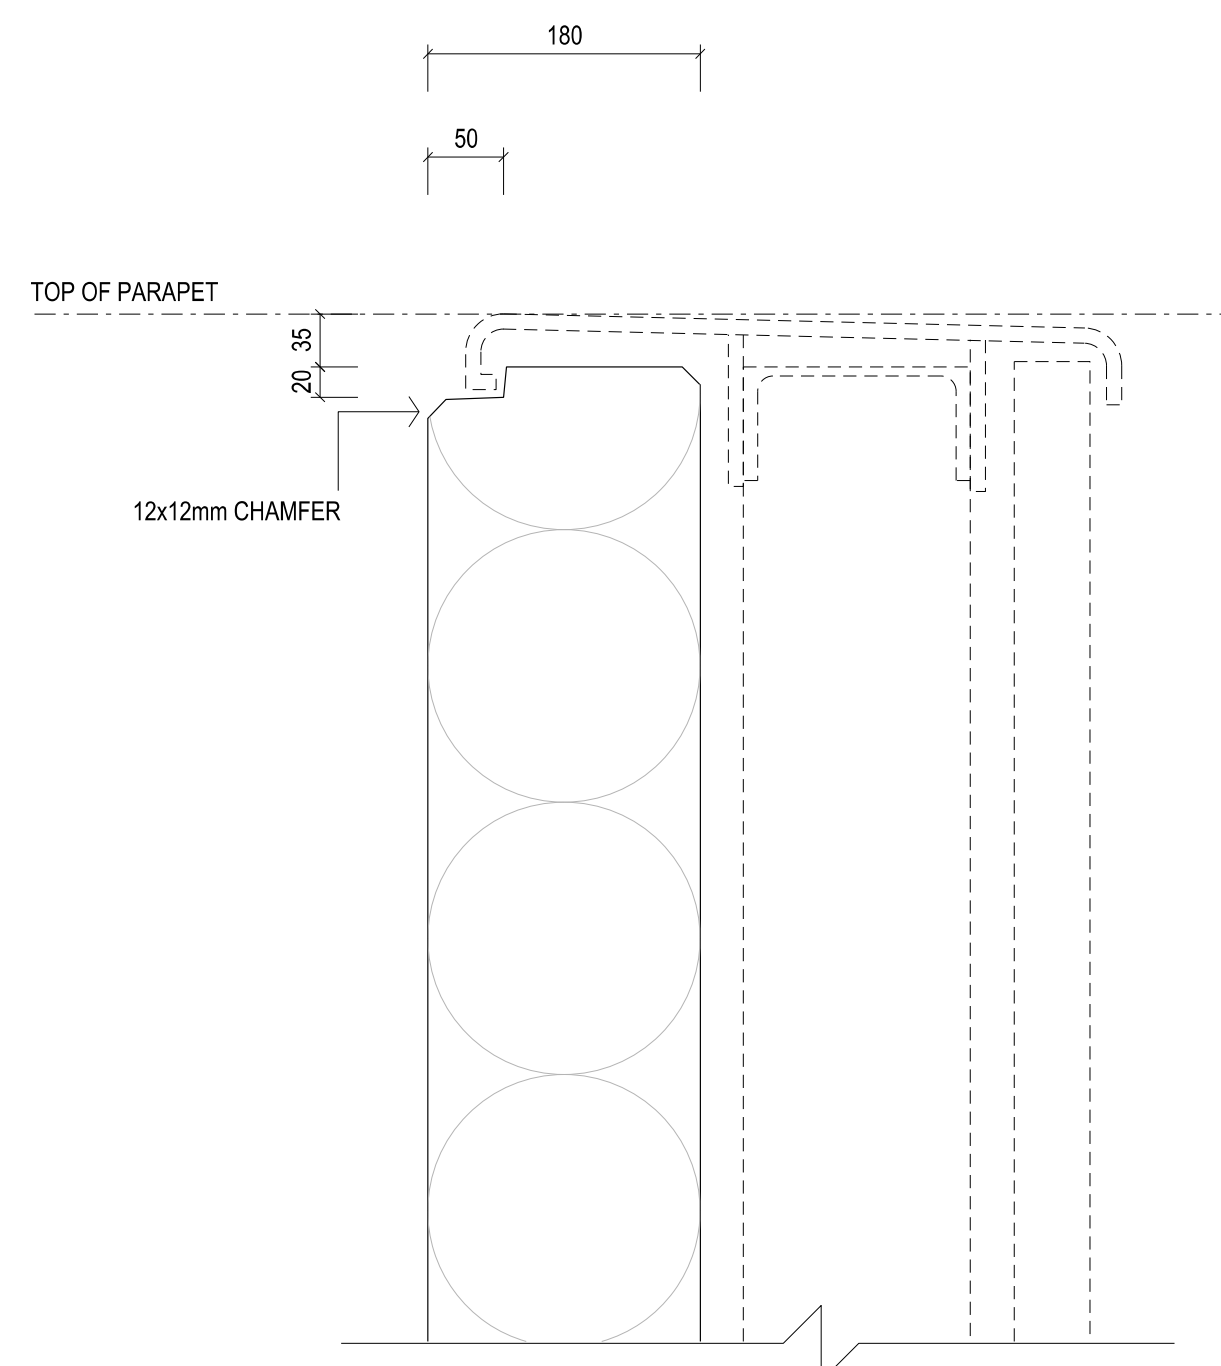


SECTION DETAIL
TYPICAL PARAPET DETAIL AT ABSEILING CAPPING
SCALE 1:5

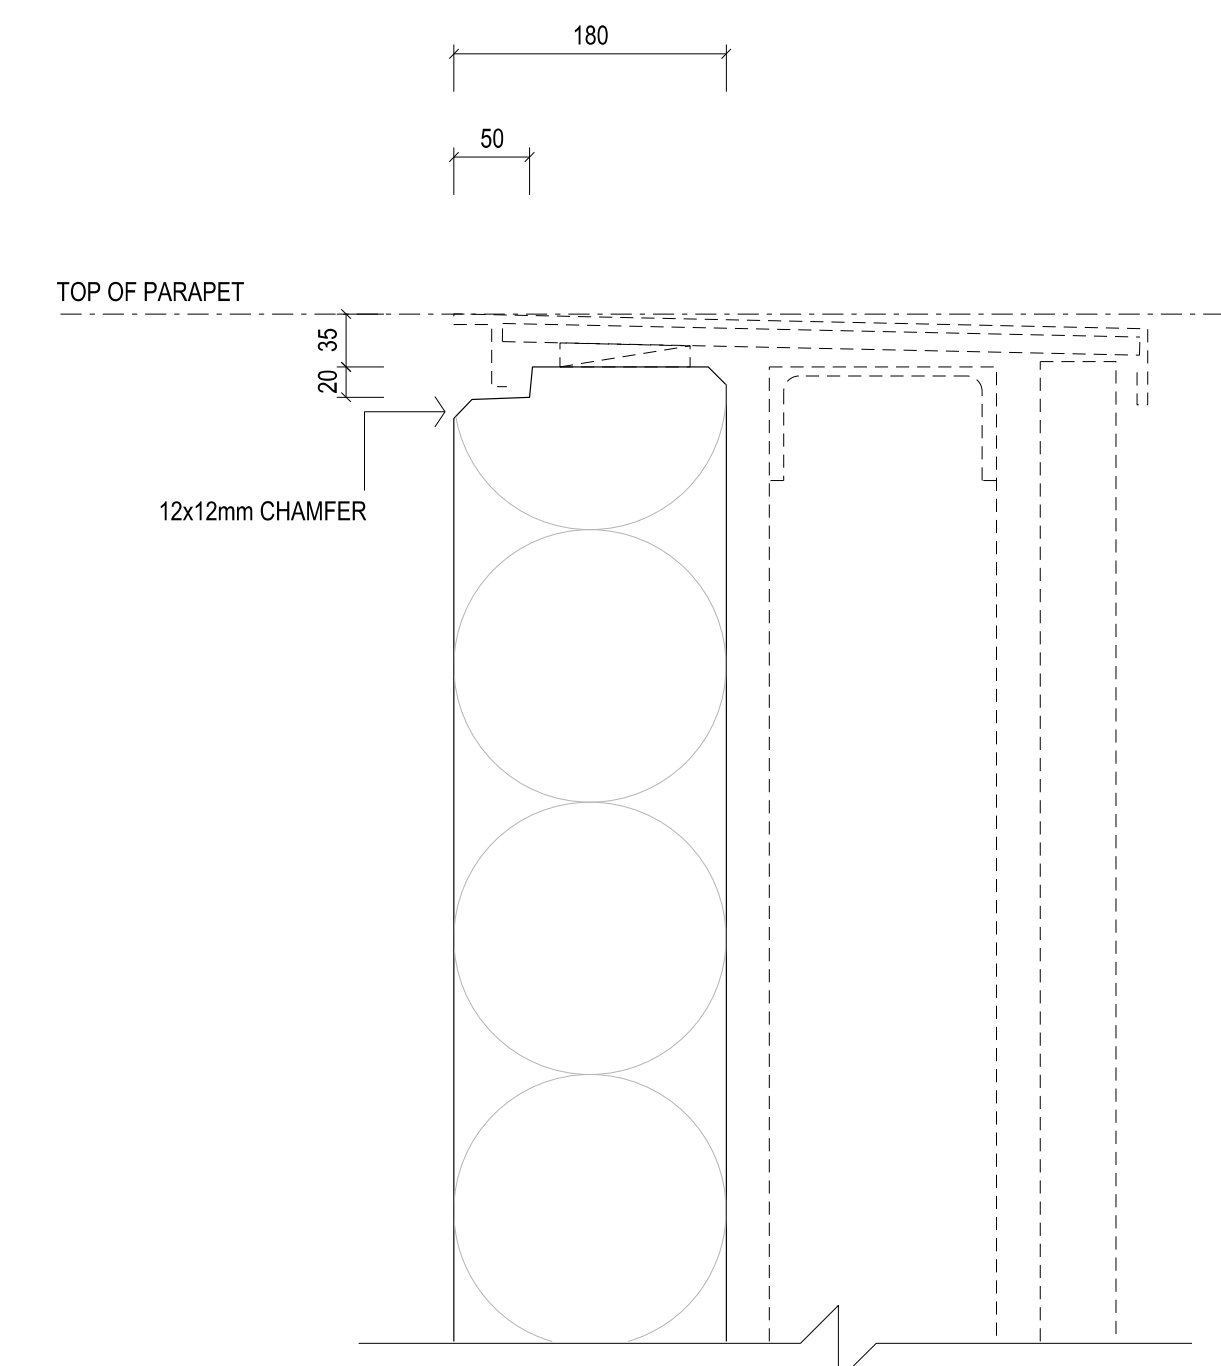


SECTION DETAIL
TYPICAL PARAPET AT FOLDED METAL CAPPING
SCALE 1:5

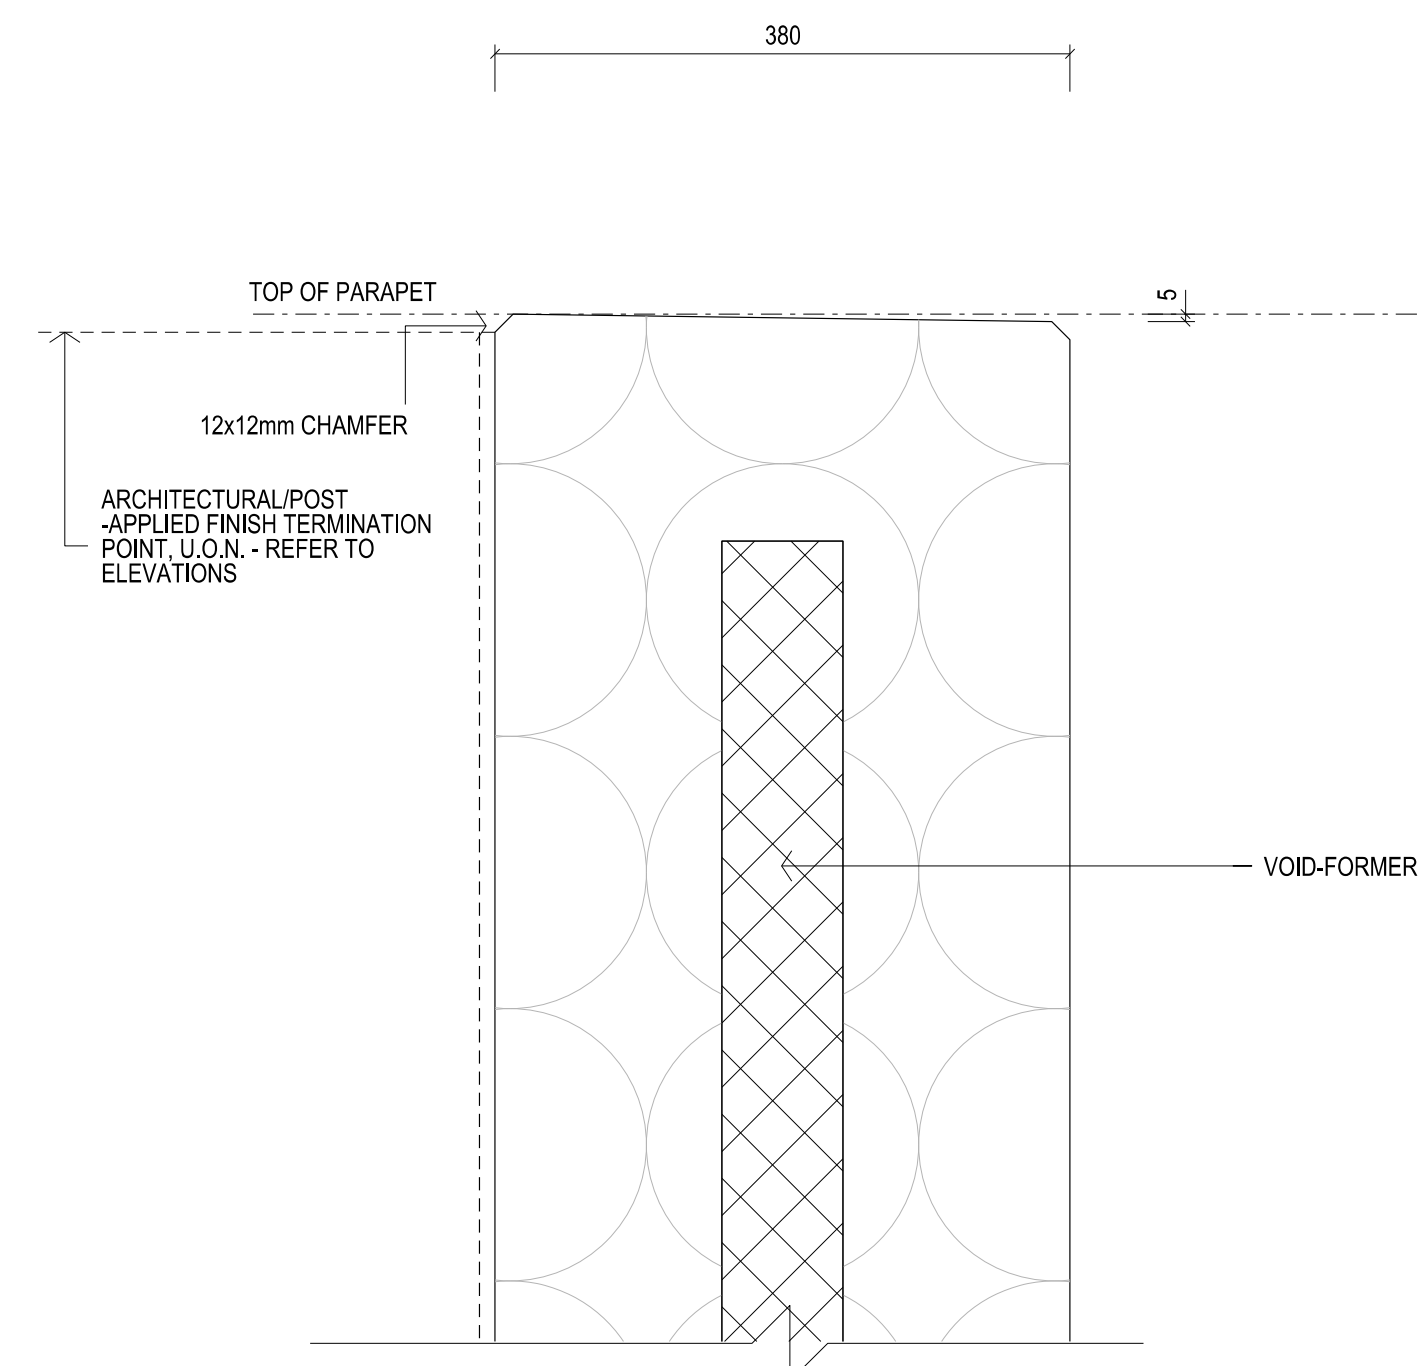


SECTION DETAIL
TYPICAL PARAPET AT DOUBLE THICKNESS PANEL
SCALE 1:5

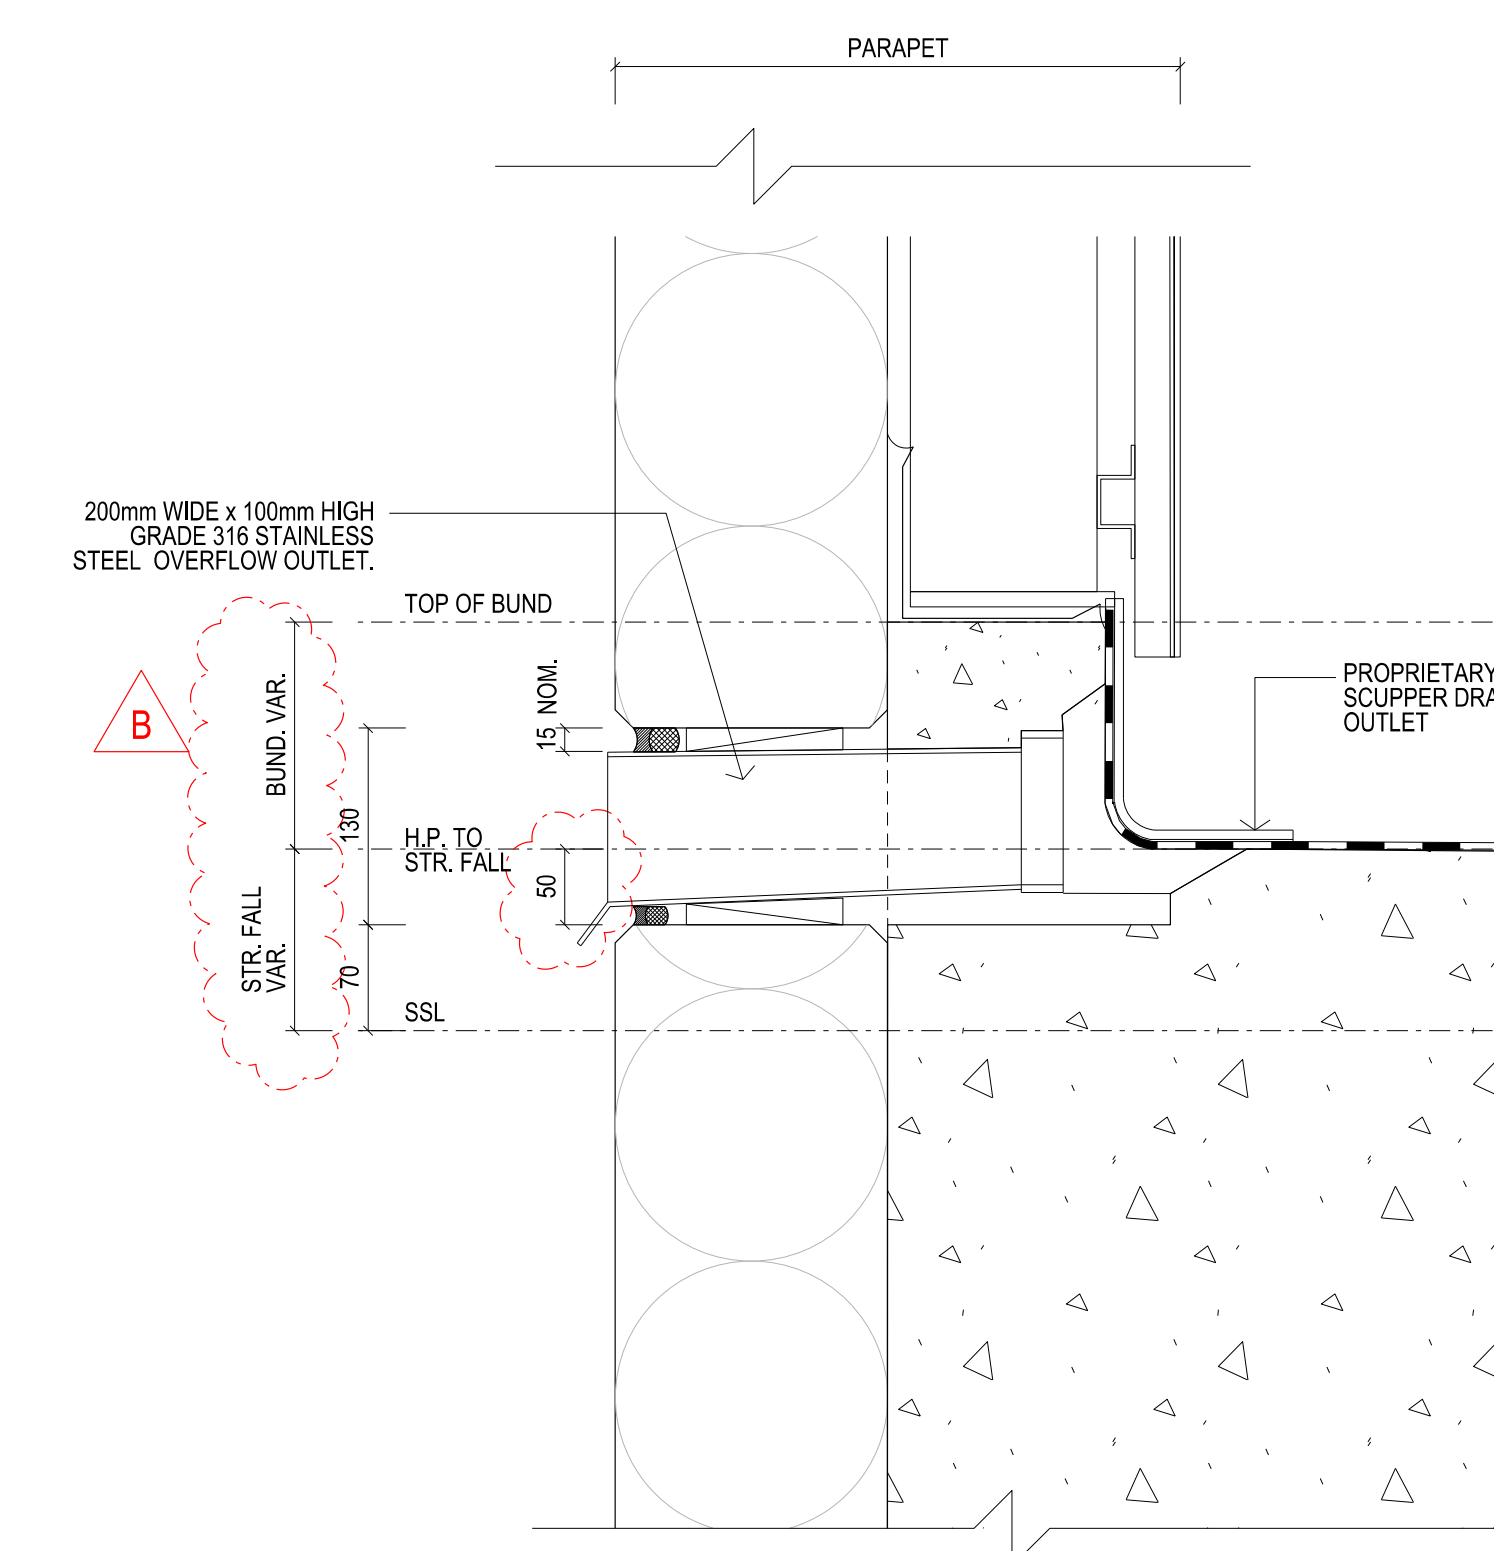


SECTION DETAIL
TYPICAL OVERFLOW DETAIL
SCALE 1:5

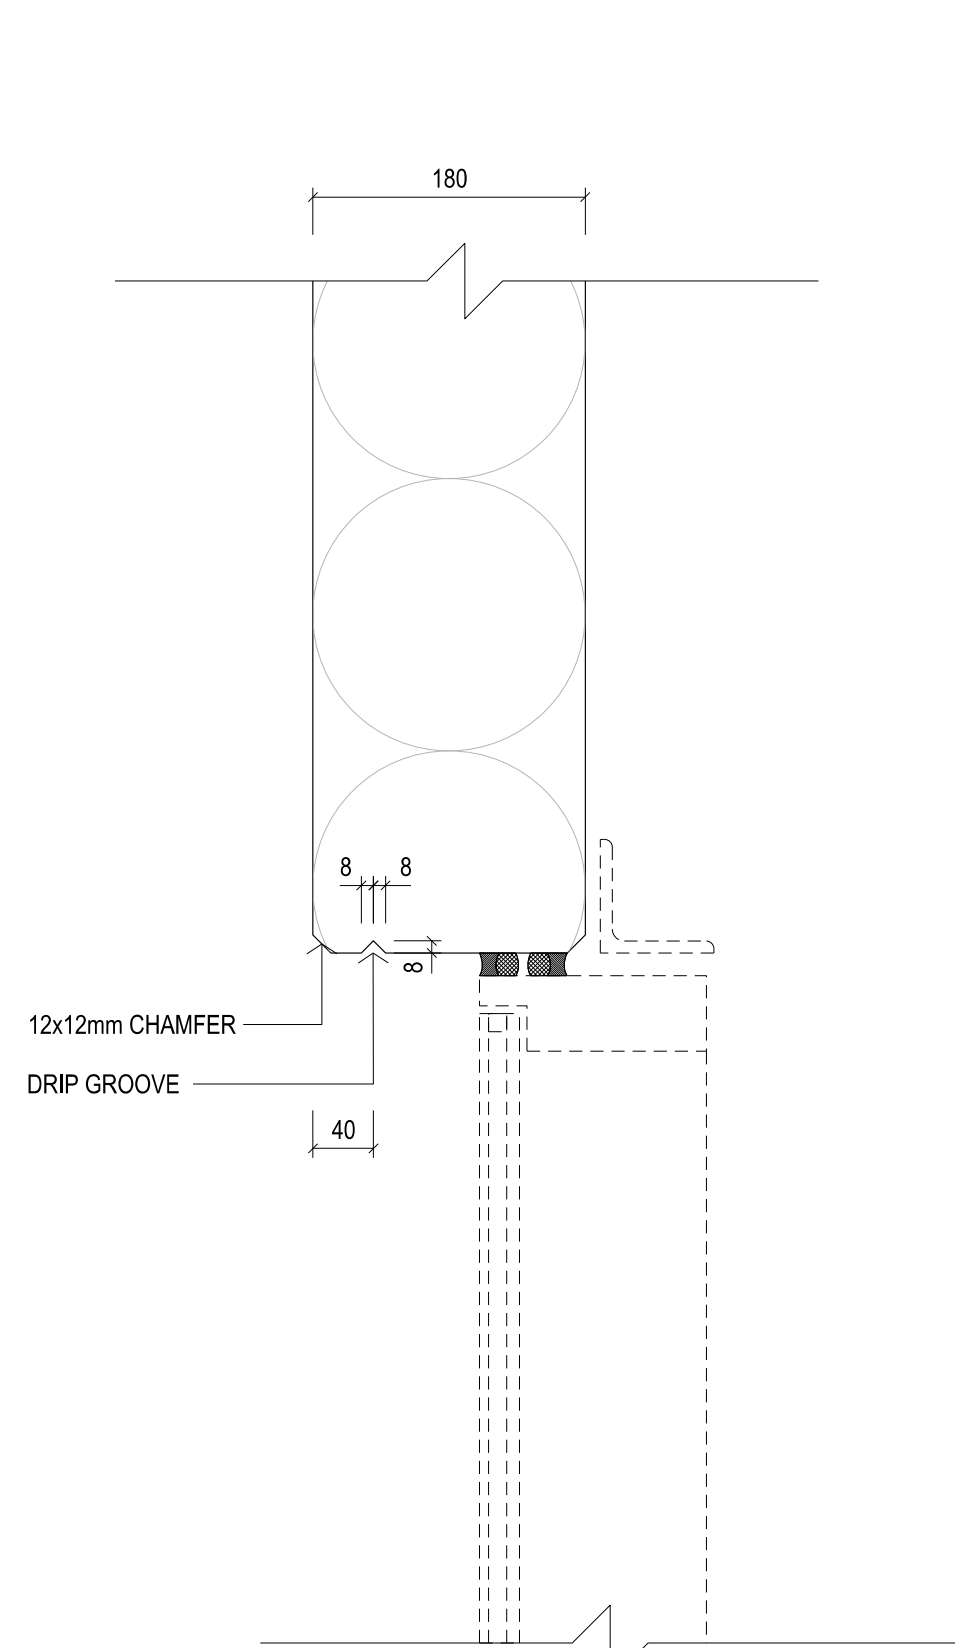


SECTION DETAIL
TYPICAL HEAD DETAIL
SCALE 1:5

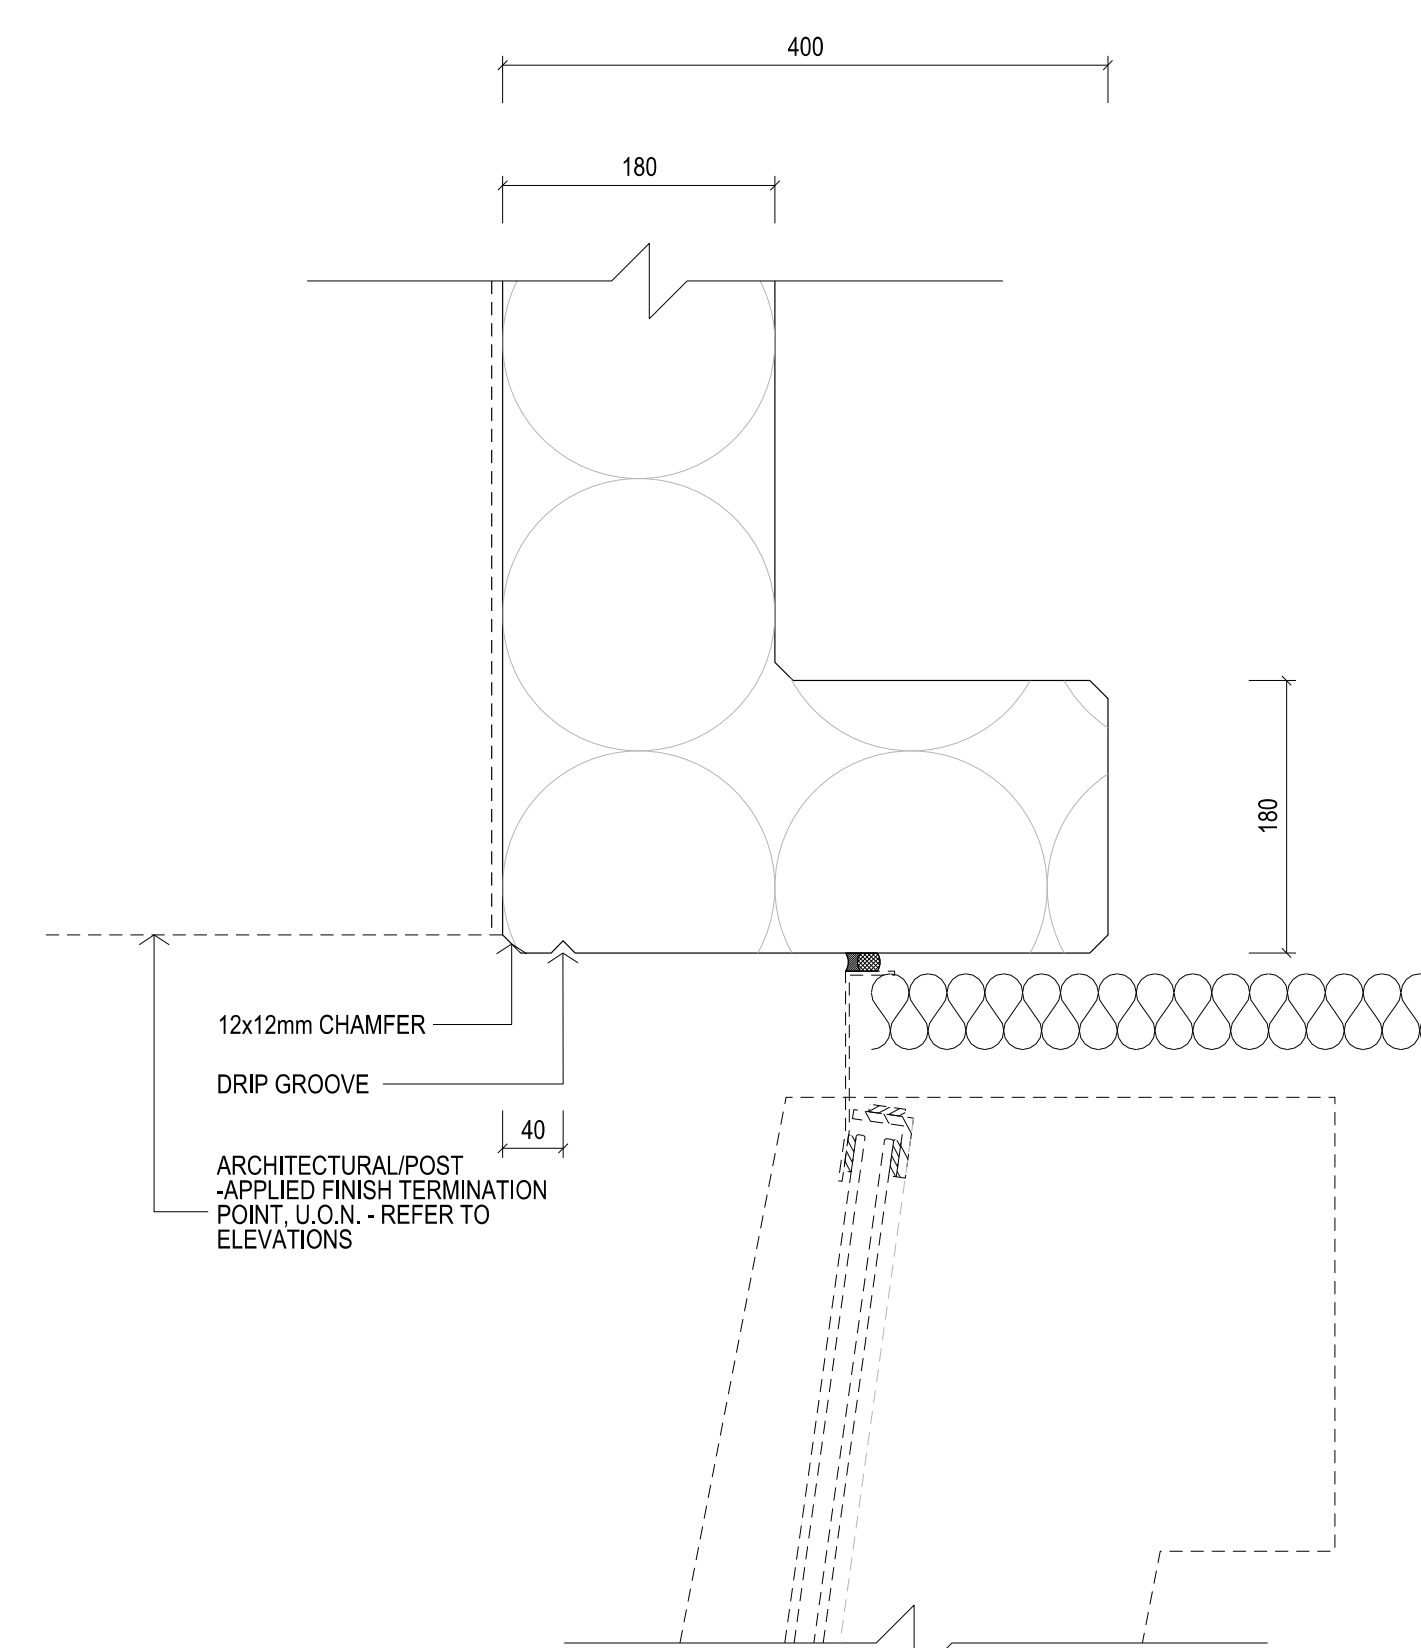


SECTION DETAIL
TYPICAL HEAD DETAIL AT PANEL RETURN
SCALE 1:5

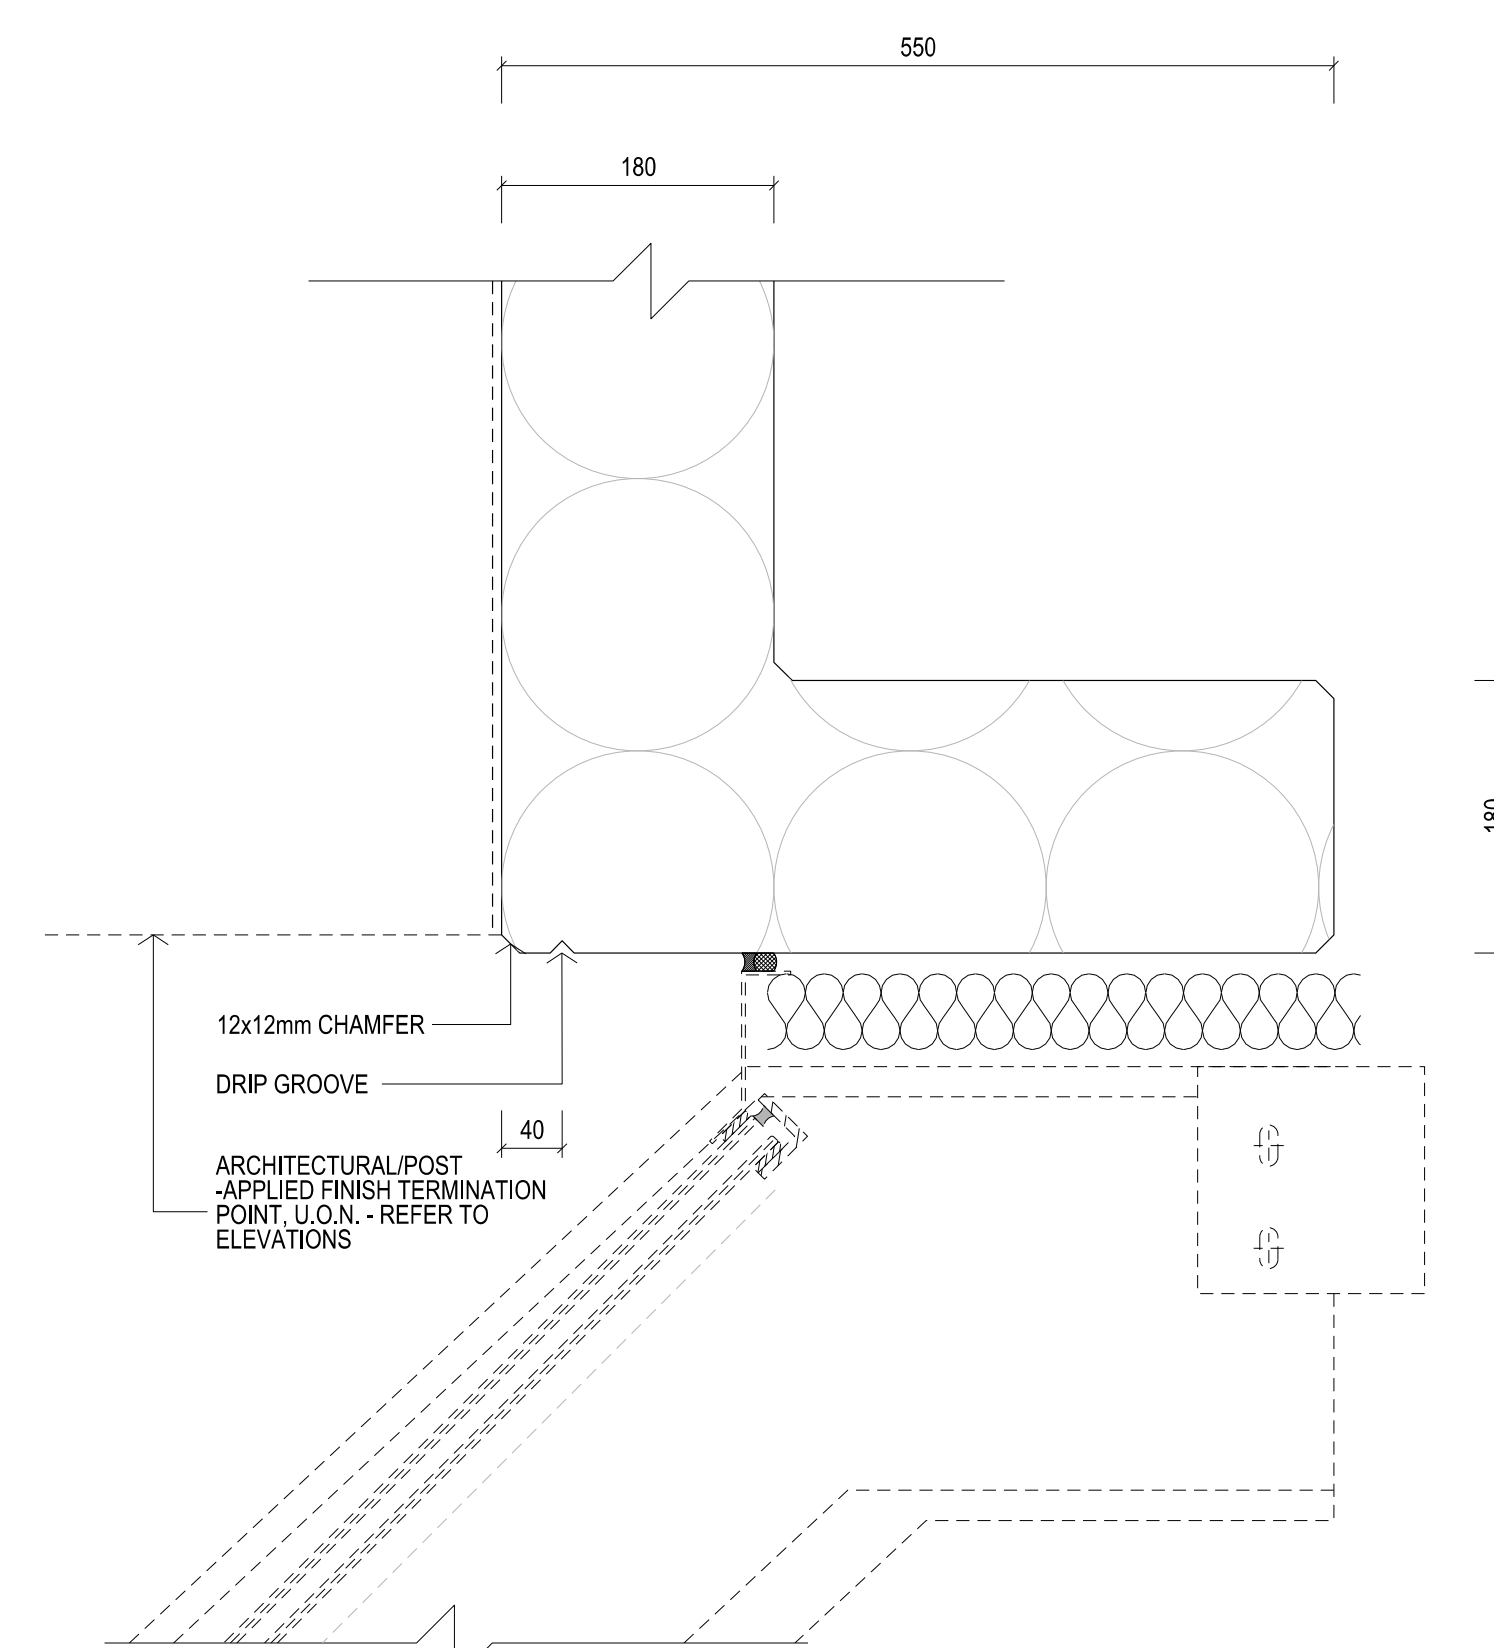


SECTION DETAIL
TYPICAL HEAD DETAIL AT DEEPER PANEL RETURN
SCALE 1:5

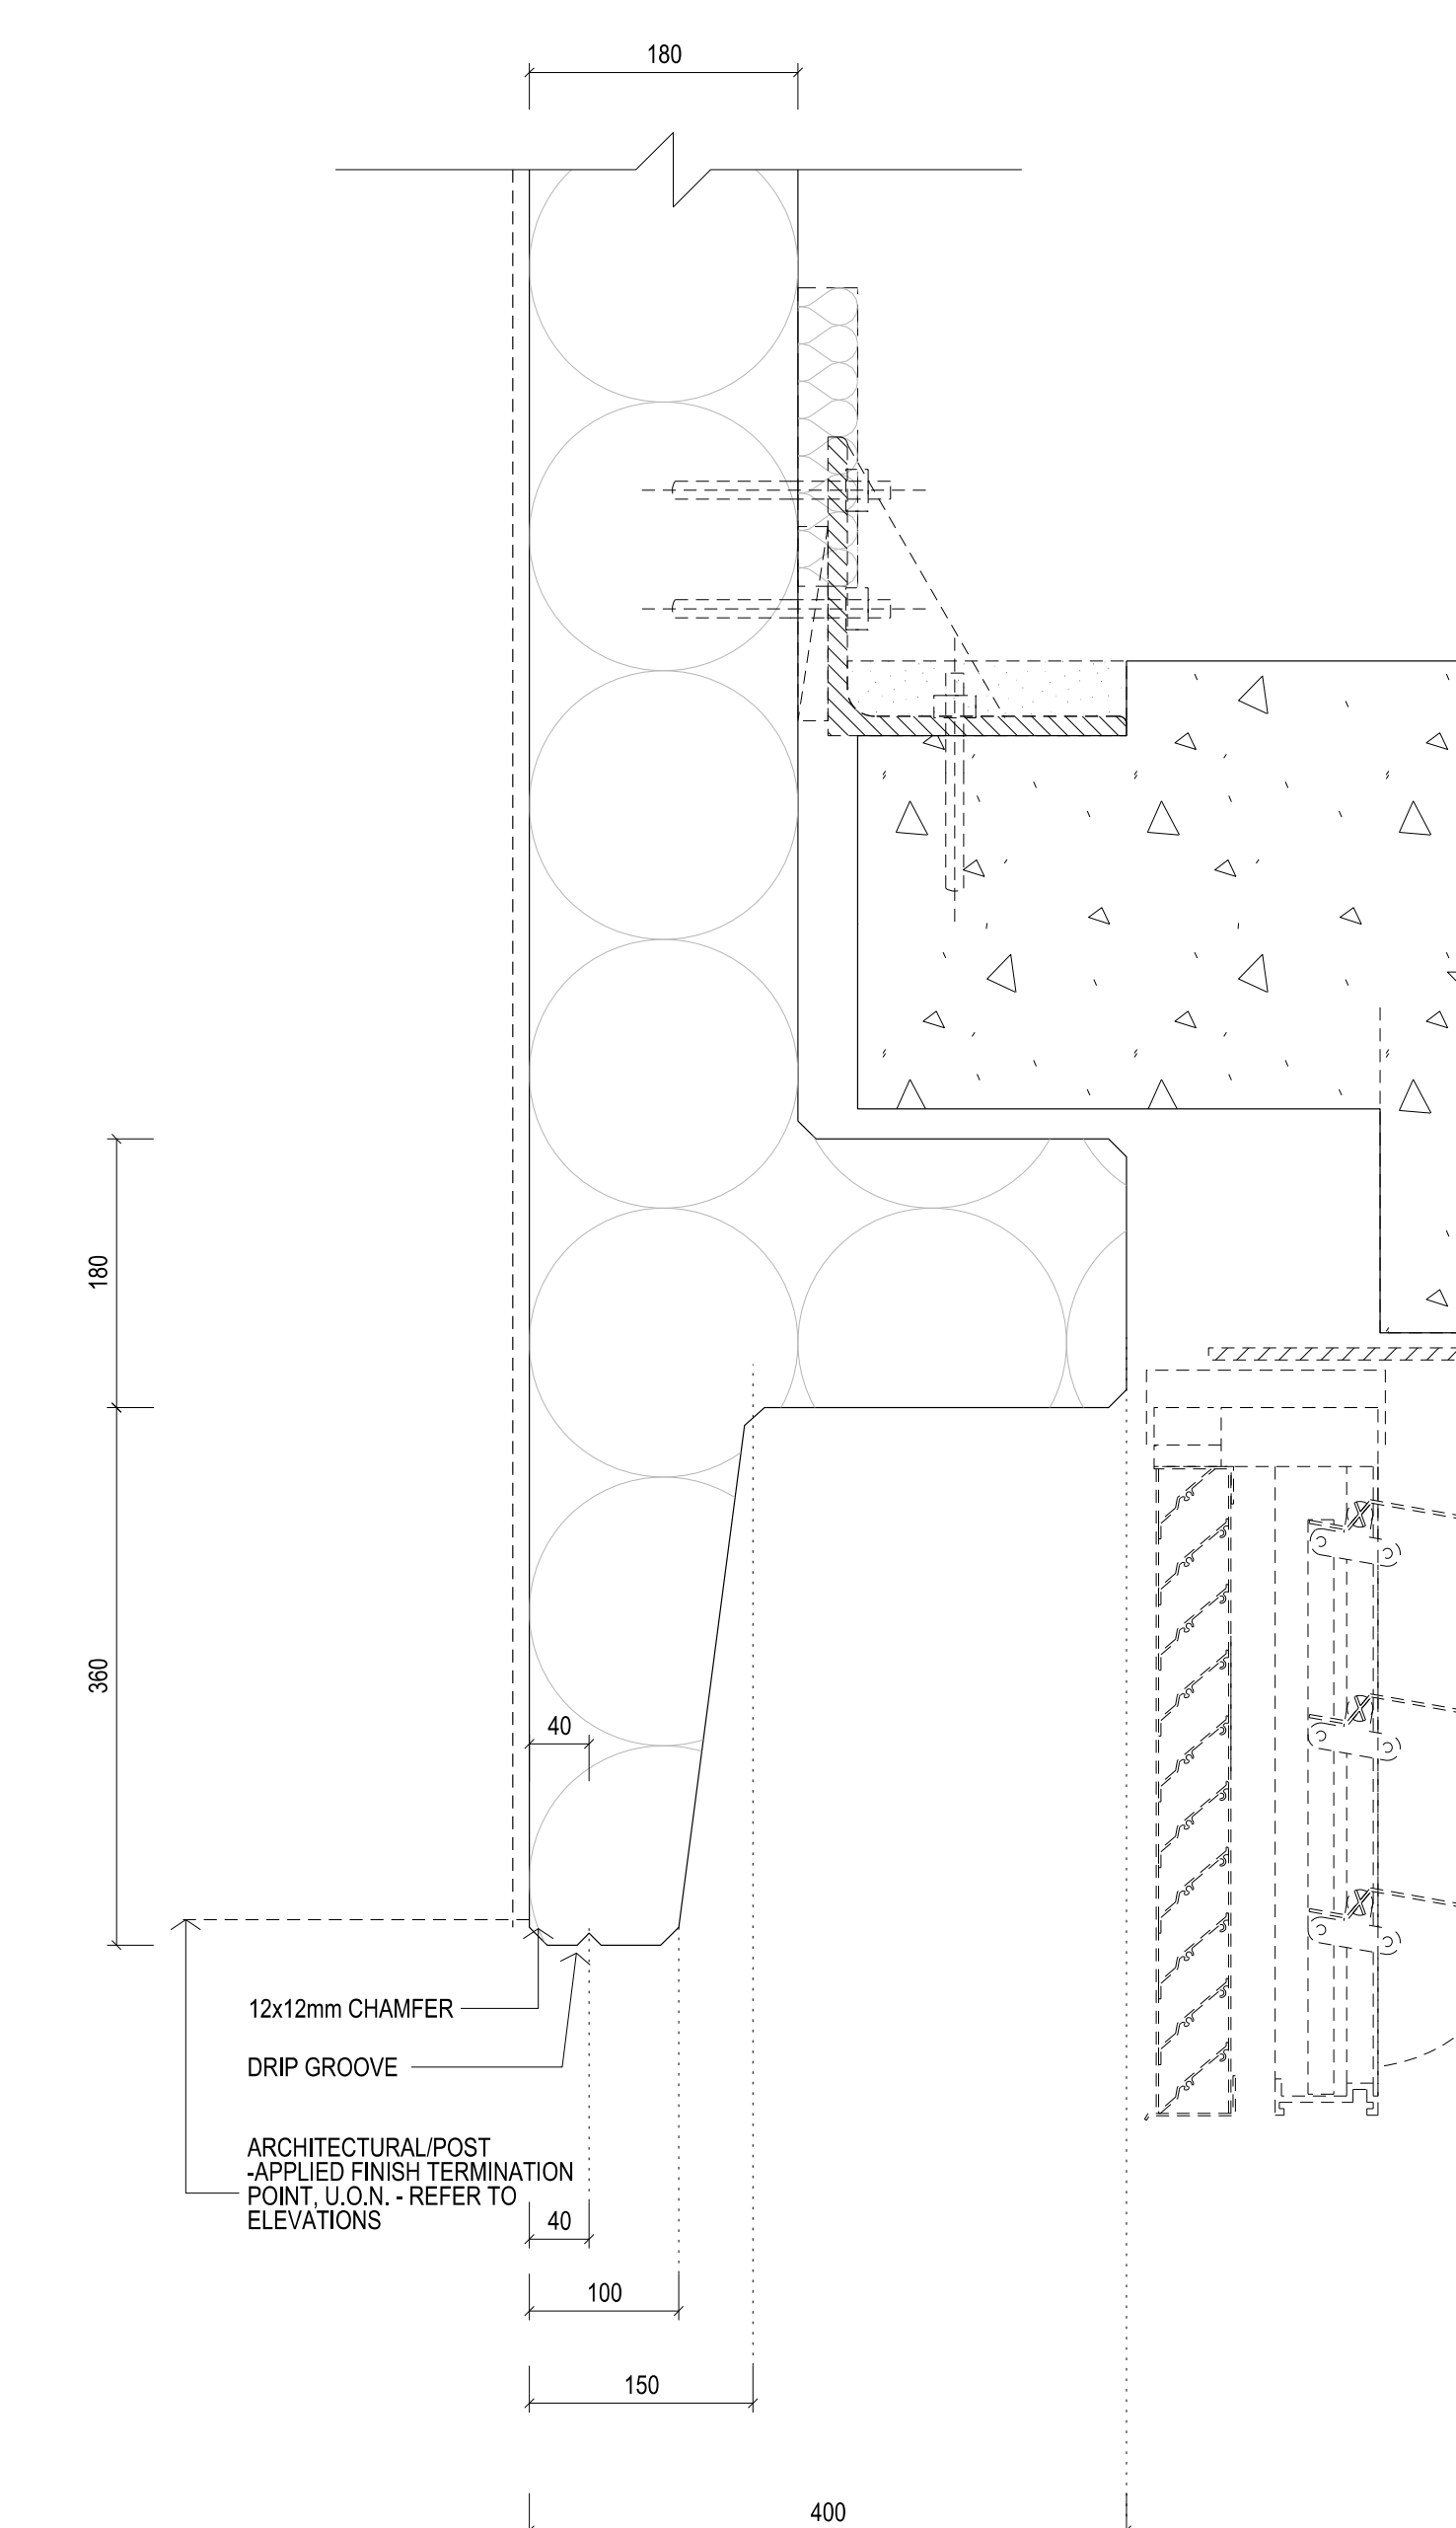


SECTION DETAIL
TYPICAL HEAD DETAIL AT TAPERED PANEL
SCALE 1:5

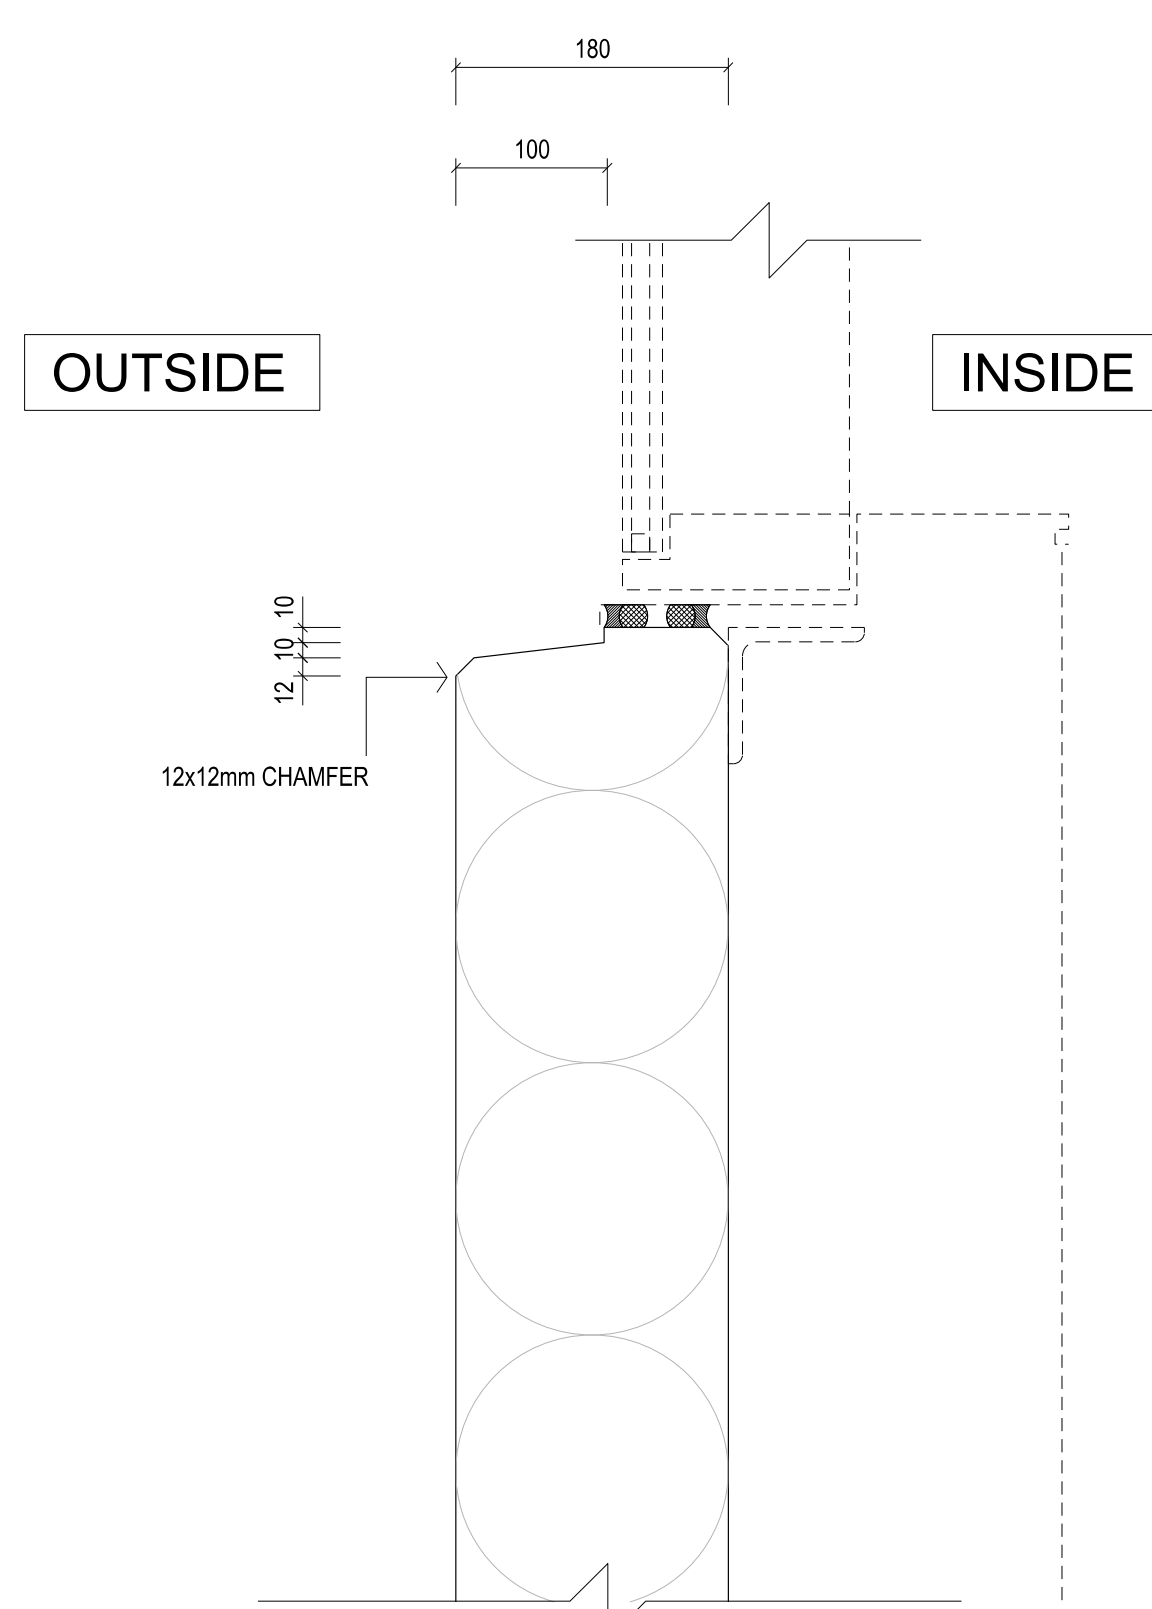

SECTION DETAIL
TYPICAL SILL DETAIL
SCALE 1:5

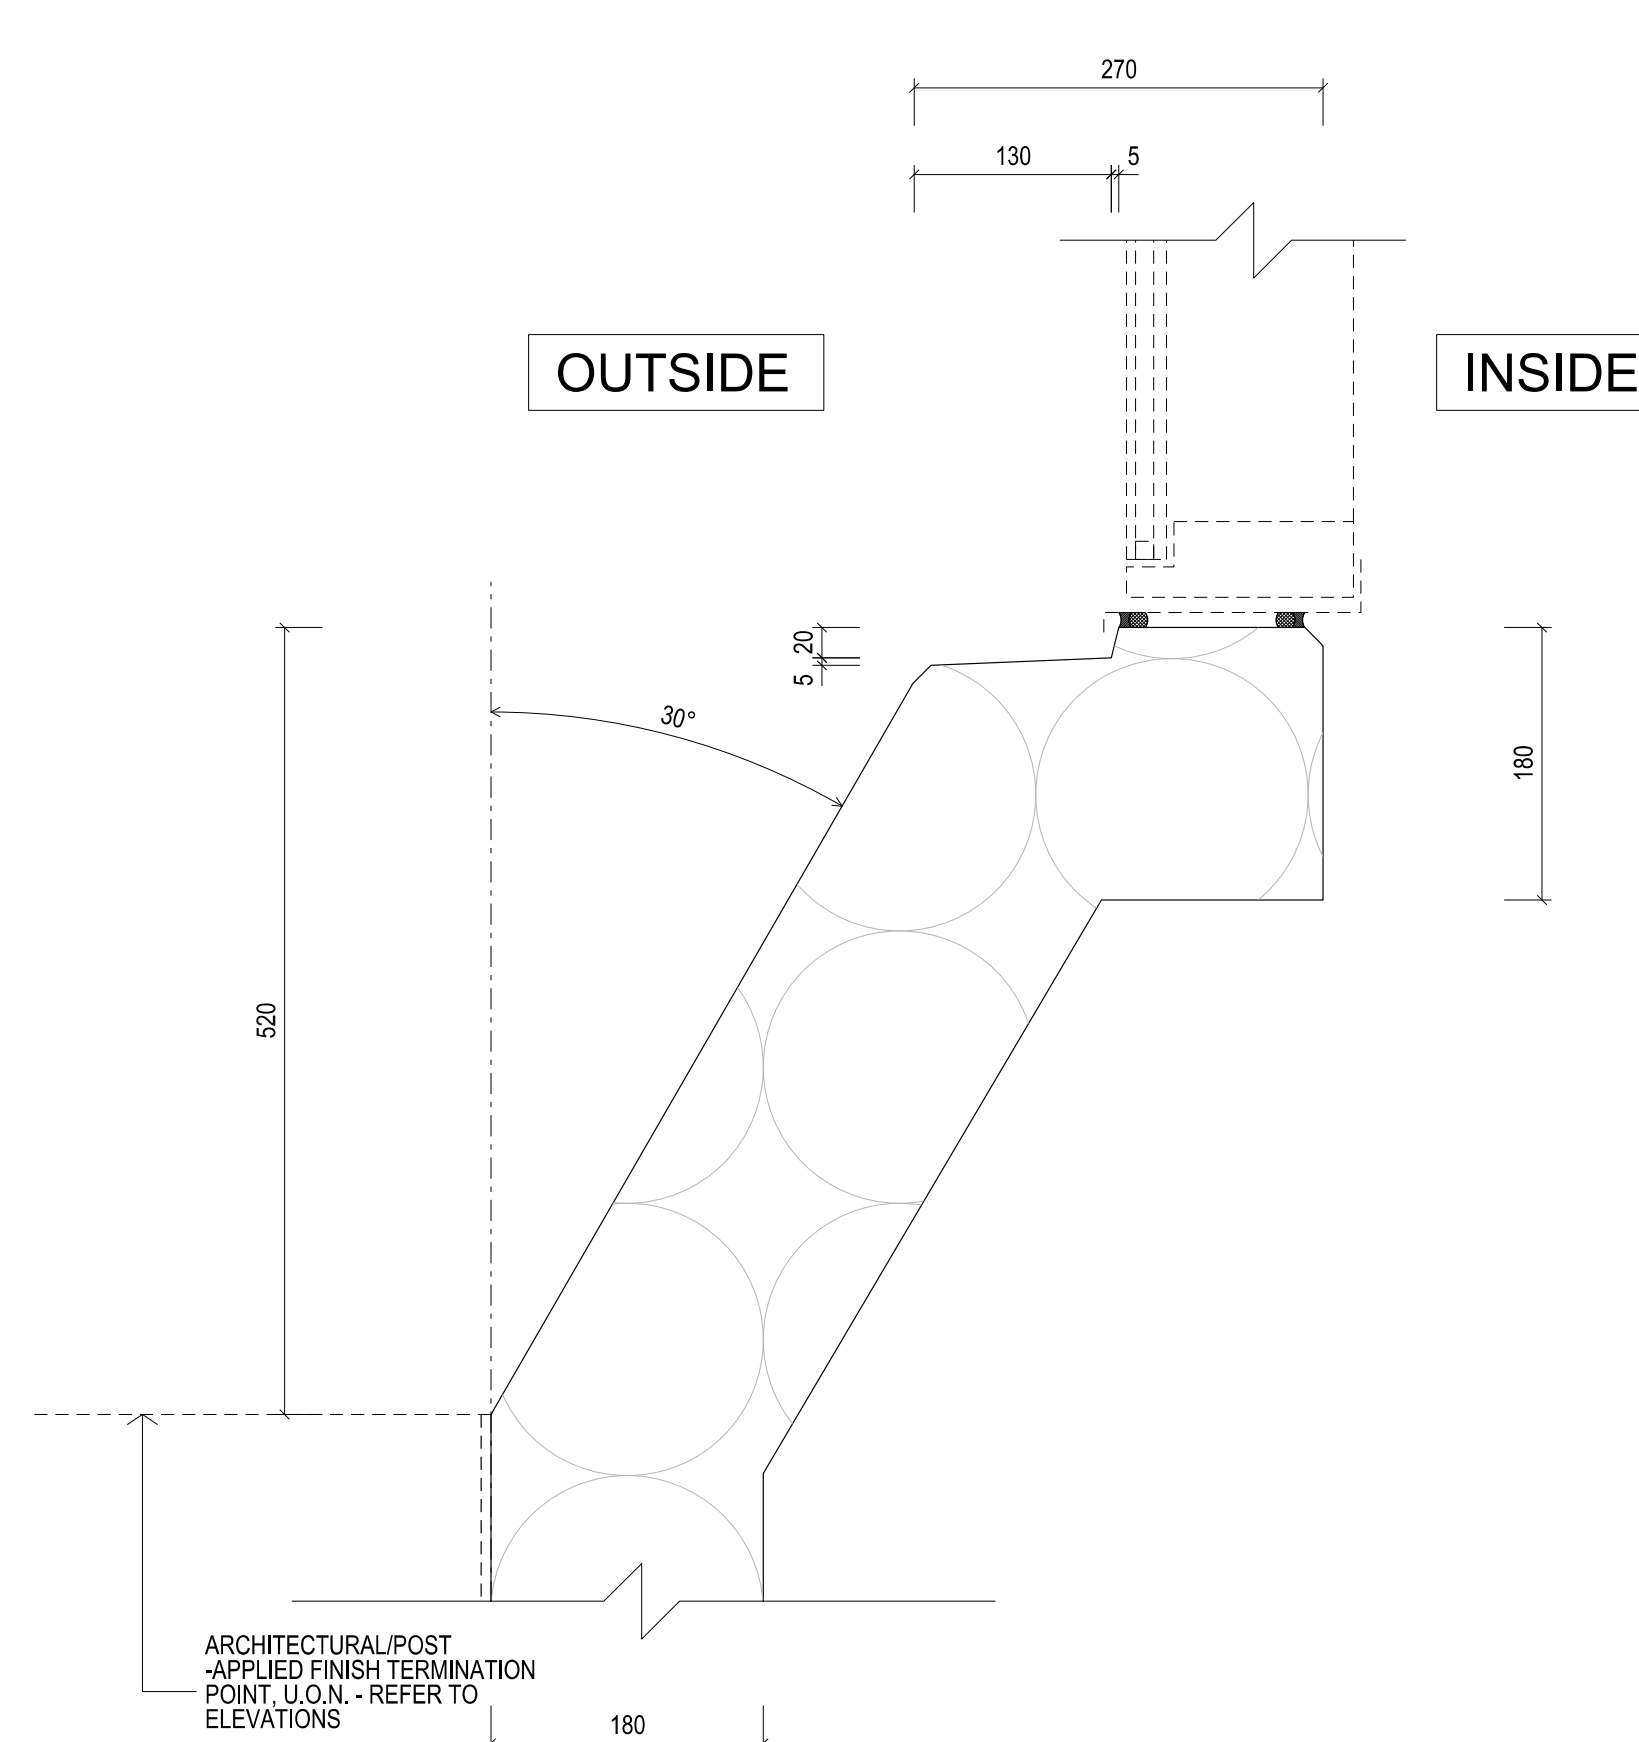

SECTION DETAIL
TYPICAL SILL DETAIL AT FOLDED PANEL
SCALE 1:5

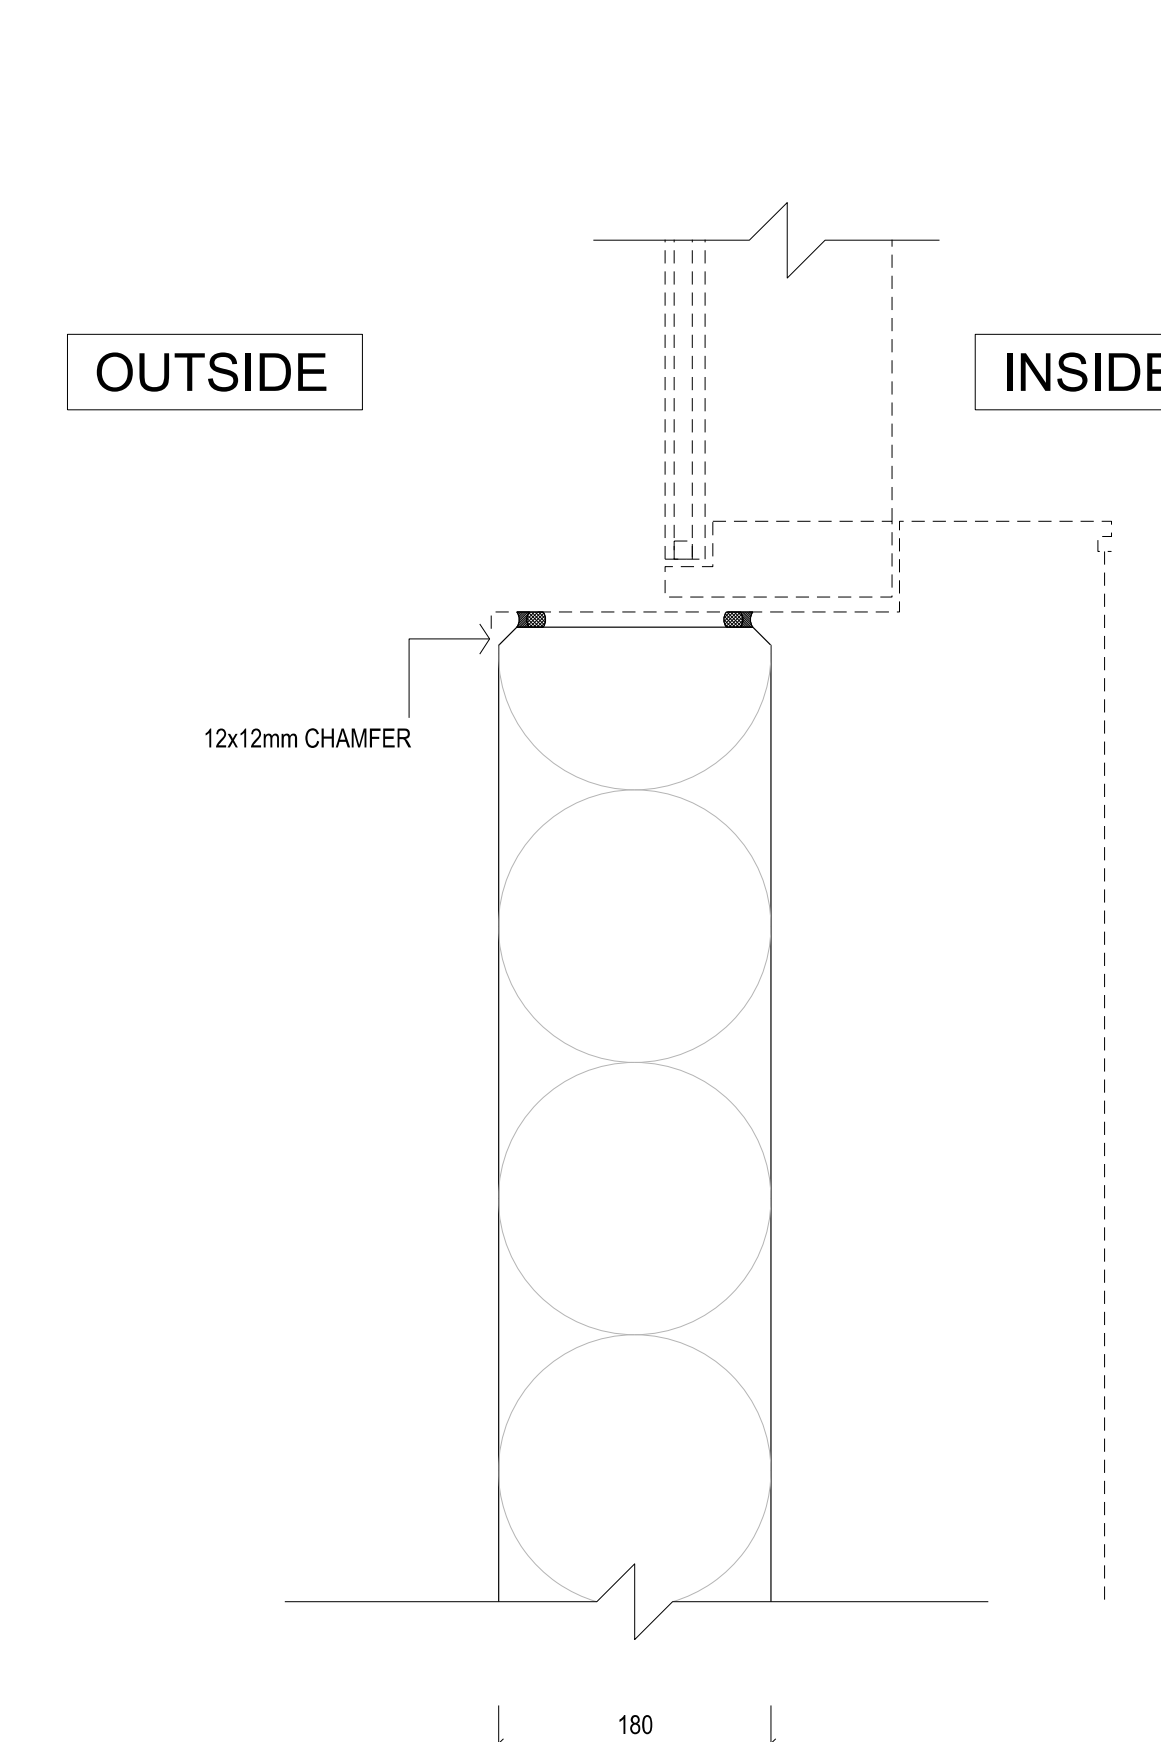

SECTION DETAIL
TYPICAL SILL DETAIL AT SOUTH FACADE
SCALE 1:5

Rev	Issue	Revision Description	And	Date
B	SG	UPDATES AS CLOUED	-	10.10.13
A	SG	ISSUED FOR CONSTRUCTION	-	11.03.13
05	SG	TENDER ISSUE	-	16.04.13
04	SG	VALUE MANAGEMENT ISSUE	-	28.03.13
03	SG	PRECAST REVIEW	-	21.03.13
02	SG	TENDER ADDENDUM 3	-	02.10.12
01	SG	100% CD - TENDER ISSUE	-	07.09.12



NADAAA
 NADAAA
 1520 Washington Street No.2 Boston Massachusetts 02118 USA
 Telephone +1 617 442 8232 Facsimile +1 688 442 1417 Email nadaa@nadaaa.com

John Wardle Architects
 25 Rokeby Street, Collingwood, Victoria 3066 Australia
 Tel: +61 3 8662 0400 www.johnwardlearchitects.com
 © 2012 John Wardle Architects ABN 83 006 814 268

Client **University of Melbourne Parkville Campus**

Project **Faculty of Architecture Building and Planning**

Title **TYPICAL PRECAST DETAILS SHEET 3**

Project No.	0913	Scale	1:5 @ A0 1:10 @ A2
Drawing No.	AR 6302	Revision	B

Date Sep 2012 Dwn - Co-Ord - Chk -

FILENAME - \$FILES

FOR CONSTRUCTION