


CONTRACTORS SHALL VERIFY DIMENSIONS BEFORE ANY JOB COMMENCES. ALL SHOP DRAWINGS SHALL BE SUBMITTED TO THE SUPERINTENDENT AND MANUFACTURER SHALL NOT COMMENCE PRIOR TO THE RETURN OF DIMENSIONS SHOP DRAWINGS REVIEWED BY THE CONSULTANT FIGURED DIMENSIONS SHALL TAKE PRECEDENCE OVER SCALED. THIS DRAWING SHALL BE READ IN CONJUNCTION WITH ALL RELEVANT CONTRACT SPECIFICATIONS AND DRAWINGS COPYRIGHT OF THIS DRAWING IS VESTED IN NADAAA


General Notes

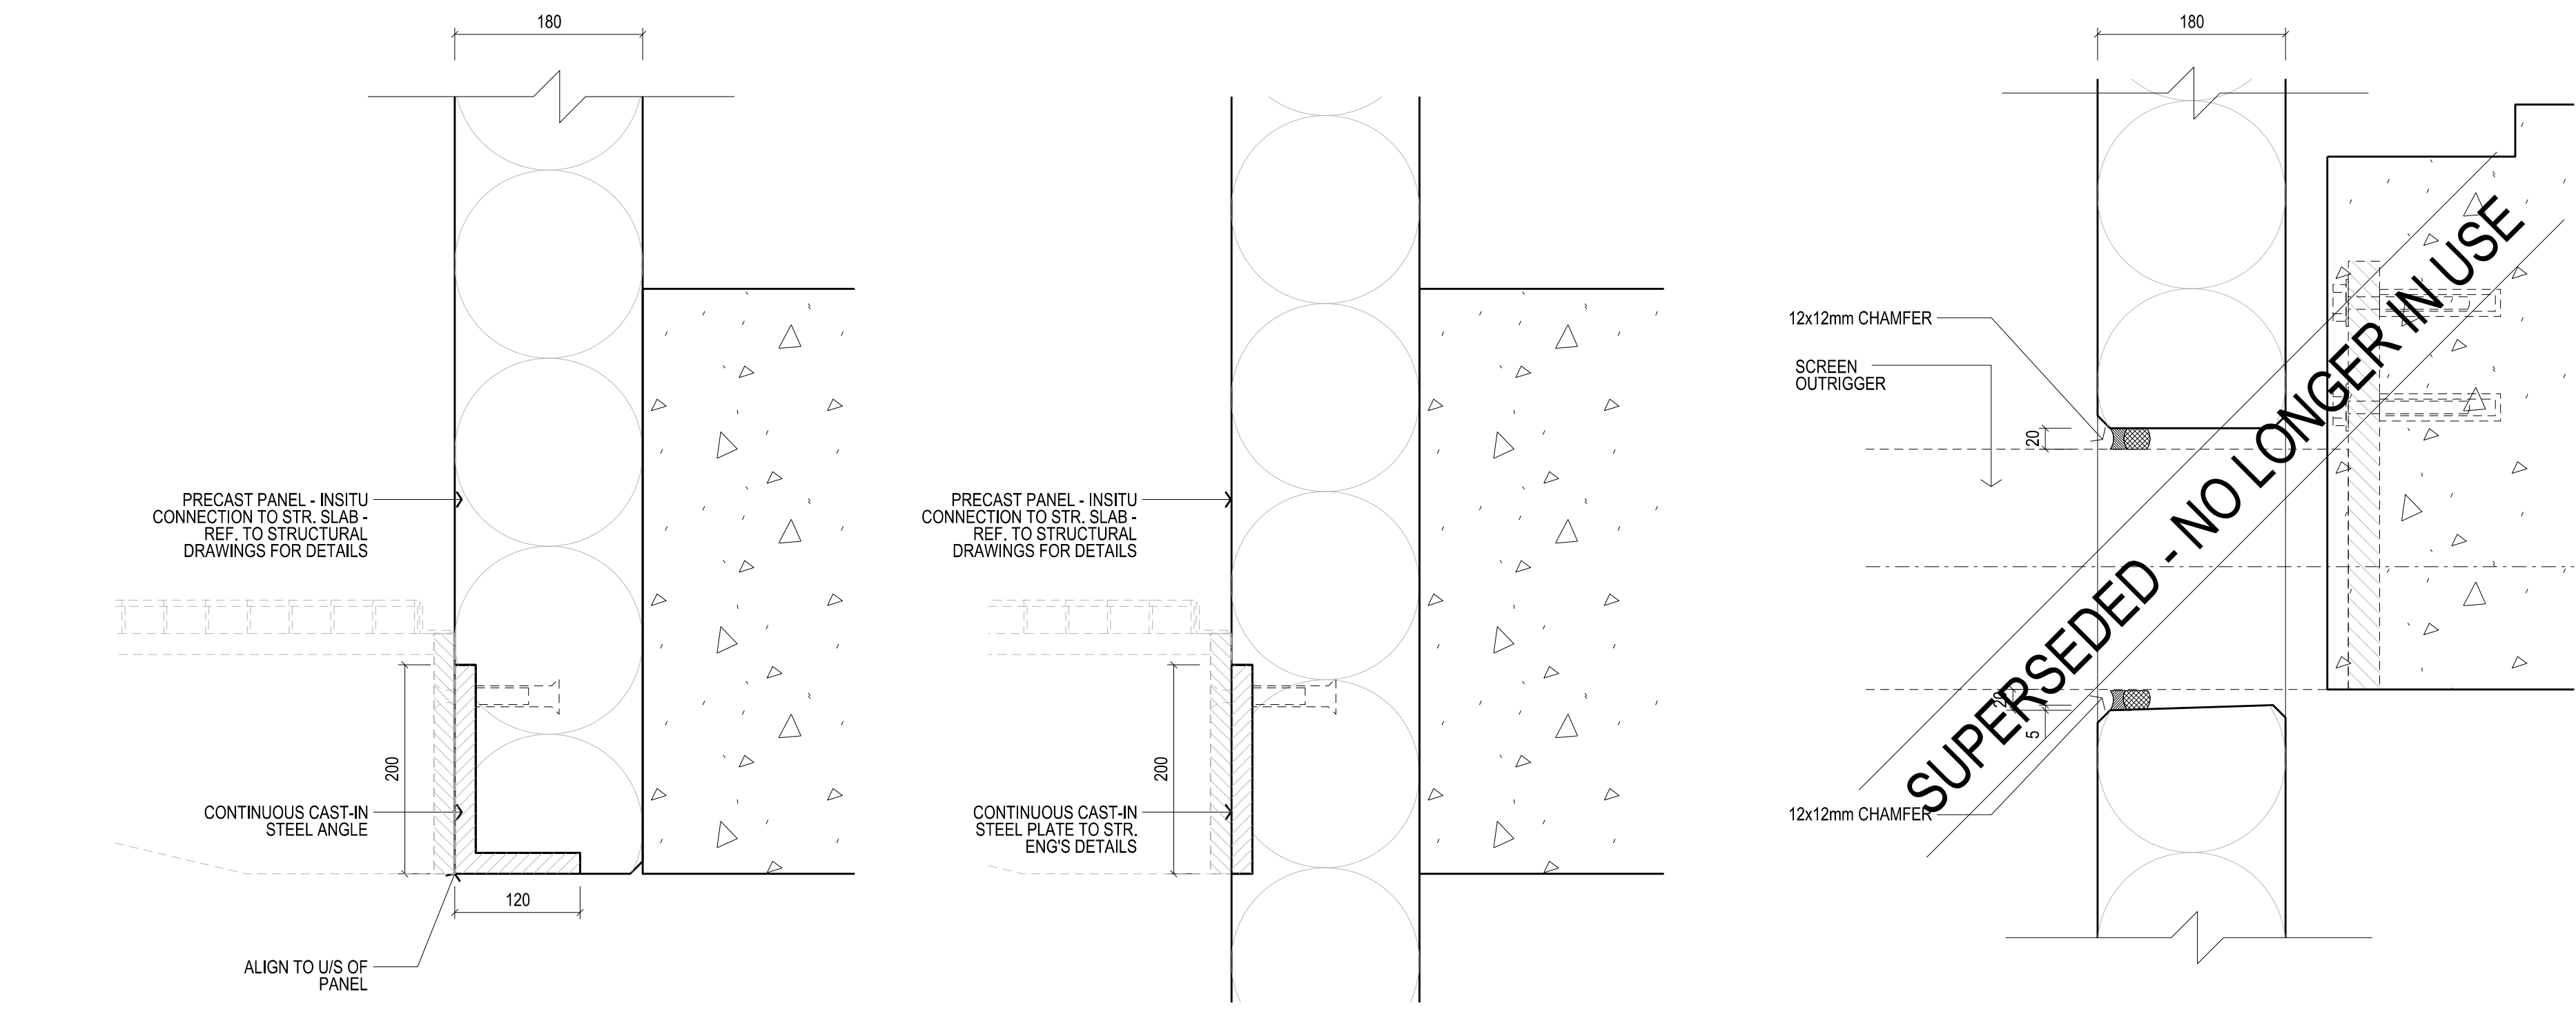

SECTION DETAIL  
01 TYP. INTERFACE AT SCREEN OUTRIGGERS  
SCALE 1:5


SECTION DETAIL  
02 INTERFACE AT SCREEN OUTRIGGERS  
SCALE 1:5  
DETAIL OCCURS WHERE  
PANEL HEIGHT DROPS  
BELOW ADJ. SLAB

SECTION DETAIL  
03 TYPICAL PANEL OPENING THROUGH OUTRIGGER  
SCALE 1:5

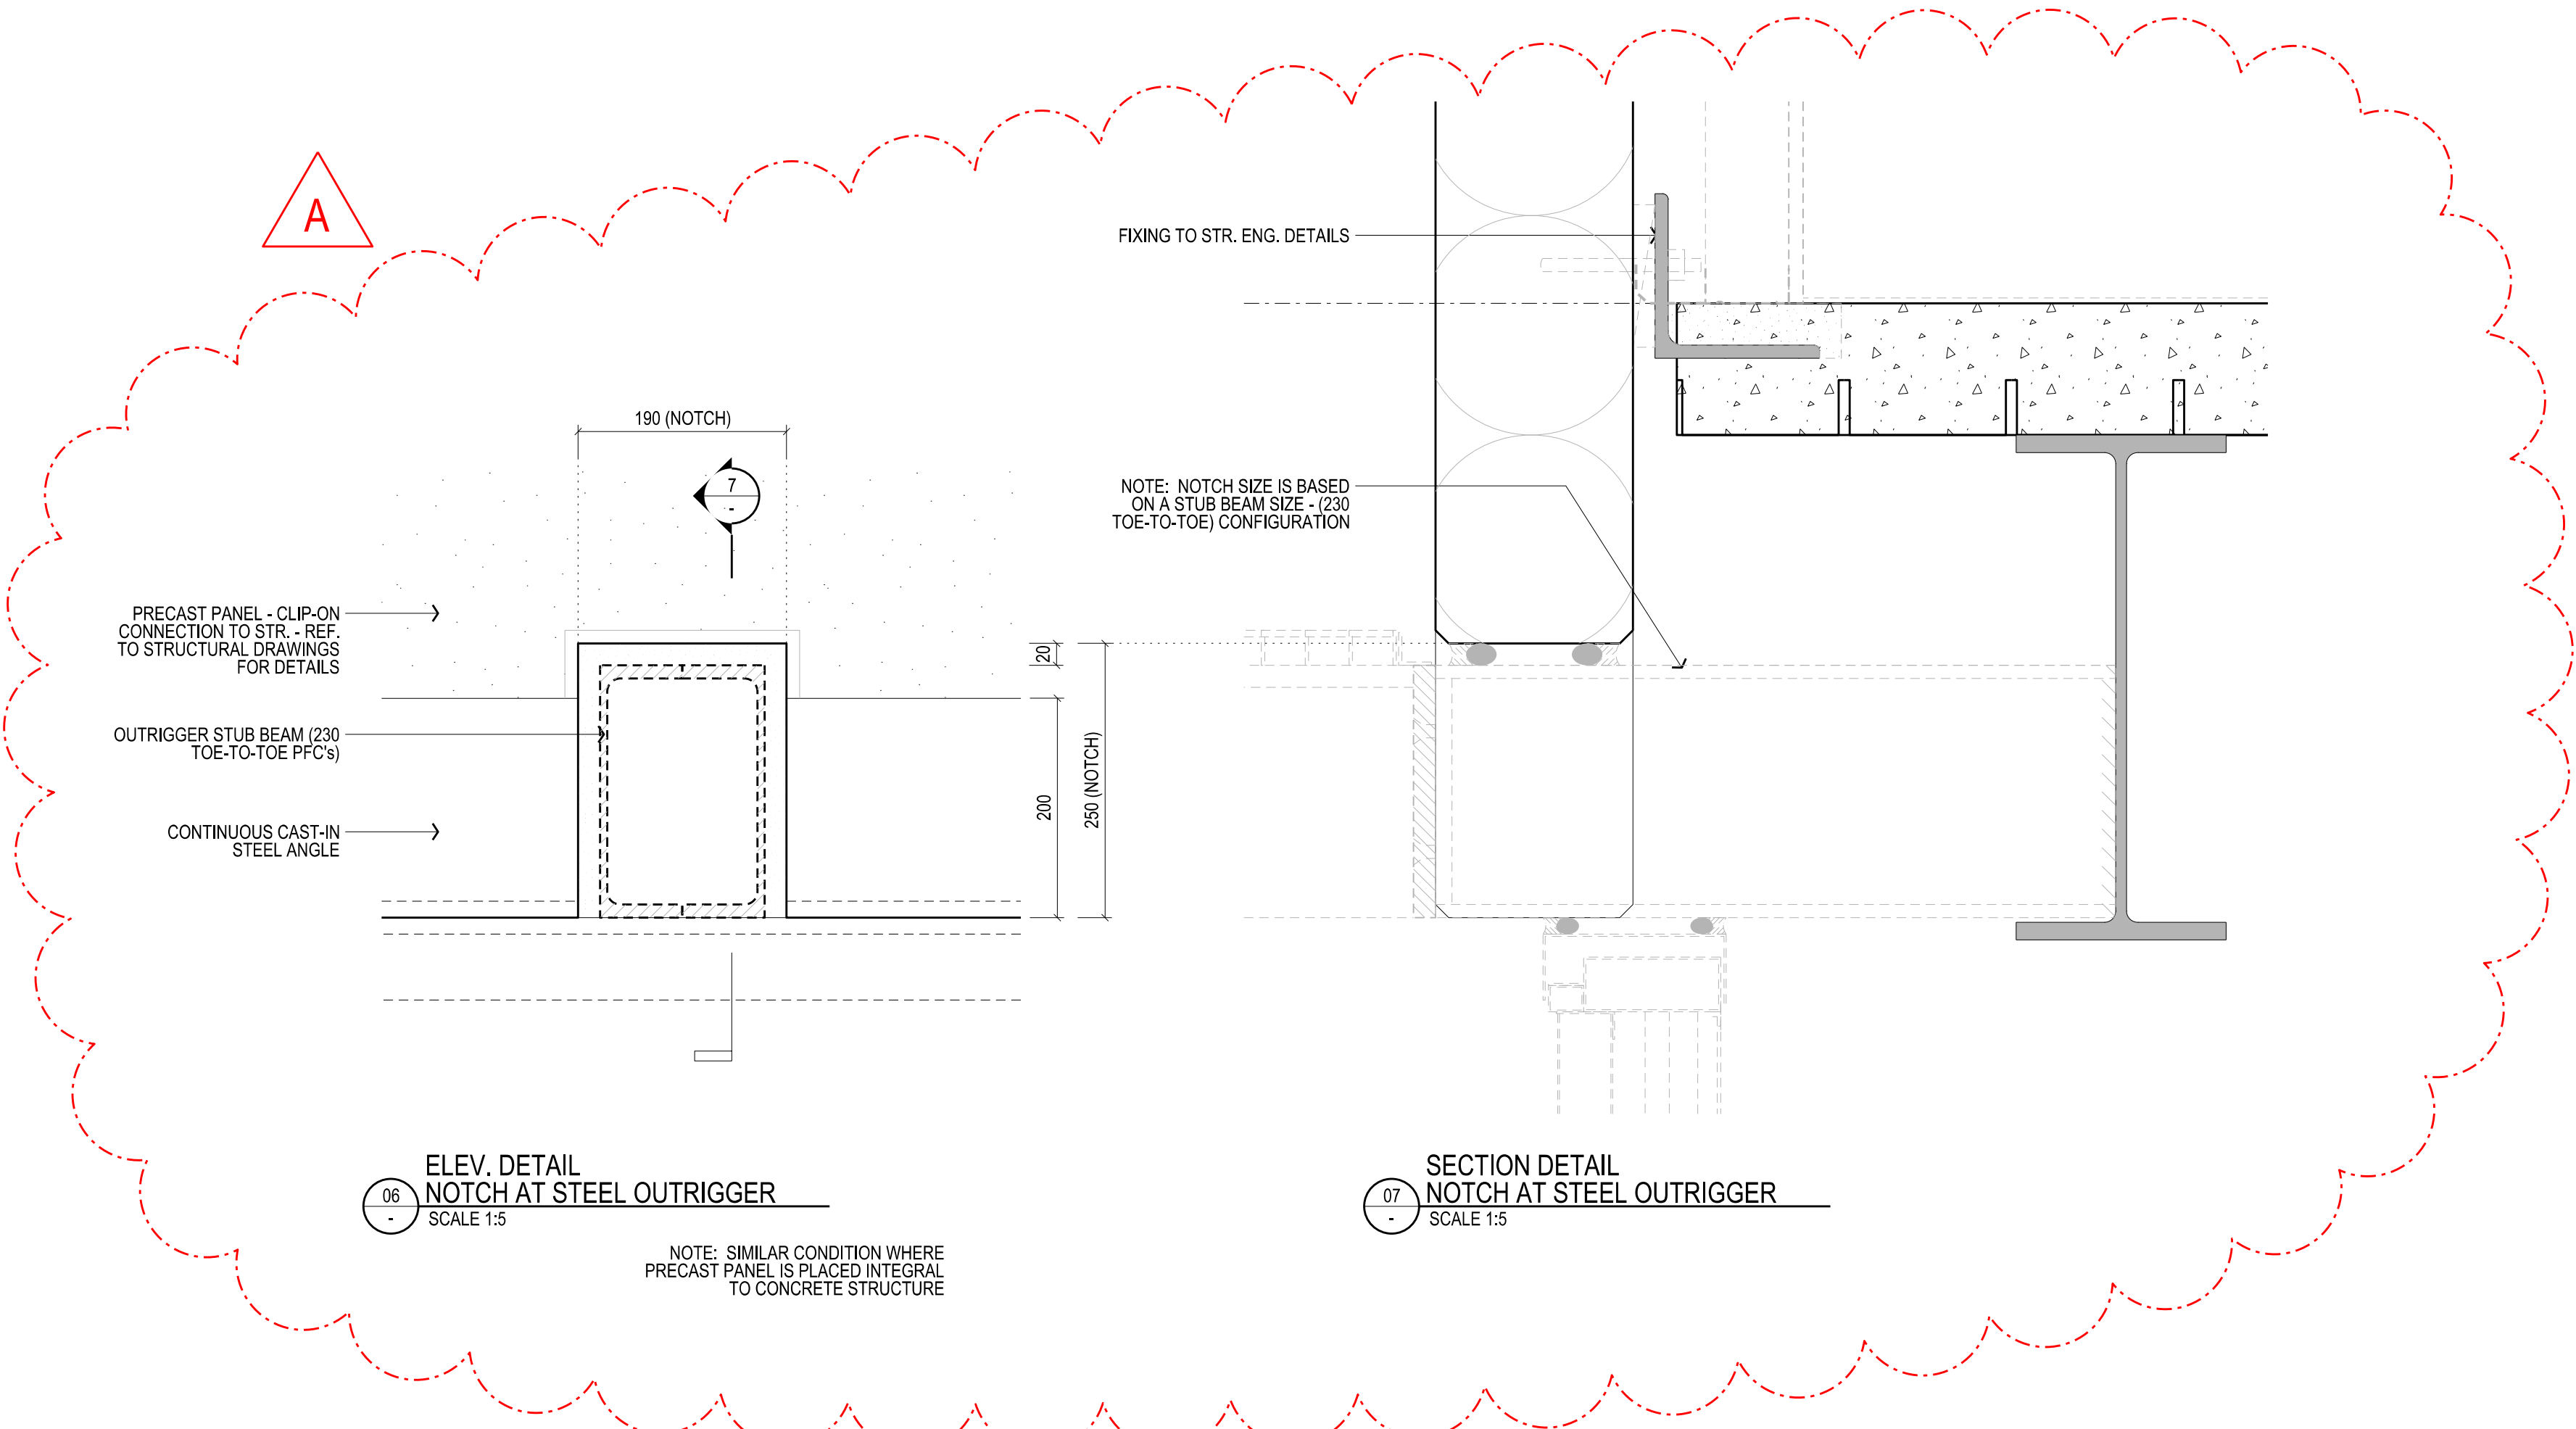


ELEV. DETAIL  
04 NOTCH AT STEEL OUTRIGGER  
SCALE 1:5  
NOTE: SIMILAR CONDITION WHERE  
PRECAST PANEL IS PLACED INTEGRAL  
TO CONCRETE STRUCTURE

SECTION DETAIL  
05 NOTCH AT STEEL OUTRIGGER  
SCALE 1:5

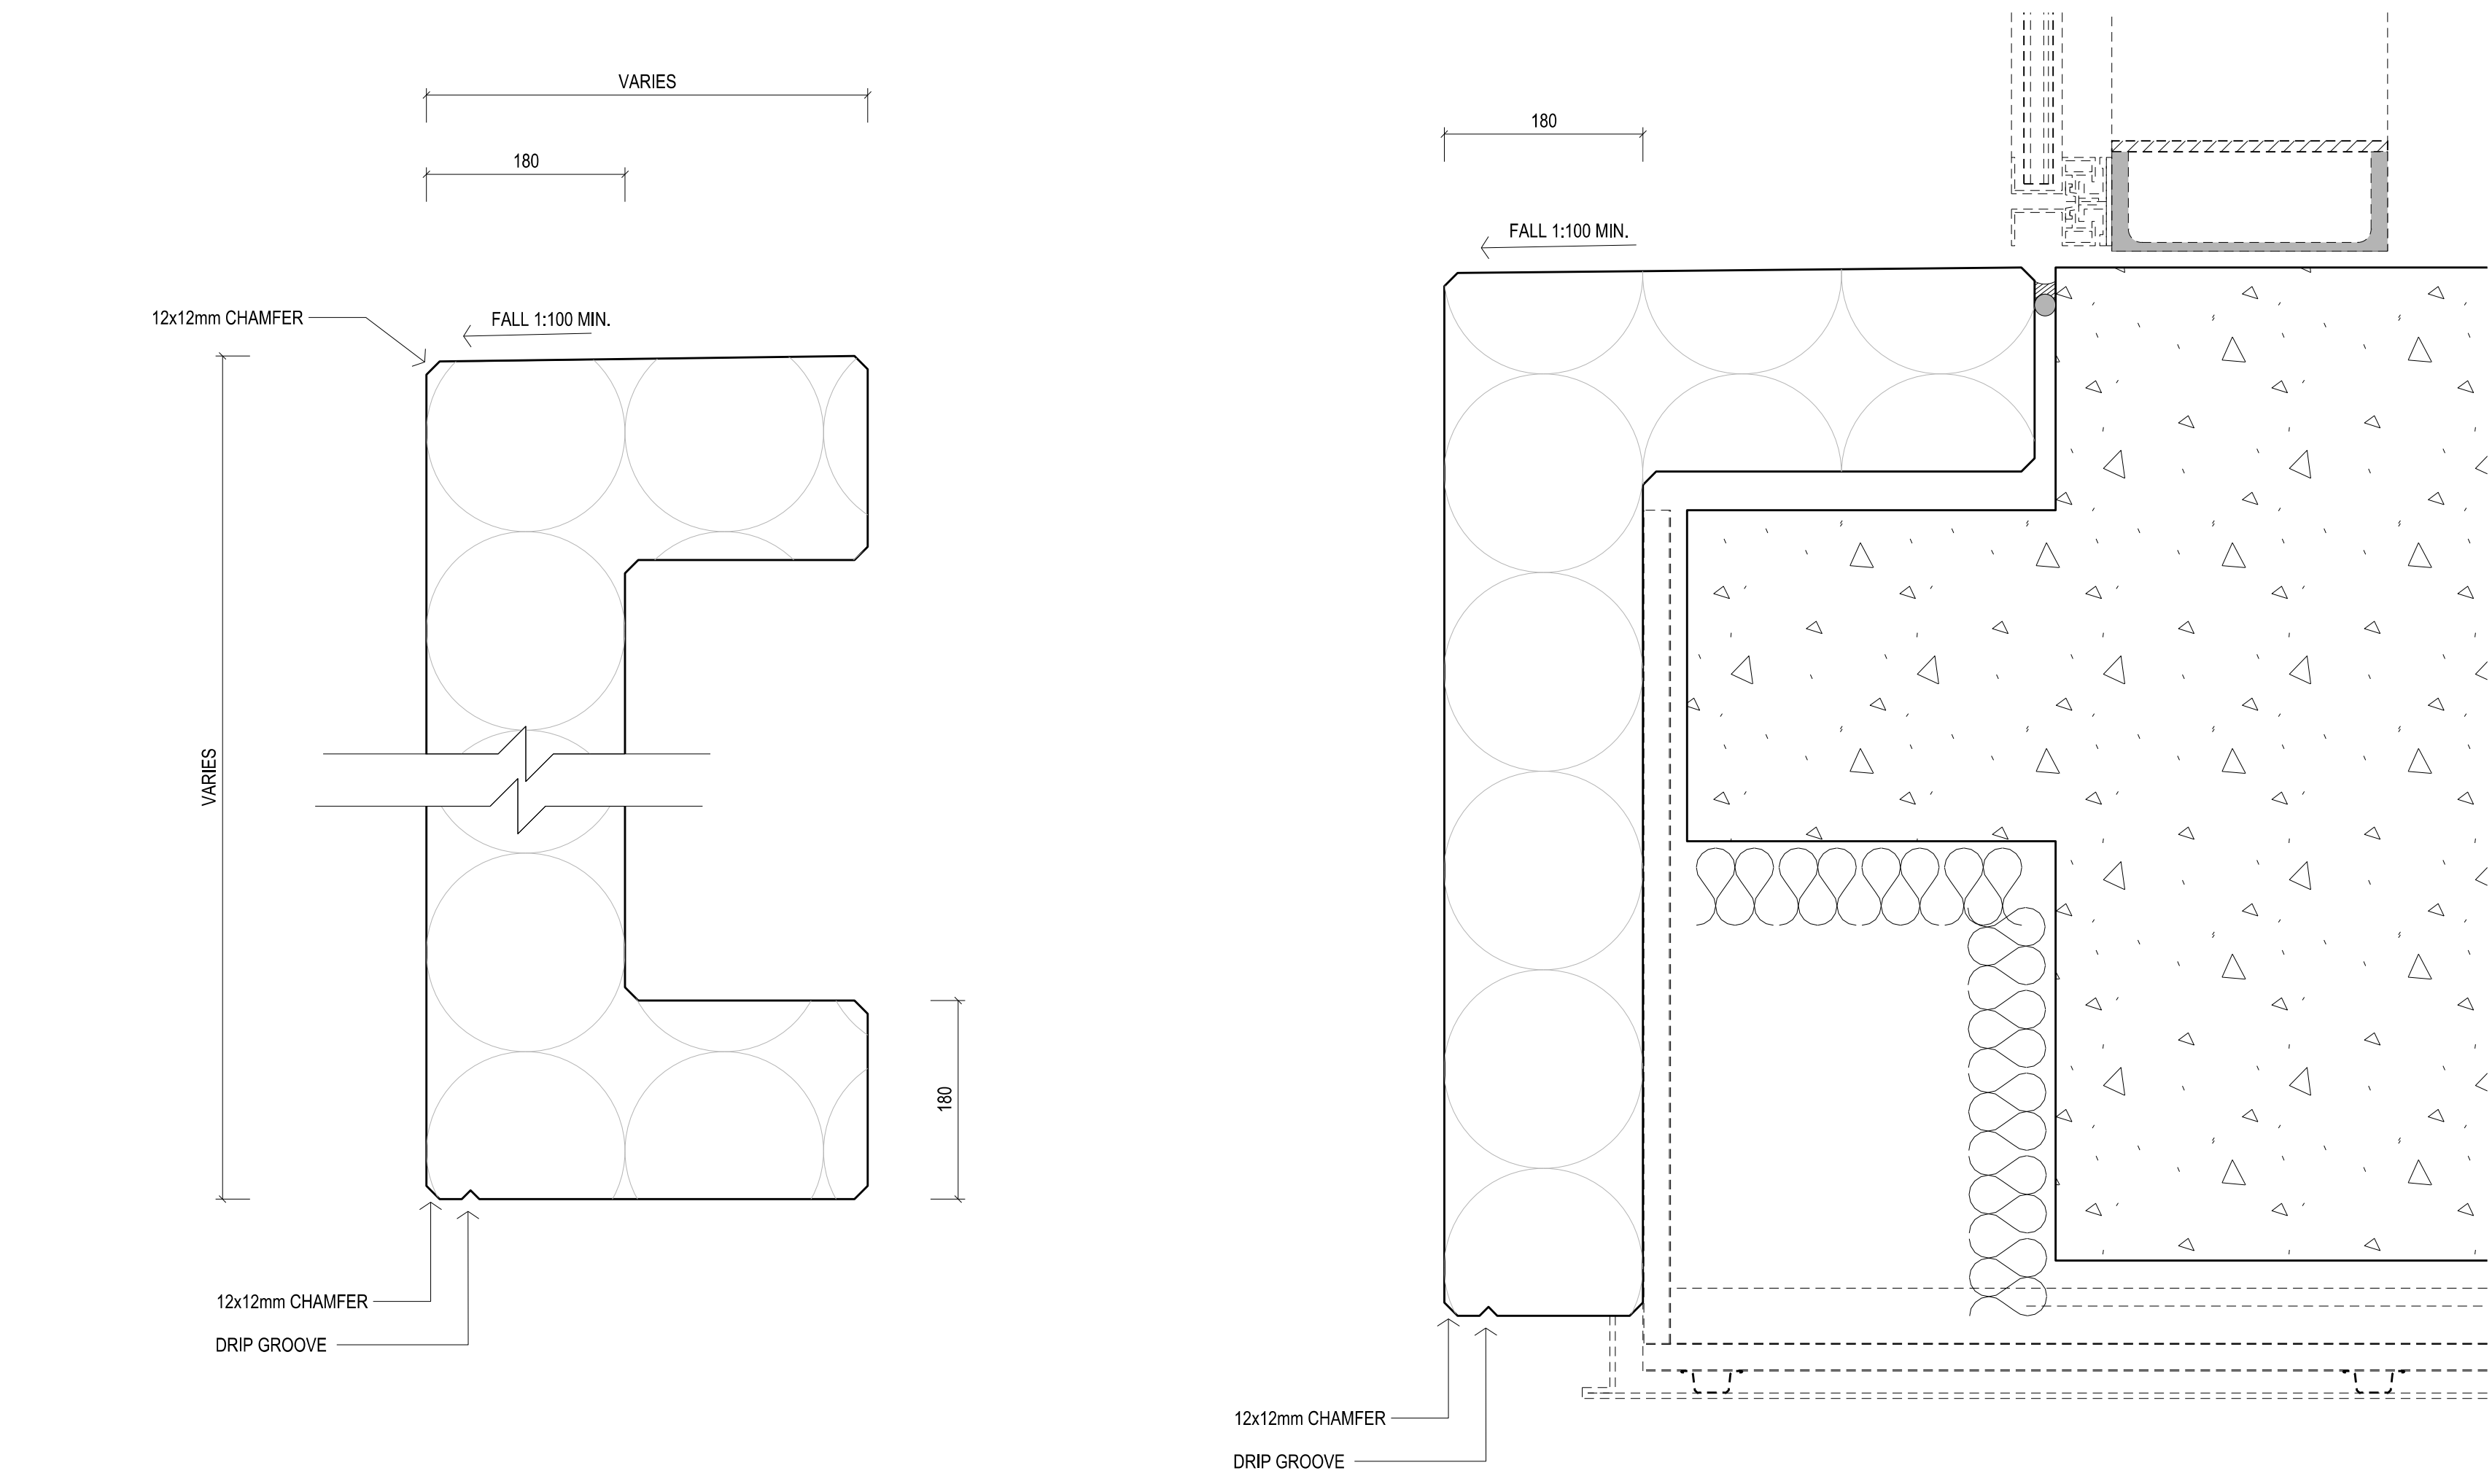


SECTION DETAIL  
06 TYPICAL DOUBLE-RETURN PANEL  
SCALE 1:5

SECTION DETAIL  
07 WINDOW SILL WITH UPPER-RETURN PANEL  
SCALE 1:5

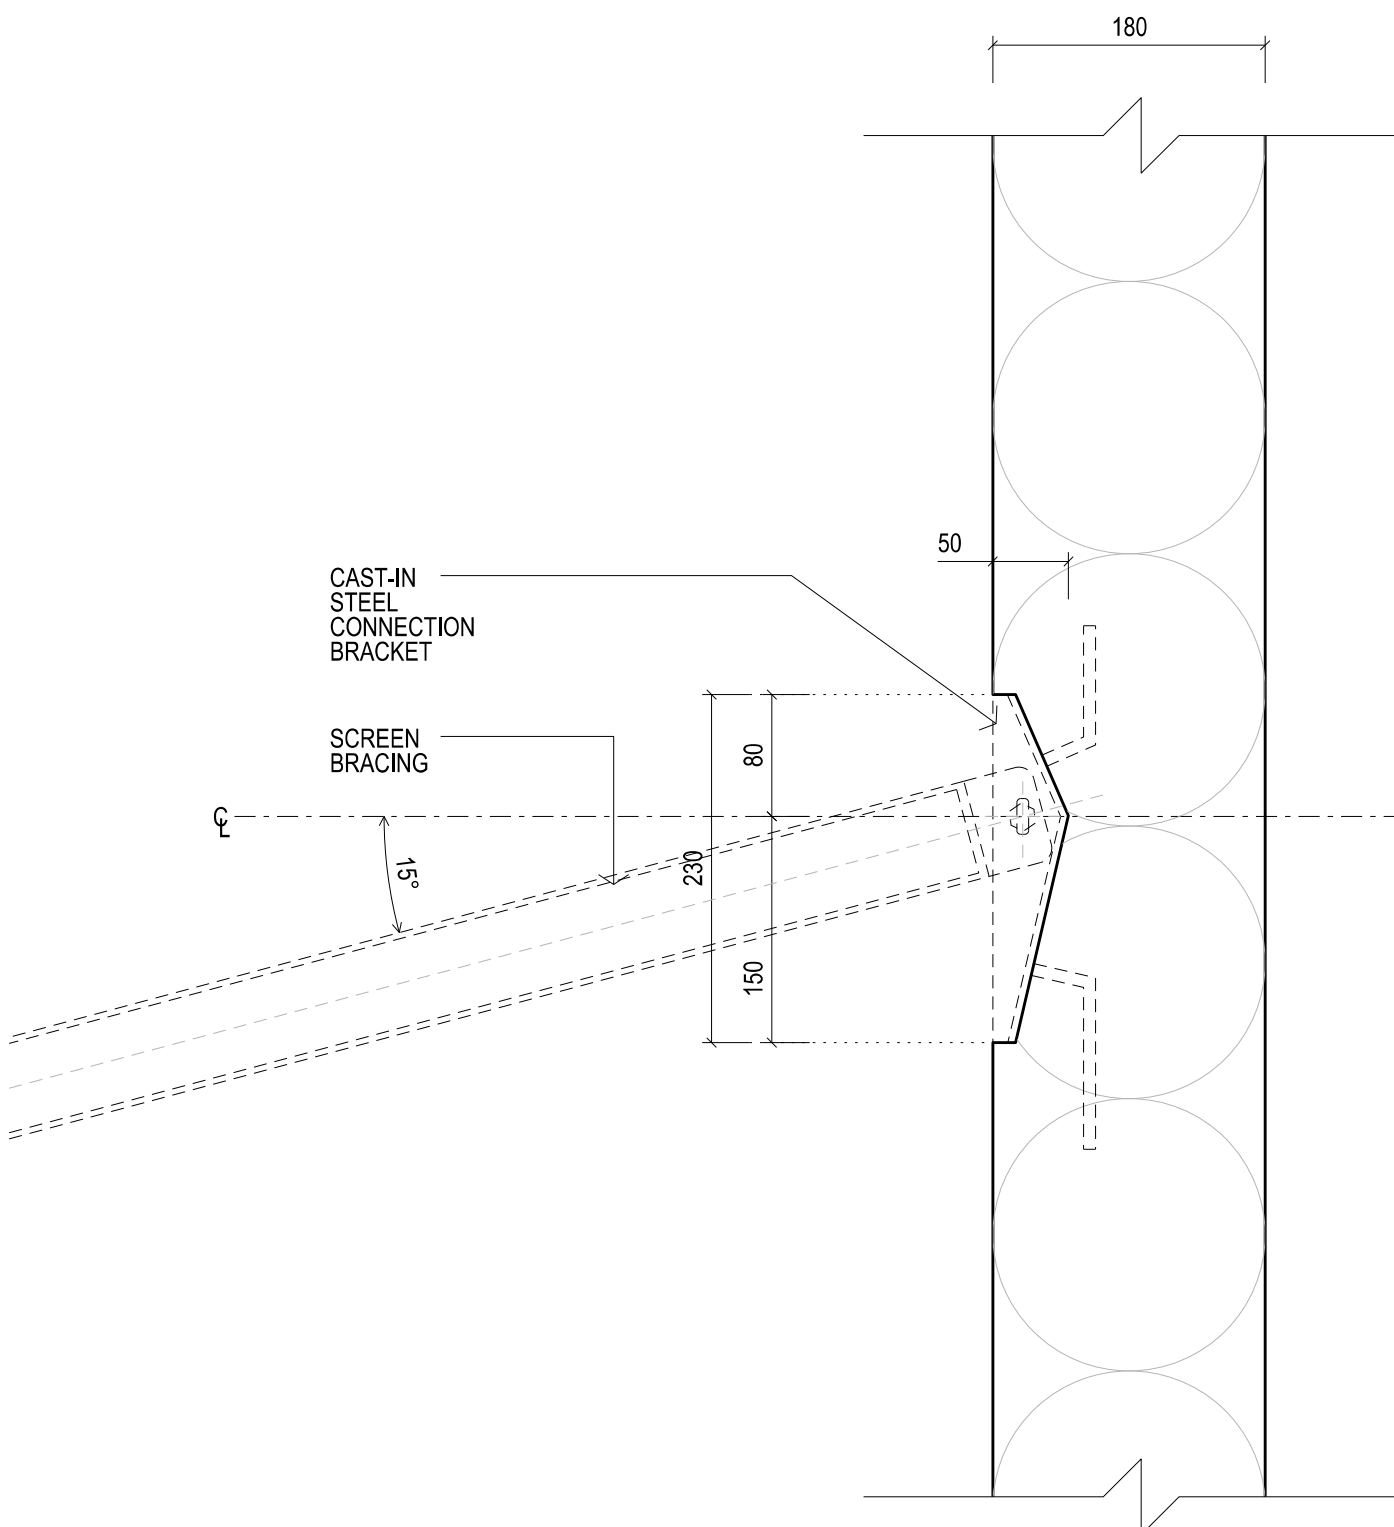

SECTION DETAIL  
08 REBATE PROFILE AT SCREEN OUTRIGGERS  
SCALE 1:5

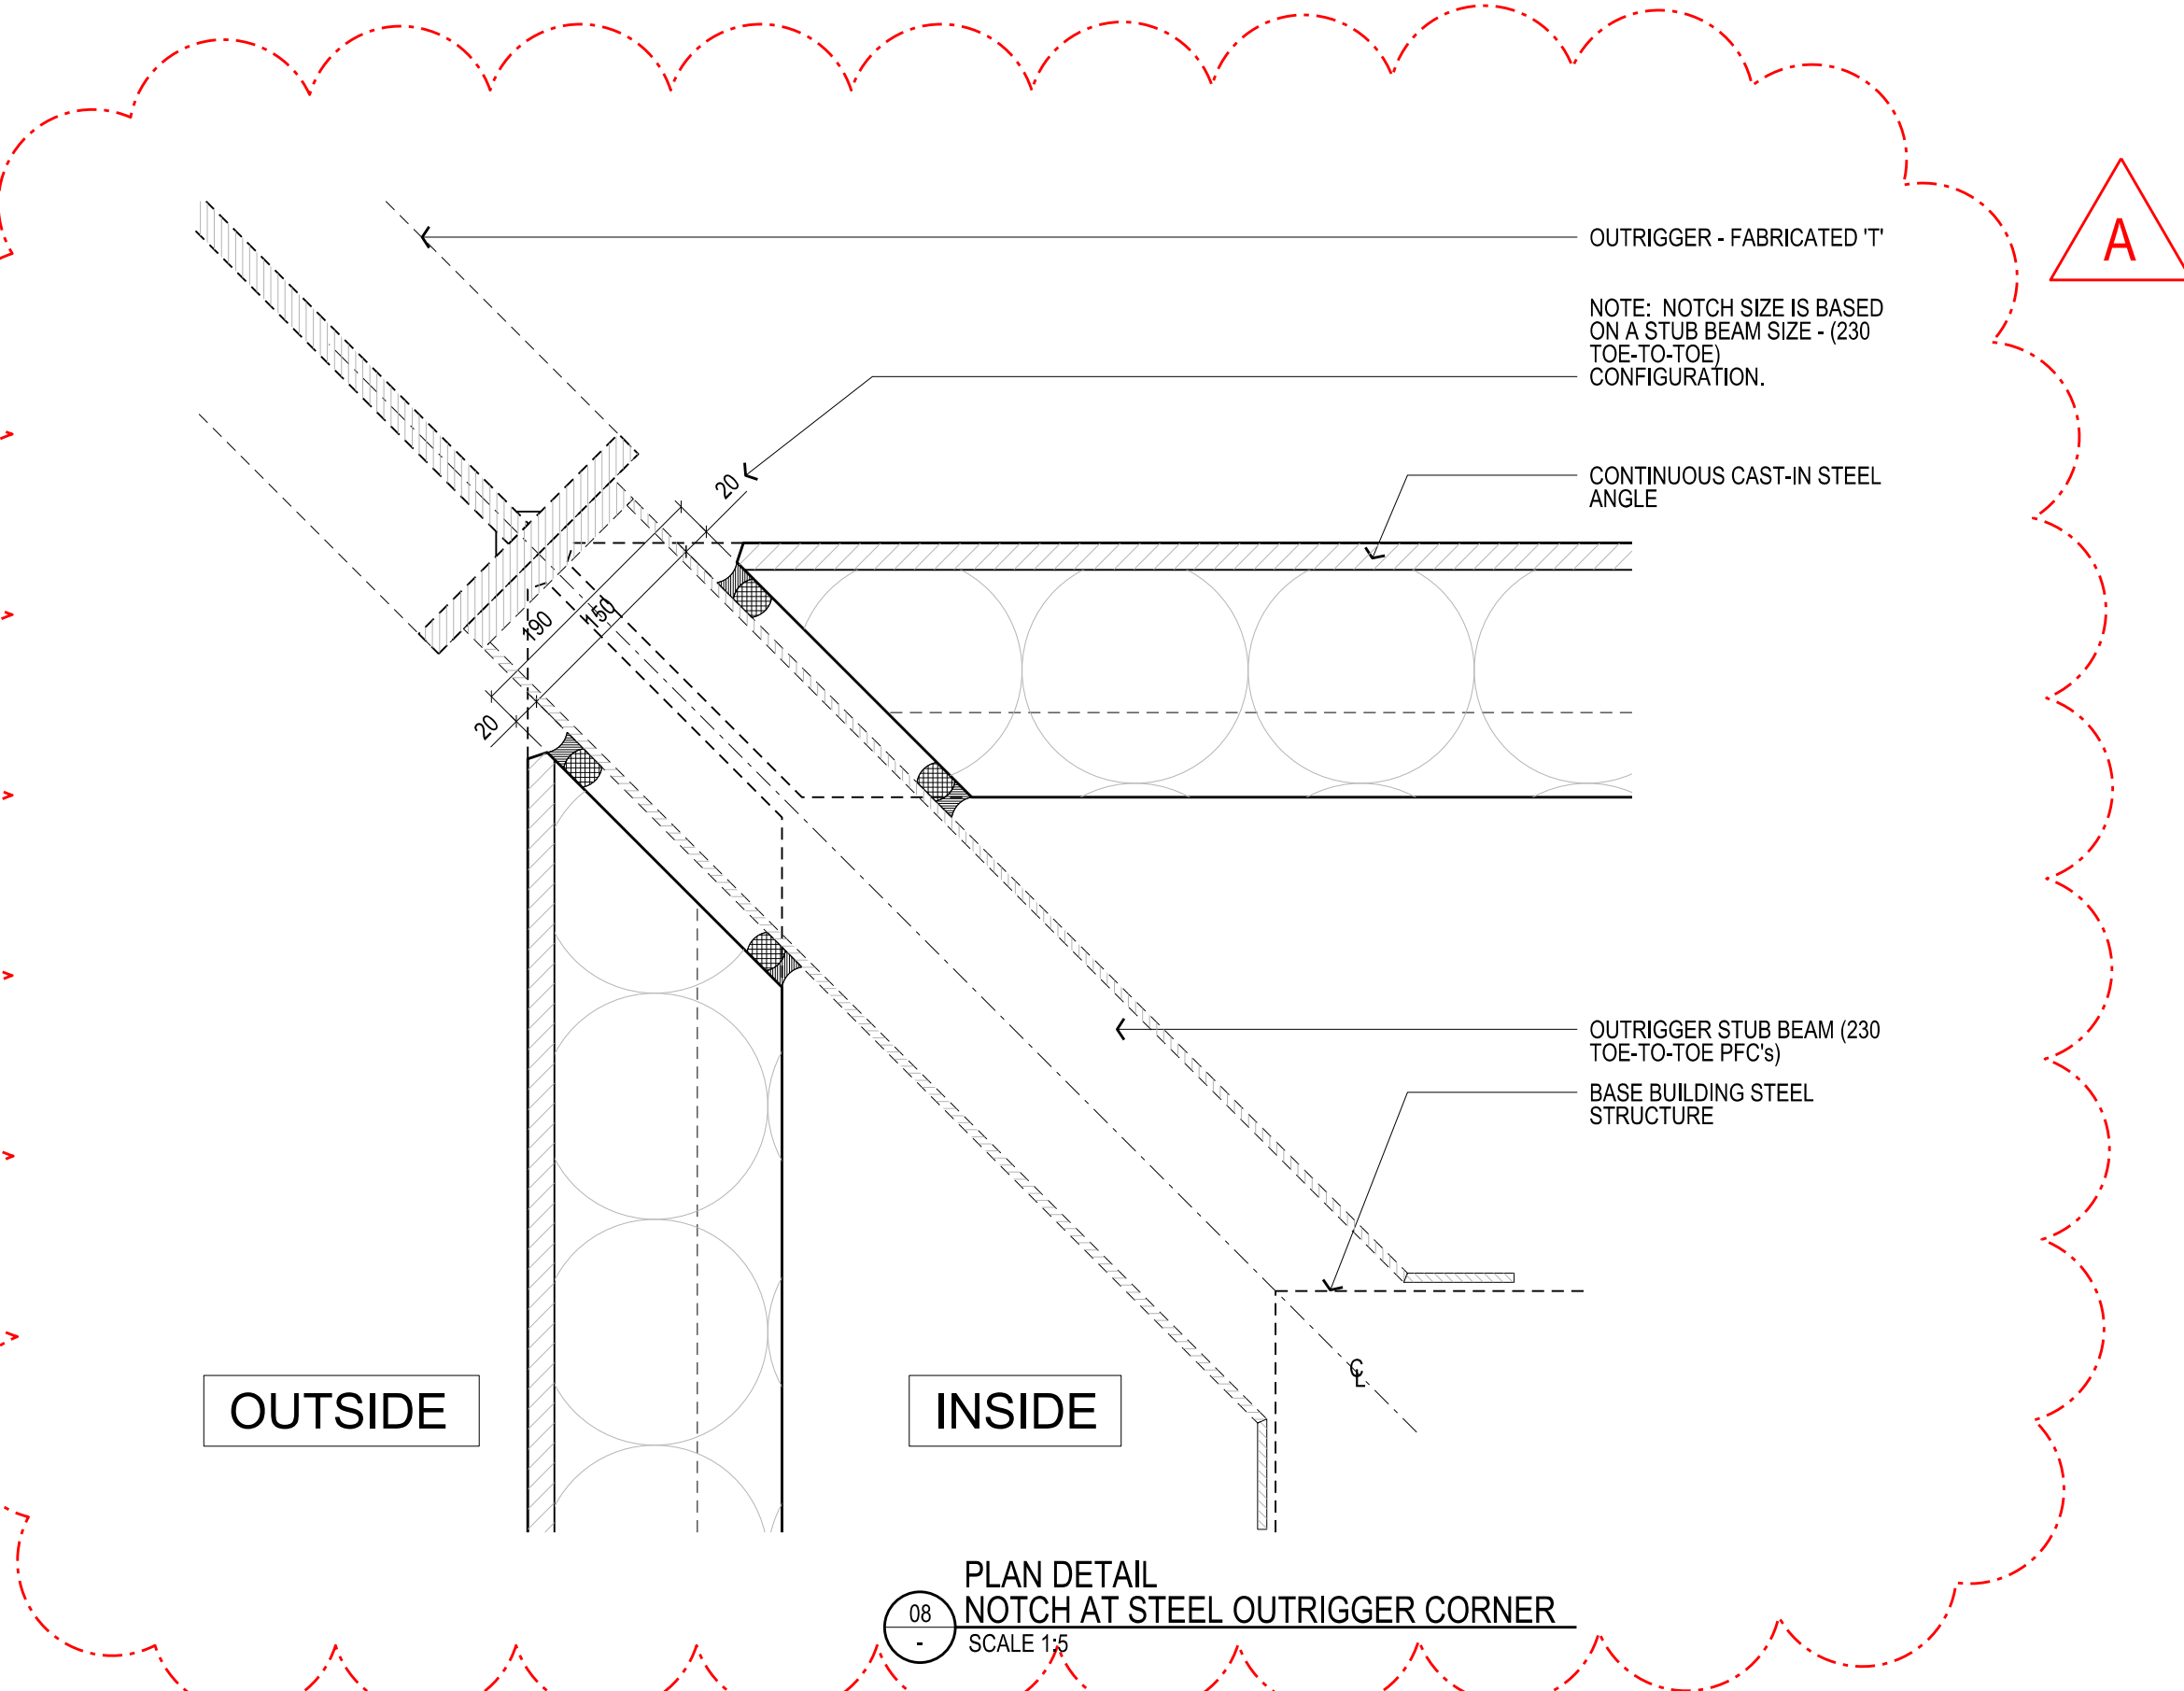

PLAN DETAIL  
09 NOTCH AT STEEL OUTRIGGER CORNER  
SCALE 1:5

Rev	Issue	Revision Description	Amd	Date
A	SG	PRECAST NOTCH ADDED TO SUIT STR.	-	11.09.13
05	SG	TENDER ISSUE	-	16.04.13
04	SG	VALUE MANAGEMENT ISSUE	-	28.03.13
03	SG	PRECAST REVIEW	-	21.03.13
02	SG	TENDER ADDENDUM 3	-	02.10.12
01	SG	100% CO - TENDER ISSUE	-	07.09.12



**NADAAA**  
 NADAAA  
 1320 Washington Street No.2 Boston Massachusetts 02118 USA  
 Telephone +1 617 442 8232 Facsimile +1 888 442 1417 Email nadaaa@nadaaa.com

**John Wardle Architects**  
 25 Rokeby Street, Collingwood, Victoria 3066 Australia  
 Tel: +61 3 8662 0400 www.johnwardlearchitects.com  
 © 2012 John Wardle Architects ABN 83 006 814 268

Client **University of Melbourne Parkville Campus**  
 Project **Faculty of Architecture Building and Planning**

Title **TYPICAL PRECAST DETAILS SHEET 4**

Project No.	<b>0913</b>	Scale	1:5 @ A0 1:10 @ A2
Drawing No.	<b>AR 6303</b>	Revision	<b>A</b>

Date Sep 2012 Dwn - Co-Ord - Chk -

FILENAME - \$FILES  
**FOR CONSTRUCTION**