


CONTRACTORS SHALL VERIFY JOB DIMENSIONS BEFORE ANY JOB COMMENCES. ALL SHOP DRAWINGS SHALL BE SUBMITTED TO THE SUPERINTENDENT AND MANUFACTURE SHALL NOT COMMENCE PRIOR TO THE RETURN OF DIMENSIONS. SHOP DRAWINGS ISSUED BY THE CONSULTANT FIGURED DIMENSIONS SHALL TAKE PRECEDENCE OVER SCALED. THIS DRAWING SHALL BE READ IN CONJUNCTION WITH ALL RELEVANT CONTRACT SPECIFICATIONS AND DRAWINGS COPYRIGHT OF THIS DRAWING IS VESTED IN WARDLE


General Notes & Legend

- PRECAST PANEL NOTES:**
- REFER TO PRECAST SETOUT PLANS, AR1513 FOR LEVEL 1 GENERAL ARRANGEMENT AND SETOUT.
 - EDGE PROFILES, CHAMFERS, FALLS, NOT SHOWN FOR CLARITY. REFER TO FACADE SECTION DETAILS AND PRECAST EDGE PROFILE DETAILS, AR6100 AND AR6300 SERIES.
 - REFER TO FACADE ELEVATIONS, 3000 SERIES, FOR PANEL FINISHES.
 - REFER TO AR5030 & 5031 FOR DETAILS AROUND THE EAST TERRACE PLATS AND PRECAST.

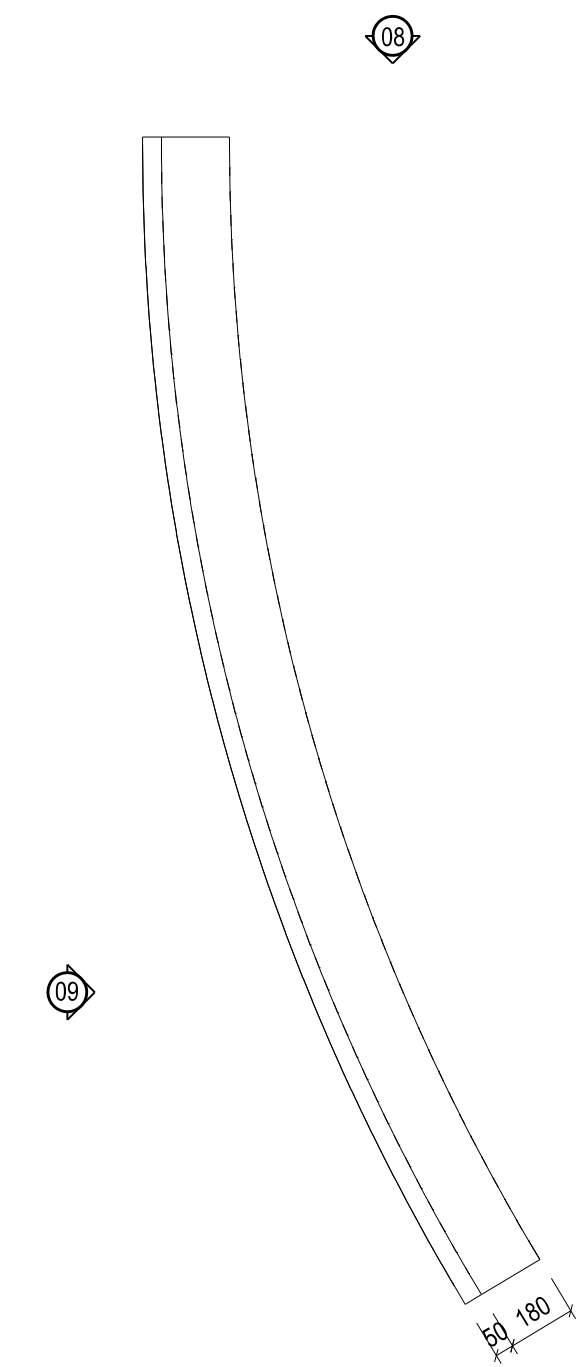


07 PRECAST PANEL 10 - PLAN
SCALE 1:20

NOTE: PANEL TO BE PLACED AS PART OF THE INSITU CONCRETE STRUCTURE ON-SITE - REFER TO STRUCTURAL DRAWINGS FOR DETAILS

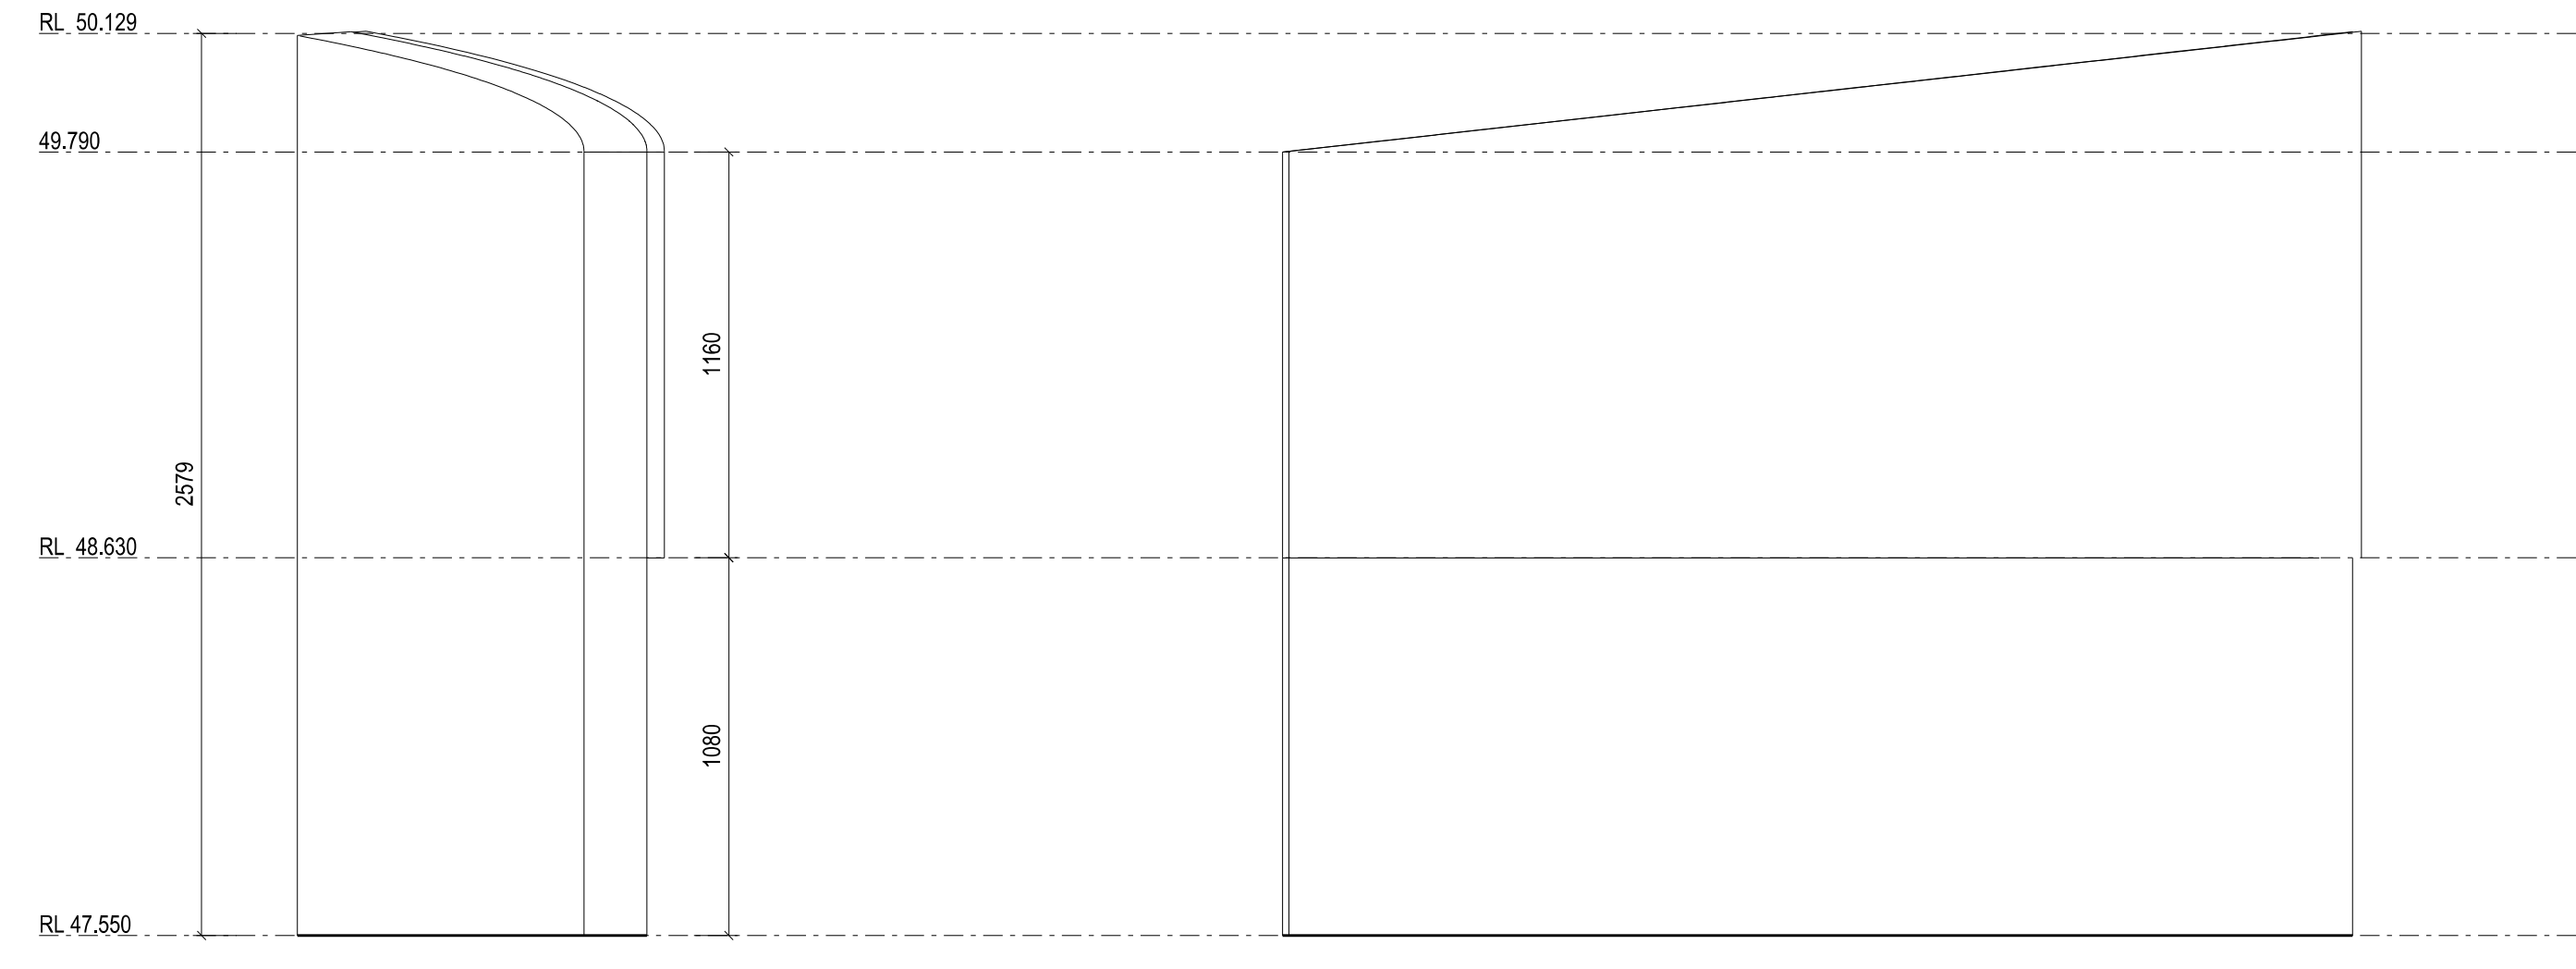


08 PRECAST PANEL 10 - ELEV
SCALE 1:20

09 PRECAST PANEL 10 - ELEV
SCALE 1:20

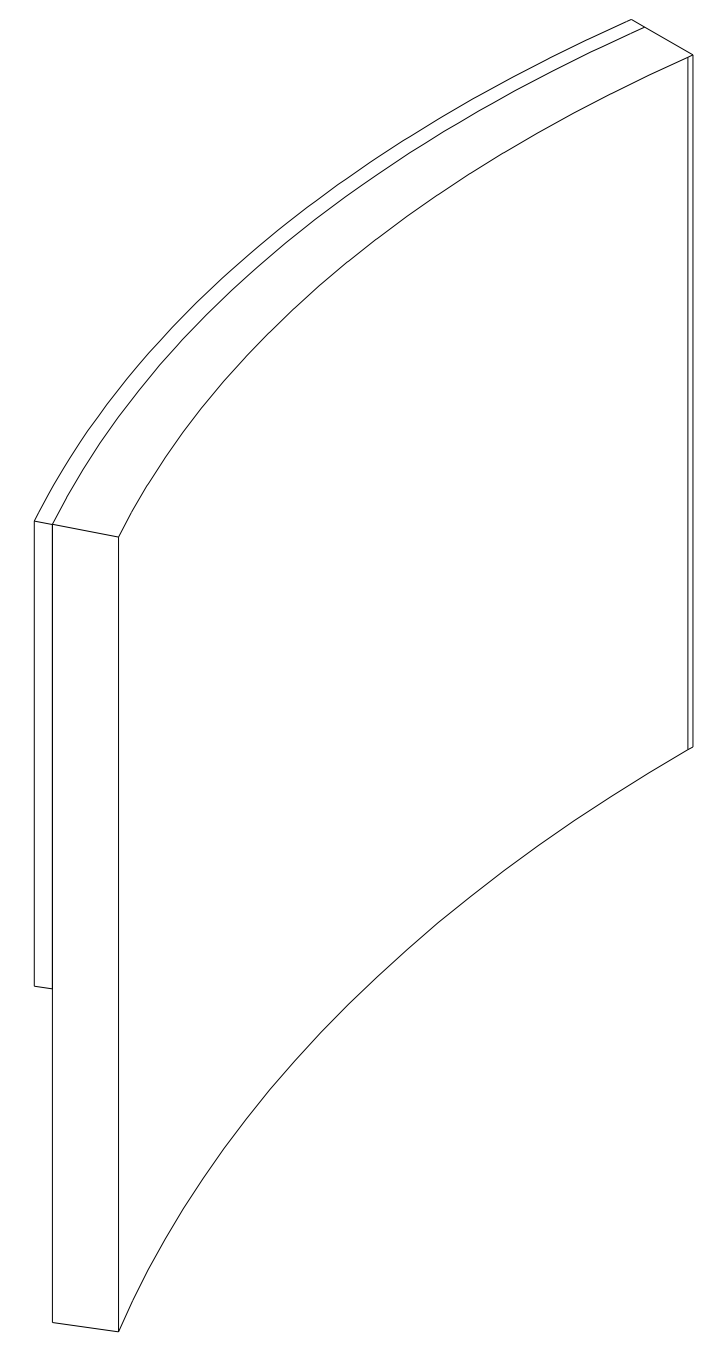


10 PRECAST PANEL 10 - ISO
SCALE 1:20

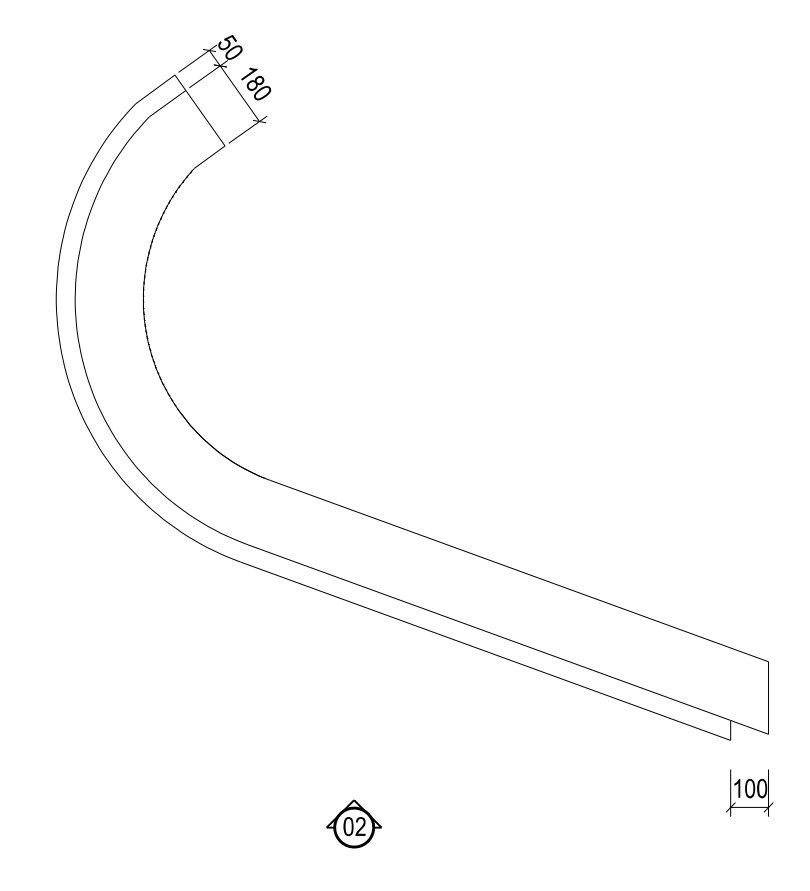


01 PRECAST PANEL 11 - PLAN
SCALE 1:20

NOTE: PANEL TO BE PLACED AS PART OF THE INSITU CONCRETE STRUCTURE ON-SITE - REFER TO STRUCTURAL DRAWINGS FOR DETAILS

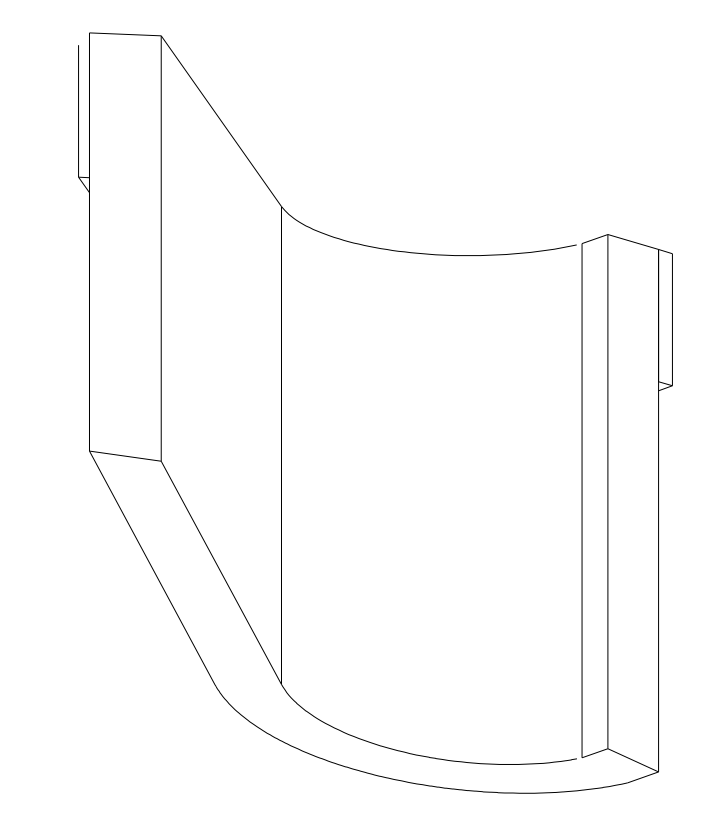


04 PRECAST PANEL 11 - ISO
SCALE 1:20

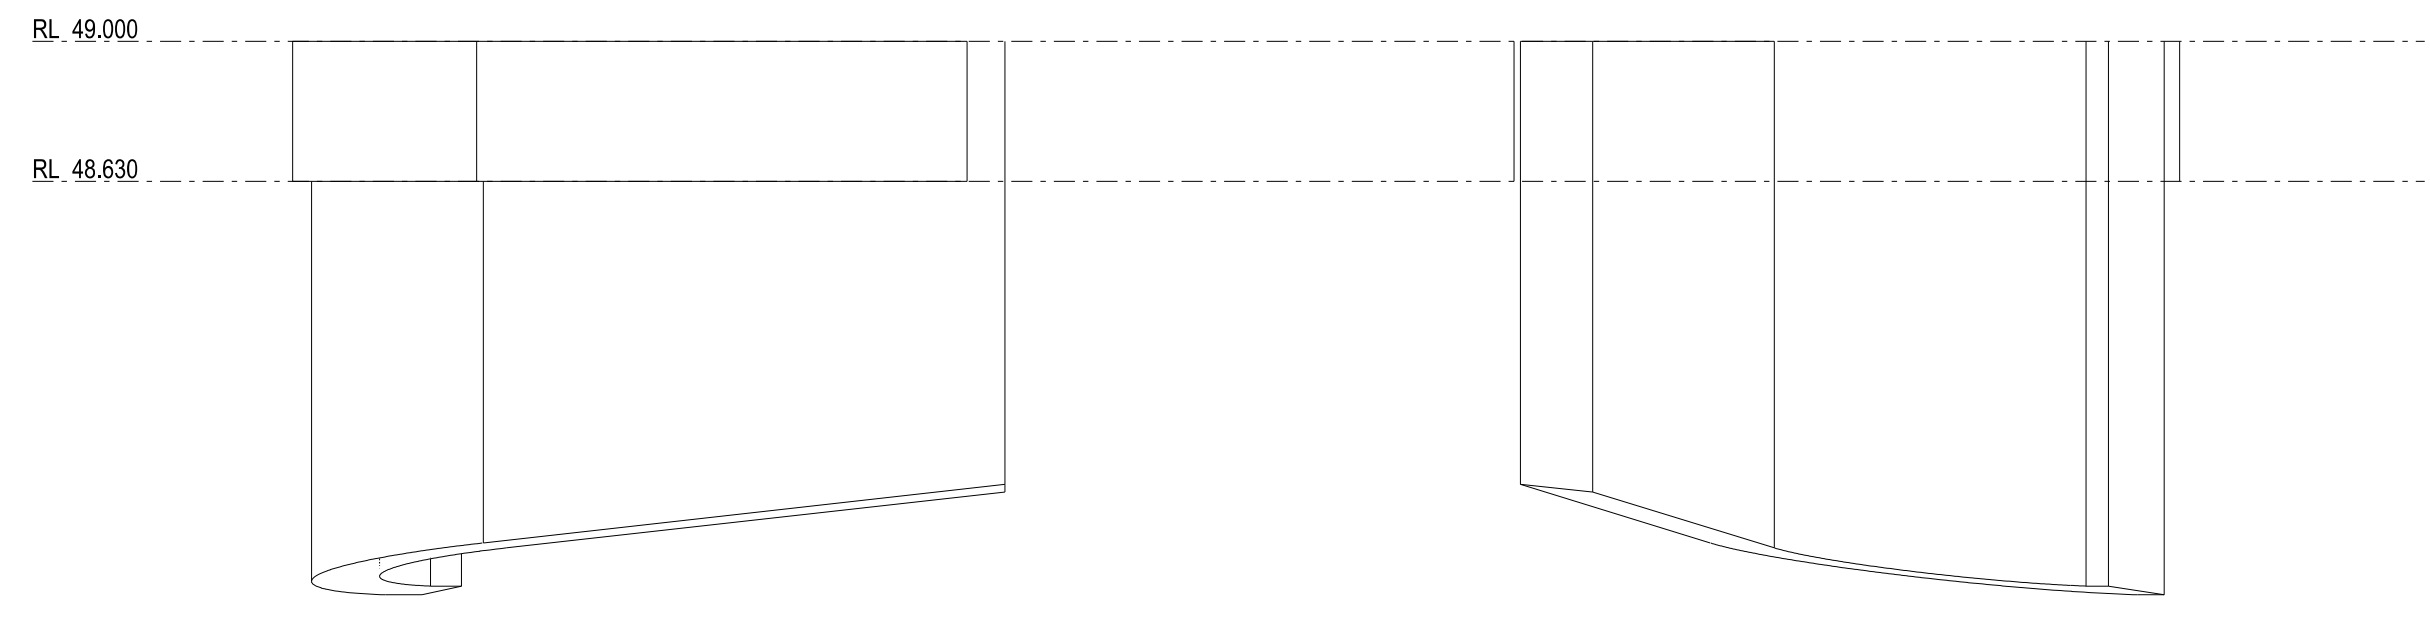


02 PRECAST PANEL 11 - ELEV
SCALE 1:20


03 PRECAST PANEL 11 - ELEV
SCALE 1:20

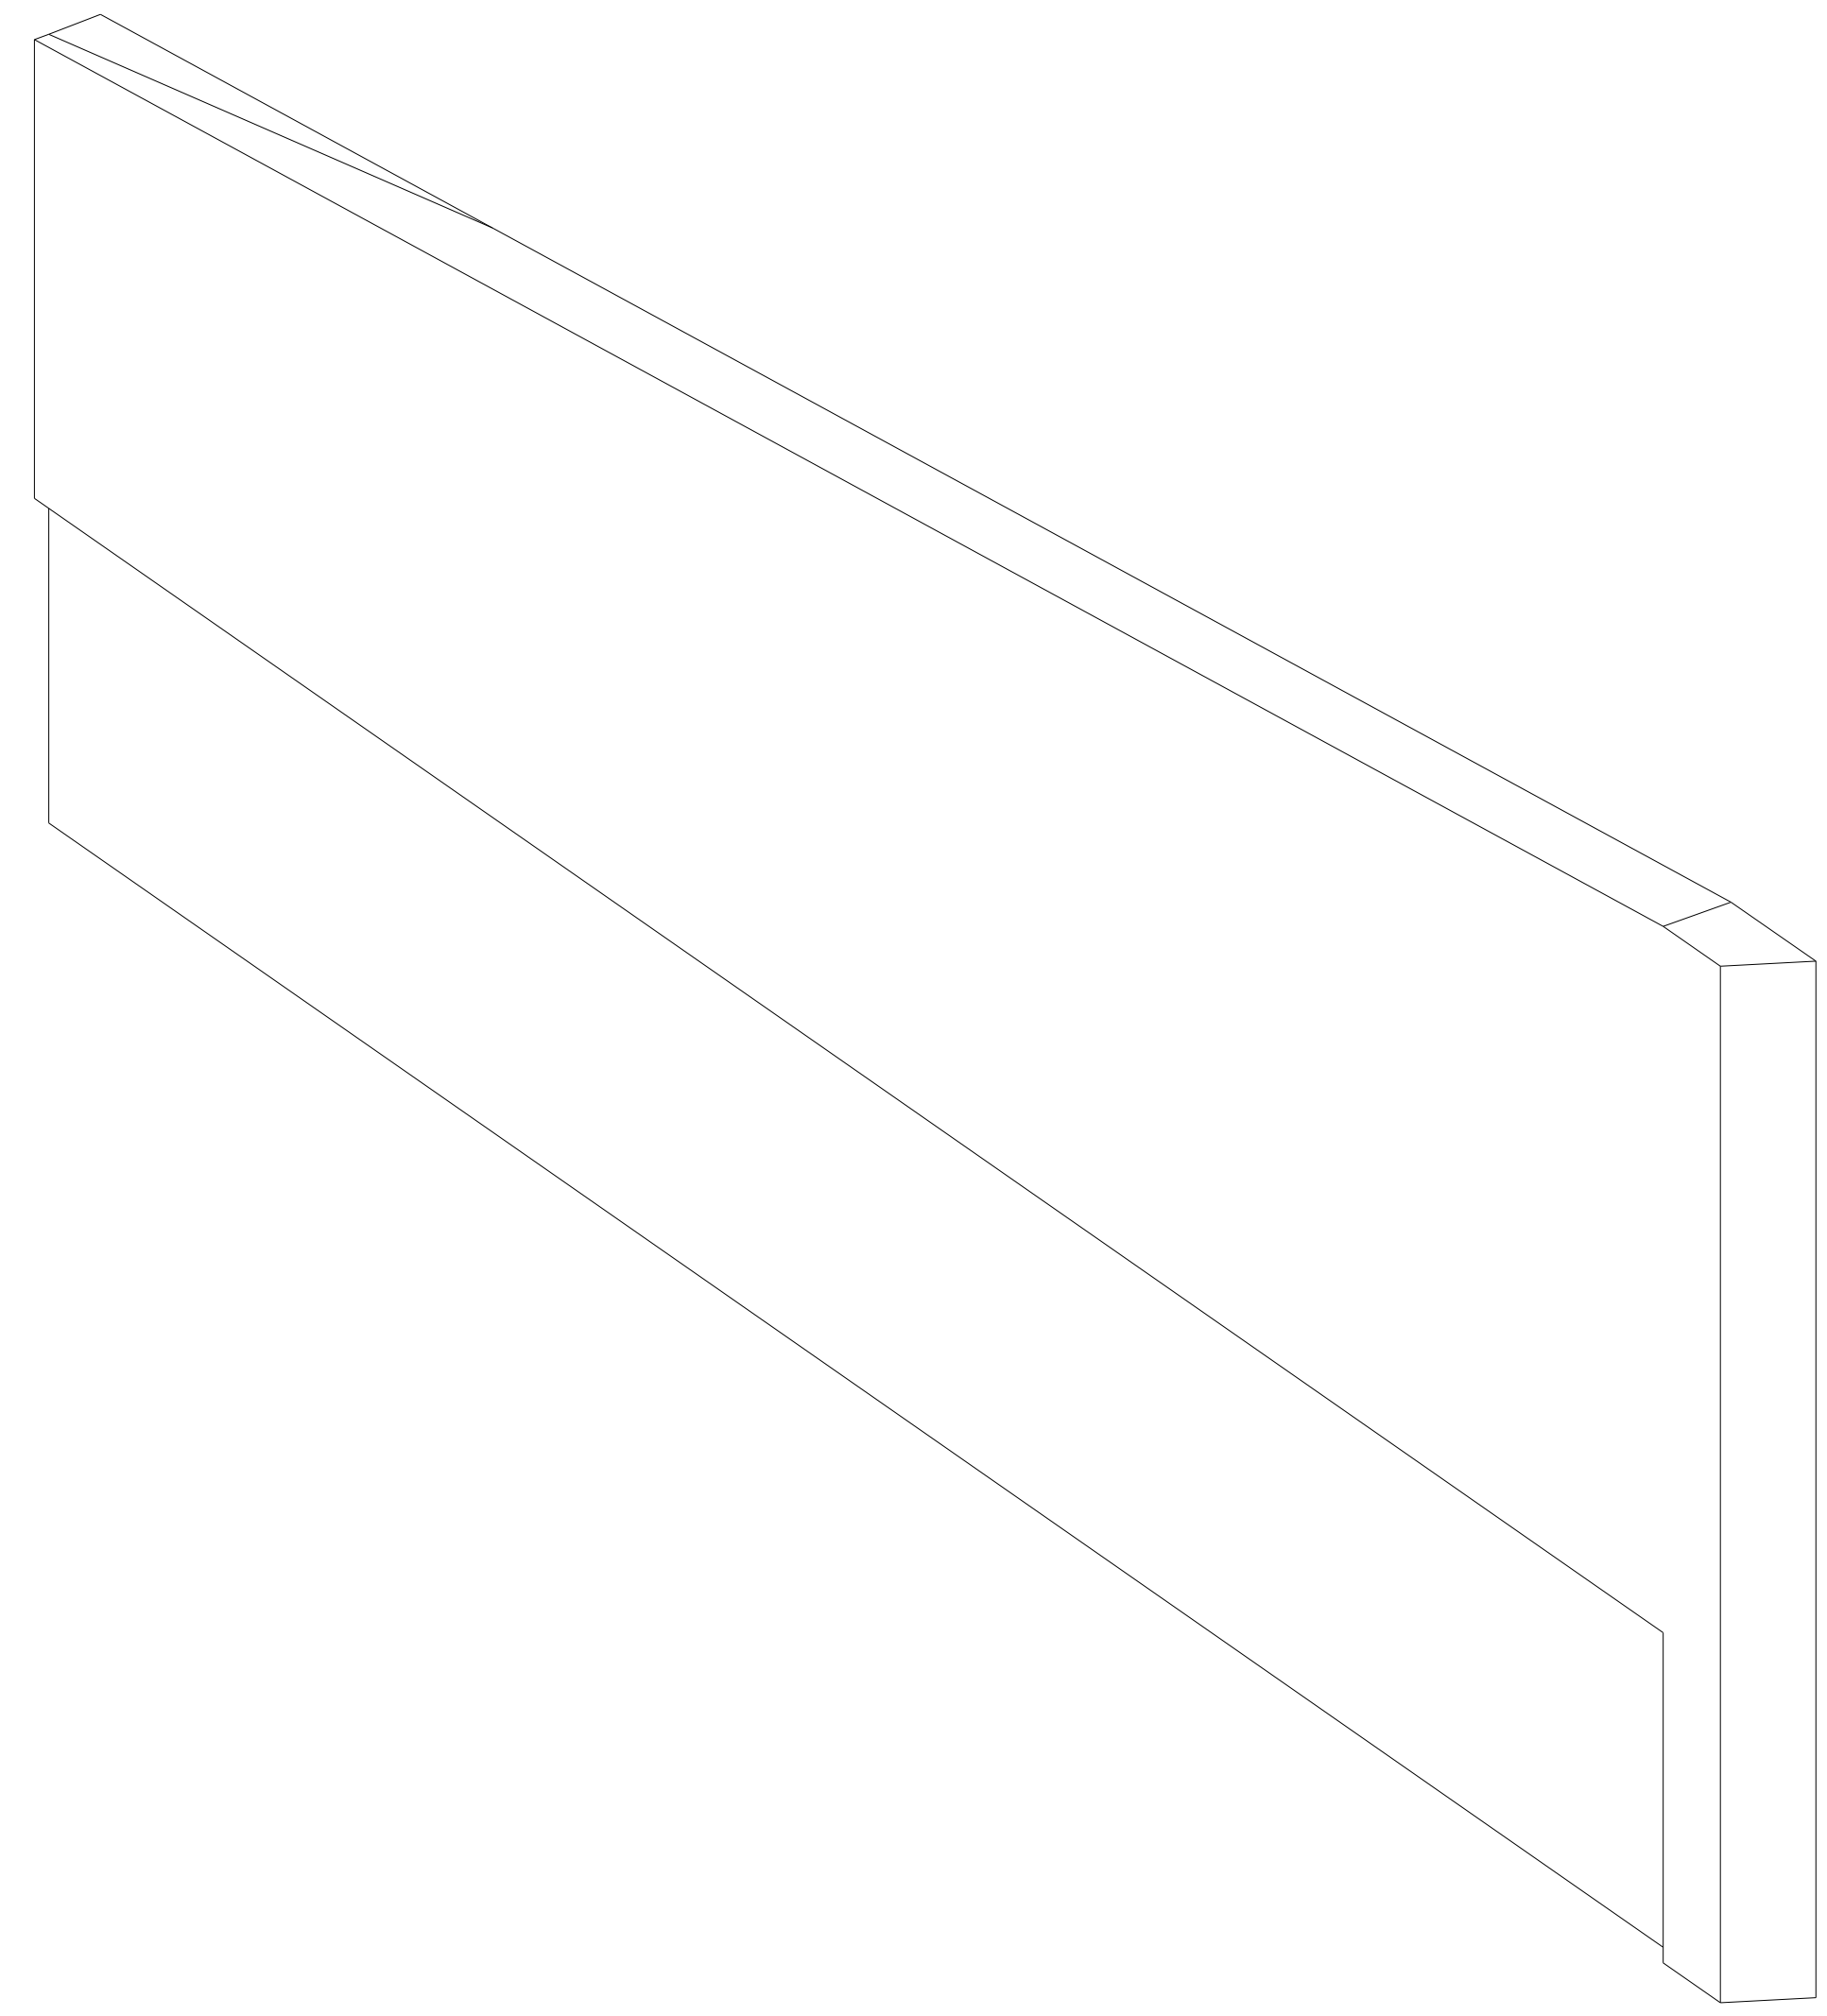

17 PRECAST PANEL 12 - ISO
SCALE 1:20

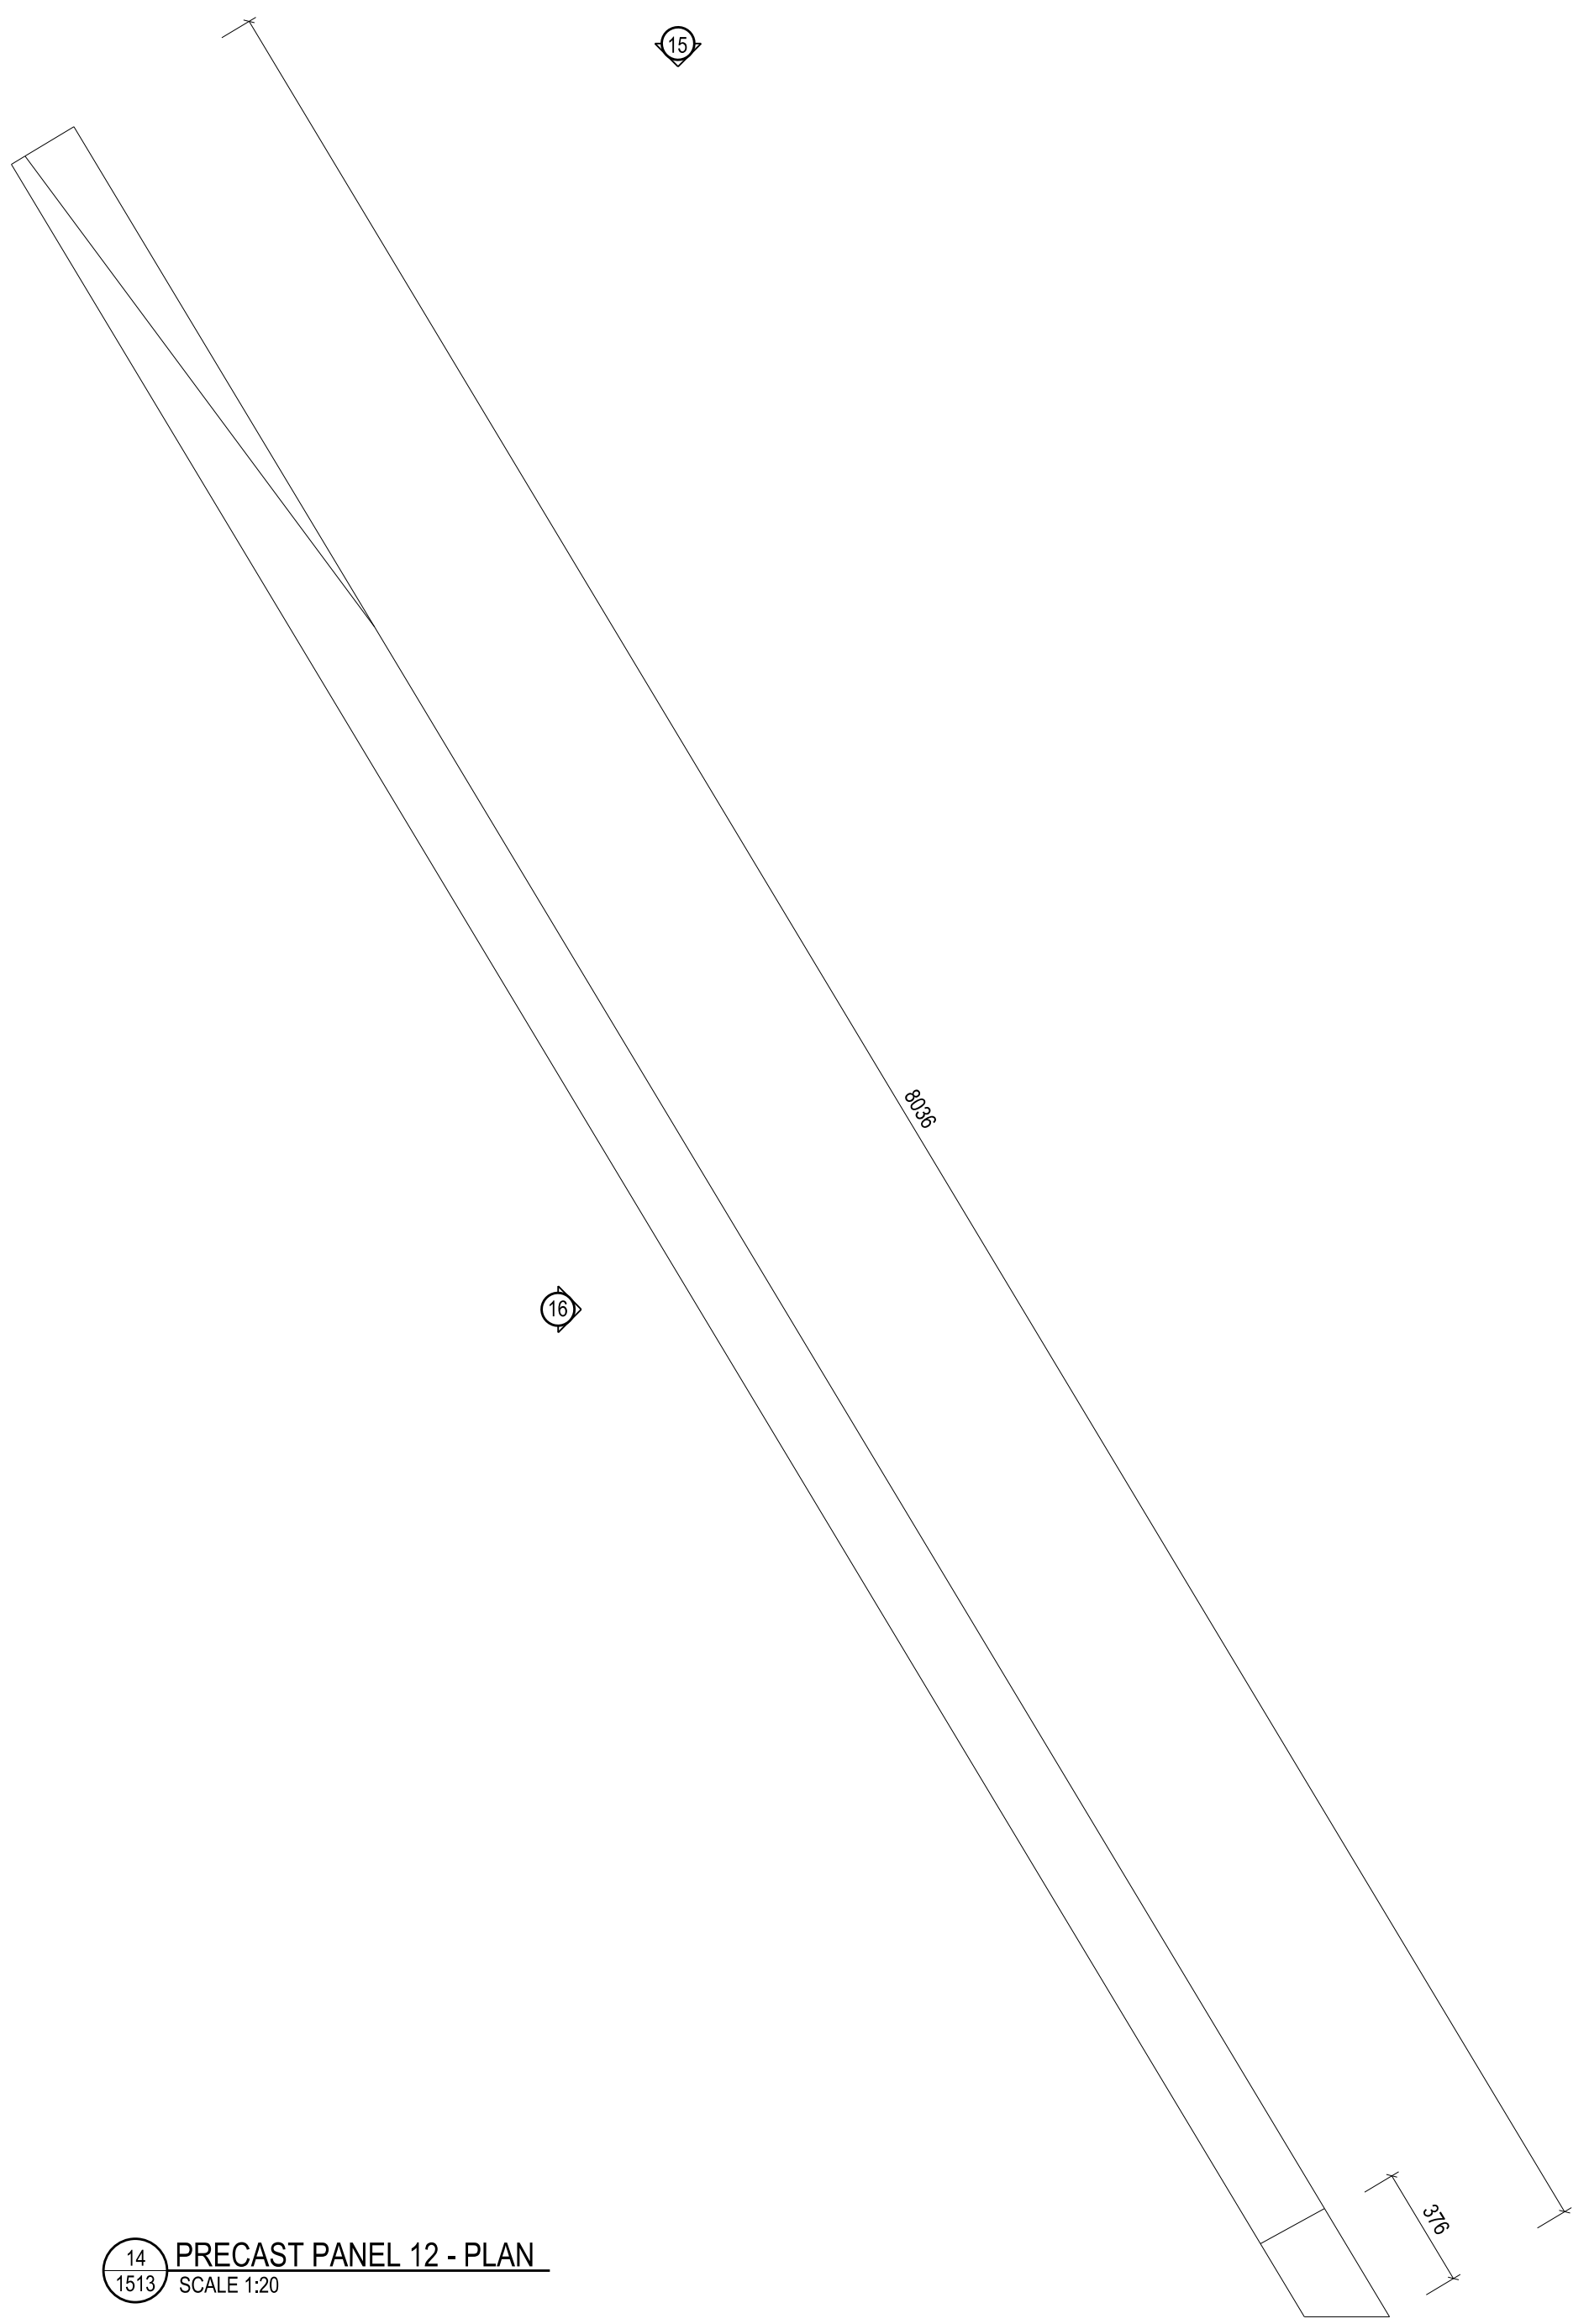

14 PRECAST PANEL 12 - PLAN
SCALE 1:20

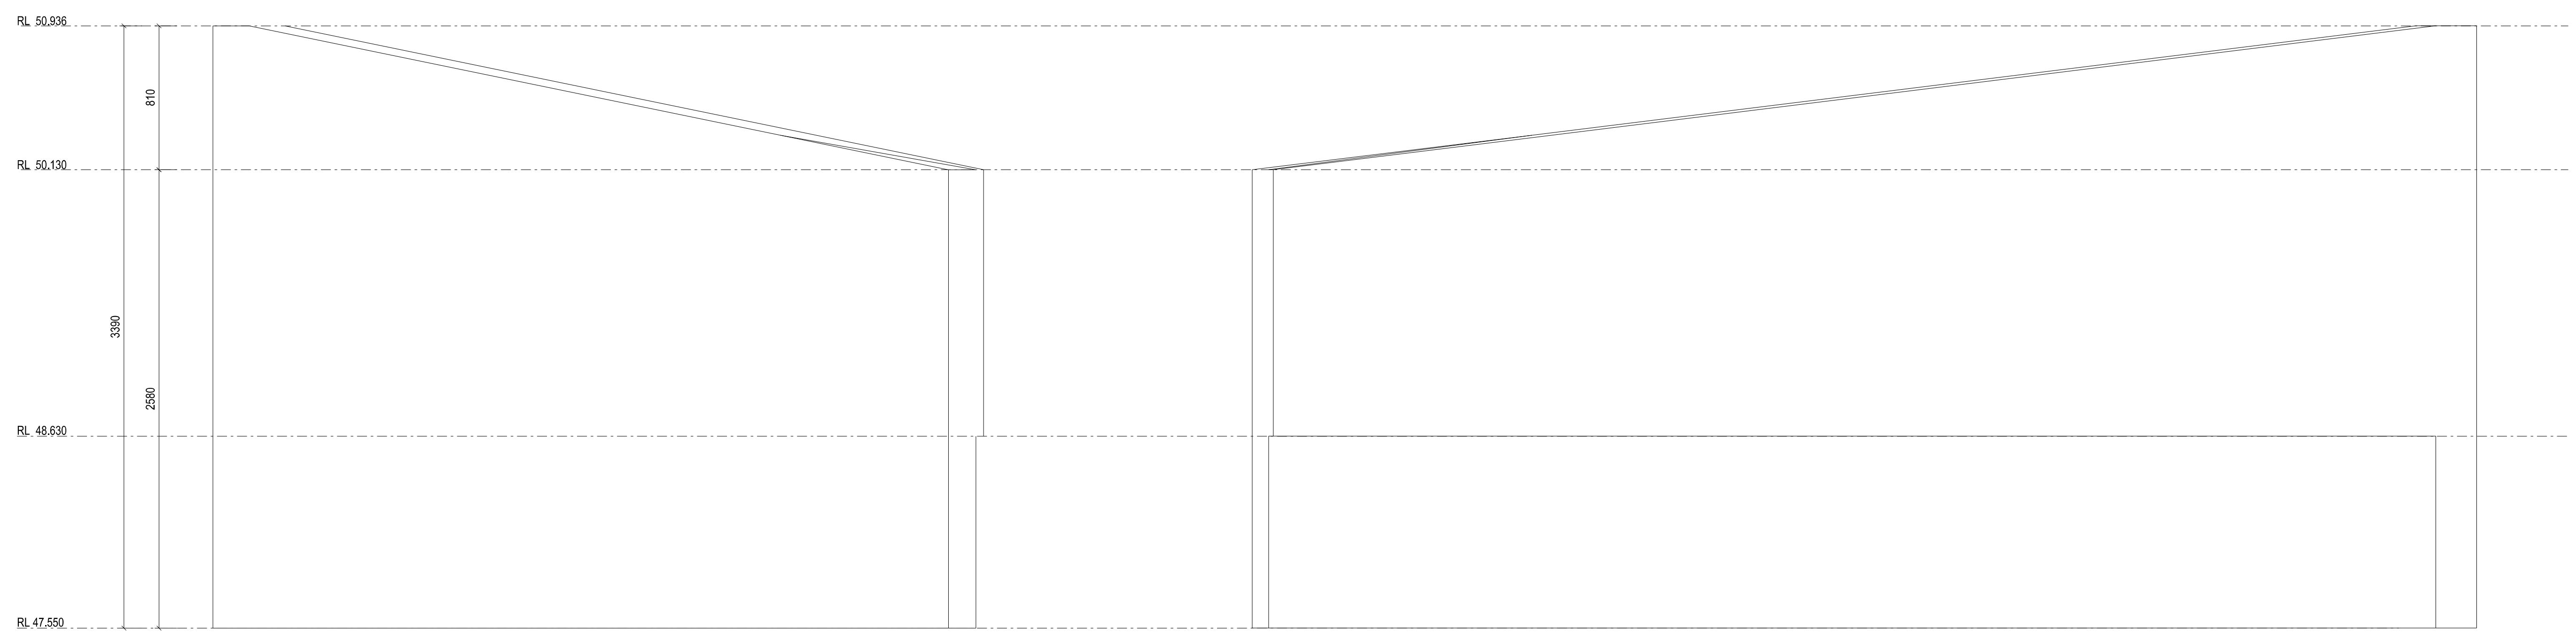

15 PRECAST PANEL 12 - ELEV
SCALE 1:20

16 PRECAST PANEL 12 - ELEV
SCALE 1:20

Rev	Issue	Revision Description	Amd	Date
A	SG	PRELIMINARY ISSUE	-	24.07.13



NADAAA
 NADAAA
 1520 Washington Street No.2 Boston Massachusetts 02118 USA
 Telephone +1 617 442 8232 Facsimile +1 688 442 1417 Email nadaaa@nadaaa.com

John Wardle Architects
 25 Rokeby Street, Collingwood, Victoria 3066 Australia
 Tel: +61 3 8662 0400 www.johnwardlearchitects.com
 © 2012 John Wardle Architects ABN 83 006 814 268

Client **University of Melbourne Parkville Campus**

Project **Faculty of Architecture Building and Planning**

Title **PRECAST PANEL SETOUT LEVEL 1 - SHEET 4**

Project No.	0913	Scale	1:20 @ A0 1:40 @ A2
Drawing No.	AR 6308	Revision	A

Date Jul 2013 Drawn Co-Ord Check

FILENAME - SFRS

FOR CONSTRUCTION