
1 PERFORATION PATTERN NO.1 - SCALE 1:10 NORTH (FLAT)	2 PERFORATION PATTERN NO.2 3 SCALE 1:10 NORTH (ANGLE) ALTERNATING DESIGNS A AND B	3 PERFORATION PATTERS - SCALE 1:10 NORTH (ANGLE) ALTERNATING DES B

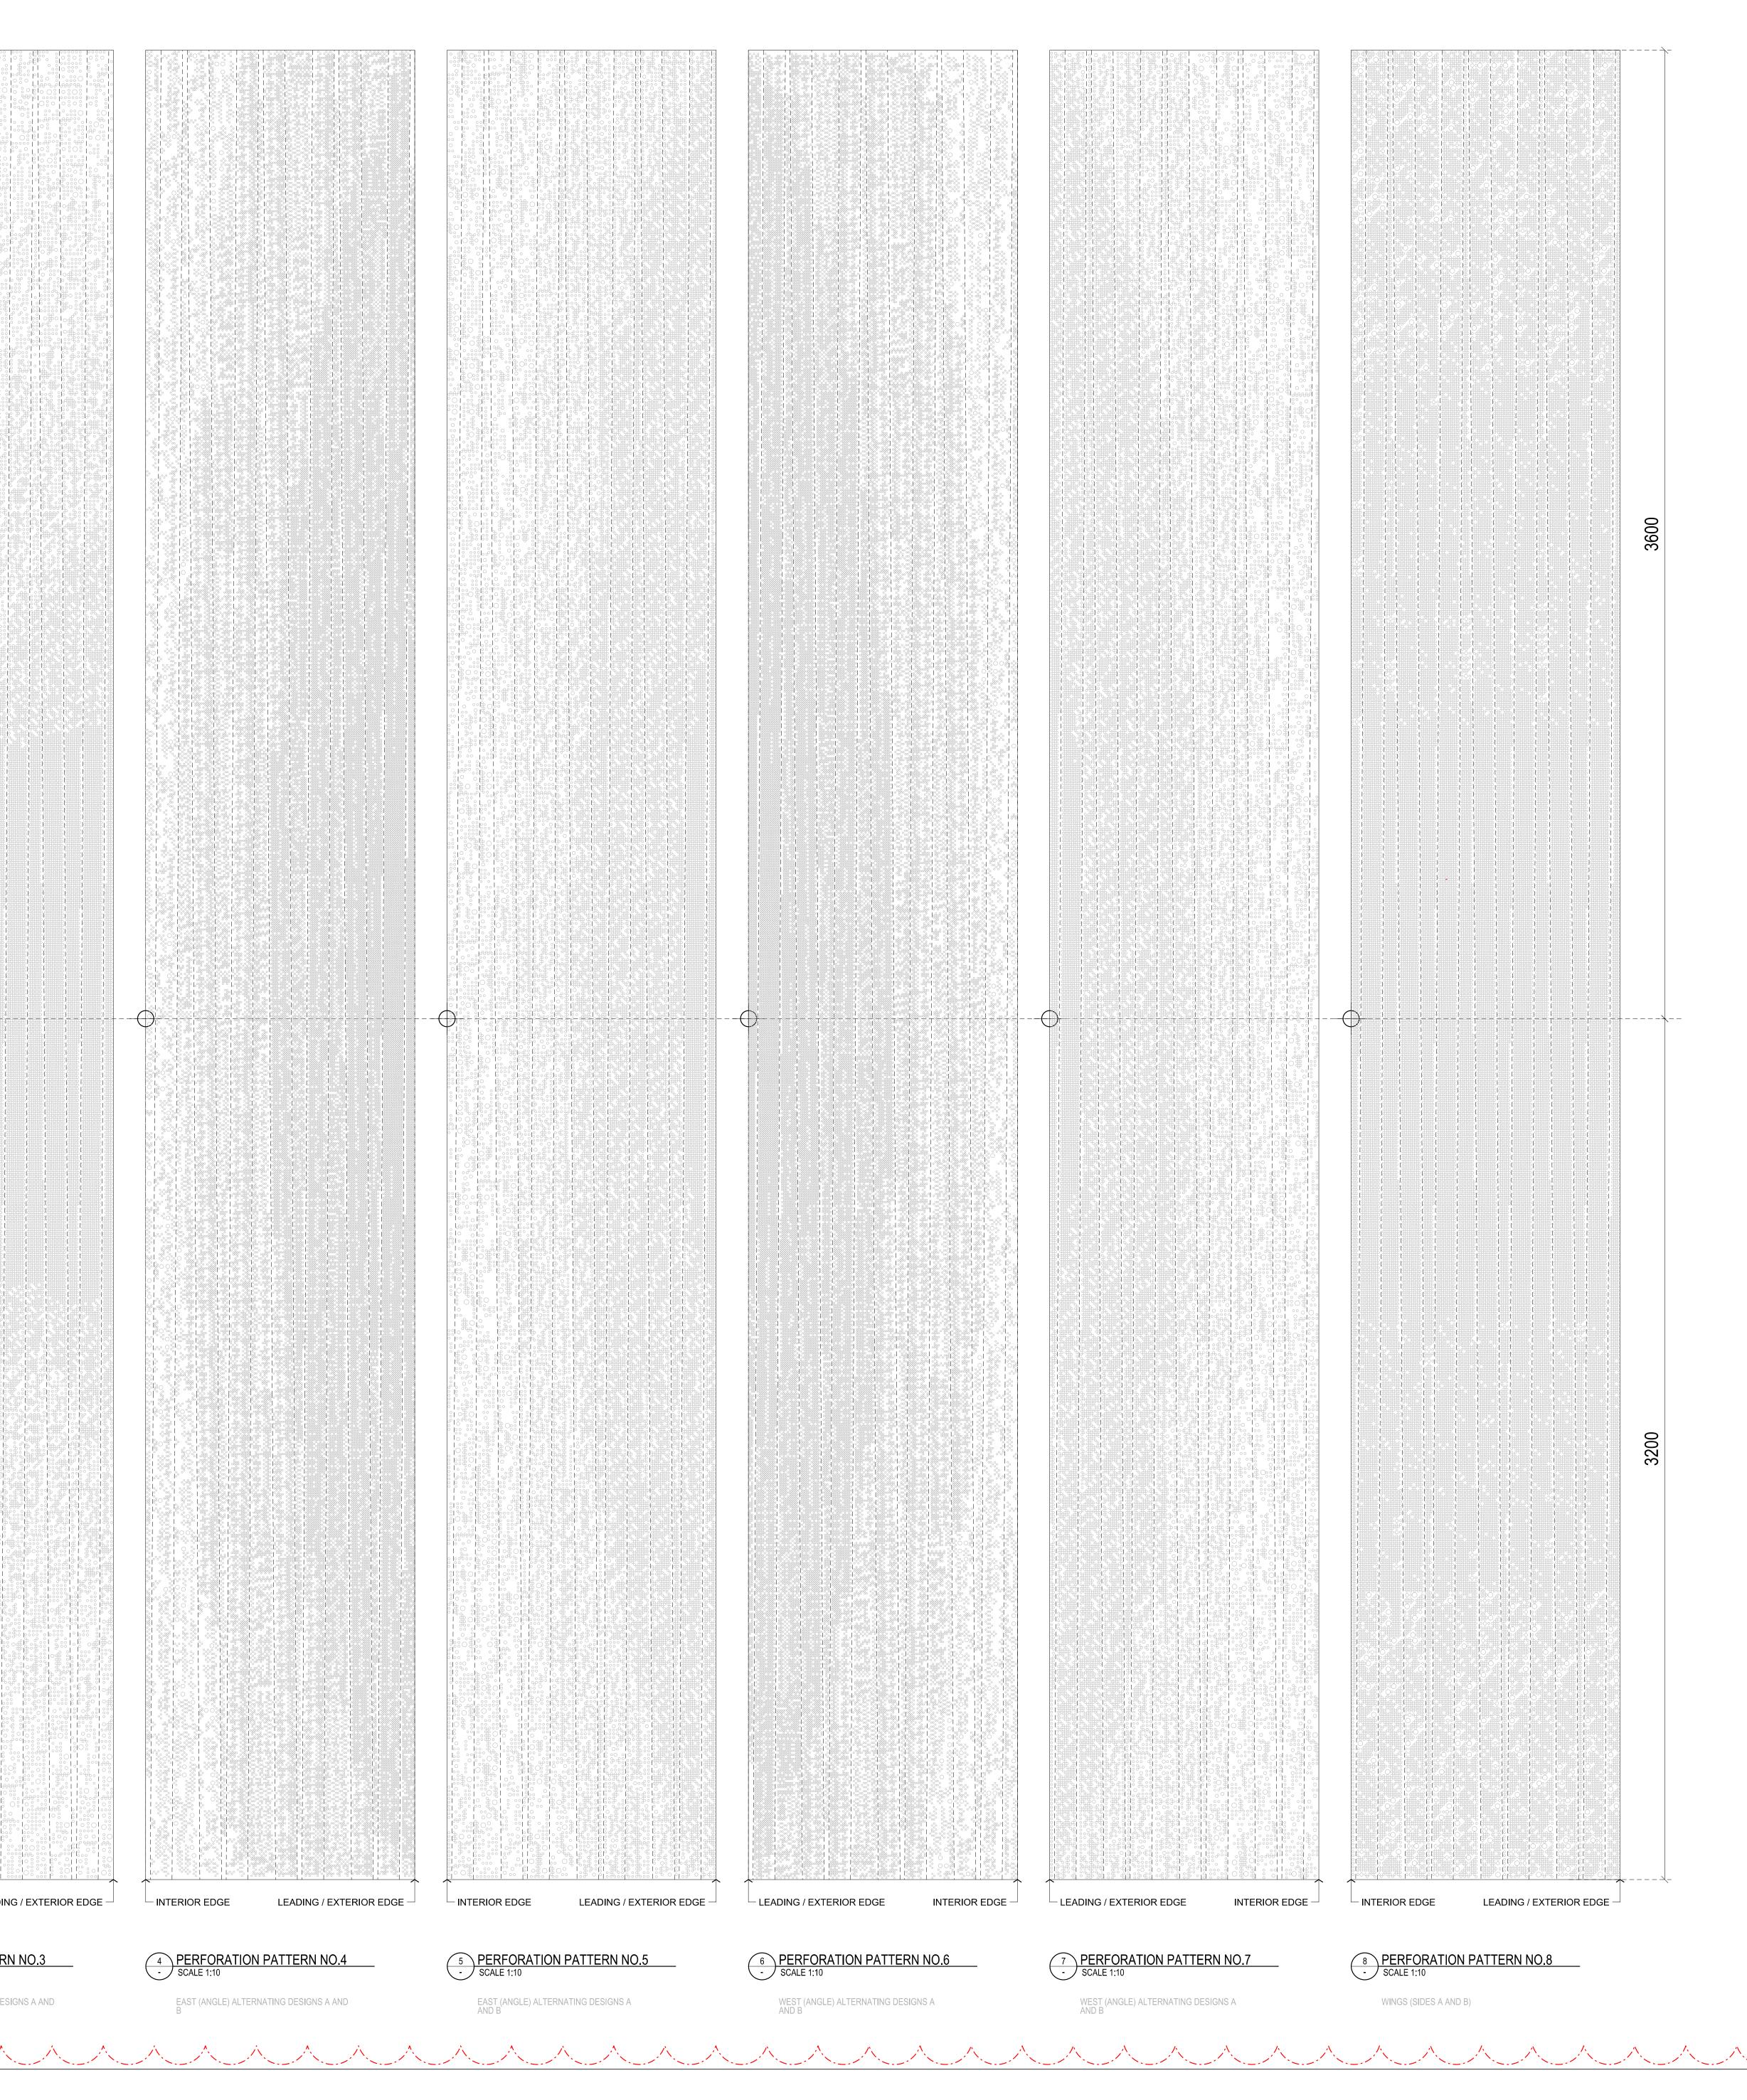

						THIS DRAWING IS AN UNCONTROLLED COPY UNLESS STAMPED OTHERWISE CONTRACTORS SHALL VERIFY JOB DIMENSIONS BEFORE ANY JOB COMMENCES. ALL SHOP DRAWINGS SHALL BE SUBMITTED TO THE SUPERINTENDENT AND MANUFACTURE SHALL NOT COMMENCE PRIOR TO THE RETURN OF UNAMENDED SHOP DRAWINGS SIGNED BY THE CONSULTANT. FIGURED DIMENSIONS SHALL TAKE PRECEDENCE OVER SCALED. THIS DRAWING SHOULD BE READ IN CONJUNCTION WITH ALL RELEVANT CONTRACT, SPECIFICATIONS AND DRAWINGS COPYRIGHT OF THIS DRAWING IS VESTED IN WARDLE
						C SG PERFORATION PATTERNS REVISED 19:12:13 B SG PERFORATION PATTERNS REVISED 19:12:13 B SG PERFORATION PATTERNS REVISED 18:11.13 A SG SSUE FOR CONSTRUCTION 31:10.13 Q2 SG VALUE MANACEMENT ISSUE 28:06.313 Q1 SO 10% CD-TENDER ISSUE 07:09:12 Rev Issue Revision Description And Date Image: Construction of the state in the st
RN NO.3	PERFORATION PATTERN NO.4 SCALE 1:10 EAST (ANGLE) ALTERNATING DESIGNS A AND B	5 PERFORATION PATTERN NO.5 - SCALE 1:10 EAST (ANGLE) ALTERNATING DESIGNS A AND B	6 PERFORATION PATTERN NO.6 - SCALE 1:10 WEST (ANGLE) ALTERNATING DESIGNS A AND B	7 PERFORATION PATTERN NO.7 • SCALE 1:10 WEST (ANGLE) ALTERNATING DESIGNS A AND B	8 PERFORATION PATTERN NO.8 - SCALE 1:10 WINGS (SIDES A AND B)	Project No. 0913 1:10 @ A0 1:20 @ A2 Drawing No. AR6551 Revision Date Dec 2011 Drwn Co-Ord Chck FILENAME - \$FILE\$ FOR CONSTRUCTION