


CONTRACTORS SHALL VERIFY JOB DIMENSIONS BEFORE ANY JOB COMMENCES. ALL SHOP DRAWINGS SHALL BE SUBMITTED TO THE SUPERINTENDENT AND MANUFACTURE SHALL NOT COMMENCE PRIOR TO THE REVIEW OF DIMENSIONS. DIMENSIONS SHOWN BY THE CONSULTANT FORMER DIMENSIONS SHALL TAKE PRECEDENCE OVER SCALE. THE DRAWING SHOULD BE READ IN CONJUNCTION WITH ALL RELEVANT CONTRACT SPECIFICATIONS AND DRAWINGS COPYRIGHT OF THIS DRAWING BY VESTED IN WORLD.

General Notes & Legend


REFER ARCHITECTURAL DRAWINGS:

- FACADE SETOUT AR1502AR1507
- PRECAST SETOUT AR1512AR1517
- SCREEN SETOUT AR1552AR1557
- SCREEN DETAILS AR8550AR8554

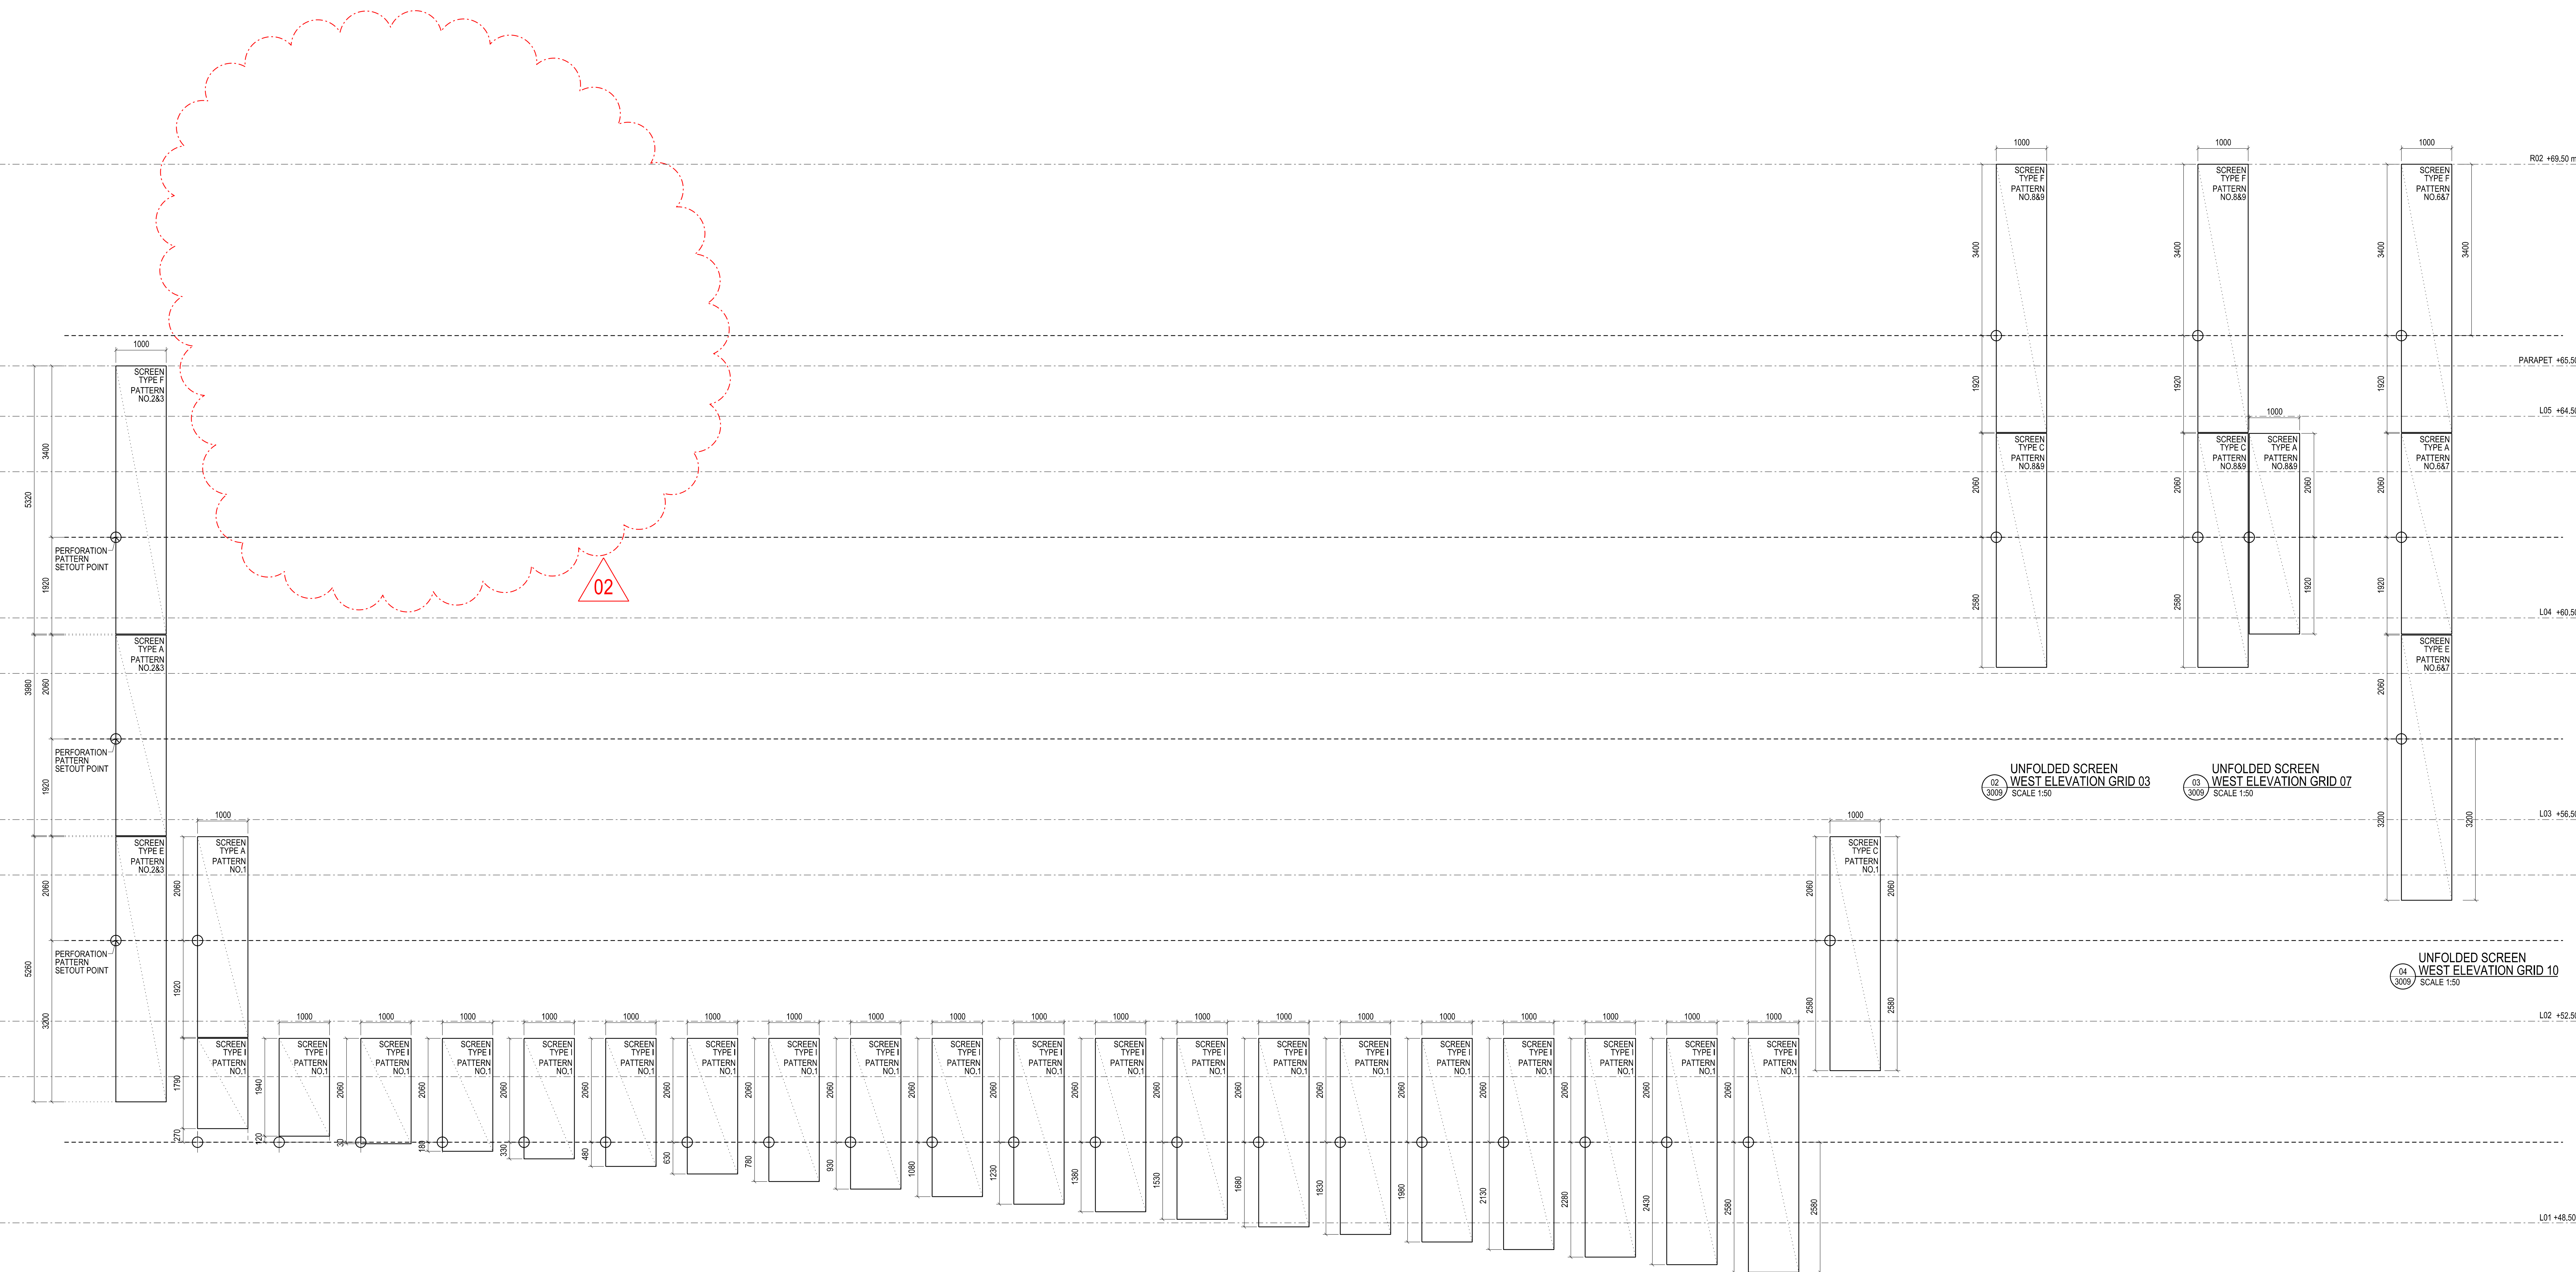

07 UNFOLDED SCREEN - NORTH ELEVATION  
SCALE 1:50

Rev	Issue	Revision Description	And	Date
02	SG	TENDER ADDENDUM 4	-	08.10.12
01	SG	100% CD - TENDER ISSUE	-	07.09.12

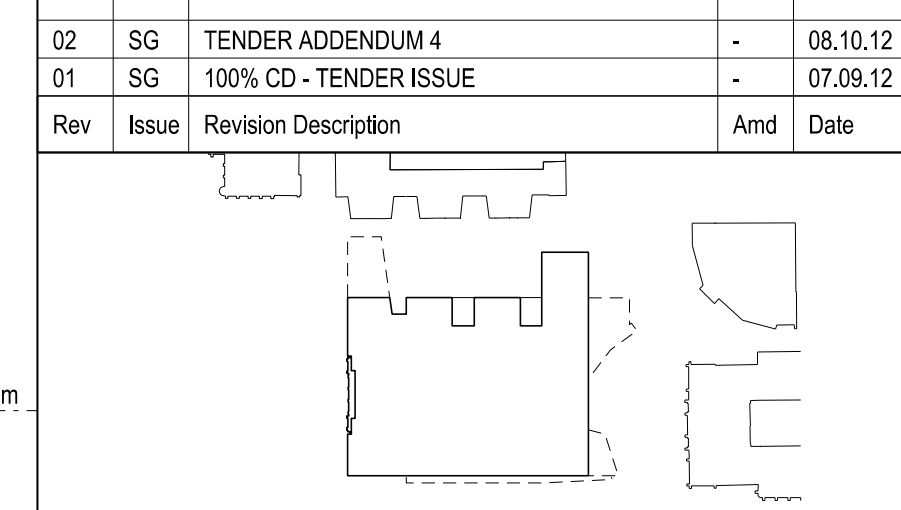

**NADAAA**  
 NADAAA  
 1920 Washington Street No.2  
 Boston  
 Massachusetts  
 02118 USA  
 Telephone +1 617 442 6232  
 Facsimile +1 888 442 1417  
 Email nads@nadaaa.com

**John Wardle Architects**  
 25 Rokaby Street, Collingwood, Victoria 3066 Australia  
 Tel: +61 3 9662 0400 www.johnwardlearchitects.com  
 © 2012 John Wardle Architects ABN 63 006 614 268

Client **University of Melbourne Parkville Campus**

Project **Faculty of Architecture Building and Planning**

Title **SCREEN SETOUT DIAGRAMS**

	Project No.	<b>0913</b>	Scale	1:50 @ A0 1:100 @ A2
	Drawing No.	<b>AR6553</b>	Revision	<b>02</b>

Date: Sept 2011 Drawn: Co-Ord: Chk:

FILENAME - FILES

**TENDER ADDENDUM 4**