


THIS DRAWING IS AN UNCONTROLLED COPY UNLESS STAMPED OTHERWISE

CONTRACTORS SHALL VERIFY JOB DIMENSIONS BEFORE ANY JOB COMMENCES. ALL SHOP DRAWINGS SHALL BE SUBMITTED TO THE SUPERINTENDENT AND MANUFACTURER SHALL NOT COMMENCE PRIOR TO THE RETURN OF APPROVED SHOP DRAWINGS. BY THE CONSULTANT FIGURED DIMENSIONS SHALL TAKE PRECEDENCE OVER SCALED. THIS DRAWING SHOULD BE READ IN CONJUNCTION WITH ALL RELEVANT CONTRACT SPECIFICATIONS AND DRAWINGS COPYRIGHT OF THIS DRAWING IS VESTED IN WARDLE

General Notes

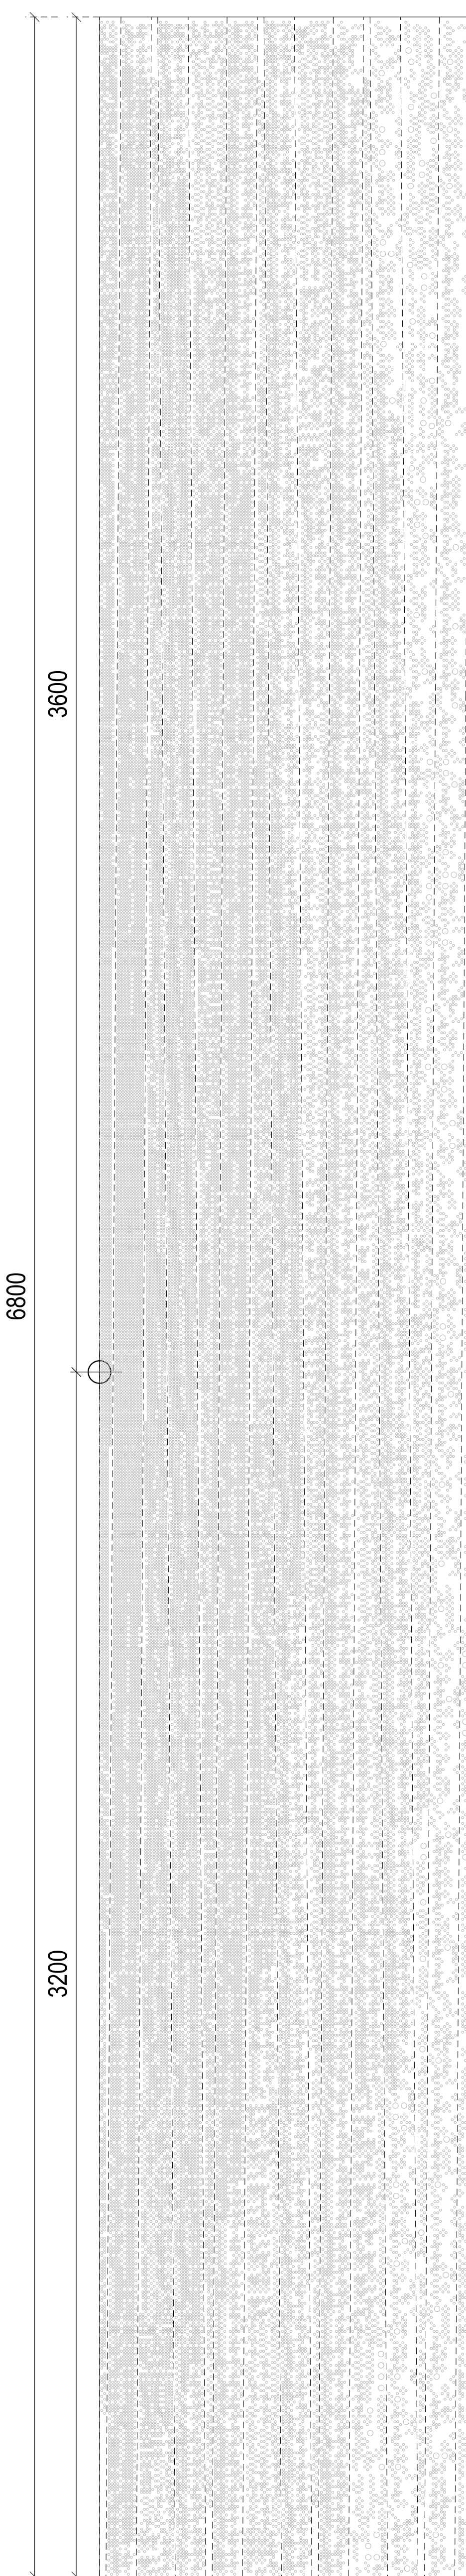

PERFORATION PATTERN NO.6
SCALE 1:10

WEST (ANGLE) ALTERNATING DESIGNS A AND B

Rev	Issue	Revision Description	Amd	Date
A	SC	ISSUE FOR CONSTRUCTION	-	05.12.13



NADAAA

NADAAA
1320 Washington
Street No.2
Boston
Massachusetts
02115 USA

Telephone
+1 617 442 8232
Facsimile
+1 608 442 1417
Email
nadaa@nadaaa.com

John Wardle Architects
25 Rokeby Street, Collingwood, Victoria 3066 Australia
Tel : +61 3 8662 0400 www.johnwardlearchitects.com
© 2012 John Wardle Architects ABN 83 006 814 268

Client **University of Melbourne
Parkville Campus**

Project **Faculty of Architecture
Building and Planning**

Title **METALWORK DETAILS
PERFORATION PATTERN NO. 6**

Project No. 0913	Scale 1:10 @ A0 1:20 @ A2
Drawing No. AR6565	Revision A

Date Dec 2011	Dwn	Co-Ord	Chk
------------------	-----	--------	-----

FILENAME - \$FILES

FOR CONSTRUCTION