



CONTRACTORS SHALL VERIFY JOB DIMENSIONS BEFORE ANY JOB COMMENCES. ALL SHOP DRAWINGS SHALL BE SUBMITTED TO THE SUPERINTENDENT AND MANUFACTURERS SHALL NOT COMMENCE FROM THE RETURN OF DIMENSIONED SHOP DRAWINGS ISSUED BY THE CONSULTANT. DIMENSIONS SHALL TAKE PRECEDENCE OVER SCALES. THIS DRAWING SHALL BE READ IN CONJUNCTION WITH ALL RELEVANT CONTRACT SPECIFICATIONS AND DRAWINGS COPYRIGHT OF THIS DRAWING IS VESTED IN NADAAA.


General Notes

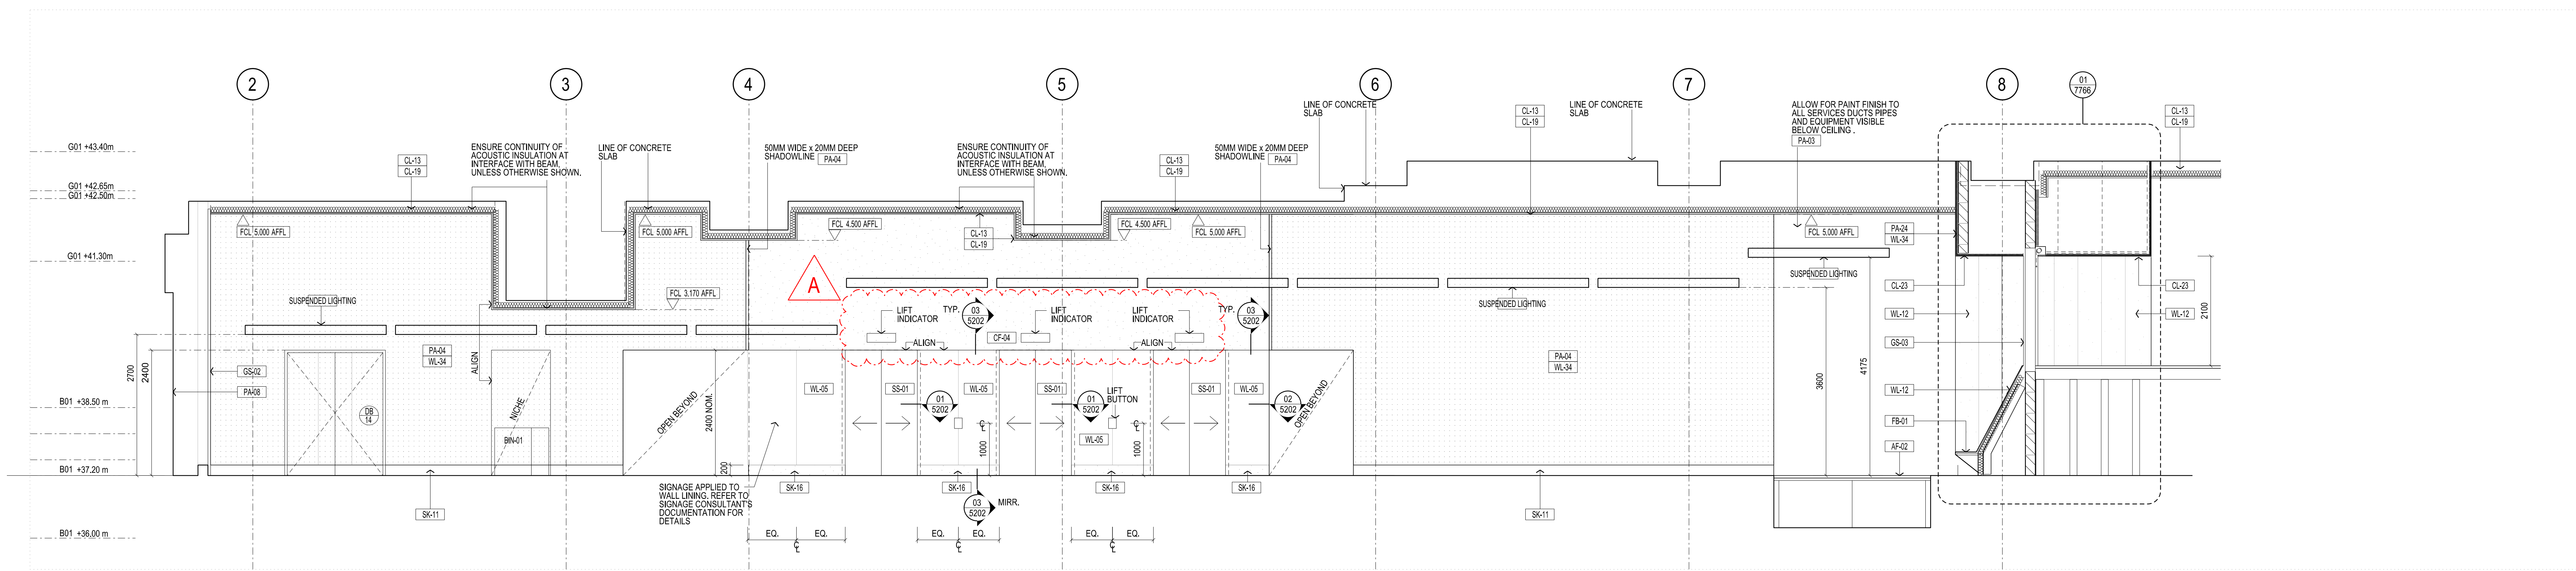


01 Foyer 1 - NORTH ELEVATION
SCALE 1:50

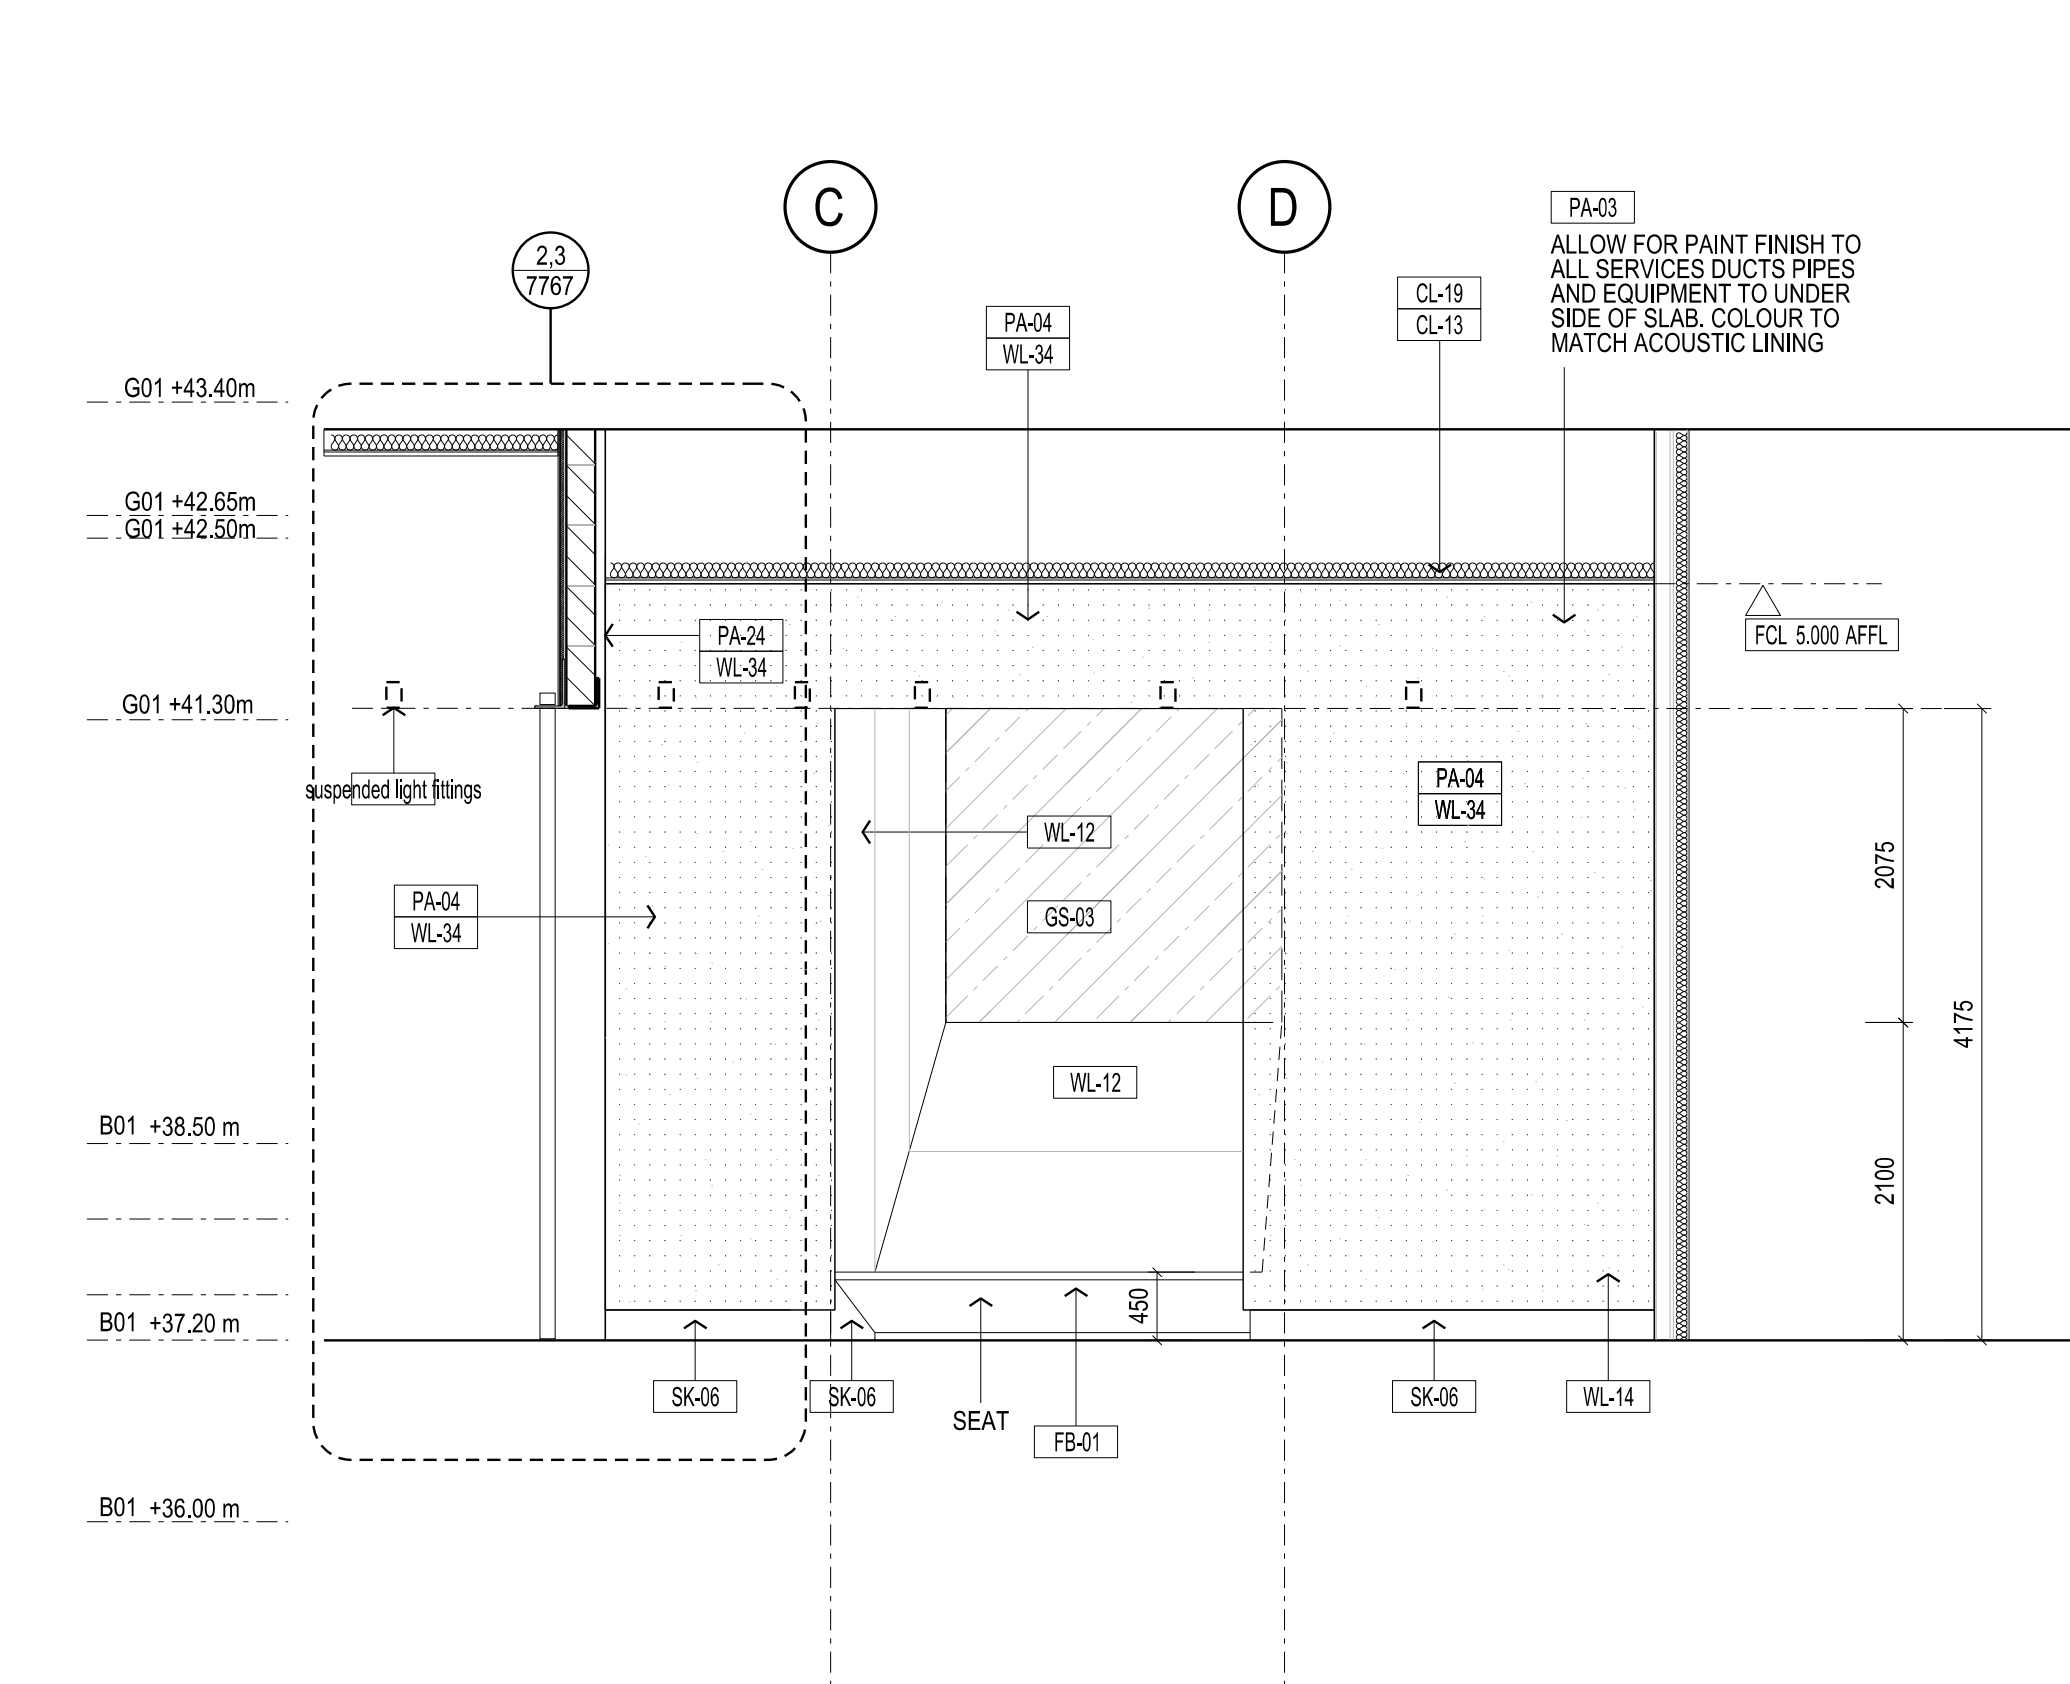

02 Foyer 1 - EAST ELEVATION
SCALE 1:50

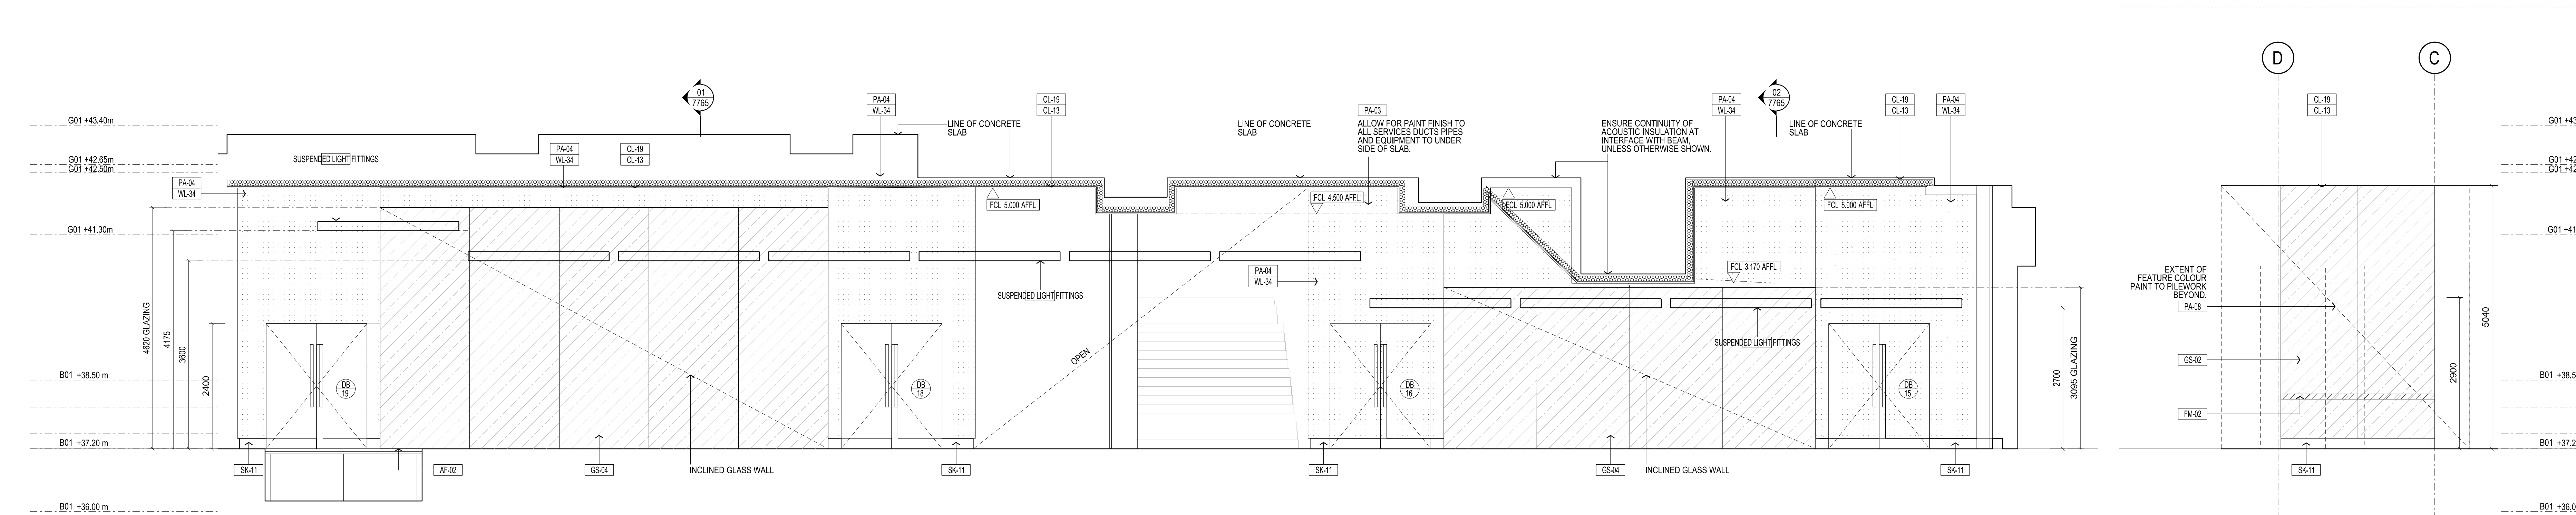

03 Foyer 1 - SOUTH ELEVATION - TRUE
SCALE 1:50

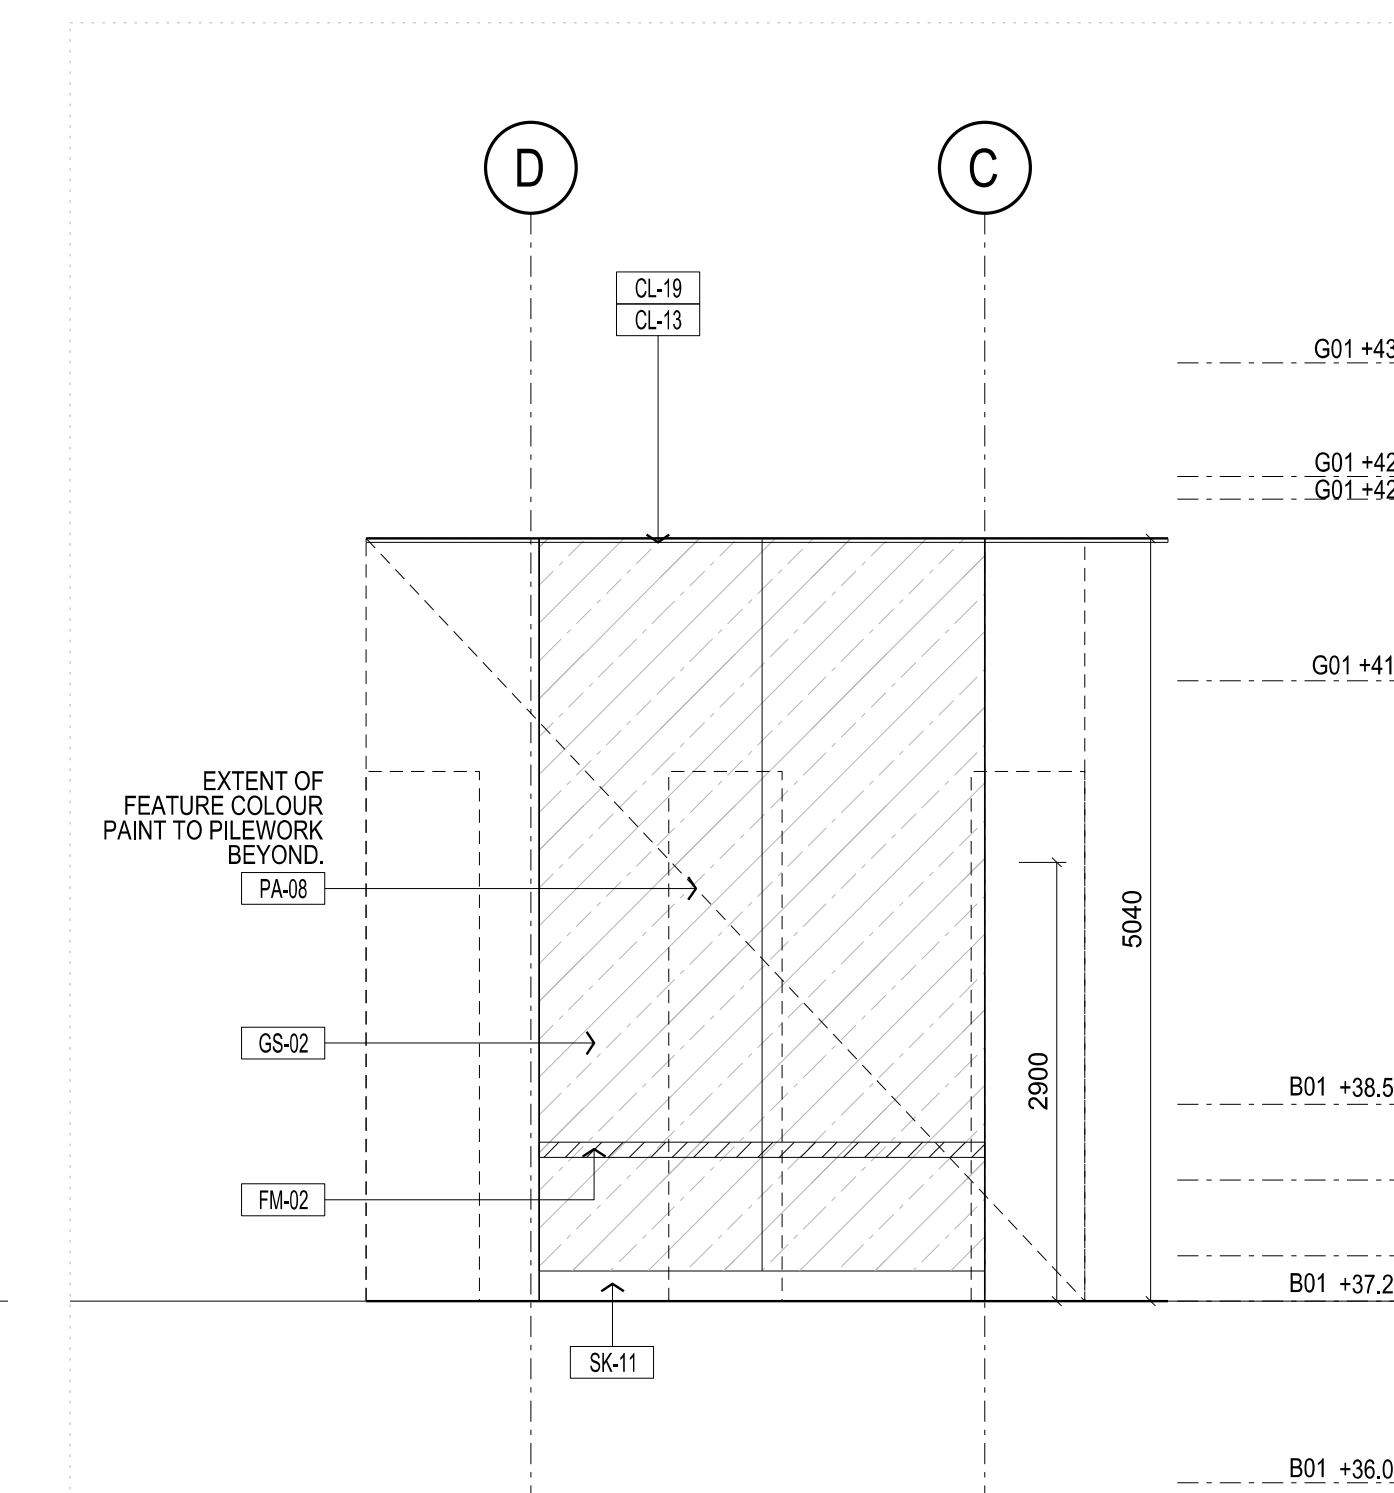

04 Foyer 1 - WEST ELEVATION
SCALE 1:50

Rev	Issue	Revision Description	And	Date
A	SG	LIFT INDICATOR AMENDED		23.09.13
06	SG	CL-07 DELETED		18.07.13
05	SG	CEILING LEVELS COORDINATED/CLARIFIED		28.03.13
05	SG	VALUE MANAGEMENT ISSUE		28.03.13
04	SG	TENDER ADDENDUM NO. 5		15.10.12
03	SG	100% CD - TENDER ISSUE		07.09.12
02	SG	90% CD ISSUE		10.08.12
01	SG	75% CD ISSUE		13.07.12



NADAAA
 NADAAA
 1520 Washington Street No.2
 Boston Massachusetts 02118 USA
 Telephone +1 617 442 8232
 Facsimile +1 688 442 1417
 Email nadaa@nadaa.com

John Wardle Architects
 25 Rokeby Street, Collingwood, Victoria 3066 Australia
 Tel: +61 3 8662 0400 www.johnwardlearchitects.com
 © 2012 John Wardle Architects ABN 83 006 814 268

Client **University of Melbourne Parkville Campus**

Project **Faculty of Architecture Building and Planning**

Title **INTERIOR ELEVATIONS B01 FOYER 1**

Project No.	0913	Scale	1:50 @ A0
Drawing No.	AR7105	Revision	A
Date	May 2011	Dwn	-
Co-Ord	-	Chk	-

FILENAME - \$FILES
FOR CONSTRUCTION