




01 Foyer 2 - True Elevation
SCALE 1:50

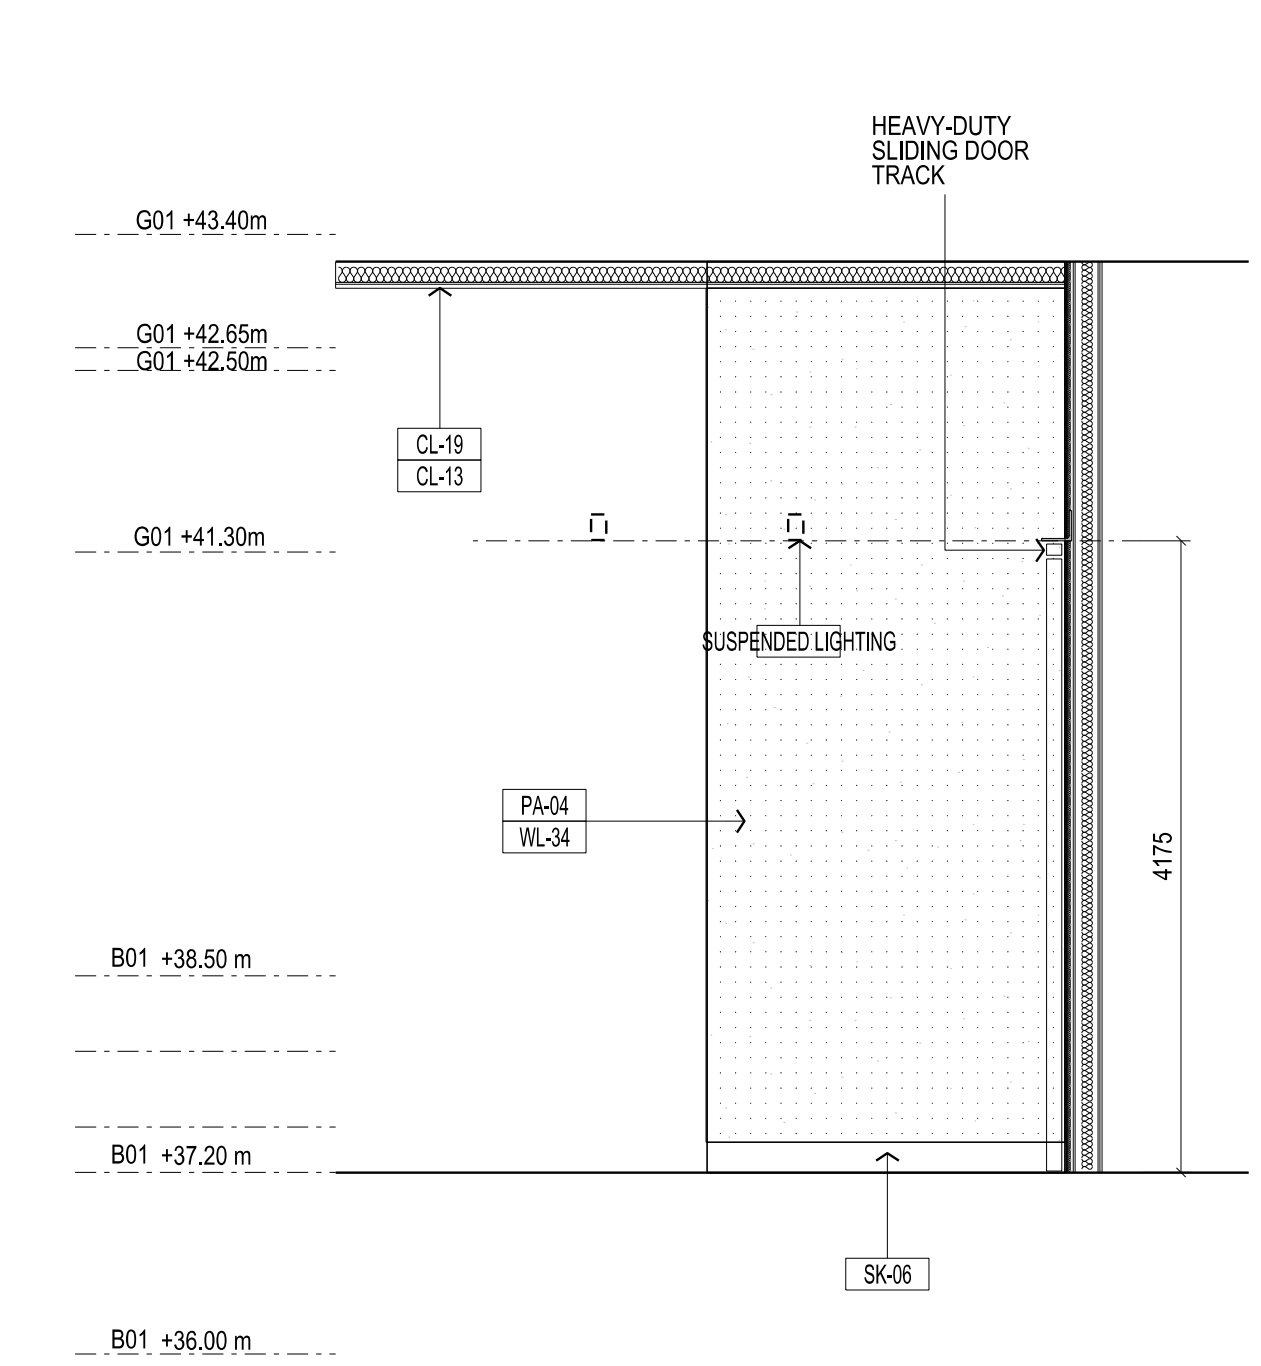


02 Foyer 2 - True Elevation
SCALE 1:50

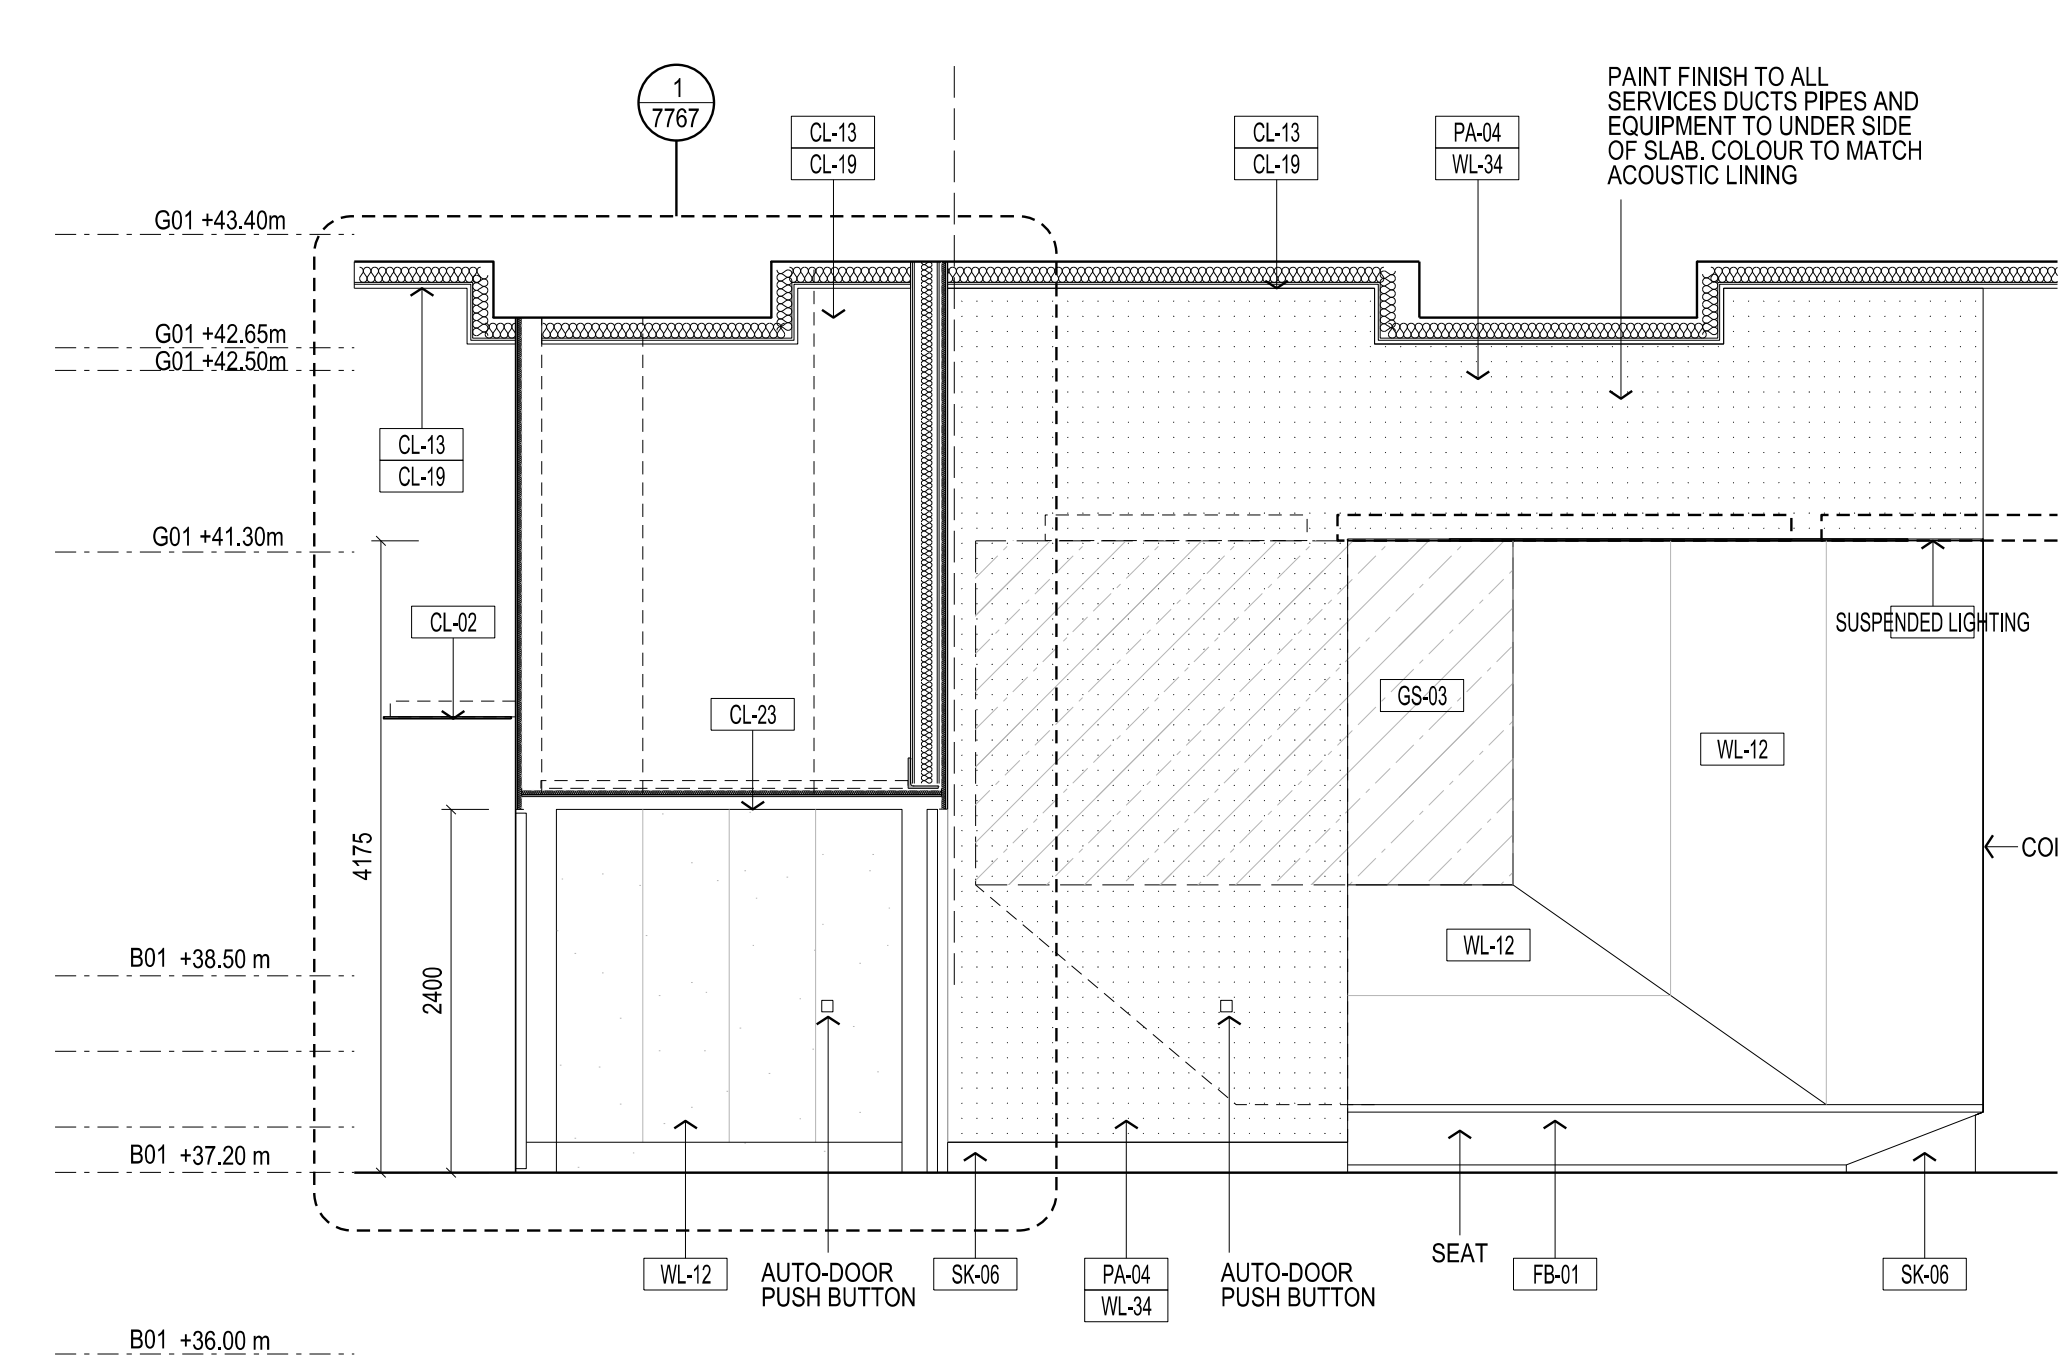


03 Foyer 2 - True Elevation
SCALE 1:50

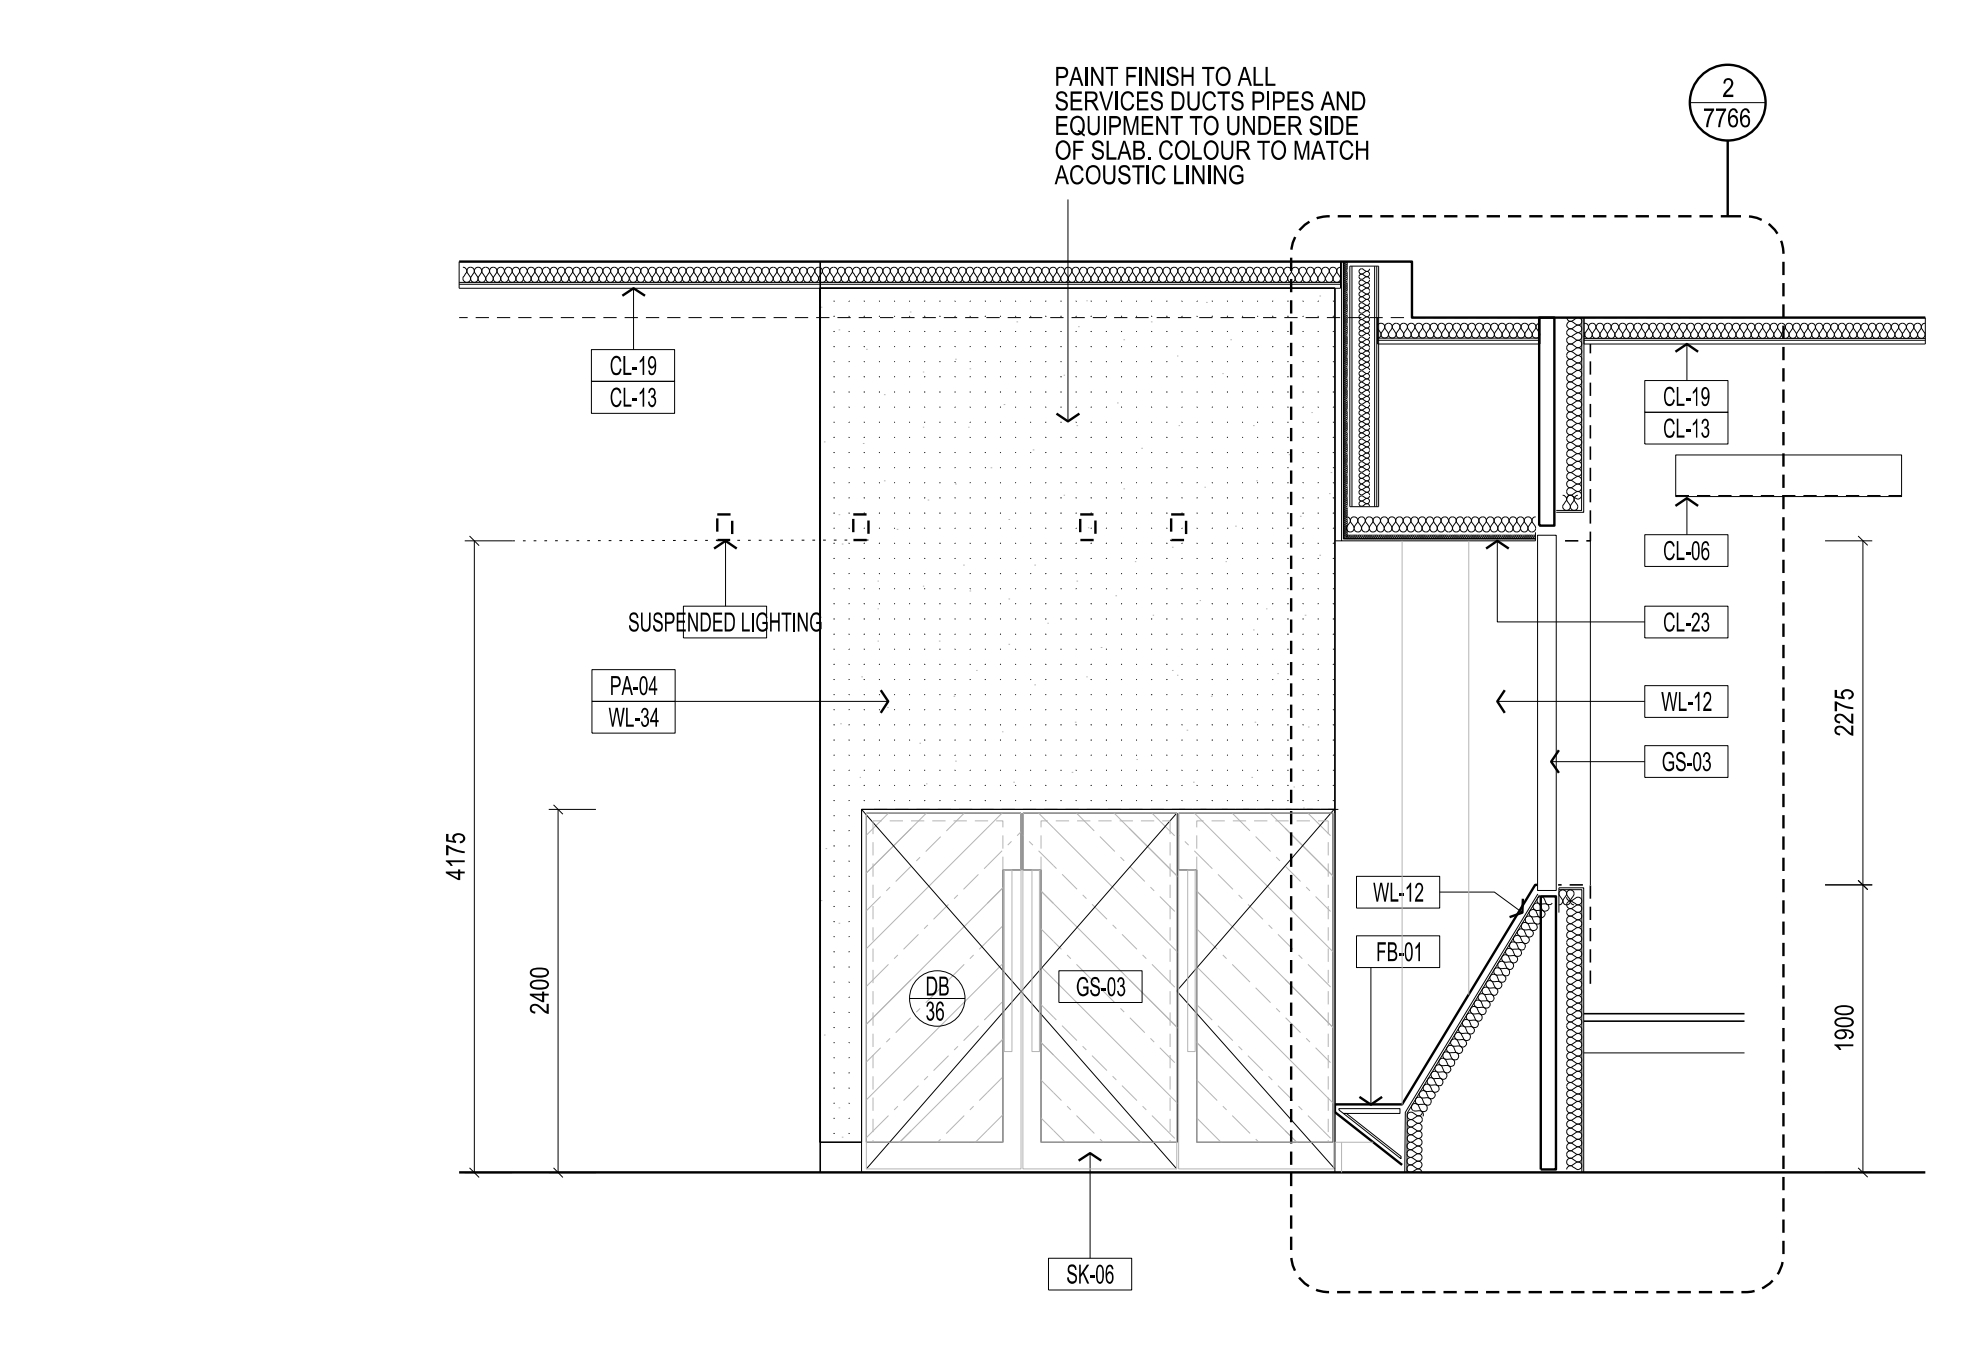


04 Foyer 2 - True Elevation
SCALE 1:50

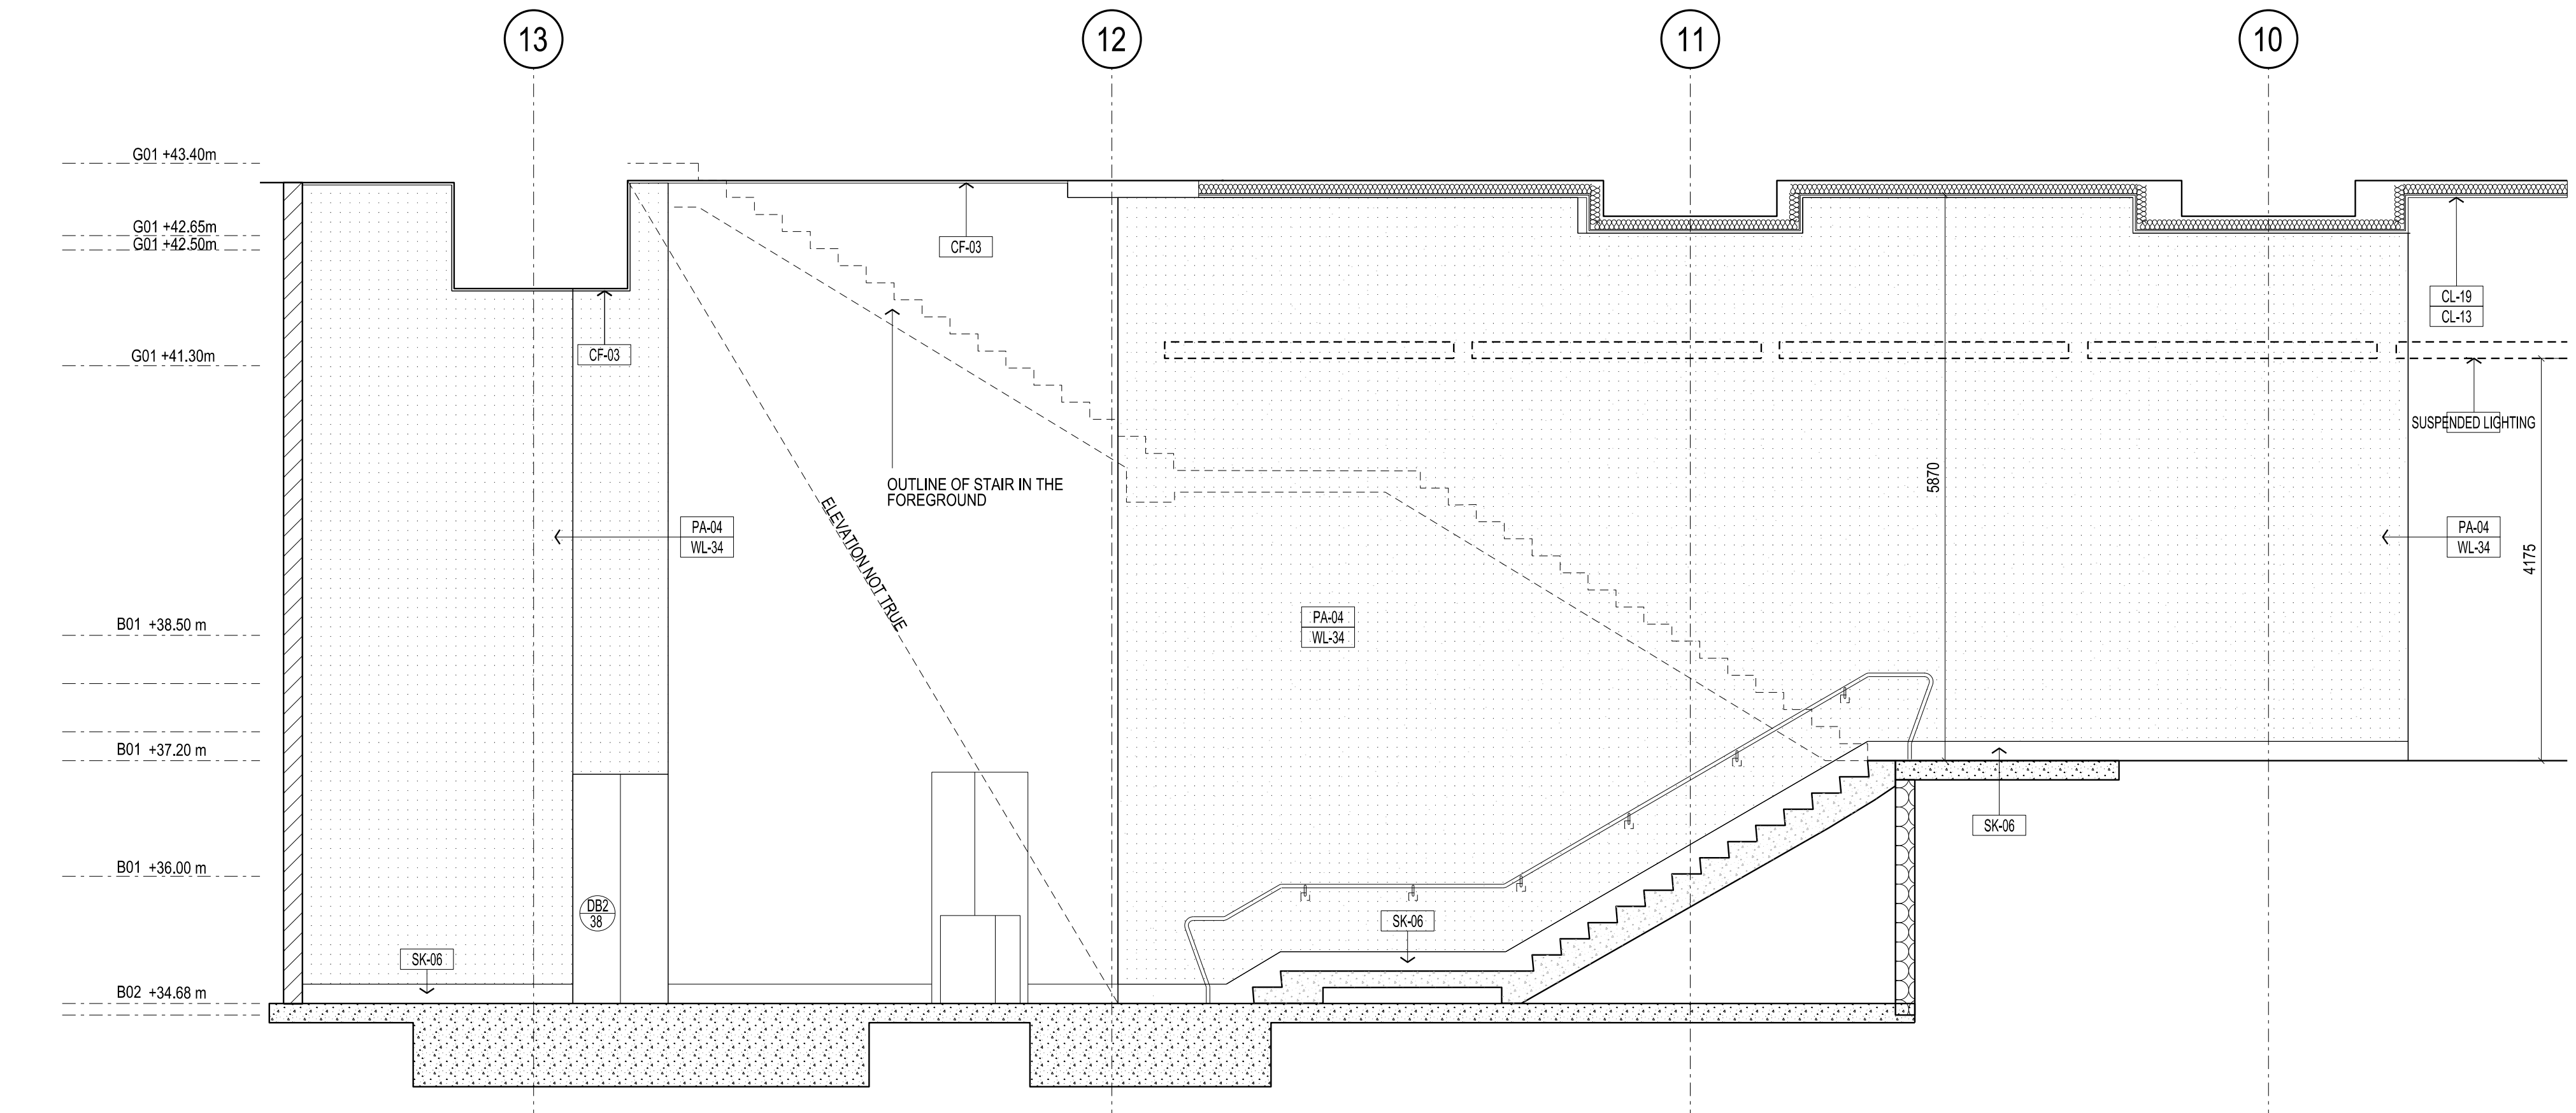


05 Foyer 2 - True Elevation
SCALE 1:50

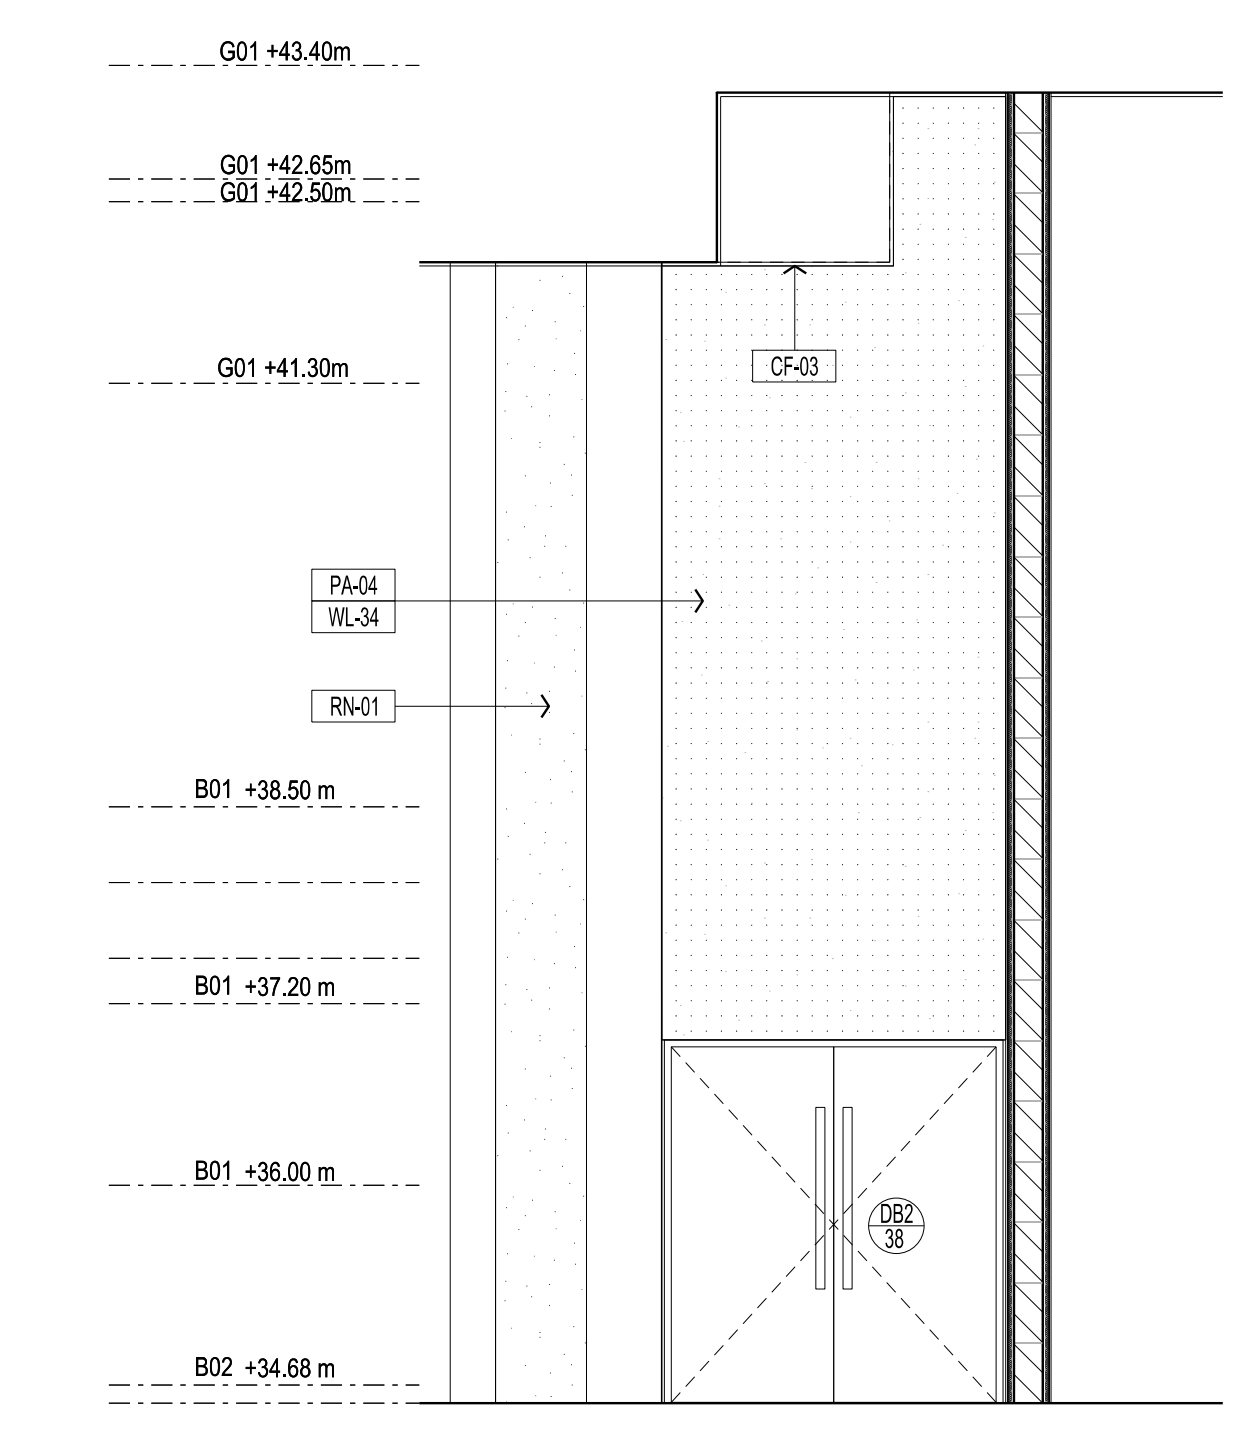


06 Foyer 2 - True Elevation
SCALE 1:50

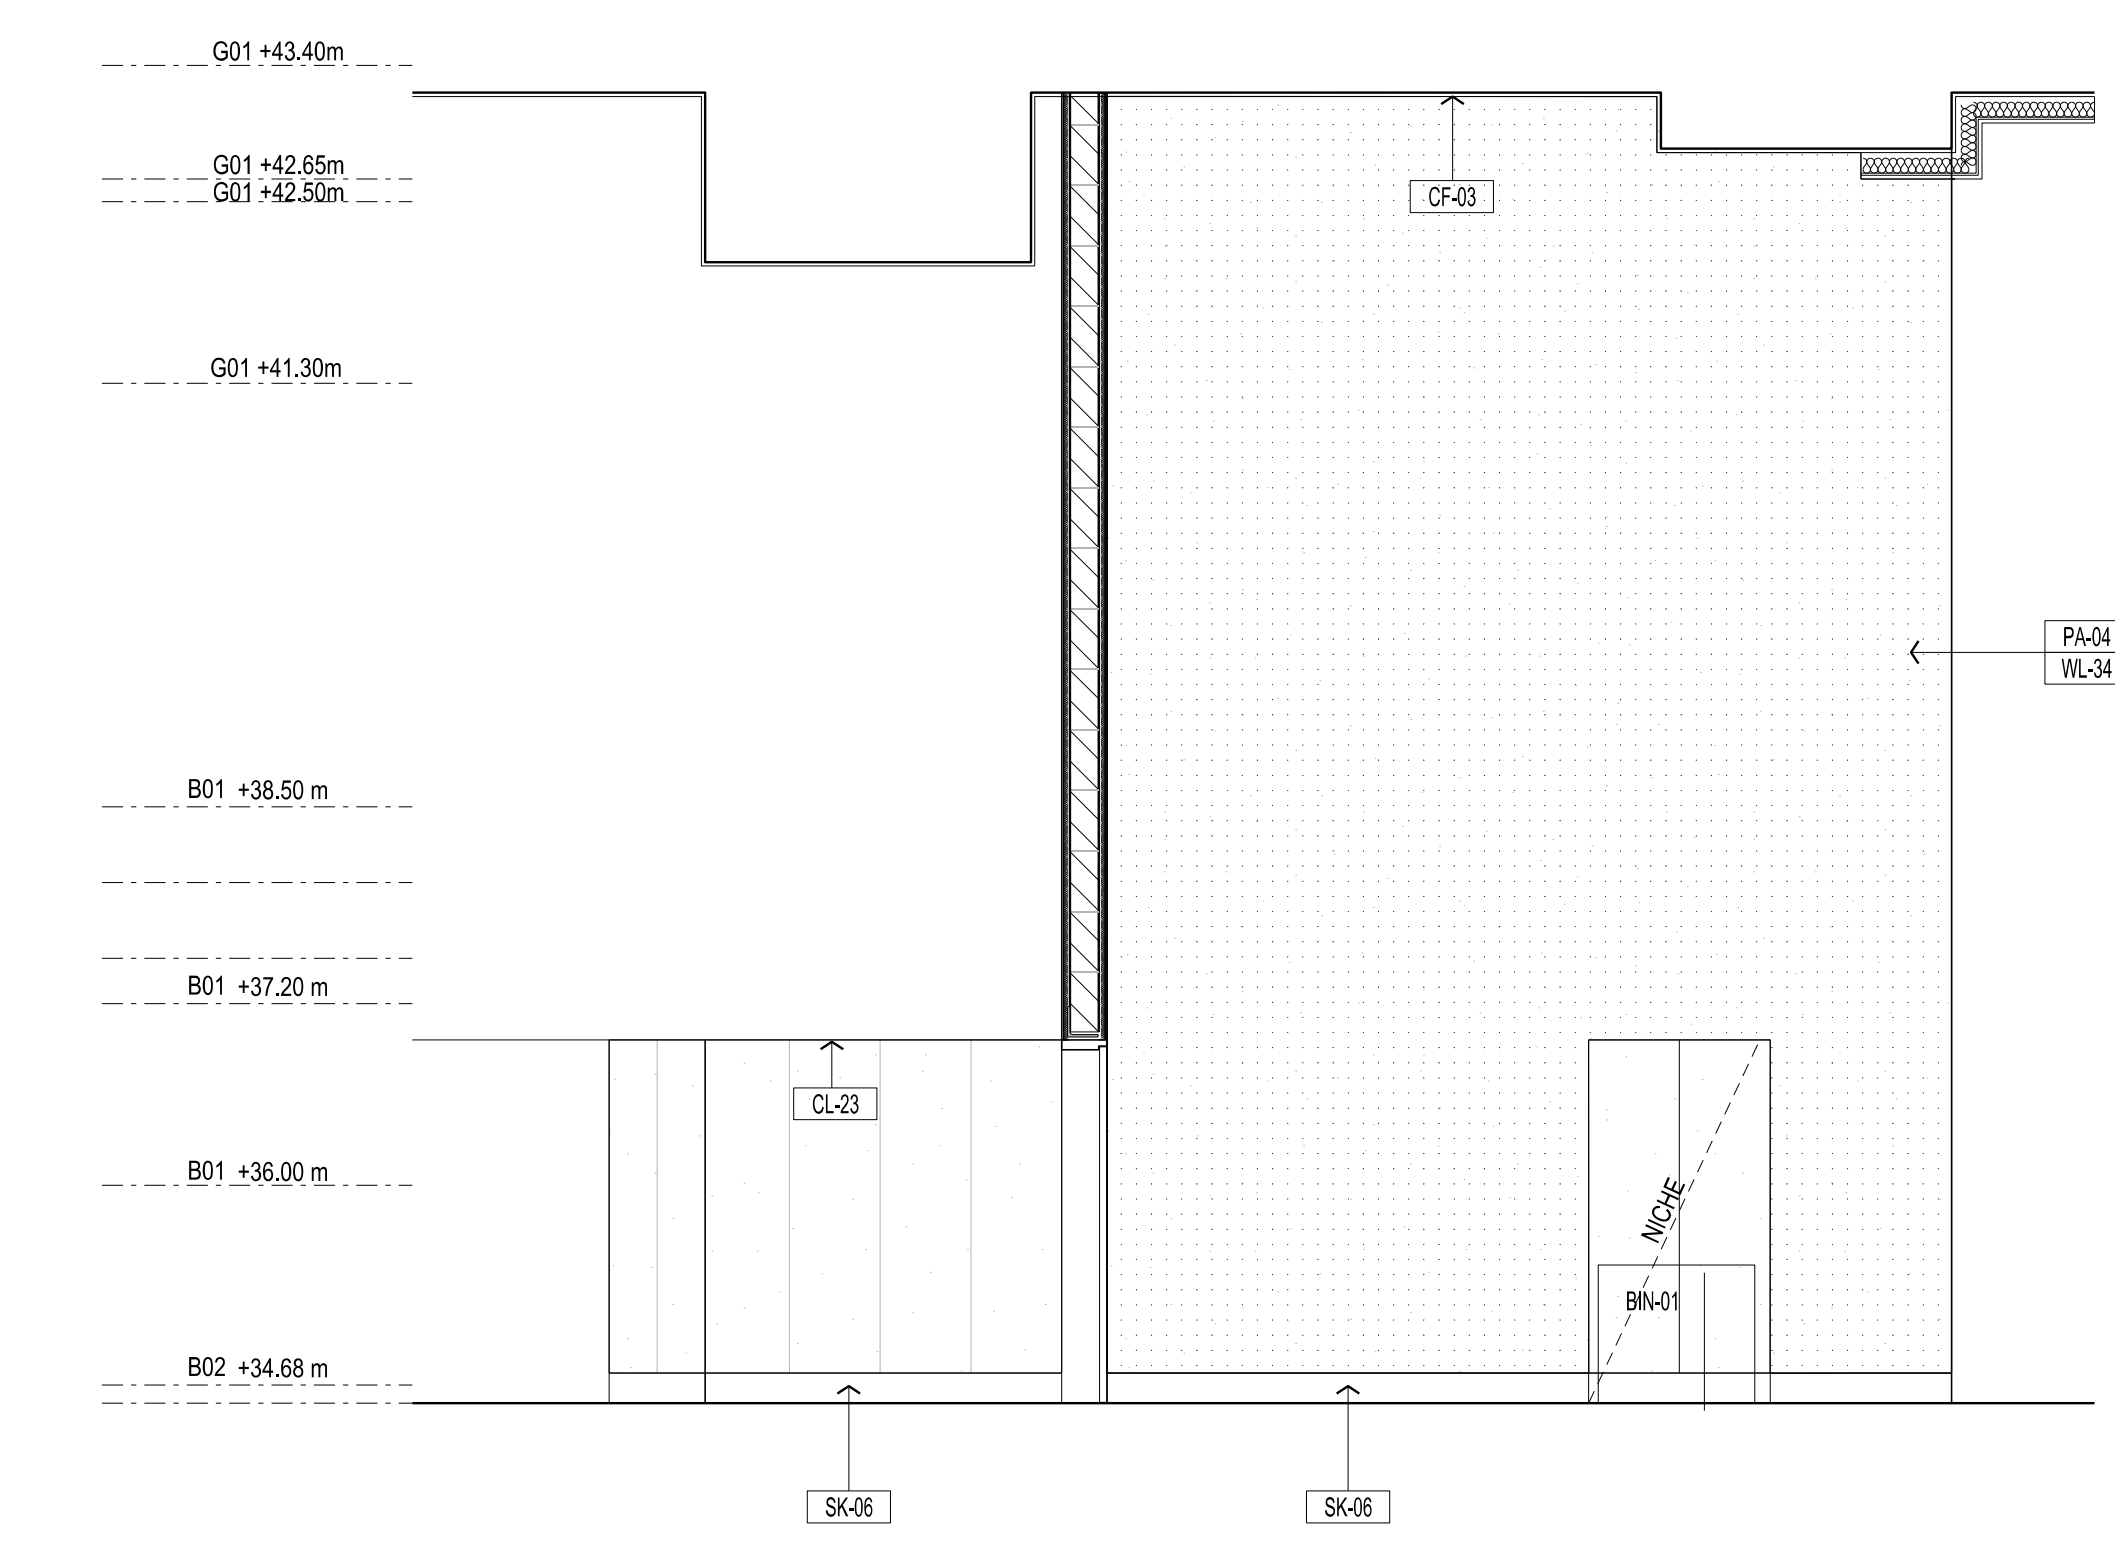


07 Foyer 2 - True Elevation
SCALE 1:50

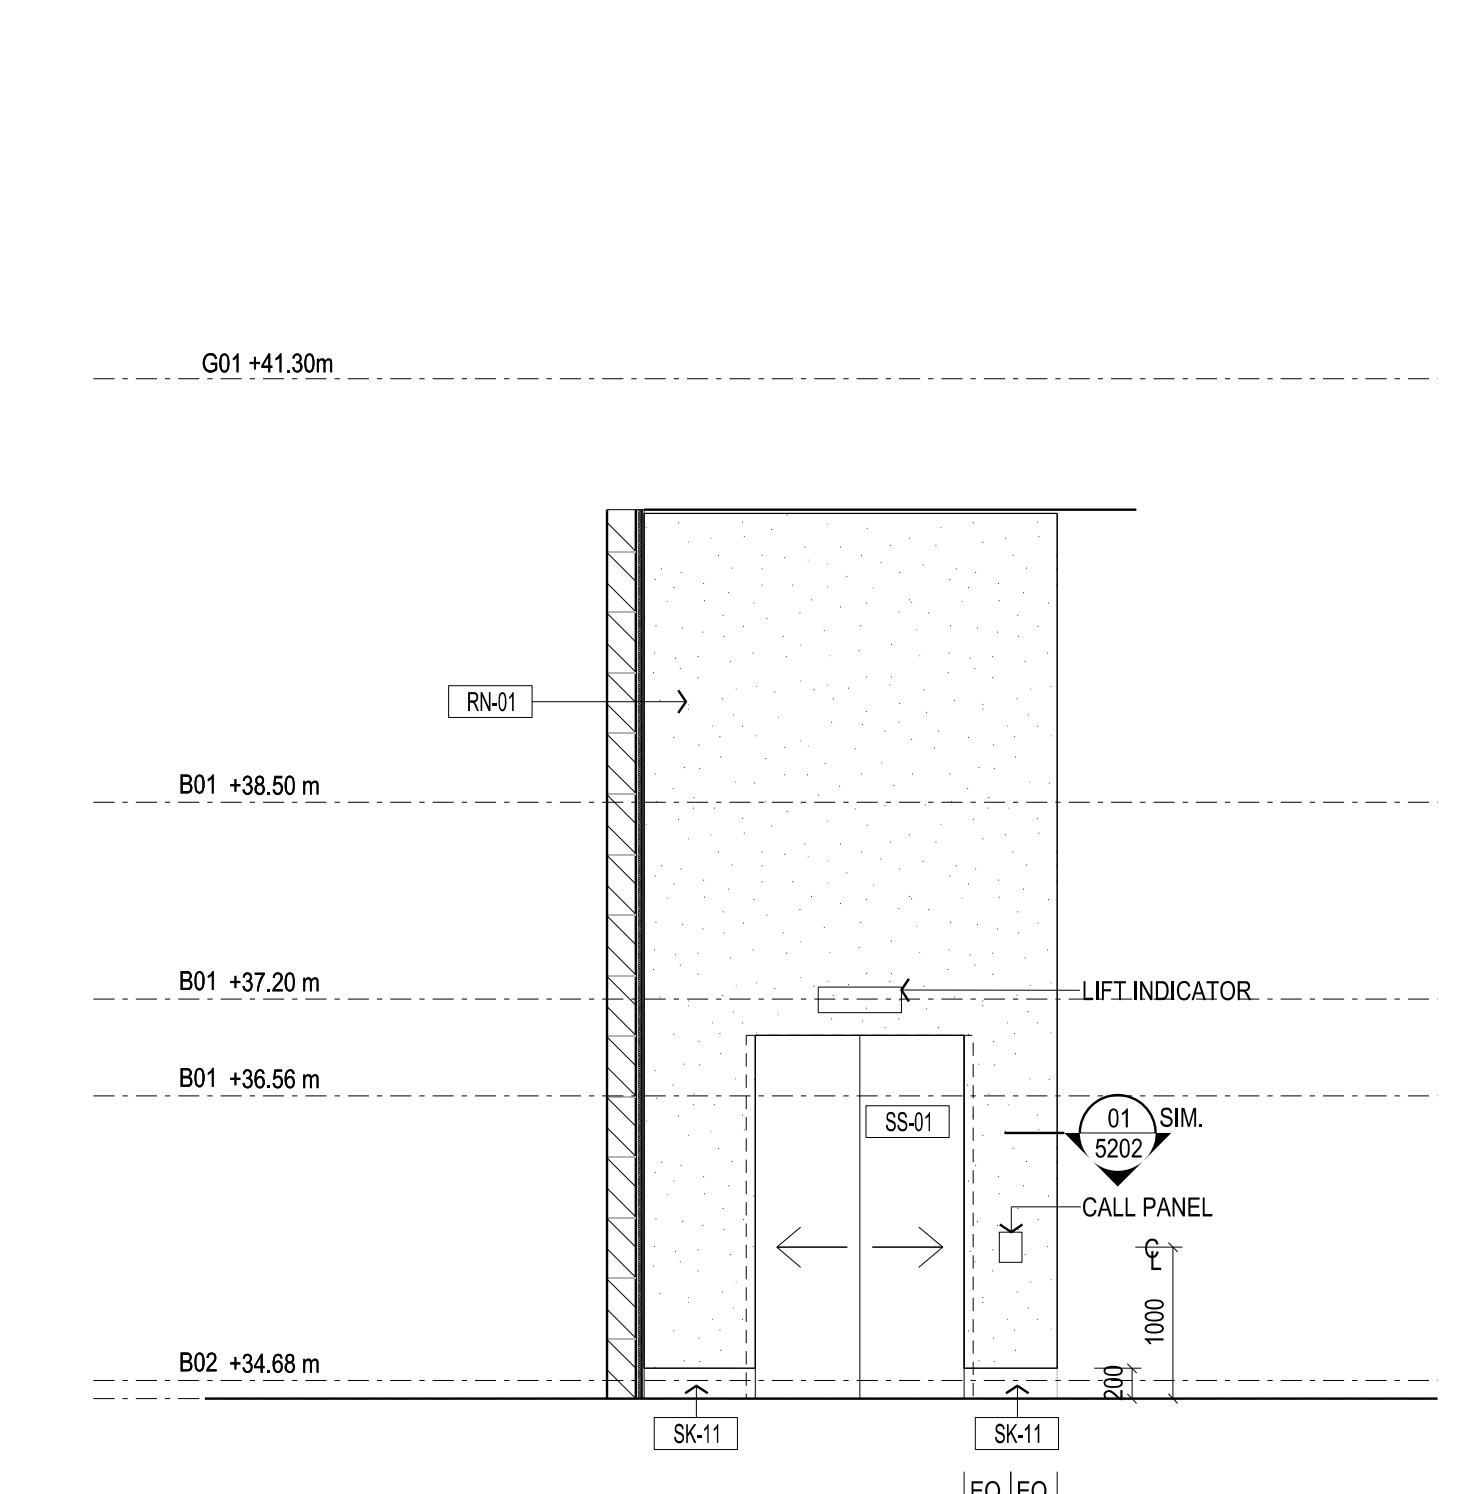

08 Foyer 2 - Lift Lobby Lift 05
SCALE 1:50

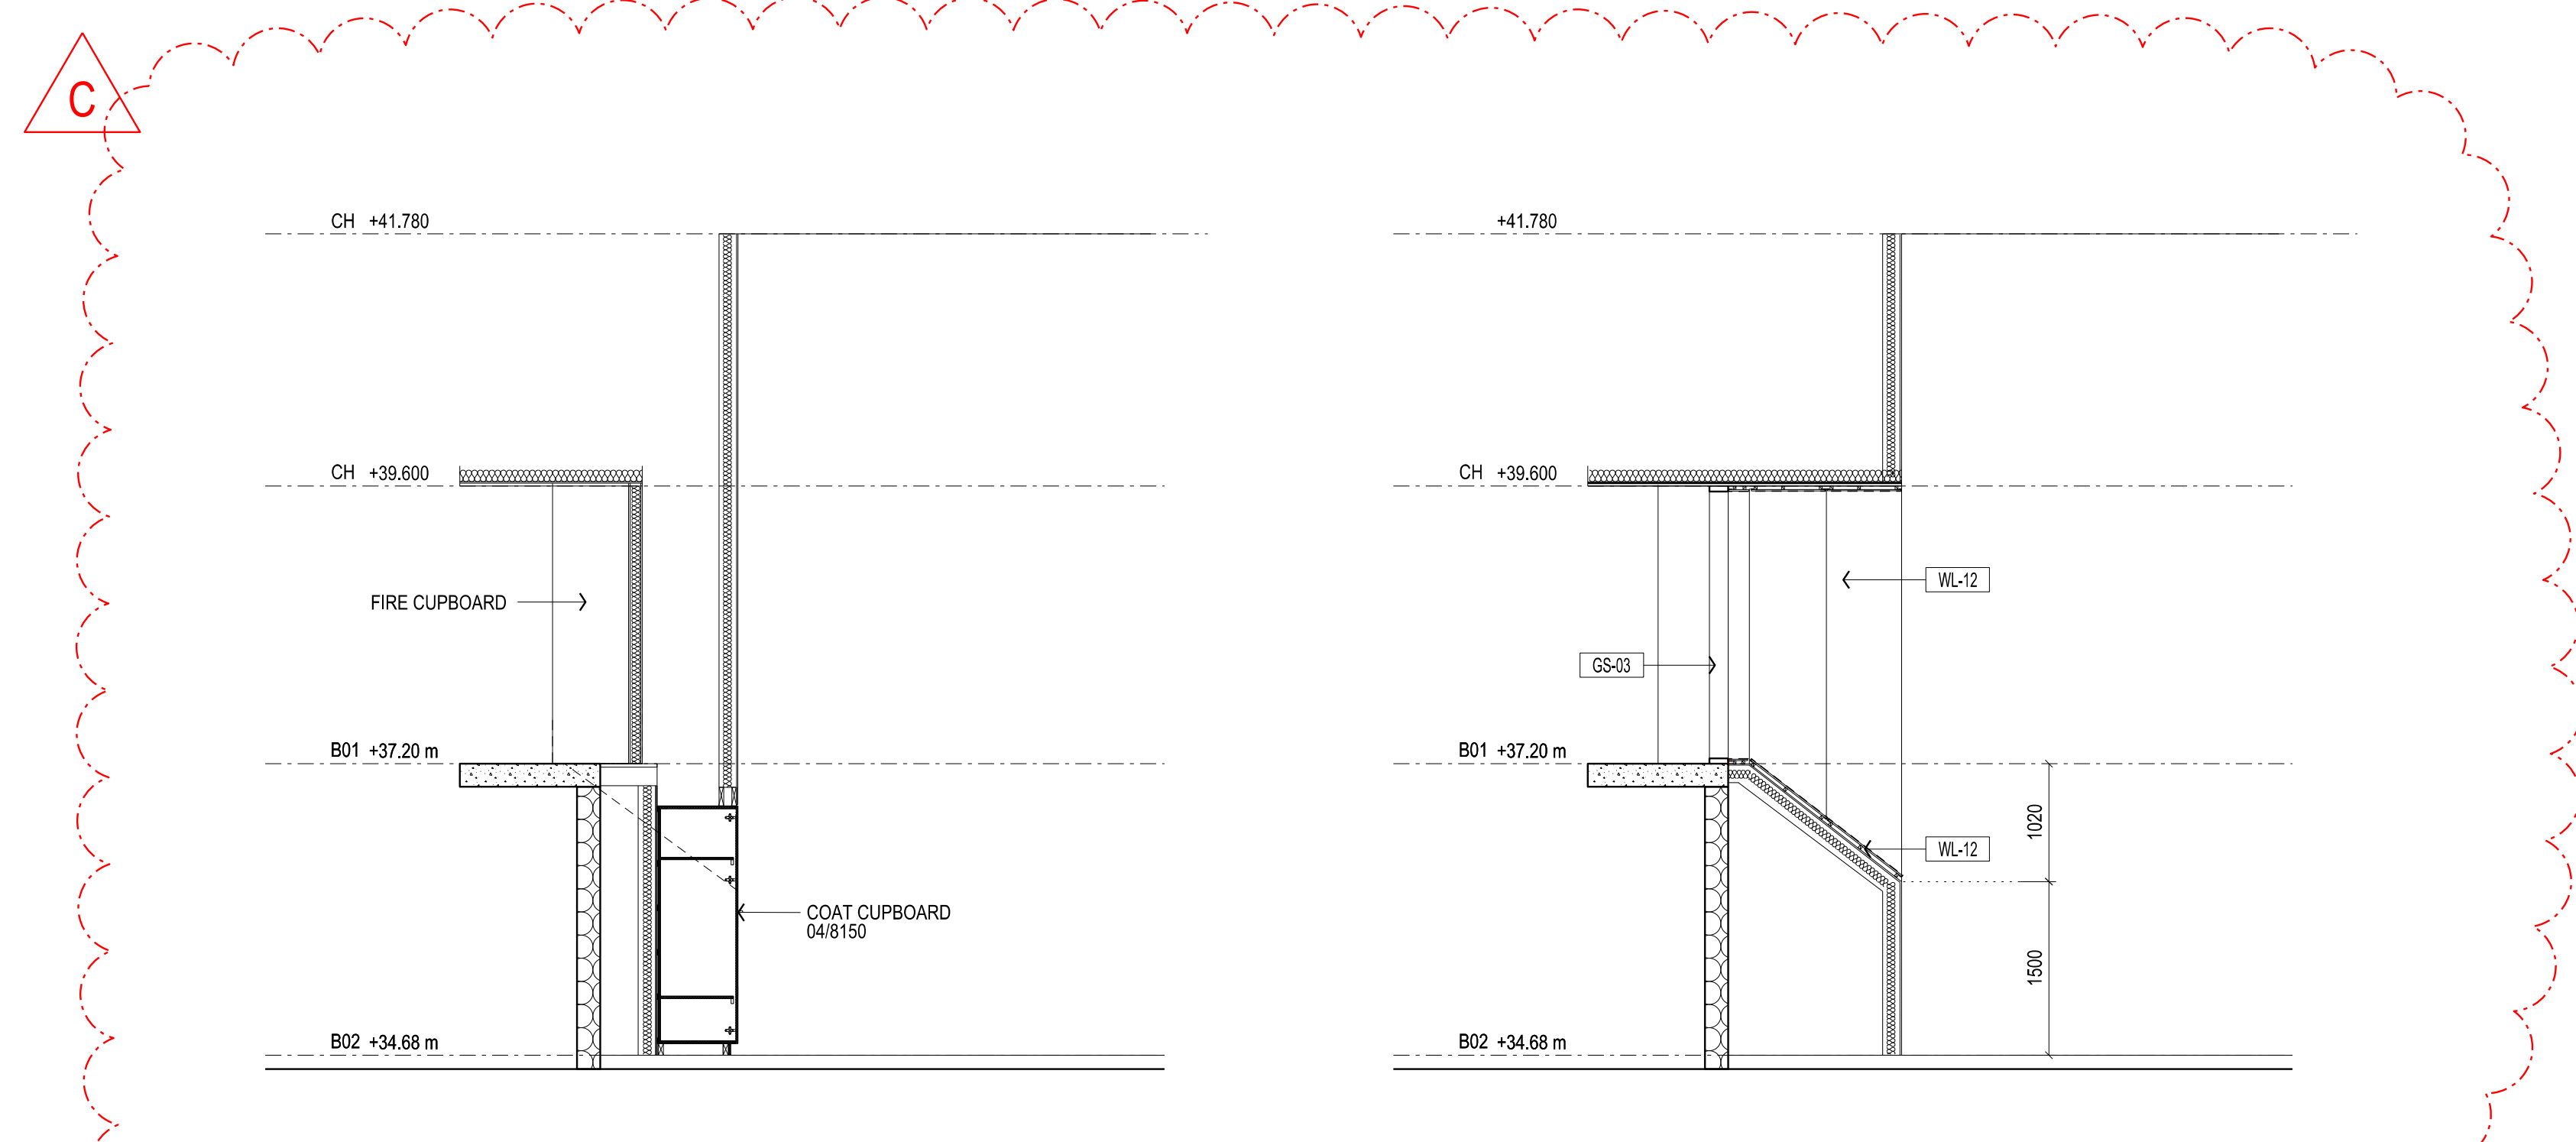

09 Entry Lock to Green Room
SCALE 1:50

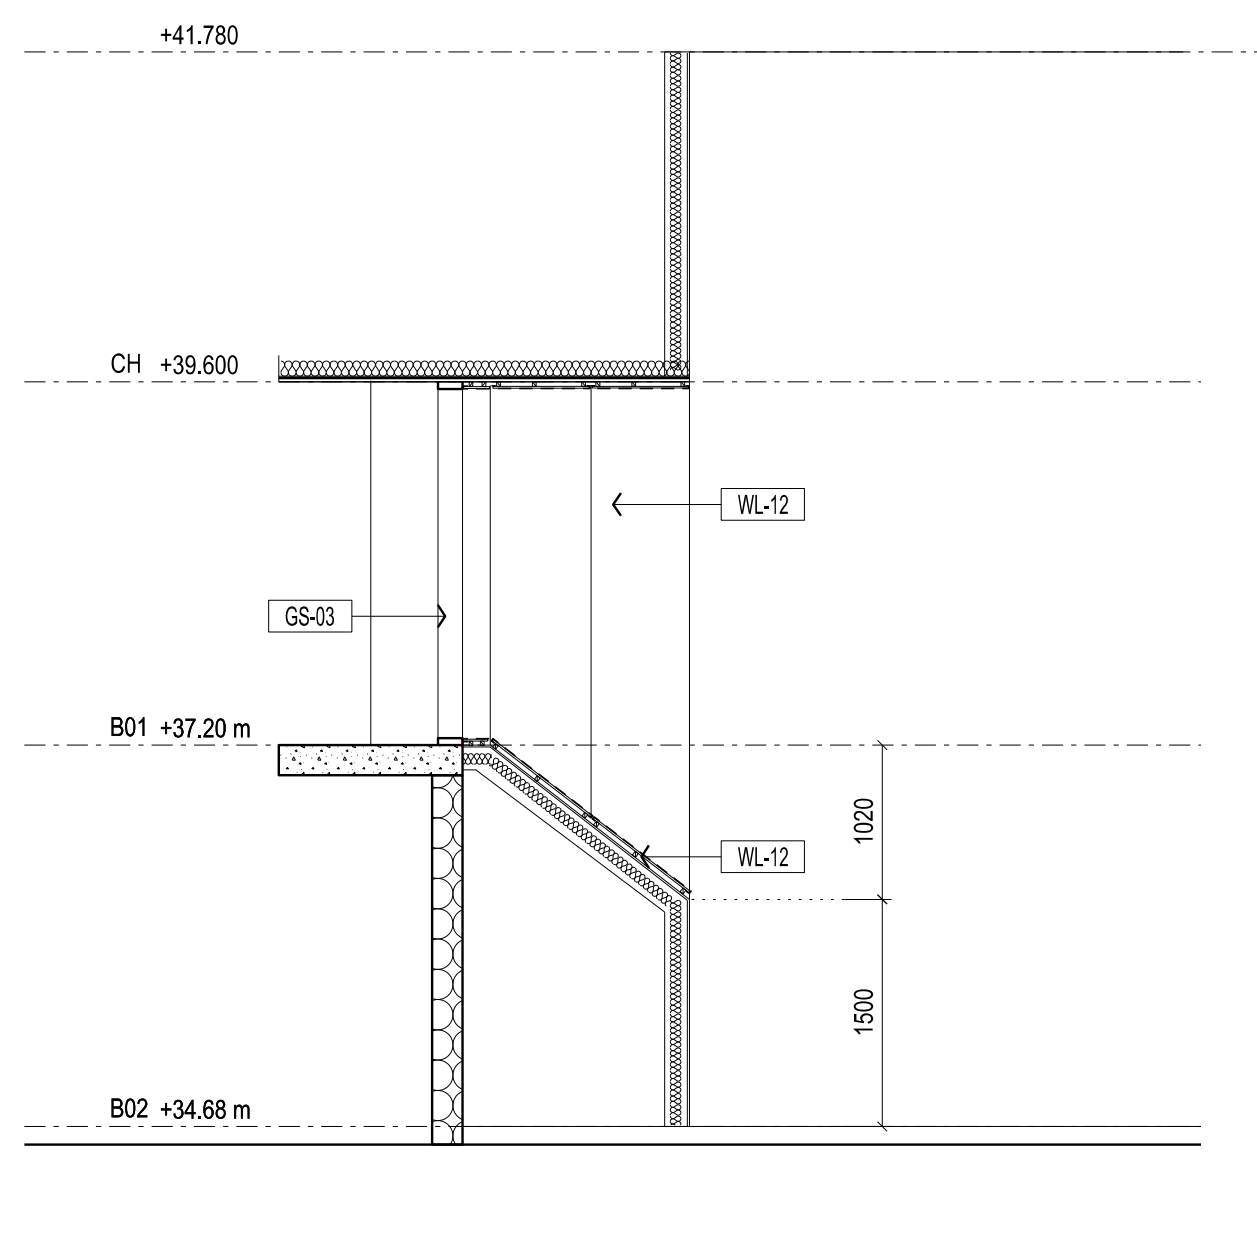

10 Entry Lock to Green Room
SCALE 1:50

Rev	Issue	Revision Description	And	Date
C	SG	UPDATES AS CLOUDED		03.02.14
B	SG	UPDATES AS CLOUDED		16.12.13
A	SG	LIFT INDICATOR AMENDED		23.09.13
CEILING LEVELS COORDINATED/CLARIFIED				
05	SG	VALUE MANAGEMENT ISSUE		28.03.13
04	SG	TENDER ADDENDUM NO. 05		15.10.12
03	SG	100% CD - TENDER ISSUE		07.09.12
02	SG	90% CD ISSUE		10.08.12
01	SG	75% CD ISSUE		13.07.12



NADAAA
 NADAAA
 1520 Washington Street No.2 Boston Massachusetts 02118 USA
 Telephone +1 617 442 8232 Facsimile +1 688 442 1417 Email nadaaa@nadaaa.com

John Wardle Architects
 25 Rokeby Street, Collingwood, Victoria 3066 Australia
 Tel: +61 3 8662 0400 www.johnwardlearchitects.com
 © 2014 John Wardle Architects ABN 83 006 814 268

Client **University of Melbourne Parkville Campus**

Project **Faculty of Architecture Building and Planning**

Title **INTERIOR ELEVATIONS B01 FOYER 2**

Project No.	0913	Scale	1:50 @ A0
Drawing No.	AR7106	Revision	C

Date Jul 2012 Dwn - Co-Ord - Chk -

FILENAME - SFLES

FOR CONSTRUCTION