


01 TYPICAL CORE 1 - LIFT LOBBY - ELEVATION  
SCALE 1:50

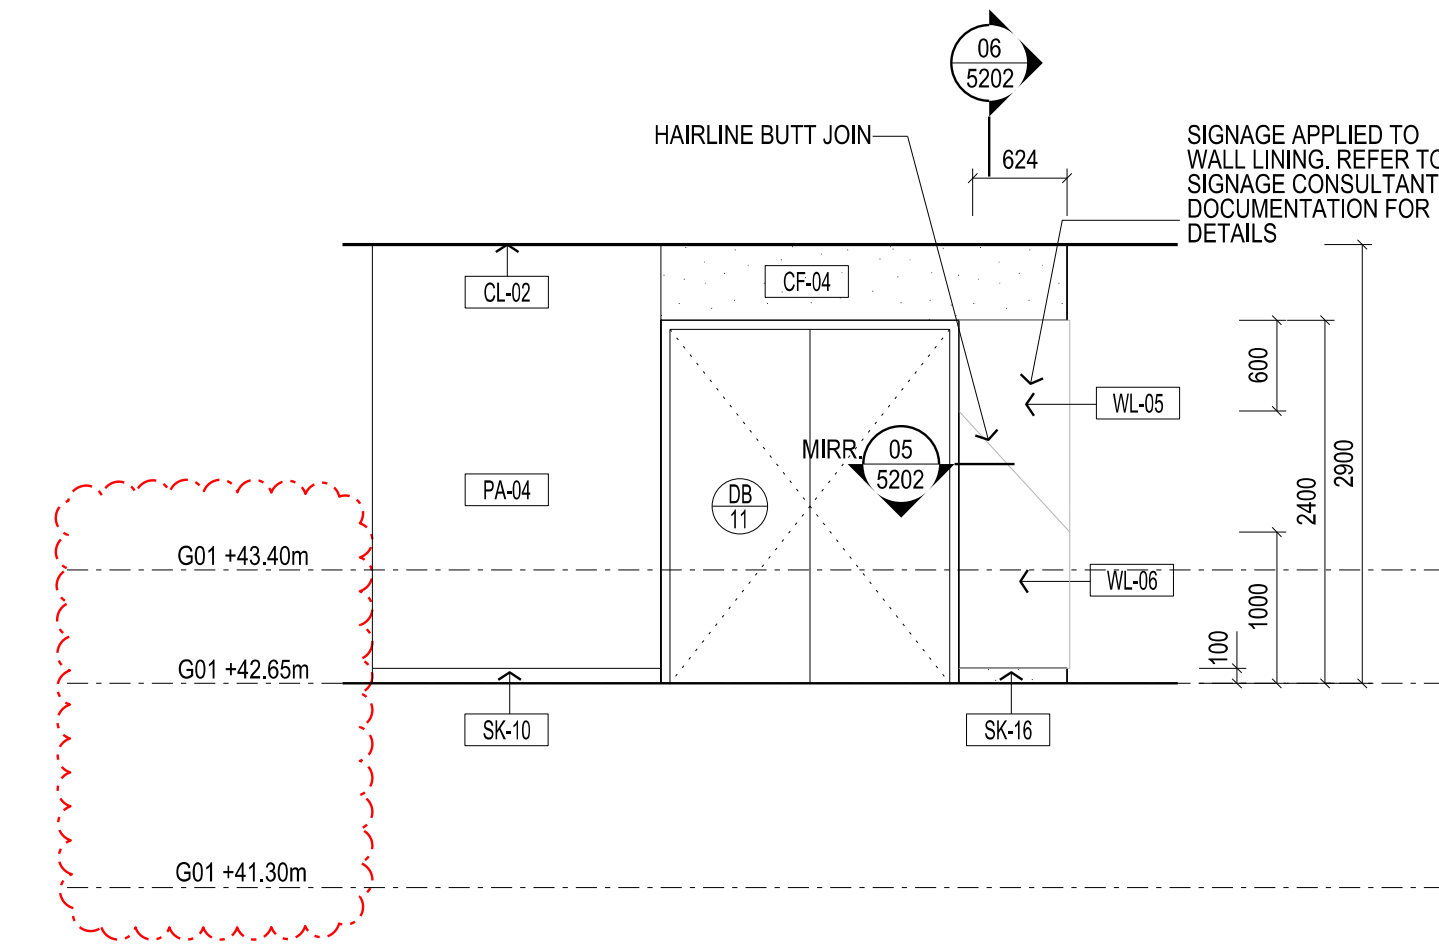

02 TYPICAL CORE 1 - LIFT LOBBY - ELEVATION  
SCALE 1:50

THIS DRAWING IS AN UNCONTROLLED COPY UNLESS STAMPED OTHERWISE

CONTRACTORS SHALL VERIFY JOB DIMENSIONS BEFORE ANY JOB COMMENCES. ALL SHOP DRAWINGS SHALL BE SUBMITTED TO THE SUPERINTENDENT AND MANUFACTURER SHALL NOT COMMENCE FROM THE RETURN OF DRAWINGS SHOWN BY THE CONSULTANT. DIMENSIONS SHALL TAKE PRECEDENCE OVER SCALES. THIS DRAWING SHOULD BE READ IN CONJUNCTION WITH ALL RELEVANT CONTRACT SPECIFICATIONS AND DRAWINGS COPYRIGHT OF THIS DRAWING IS VESTED IN WARDLE.

General Notes

Rev	Issue	Revision Description	Amd	Date
B	SG	UPDATES AS CLOUDED	-	14.11.13
A	SG	LIFT INDICATOR AMENDED	-	23.09.13
02	SG	UPDATES AS CLOUDED	-	23.09.13
01	SG	TENDER ADDENDUM NO. 05	-	15.10.12




**NADAAA**  
 NADAAA  
 1520 Washington Street No. 2  
 Boston Massachusetts 02118 USA  
 Telephone +1 617 442 8232  
 Facsimile +1 688 442 1417  
 Email nadaaa@nadaaa.com

**John Wardle Architects**  
 25 Rokeby Street, Collingwood, Victoria 3066 Australia  
 Tel : +61 3 8662 0400 www.johnwardlearchitects.com  
 © 2012 John Wardle Architects ABN 83 006 814 268

Client **University of Melbourne  
Parkville Campus**

Project **Faculty of Architecture  
Building and Planning**

Title **INTERIOR ELEVATIONS  
TYPICAL LIFT LOBBY CORE 1**

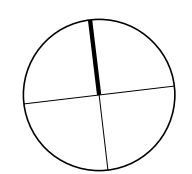	Project No.	<b>0913</b>	Scale	1:50 @ A0
	Drawing No.	<b>AR7107</b>	Revision	<b>B</b>
Date: Jul 2012	Dwn	Co-Ord	Chk	

FILENAME - SFILES

**FOR CONSTRUCTION**