


THIS DRAWING IS AN UNCONTROLLED COPY UNLESS STAMPED OTHERWISE


CONTRACTORS SHALL VERIFY JOB DIMENSIONS BEFORE ANY JOB COMMENCES. ALL SHOP DRAWINGS SHALL BE SUBMITTED TO THE SUPERINTENDENT AND MANUFACTURER SHALL NOT COMMENCE PRIOR TO THE RETURN OF SIGNED SHOP DRAWINGS. BY THE CONTRACTOR. DIMENSIONS SHALL TAKE PRECEDENCE OVER SCALES. THIS DRAWING SHOULD BE READ IN CONJUNCTION WITH ALL RELEVANT CONTRACT SPECIFICATIONS AND DRAWINGS COPYRIGHT OF THIS DRAWING IS VESTED IN WARDLE.

General Notes  
REFER TO WINDOW SCHEDULE FOR FURTHER DETAILS

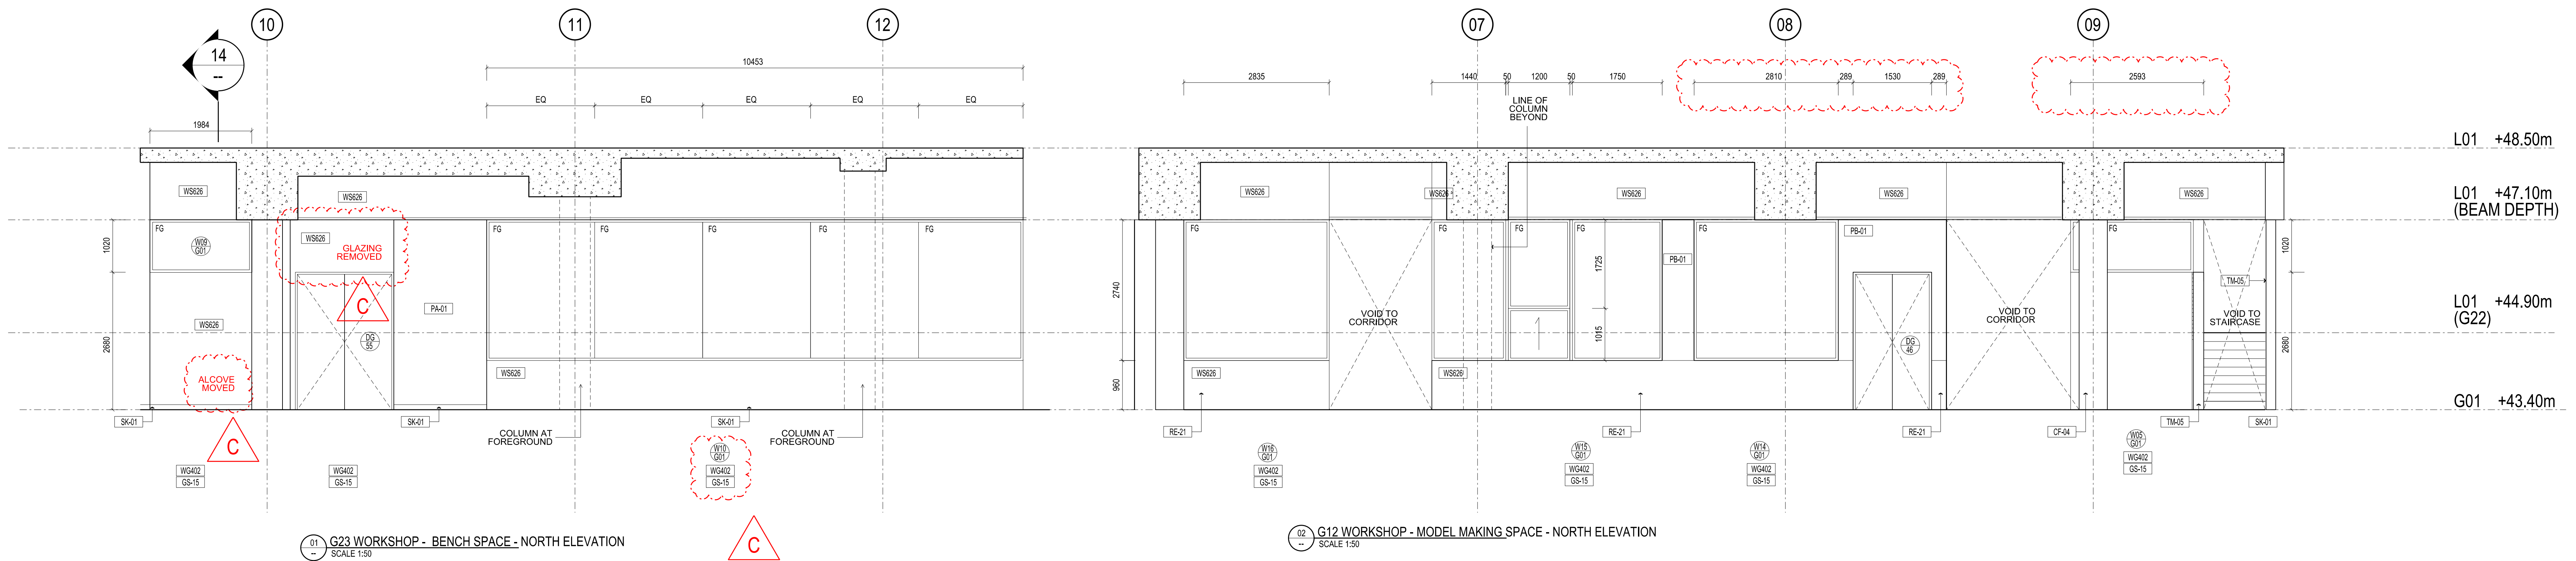

01 G23 WORKSHOP - BENCH SPACE - NORTH ELEVATION  
SCALE 1:50


02 G12 WORKSHOP - MODEL MAKING SPACE - NORTH ELEVATION  
SCALE 1:50

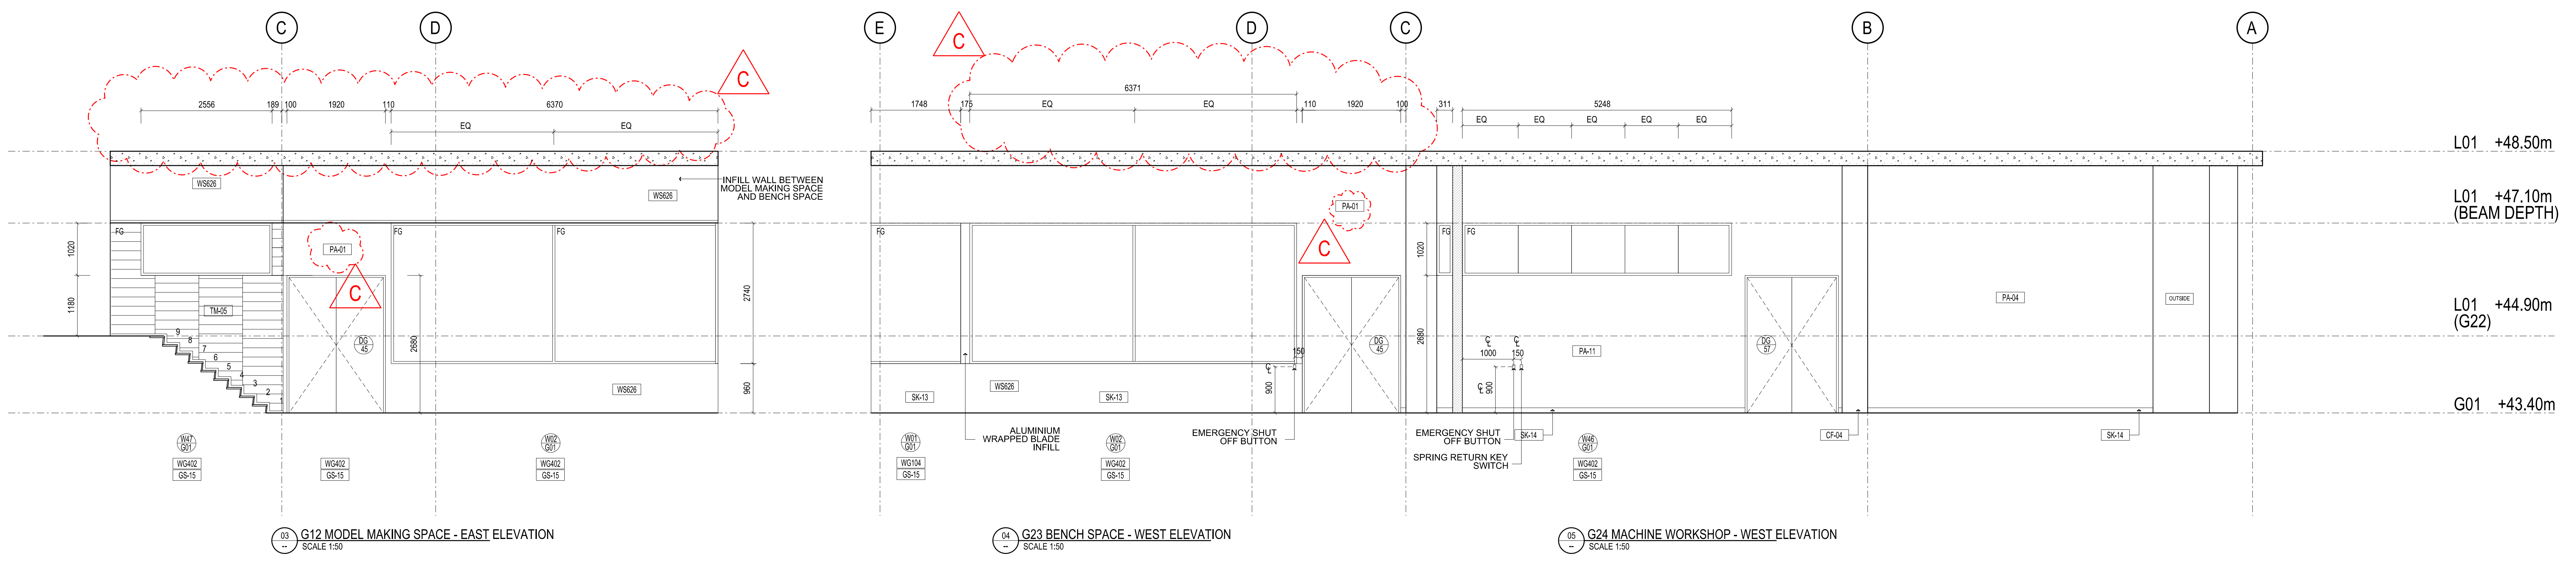

03 G12 MODEL MAKING SPACE - EAST ELEVATION  
SCALE 1:50

04 G23 BENCH SPACE - WEST ELEVATION  
SCALE 1:50

05 G24 MACHINE WORKSHOP - WEST ELEVATION  
SCALE 1:50

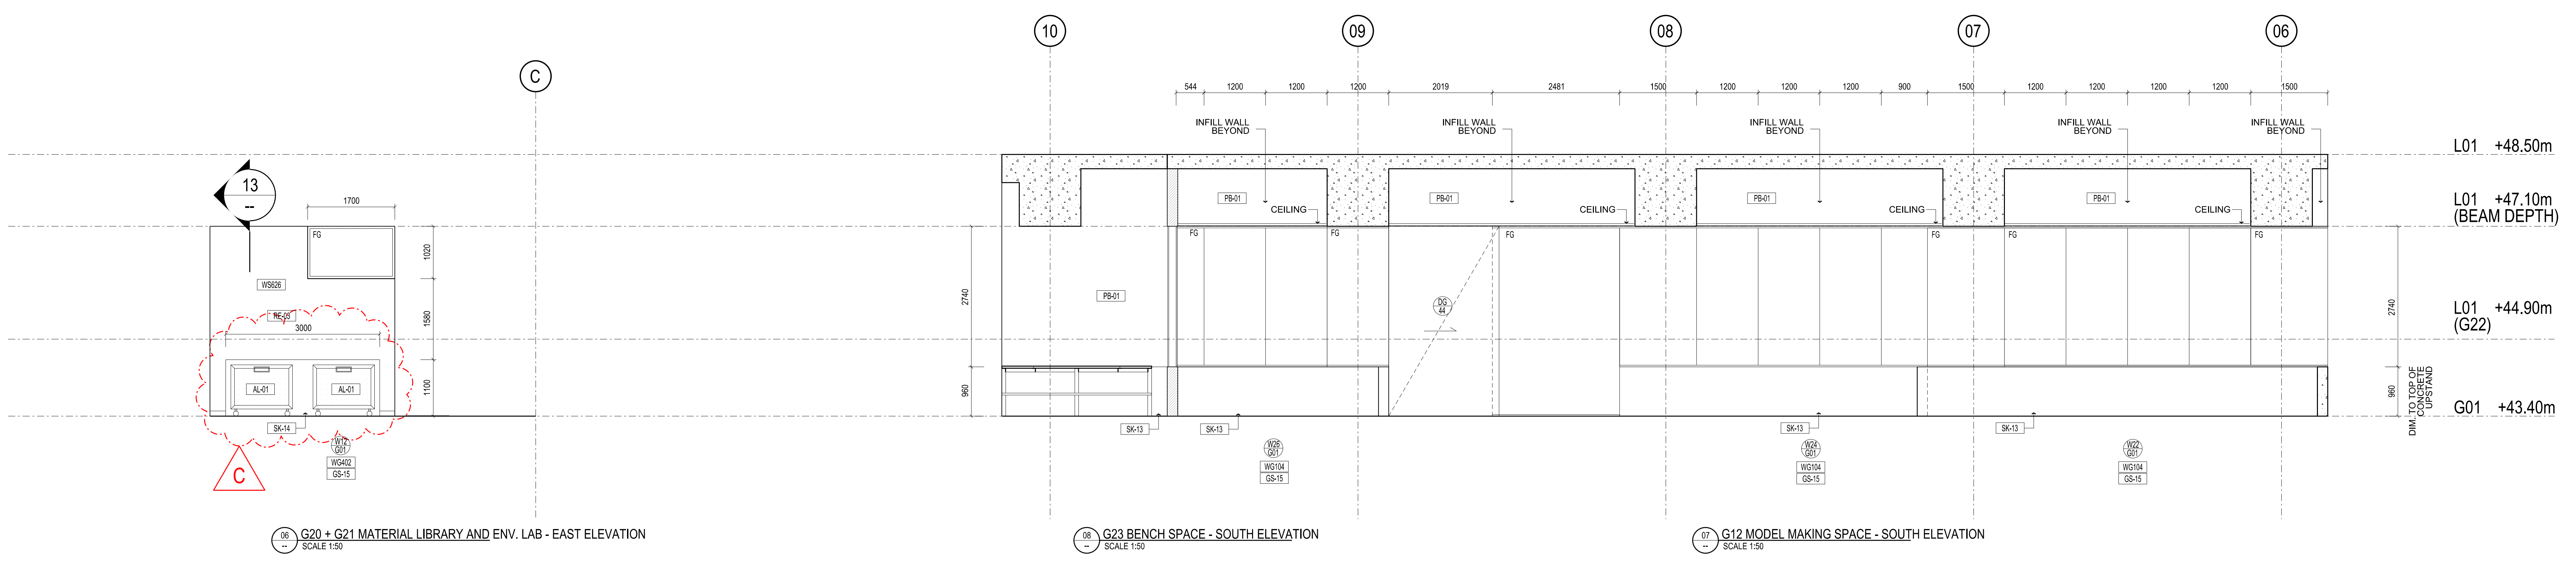

06 G20 + G21 MATERIAL LIBRARY AND ENV. LAB - EAST ELEVATION  
SCALE 1:50

08 G23 BENCH SPACE - SOUTH ELEVATION  
SCALE 1:50

07 G12 MODEL MAKING SPACE - SOUTH ELEVATION  
SCALE 1:50

Rev	Issue	Revision Description	Amd	Date
C	SG	WINDOW NO. AND DIMS UPDATE AS CLOUDED	--	05.02.14
B	SG	ISSUE FOR CONSTRUCTION - UPDATE	--	14.11.13
A	SG	ISSUE FOR CONSTRUCTION	--	13.11.12



**NADAAA**  
 NADAAA  
 1320 Washington Street No.2 Boston Massachusetts 02118 USA  
 Telephone +1 617 442 8232 Facsimile +1 688 442 1417 Email nadaaa@nadaaa.com

**John Wardle Architects**  
 25 Rokeby Street, Collingwood, Victoria 3066 Australia  
 Tel : +61 3 8662 0400 www.johnwardlearchitects.com  
 © 2014 John Wardle Architects ABN 83 006 814 268

Client **University of Melbourne Parkville Campus**  
 Project **Faculty of Architecture Building and Planning**

Title **INTERNAL ELEVATIONS G01 WORKSHOP 1**

Project No.	<b>0913</b>	Scale	1:50 @ A0 1:100 @ A2
Drawing No.	<b>AR7109</b>	Revision	<b>C</b>

Date NOV 2013 Drawn - Co-Ord - Check -

FILENAME - SFILES  
**FOR CONSTRUCTION**