



CONTRACTORS SHALL VERIFY DIMENSIONS BEFORE ANY JOB COMMENCES. ALL SHOP DRAWINGS SHALL BE SUBMITTED TO THE SUPERINTENDENT AND MANUFACTURERS SHALL NOT COMMENCE FROM THE RETURN OF APPROVED SHOP DRAWINGS ISSUED BY THE CONSULTANT. DIMENSIONS SHALL TAKE PRECEDENCE OVER SCALES. THIS DRAWING SHALL BE READ IN CONJUNCTION WITH ALL RELEVANT CONTRACT SPECIFICATIONS AND DRAWINGS COPYRIGHT OF THIS DRAWING IS VESTED IN WARDLE.

General Notes
REFER TO WINDOW SCHEDULE FOR FURTHER DETAILS

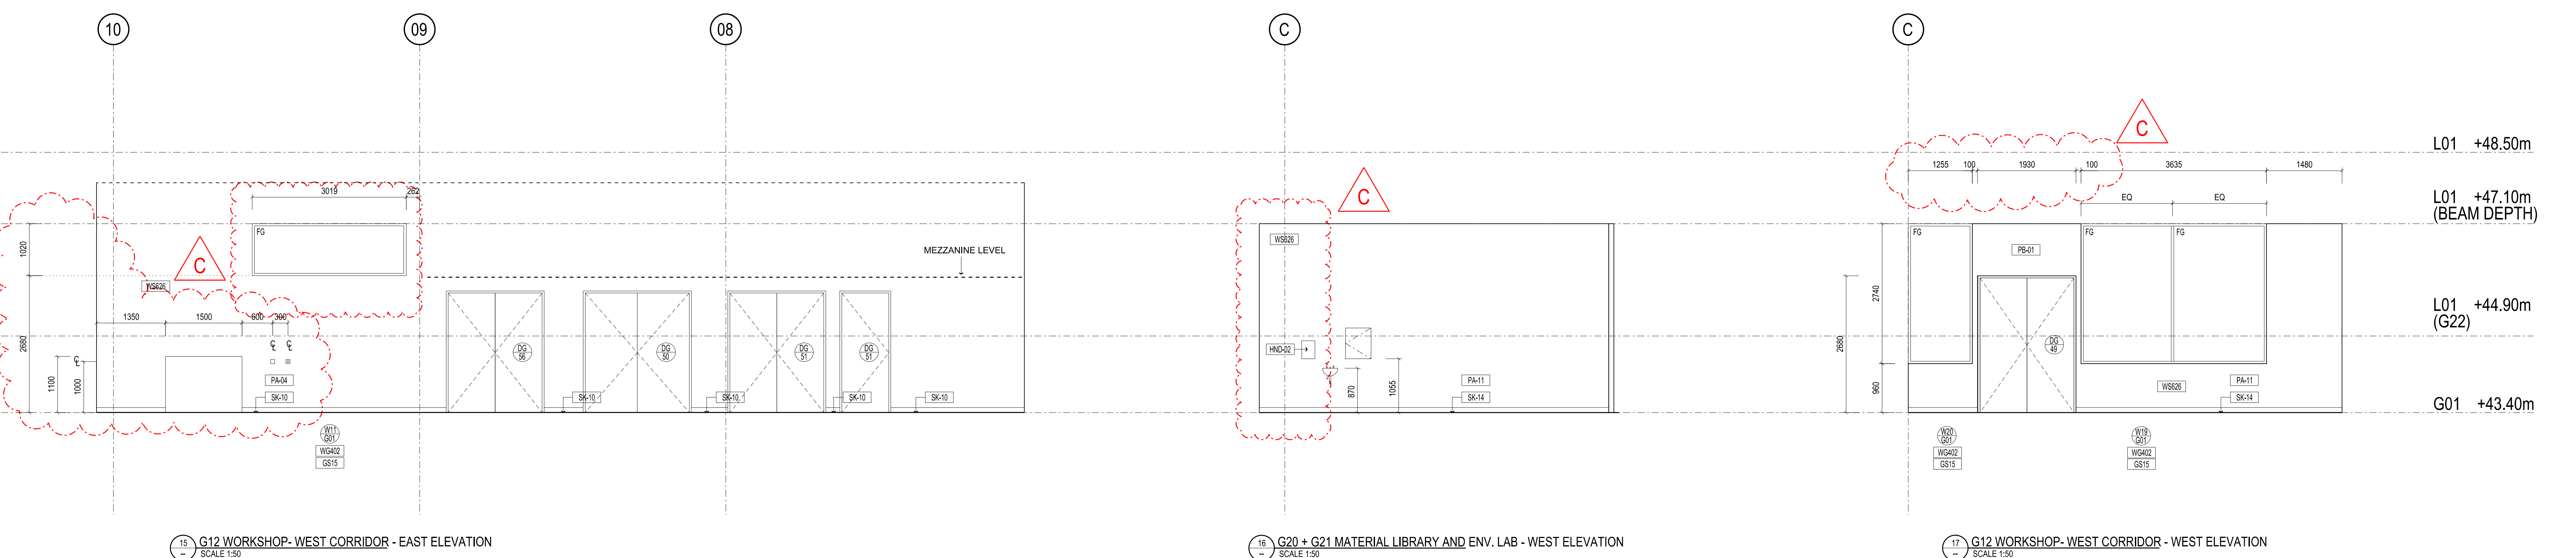

Rev	Issue	Revision Description	Amd	Date
C	SG	UPDATES AS CLOUDED	-	05.02.14
B	SG	ISSUE FOR CONSTRUCTION - UPDATE	-	14.11.13
A	SG	ISSUE FOR CONSTRUCTION	-	13.11.13

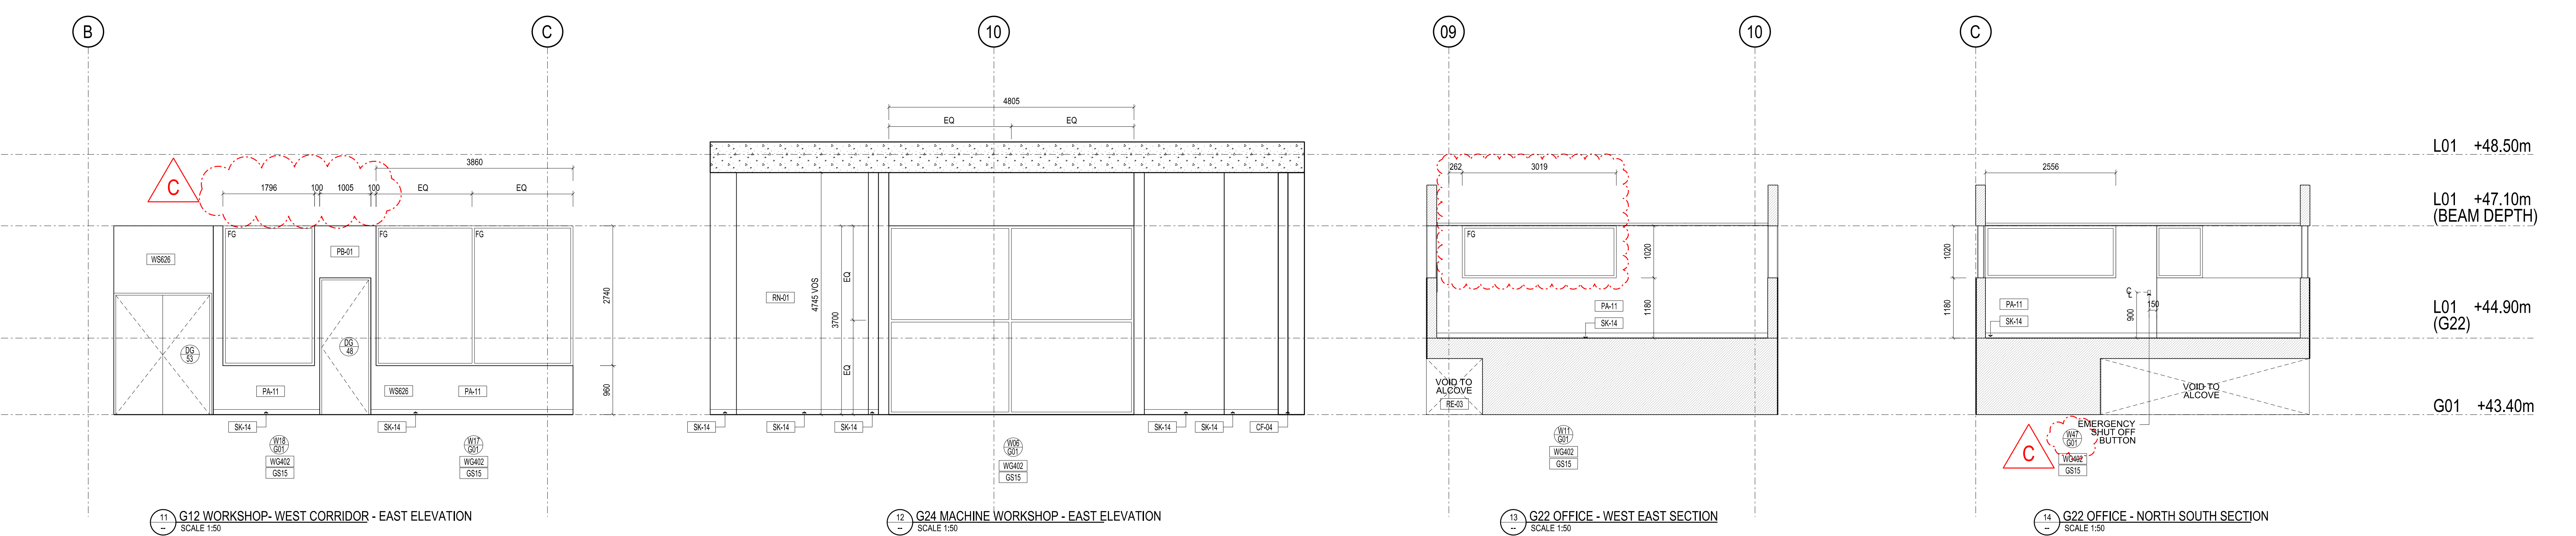

Client: University of Melbourne
Parkville Campus

Project: Faculty of Architecture
Building and Planning

Title: INTERNAL ELEVATIONS
G01 WORKSHOP 2

Project No.	0913	Scale	1:50 @ A0 1:100 @ A2
Drawing No.	AR 7110	Revision	C

Date: NOV 2013 Drawn: Co-Ord: Check:

FILENAME - SFILES

FOR CONSTRUCTION