

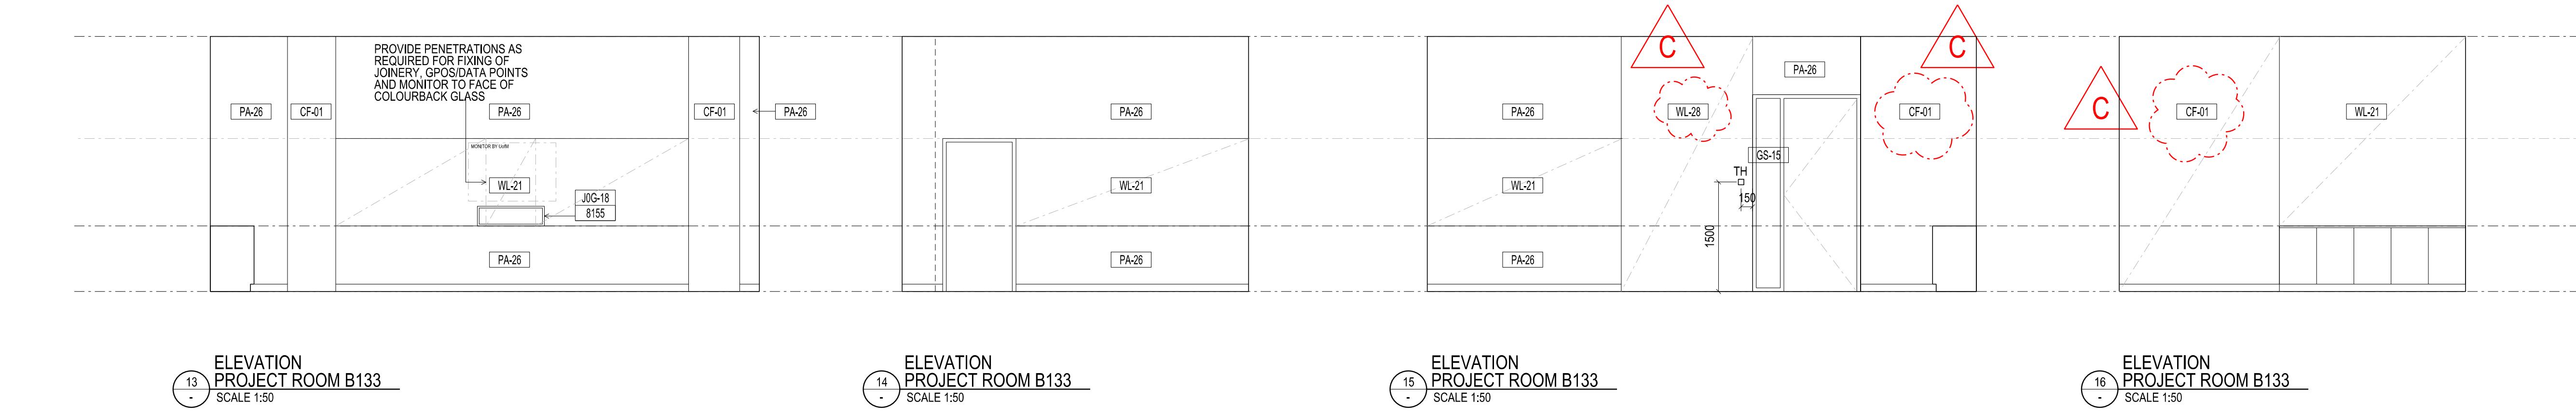


CONTRACTORS SHALL VERIFY JOB DIMENSIONS BEFORE ANY JOB COMMENCES. ALL SHOP DRAWINGS SHALL BE SUBMITTED TO THE SUPERINTENDENT AND MANUFACTURER SHALL NOT COMMENCE PRIOR TO THE RETURN OF FRAMED SHOP DRAWINGS SIGNED BY THE CONSULTANT. DIMENSIONS SHALL TAKE PRECEDENCE OVER SCALE. THIS DRAWING SHOULD BE READ IN CONJUNCTION WITH ALL RELEVANT CONTRACT SPECIFICATIONS AND DRAWINGS COPYRIGHT OF THIS DRAWING IS VESTED IN NADAAA.

General Notes

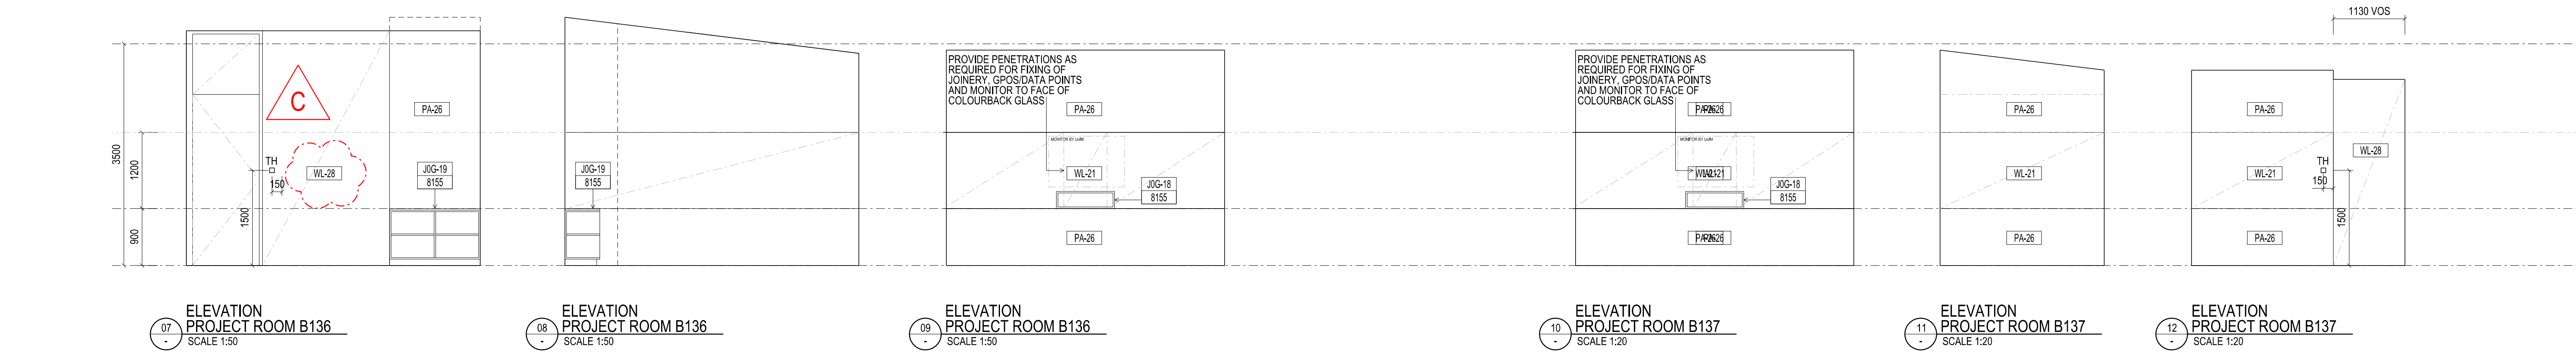

Rev	Issue	Revision Description	Amd	Date
C	SG	FINISHES TAGS AMENDED	-	09.01.14
B	SG	THERMOSTAT LOCATIONS ADDED	-	18.11.13
A	SG	ISSUED FOR CONSTRUCTION	-	13.11.13

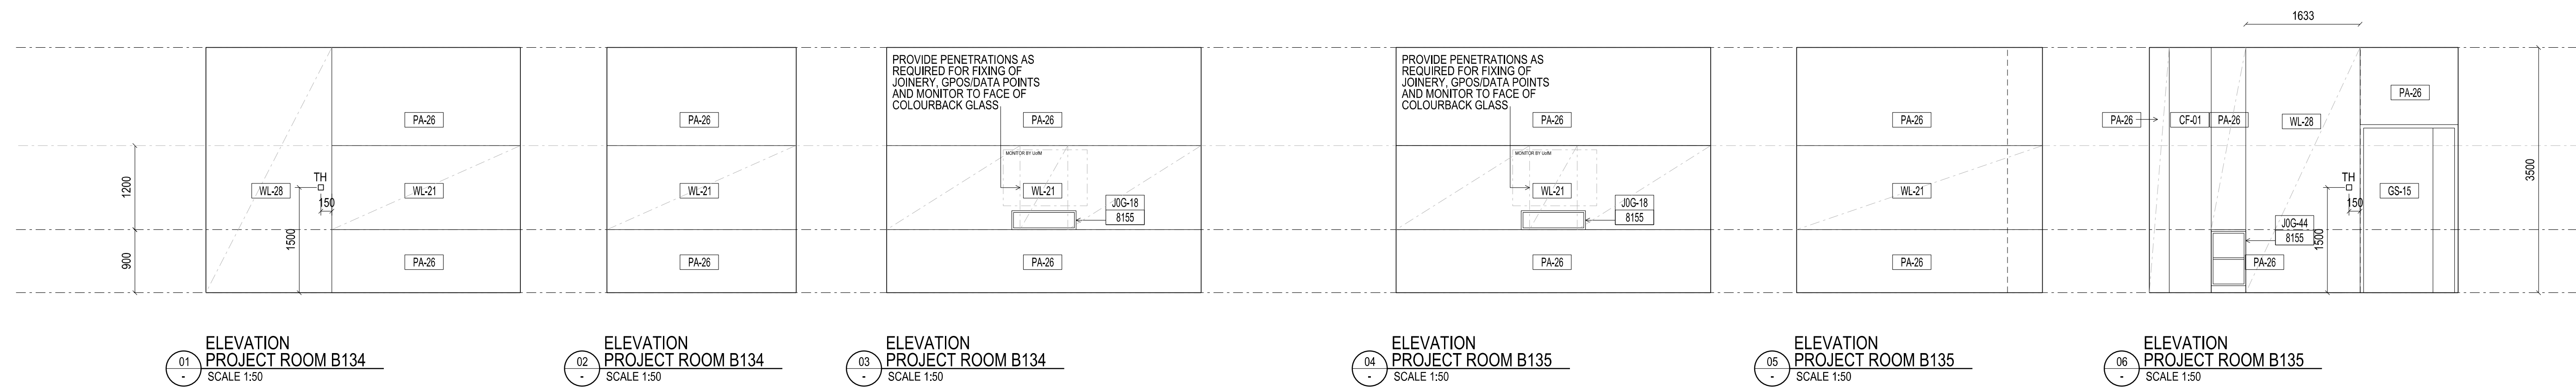

NADAAA
 NADAAA
 1920 Washington Street No.2 Boston Massachusetts 02118 USA
 Telephone +1 617 442 6232 Facsimile +1 988 442 1417 Email nad@nadaaa.com

John Wardle Architects
 25 Rokeby Street, Collingwood, Victoria 3066 Australia
 Tel: +61 3 8962 0400 www.johnwardlearchitects.com
 © 2012 John Wardle Architects ABN 83 006 814 268

Client: University of Melbourne
 Parkville Campus
 Project: Faculty of Architecture Building and Planning
 Title: INTERIOR ELEVATIONS B01 LIBRARY PROJECT ROOMS

Project No.	0913	Scale	1:50 @ A0
Drawing No.	AR7113	Revision	C
Date	Dec 2011	Drawn	KW
Co-Ord	SG	Check	JA

FILENAME - SFILES
FOR CONSTRUCTION