




01 ELEVATION - DEAN'S RECEPTION 103
SCALE 1:50

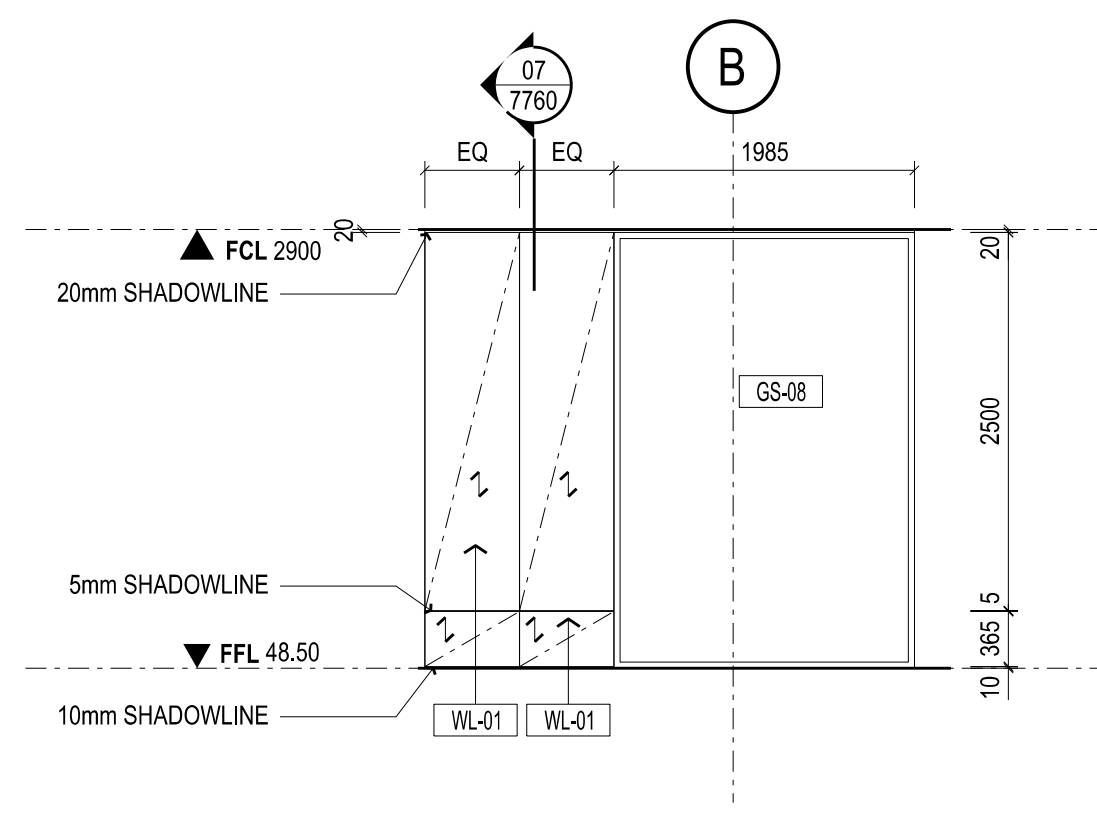


02 ELEVATION - DEAN'S AREA 106
SCALE 1:50

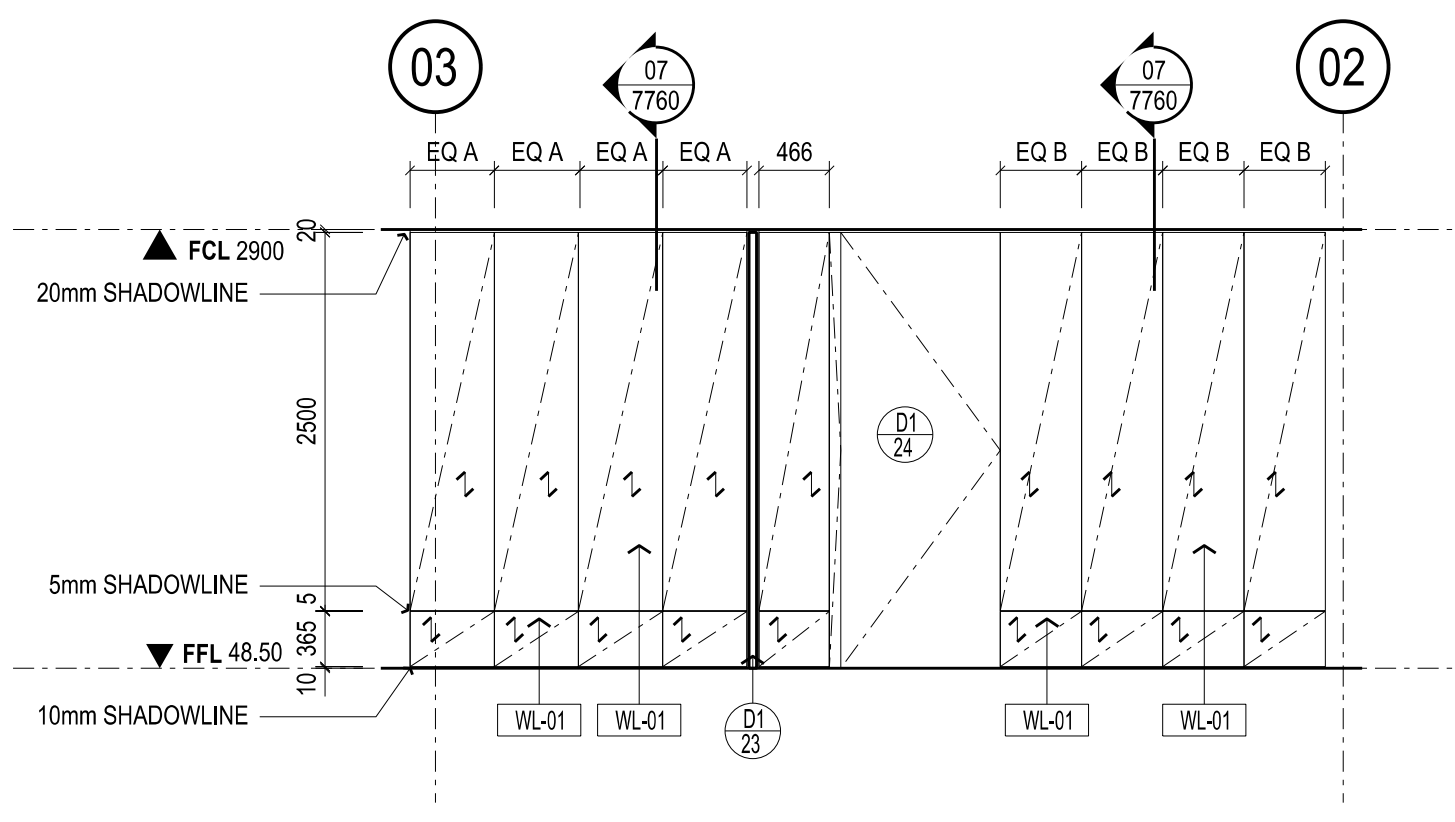


03 ELEVATION - DEAN'S AREA 110 & 108
SCALE 1:50

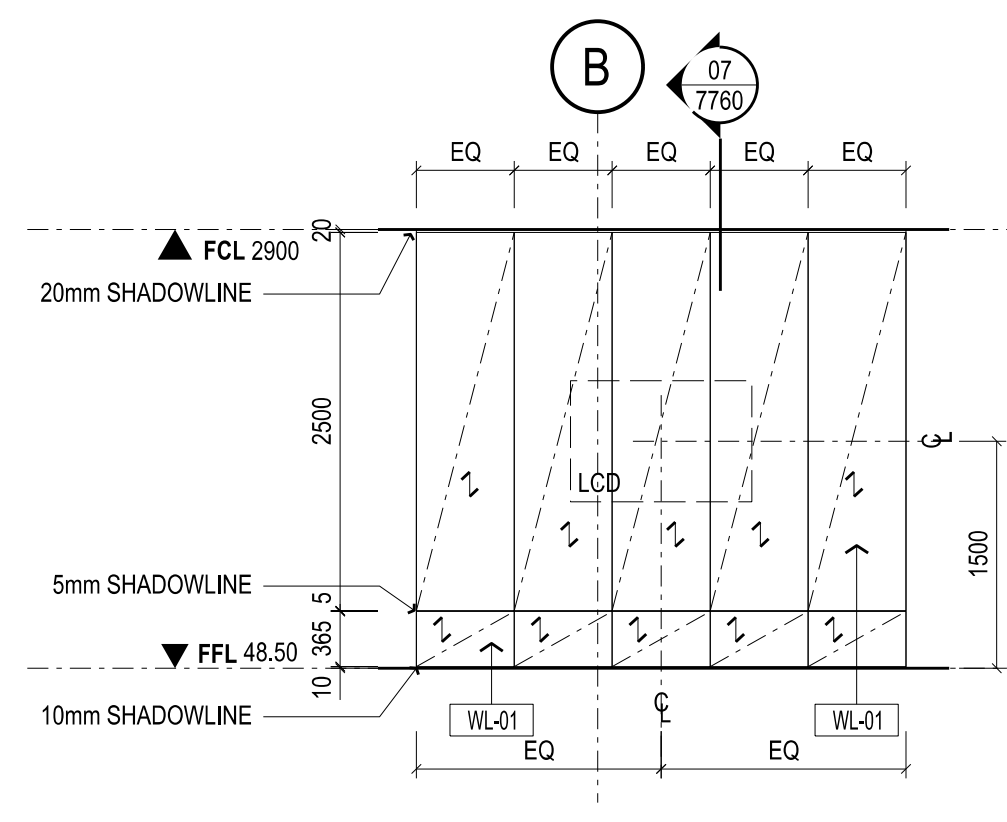


04 ELEVATION - DEAN'S RECEPTION
SCALE 1:50

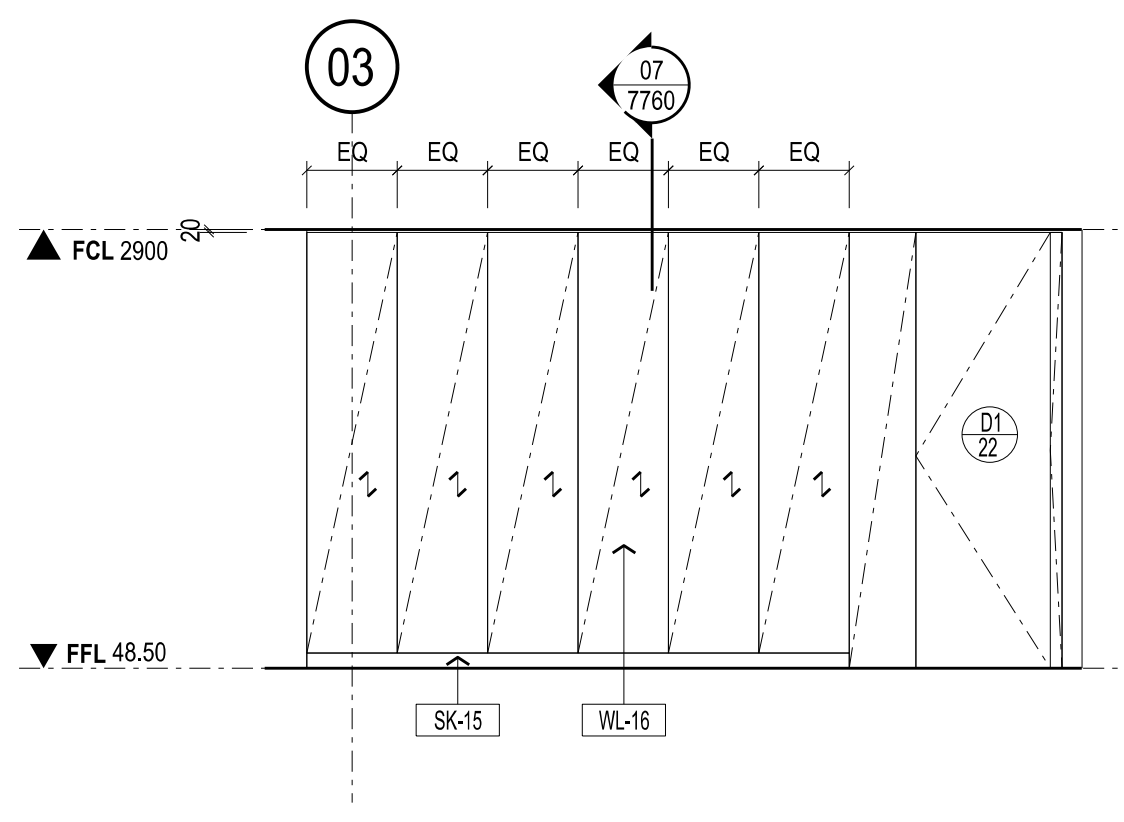


05 ELEVATION - DEAN'S RECEPTION 103
SCALE 1:50

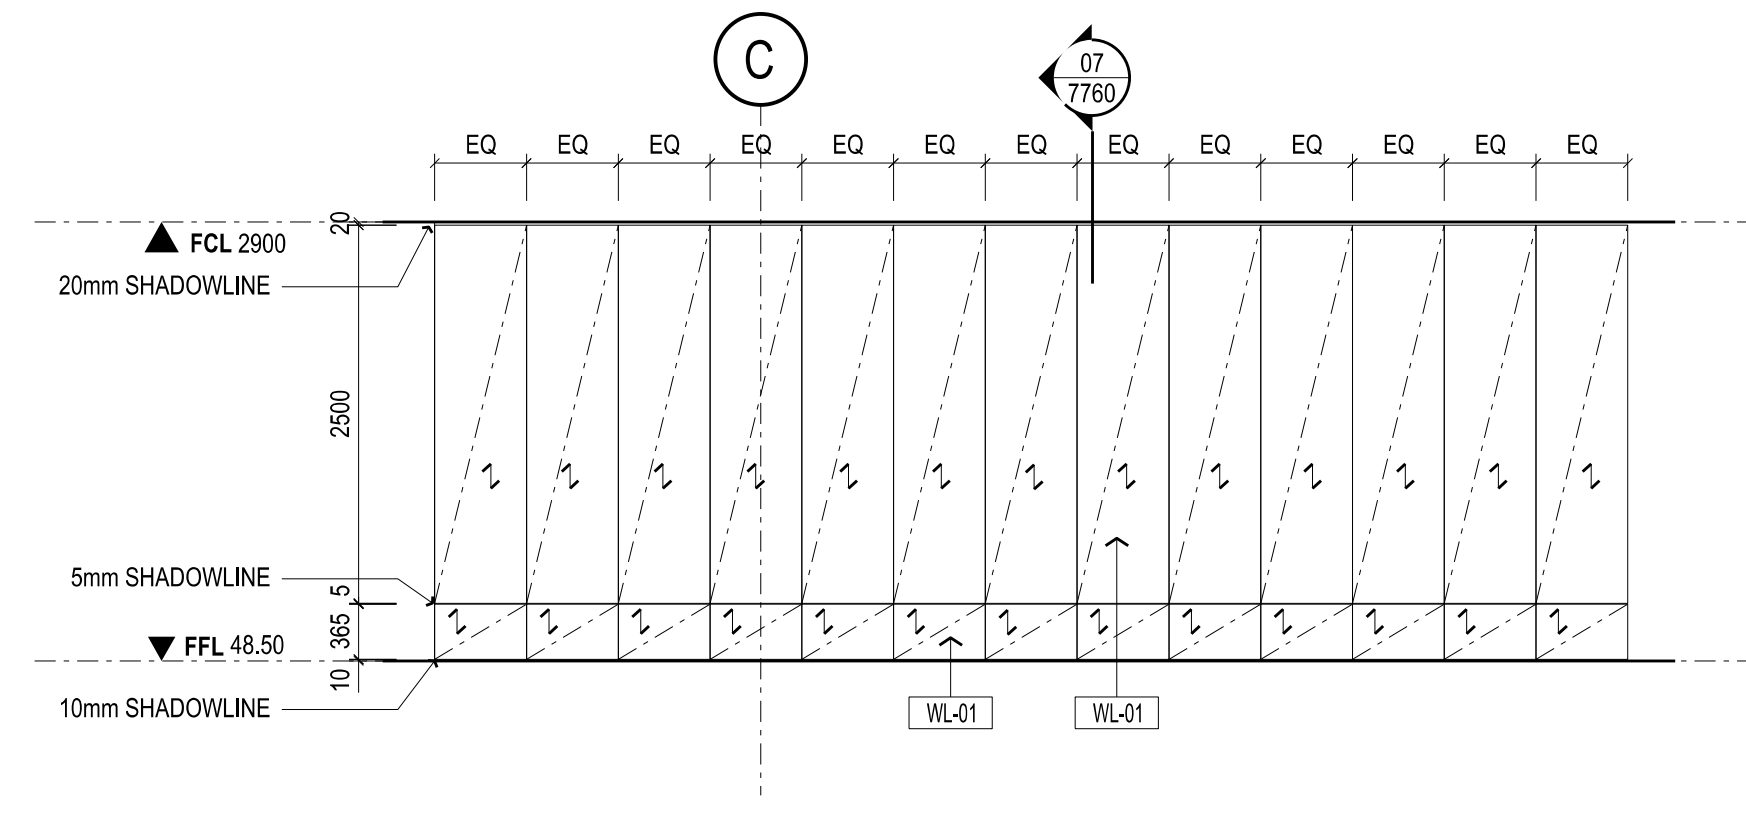


06 ELEVATION - BOARDROOM 102
SCALE 1:50

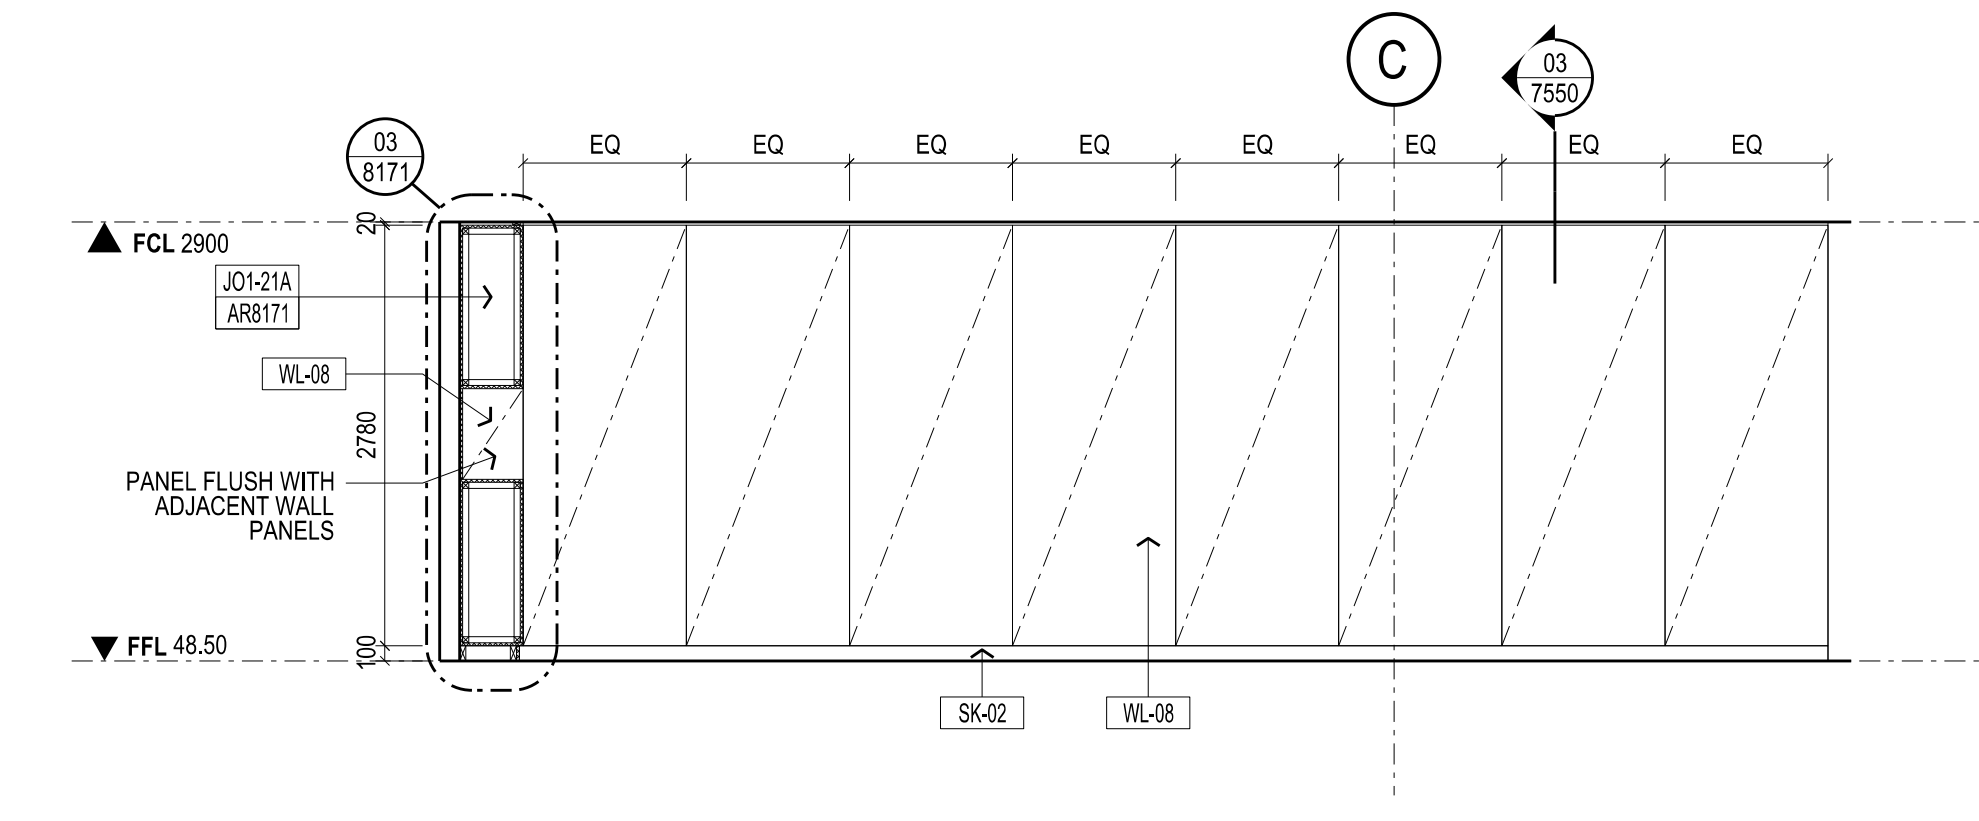

07 ELEVATION - BOARDROOM 102
SCALE 1:50

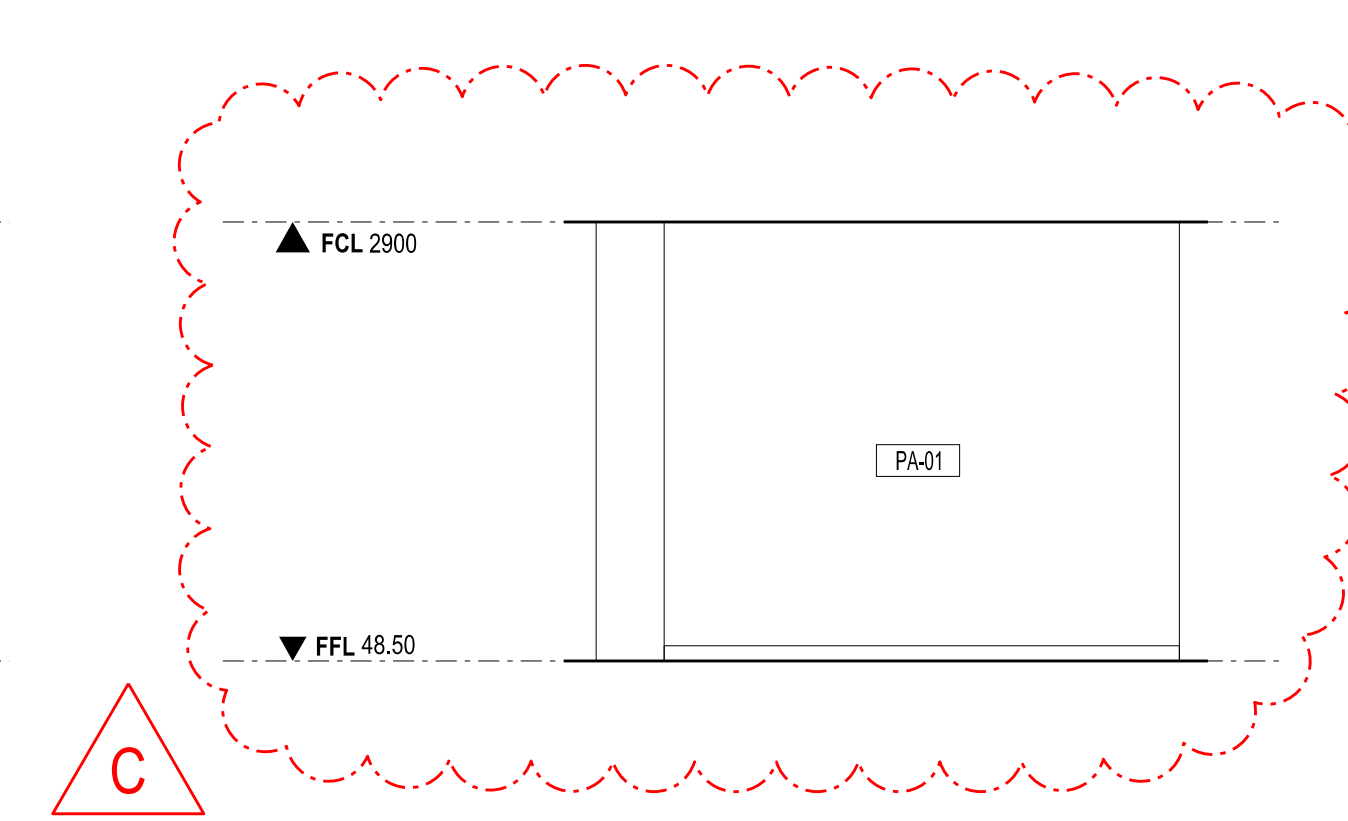

08 ELEVATION - DEAN'S AREA 108
SCALE 1:50

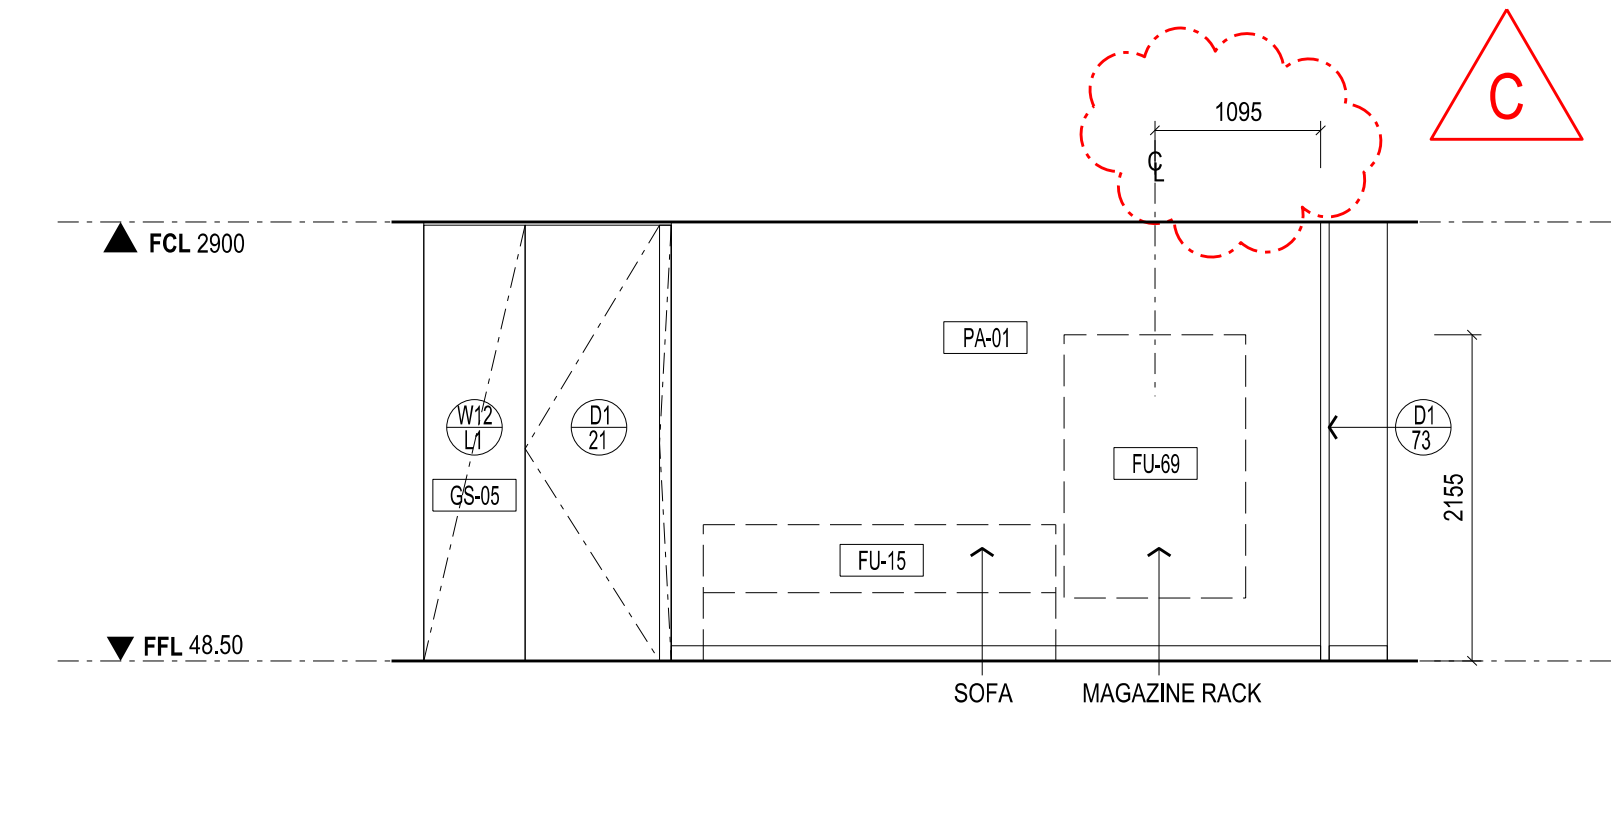

09 ELEVATION - DEAN'S RECEPTION
SCALE 1:50

THIS DRAWING IS AN UNCONTROLLED COPY UNLESS STAMPED OTHERWISE

CONTRACTORS SHALL VERIFY JOB DIMENSIONS BEFORE ANY JOB COMMENCES. ALL SHOP DRAWINGS SHALL BE SUBMITTED TO THE SUPERINTENDENT AND MANUFACTURERS SHALL NOT COMMENCE FROM THE RETURN OF DRAWINGS UNLESS BY THE CONSULTANT. DIMENSIONS SHALL TAKE PRECEDENCE OVER SCALES. THIS DRAWING SHOULD BE READ IN CONJUNCTION WITH ALL RELEVANT CONTRACT SPECIFICATIONS AND DRAWINGS COPYRIGHT OF THIS DRAWING IS VESTED IN NADAAA.

General Notes

ALL HORIZONTAL DIMENSIONS SHOWN IN ELEVATION ARE NOMINAL AND SHOULD BE READ IN CONJUNCTION WITH OVERALL PLAN SET-OUT OF INTERNAL PARTITION AND ADJACENT WALL LININGS.

C	SG	UPDATES AS CLOUED	-	25.02.14
B	KW	UPDATES AS CLOUED	-	31.01.14
A	SG	REVISIONS AS REQUESTED BY CLIENT	-	11.12.13
08	YA	TENDER ADDENDUM 04	-	08.10.12
07	SG	100% CD - TENDER ISSUE	-	07.09.12
06	SG	90% CD ISSUE	-	10.06.12
05	JC	50% CD ISSUE	-	01.06.12
04	JC	25% CD ISSUE	-	20.04.12
03	JC	FINAL DD ISSUE	-	24.02.12
02	JC	DESIGN DEVELOPMENT ISSUE	-	20.07.12
01	JC	DESIGN DEVELOPMENT ISSUE	-	22.12.11



NADAAA
 NADAAA
 1520 Washington Street No.2 Boston Massachusetts 02118 USA
 Telephone +1 617 442 8232 Facsimile +1 688 442 1417 Email nadaa@nadaaa.com

John Wardle Architects
 25 Rokeby Street, Collingwood, Victoria 3066 Australia
 Tel : +61 3 8662 0400 www.johnwardlearchitects.com
 © 2014 John Wardle Architects ABN 83 006 814 268

Client **University of Melbourne Parkville Campus**

Project **Faculty of Architecture Building and Planning**

Title **INTERIOR ELEVATIONS LEVEL 01**

Project No.	0913	Scale	1:50 @ A0
Drawing No.	AR7130	Revision	C
Date	May 2011	Dwn	-
Co-Ord	-	Chk	-

FOR CONSTRUCTION