


THIS DRAWING IS AN UNCONTROLLED COPY UNLESS STAMPED OTHERWISE


CONTRACTORS SHALL VERIFY JOB DIMENSIONS BEFORE ANY JOB COMMENCES. ALL SHOP DRAWINGS SHALL BE SUBMITTED TO THE SUPERINTENDENT AND MANUFACTURE SHALL NOT COMMENCE PRIOR TO THE RETURN OF DIMENSIONED SHOP DRAWINGS ISSUED BY THE CONSULTANT. FINISHED DIMENSIONS SHALL TAKE PRECEDENCE OVER SCALED. THIS DRAWING SHOULD BE READ IN CONJUNCTION WITH ALL RELEVANT CONTRACT SPECIFICATIONS AND DRAWINGS COPYRIGHT OF THIS DRAWING IS VESTED IN WARDLE

General Notes

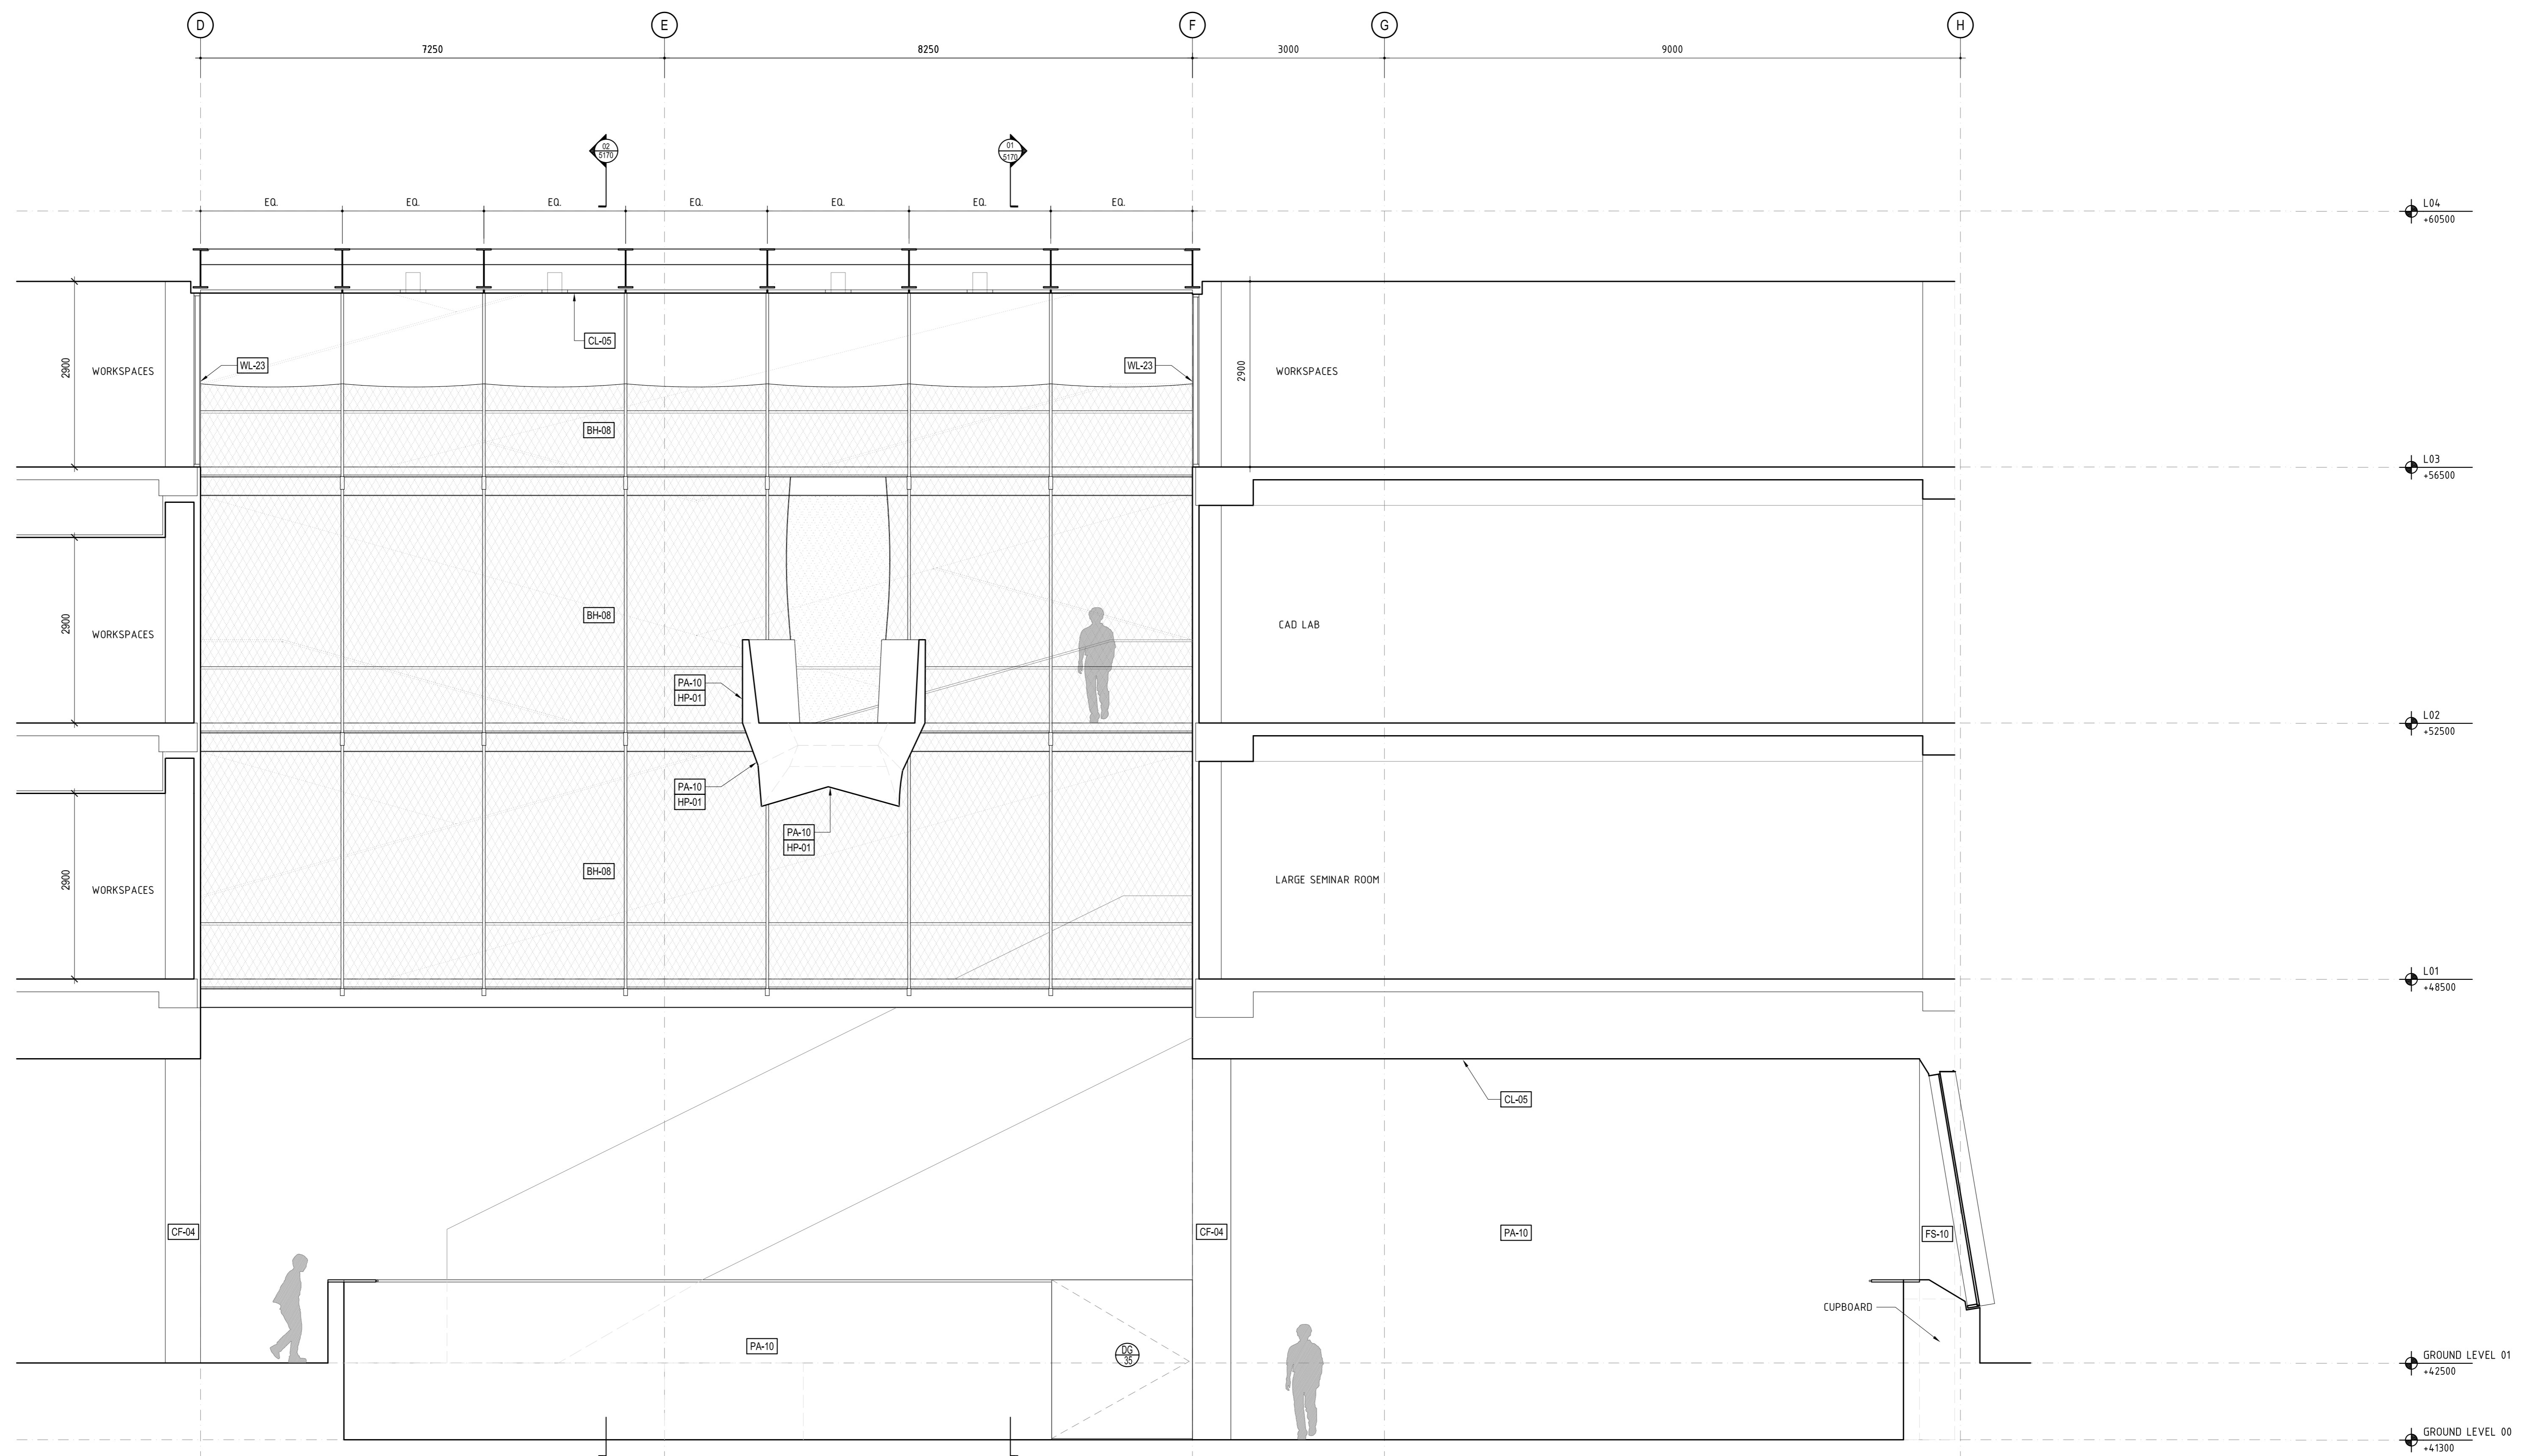

01 LARGE EXHIBITION (G42) - EAST ELEVATION
SCALE 1:50

Rev	Issue	Revision Description	Amd	Date
A	SG	CONSTRUCTION ISSUE	-	19.12.13
05	JC	100% CD - TENDER ISSUE	-	07.09.12
04	JC	95% CD ISSUE	-	10.09.12
03	JC	75% CD ISSUE	-	13.07.12
THIS SHEET WAS PREVIOUSLY ART112				
FINISHES REVIEWED				
02	JC	50% CD ISSUE	-	01.06.12
01	JC	25% CD ISSUE	-	20.04.12

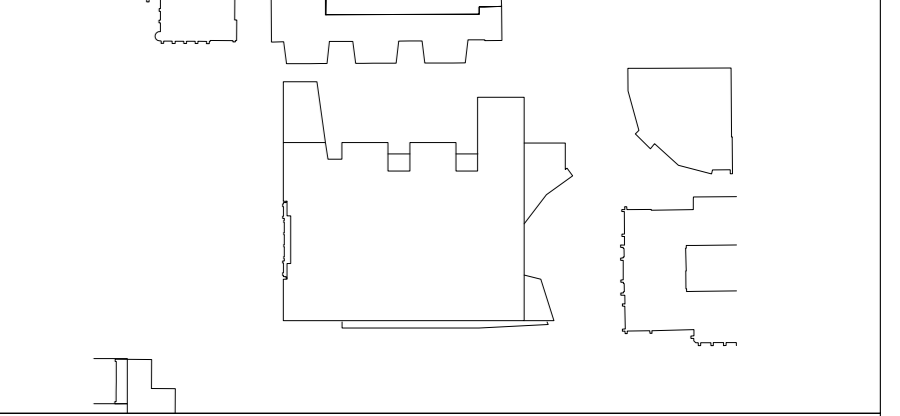

NADAAA

NADAAA
1920 Washington
Street No.2
Boston
Massachusetts
02118 USA

Telephone
+1 617 442 6232
Facsimile
+1 688 442 1417
Email
nadai@nadaaa.com

John Wardle Architects

© 2011 John Wardle Architects
Level 10, 180 Russell Street, Melbourne Victoria 3000 Australia
Tel : +613 9654 8700 www.johnwardlearchitects.com

Client **University of Melbourne
Parkville Campus**

Project **Faculty of Architecture
Building and Planning**

Title **G01
INTERIOR ELEVATIONS**

Project No.	0913	Scale	1:50 @ A0 1:100 @ A2
Drawing No.	AR7141	Revision	A

Date DEC 2013 Dwn - Co-Ord - Chk -

FILENAME: *****

FOR CONSTRUCTION