


CONSTRUCTION SHALL BE RESPONSIBLE FOR OBTAINING ALL NECESSARY PERMITS AND CONFORMANCE WITH ALL APPLICABLE REGULATIONS AND STANDARDS. THE CLIENT SHALL BE RESPONSIBLE FOR OBTAINING ALL NECESSARY PERMITS AND CONFORMANCE WITH ALL APPLICABLE REGULATIONS AND STANDARDS. THE CLIENT SHALL BE RESPONSIBLE FOR OBTAINING ALL NECESSARY PERMITS AND CONFORMANCE WITH ALL APPLICABLE REGULATIONS AND STANDARDS.

General Notes

Rev	Number	Description	Date	By	Check
1	01	CONSTRUCTION ISSUE	13/11/13		
2	02	VALUE ENGINEERING ISSUE	28/03/13		
3	03	100% CD - TENDER ISSUE	07/04/13		
4	04	90% CD ISSUE	10/04/13		
5	05	75% CD ISSUE	13/07/13		
6	06	75% CD ISSUE - 20% DISCOUNT	13/07/13		

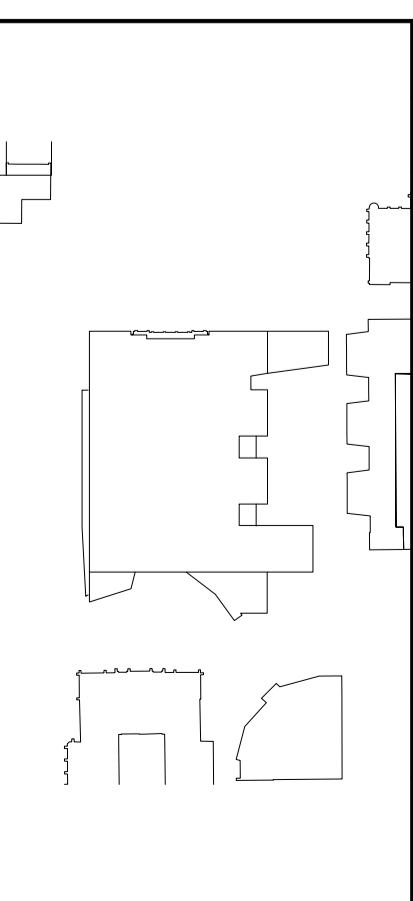

NADAAA

NADAAA
 10/100 RUSSELL STREET
 MELBOURNE VIC 3000 AUSTRALIA
 TEL: +61 3 8624 8700
 WWW.PARKVILLEARCHITECTS.COM

John Wardle Architects

John Wardle Architects
 Level 10, 180 Russell Street, Melbourne, Victoria, 3000 Australia
 Tel: +61 3 8624 8700
 www.parkvillearchitects.com

Client: University of Melbourne
 Parkville Campus
 Project: Faculty of Architecture
 Building and Planning
 Interior & Joinery Elevations

Project No. 0913
 Drawing No. AR7162
 Scale: 1:50
 Revision: A

FOR CONSTRUCTION

