



THIS DRAWING IS AN UNCONTROLLED COPY UNLESS STAMPED OTHERWISE

CONTRACTORS SHALL VERIFY JOB DIMENSIONS BEFORE ANY JOB COMMENCES. ALL SHOP DRAWINGS SHALL BE SUBMITTED TO THE SUPERINTENDENT AND MANUFACTURER. SHALL NOT COMMENCE WORK UNTIL THE RETURN OF UNAMBIGUOUS SHOP DRAWINGS ISSUED BY THE CONSULTANT FIGURED DIMENSIONS SHALL TAKE PRECEDENCE OVER SCALED. THIS DRAWING SHOULD BE READ IN CONJUNCTION WITH ALL RELEVANT CONTRACT SPECIFICATIONS AND DRAWINGS COPYRIGHT OF THIS DRAWING IS VESTED IN WARDLE

General Notes

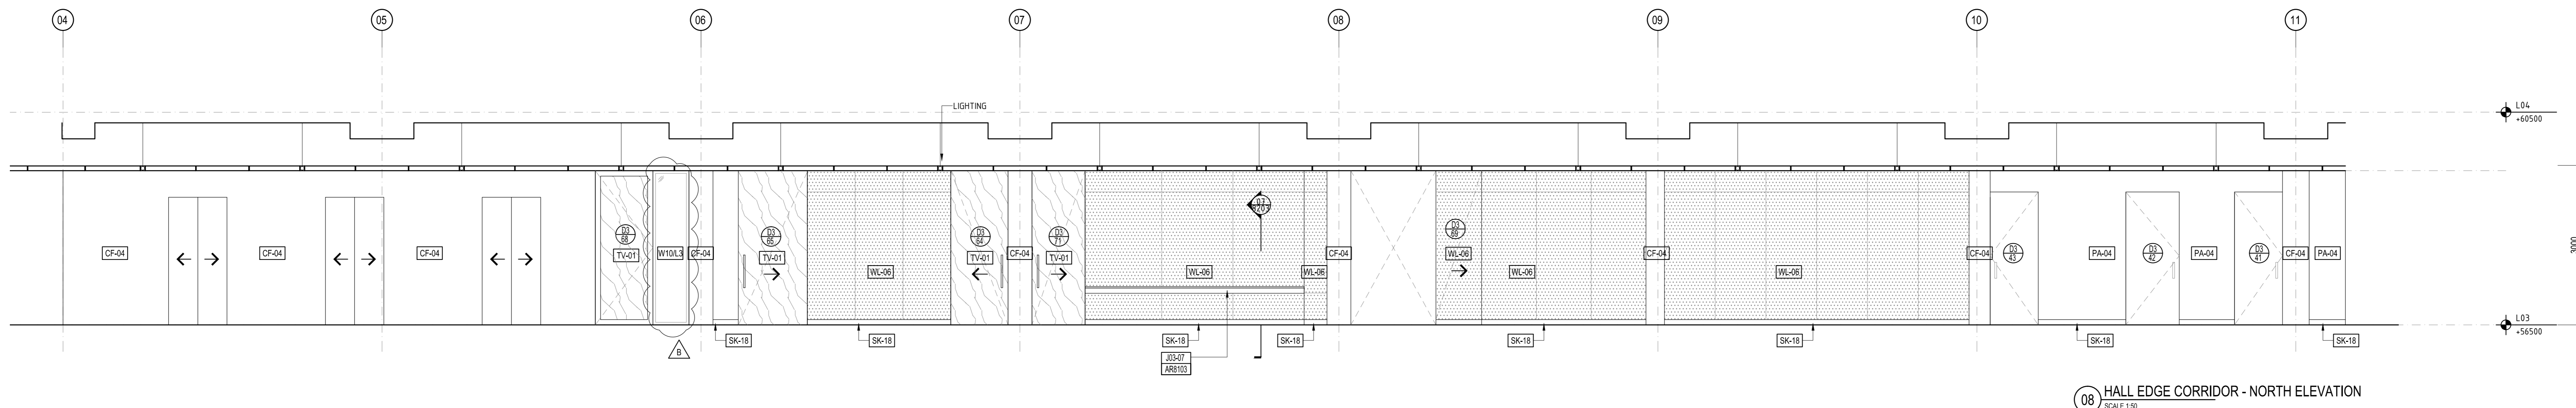


08 HALL EDGE CORRIDOR - NORTH ELEVATION
SCALE 1:50

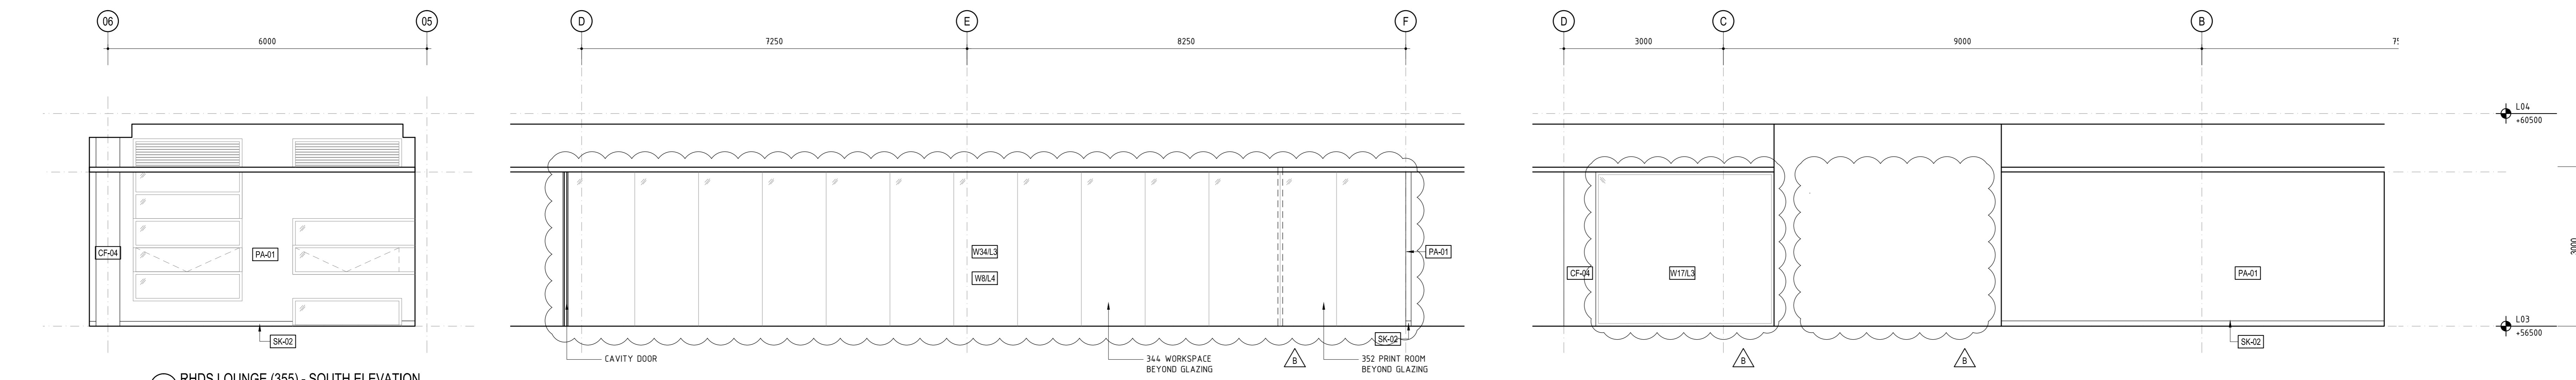

07 RHDS LOUNGE (355) - SOUTH ELEVATION
SCALE 1:50

06 WORKSPACE - EAST ELEVATION
SCALE 1:50


05 EAST LIFT LOBBY - WEST ELEVATION
SCALE 1:50

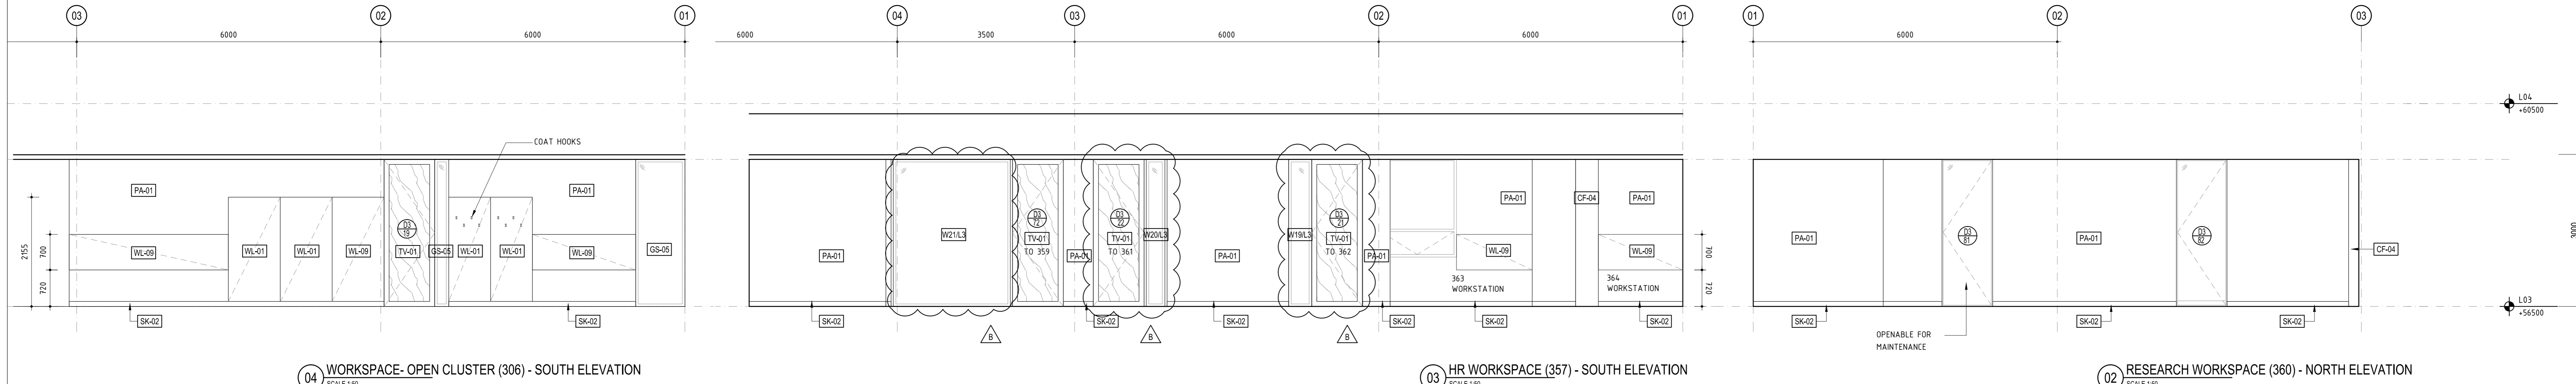

04 WORKSPACE - OPEN CLUSTER (306) - SOUTH ELEVATION
SCALE 1:50


03 HR WORKSPACE (357) - SOUTH ELEVATION
SCALE 1:50

02 RESEARCH WORKSPACE (360) - NORTH ELEVATION
SCALE 1:50

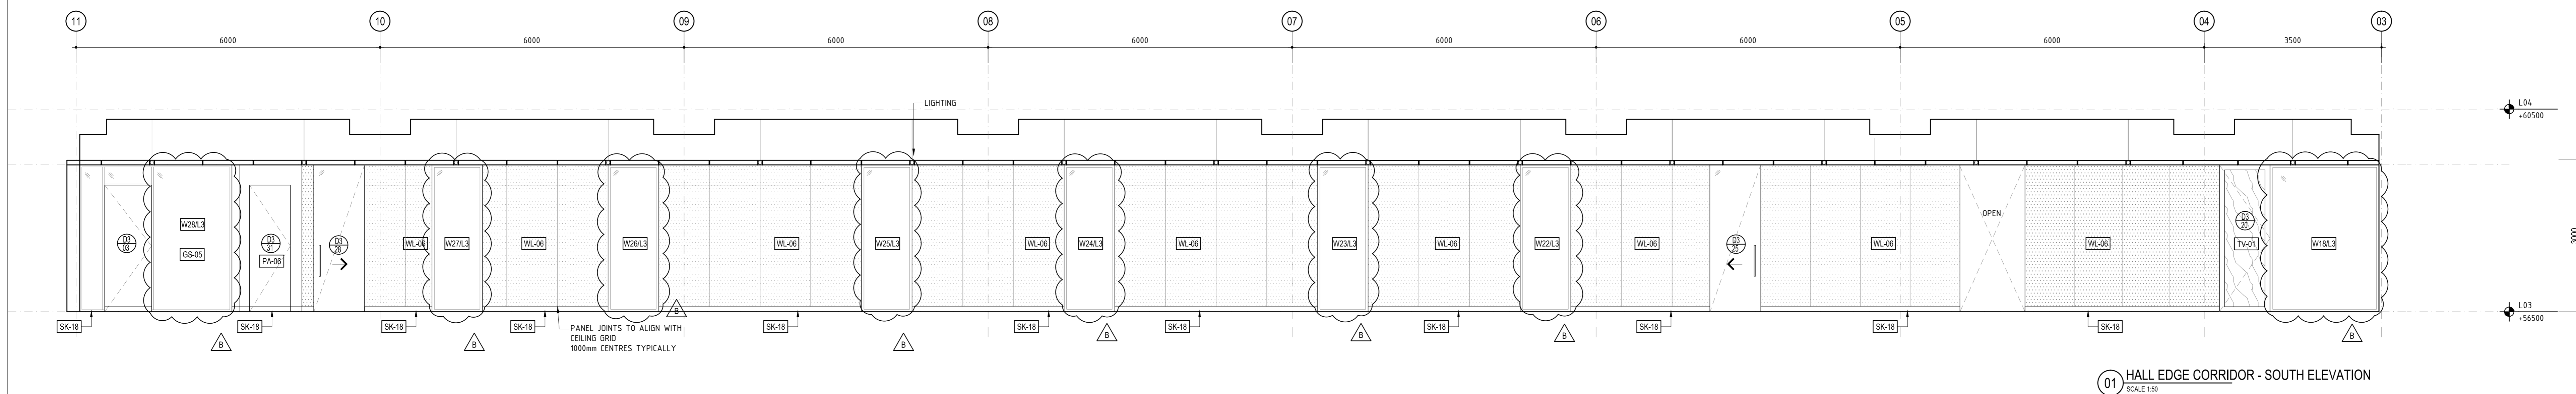

01 HALL EDGE CORRIDOR - SOUTH ELEVATION
SCALE 1:50

Rev	Issue	Revision Description	Amd	Date
B	SG	CONSTRUCTION ISSUE	-	24.01.14
A	SG	CONSTRUCTION ISSUE	-	19.12.13
04	SG	VALUE MANAGEMENT ISSUE	-	28.03.13
03	JC	100% CD - TENDER ISSUE	-	07.09.12
02	JC	90% CD ISSUE	-	10.08.12
01	JC	75% CD ISSUE	-	13.07.12
THIS SHEET WAS PREVIOUSLY AR7140				

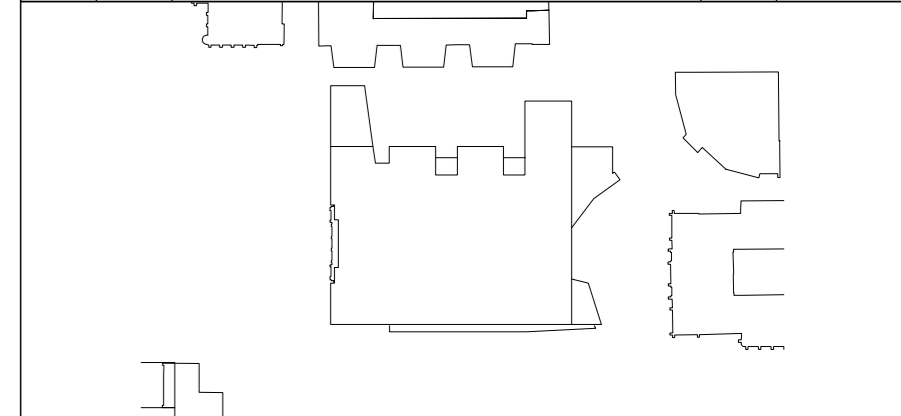

NADAAA

NADAAA
1302 Wellington Street No.2
Boston Massachusetts
02118 USA
Telephone +1 617 442 8332
Facsimile +1 688 442 1417
Email nada@nadaaa.com

John Wardle Architects

© 2011 John Wardle Architects
Level 10, 180 Russell Street, Melbourne Victoria 3000 Australia
Tel: +613 9654 8700 www.johnwardlearchitects.com

Client: University of Melbourne
Parkville Campus

Project: Faculty of Architecture
Building and Planning

Title: L03
INTERIOR & JOINERY ELEVATIONS

Project No.	0913	Scale	1:50
Drawing No.	AR7170	Revision	B
Date	JAN 2014	Dwn	-
Co-Ord	-	Check	-

FILENAME: #####

FOR CONSTRUCTION