

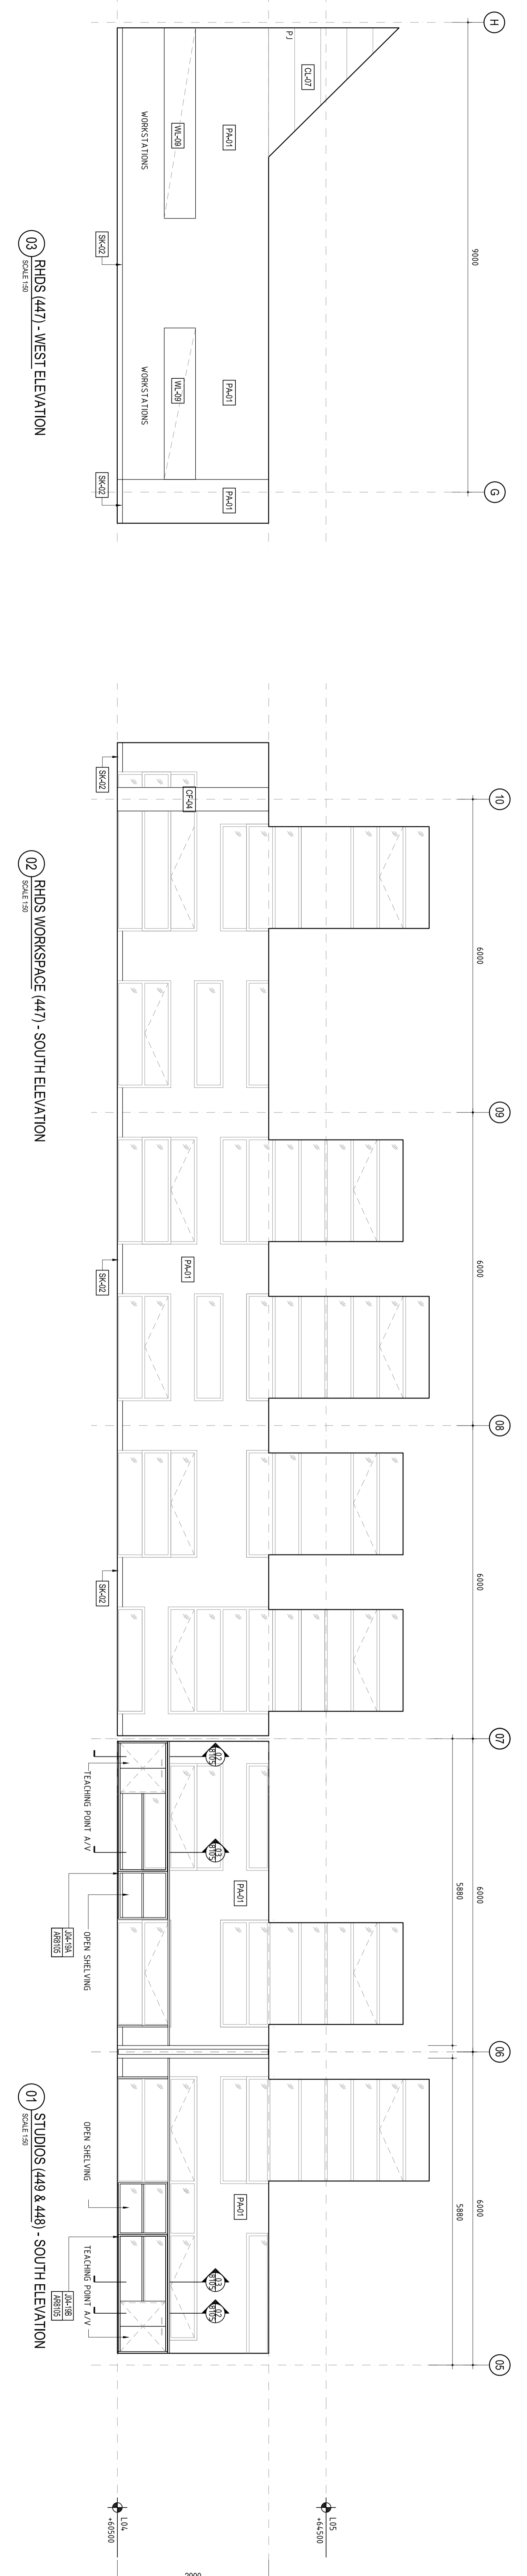
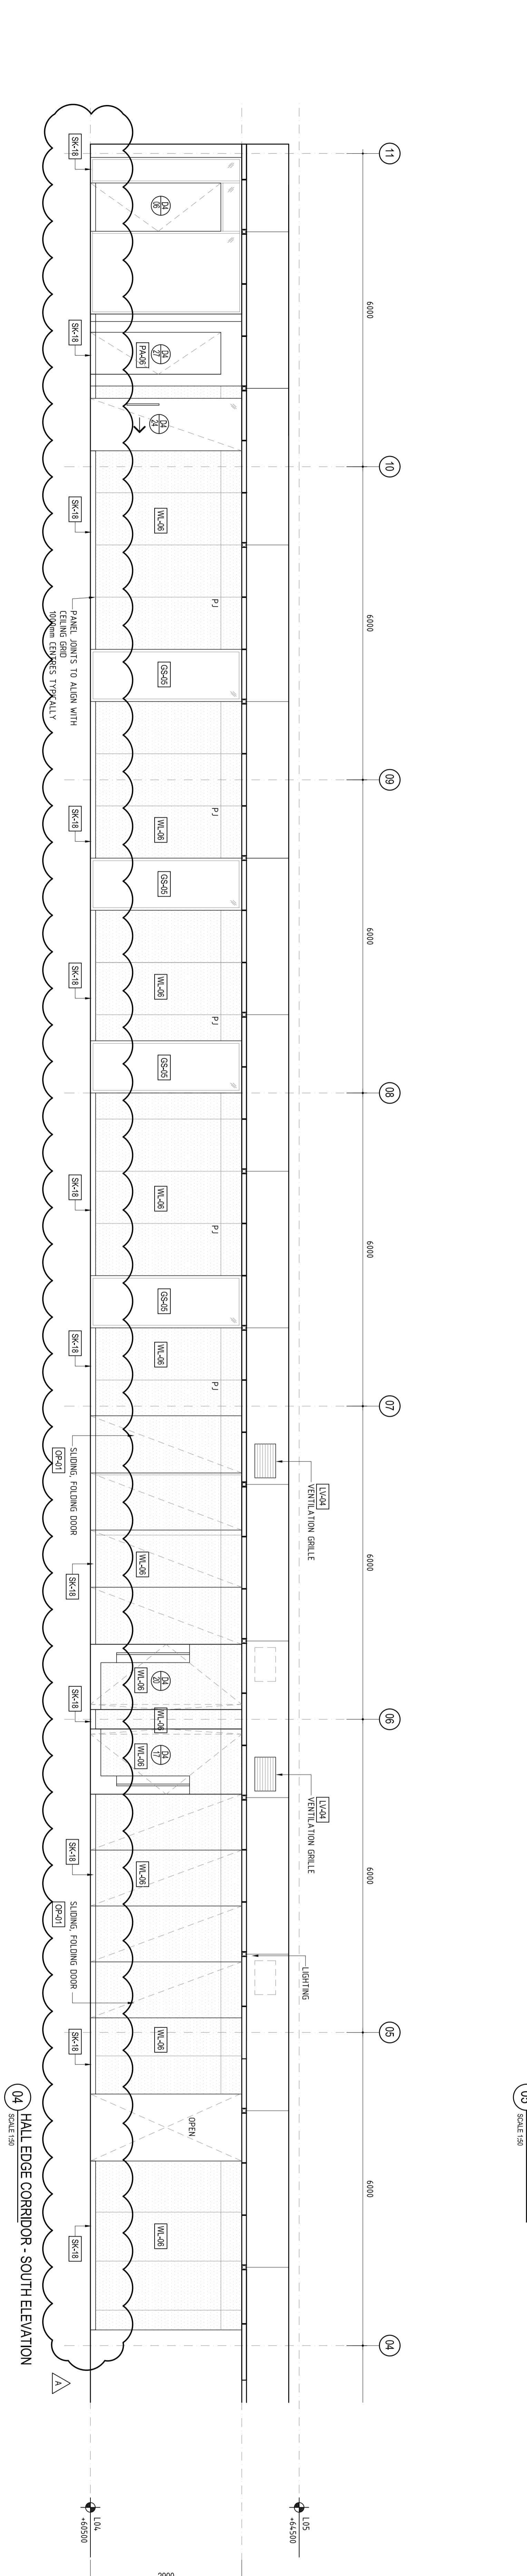
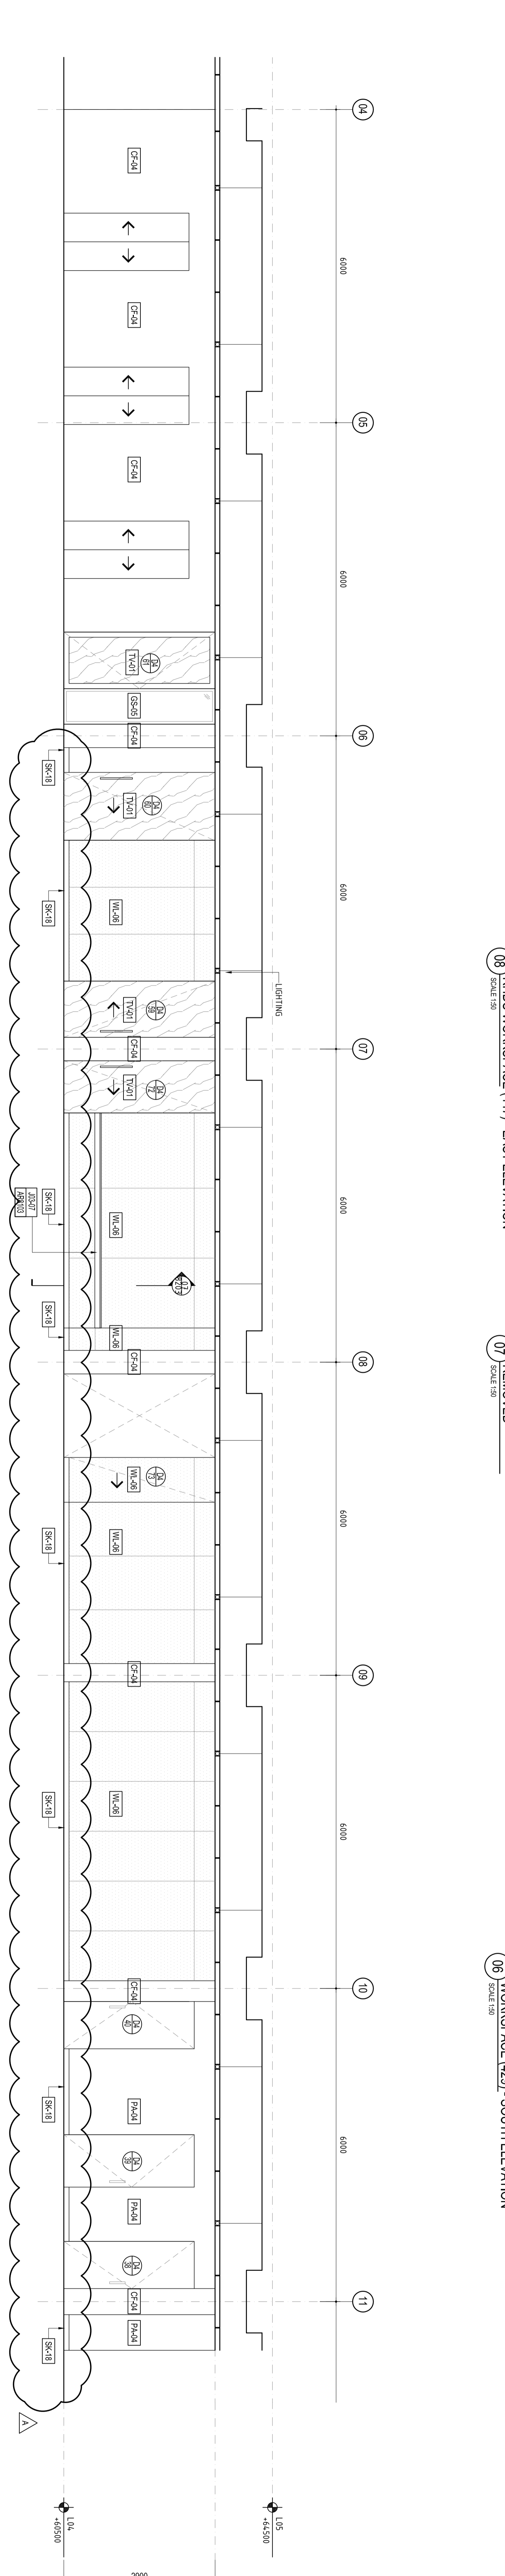


THIS DRAWING IS AN UNCONTROLLED COPY UNLESS STAMPED OTHERWISE
 CONTRACT DOCUMENTS SHALL BE REPRODUCED AS SHOWN AND CONTRACTOR SHALL BE RESPONSIBLE FOR OBTAINING THE LATEST REVISIONS AND AMENDMENTS TO THIS DRAWING. THE CONTRACTOR SHALL BE RESPONSIBLE FOR OBTAINING THE LATEST REVISIONS AND AMENDMENTS TO THIS DRAWING. THE CONTRACTOR SHALL BE RESPONSIBLE FOR OBTAINING THE LATEST REVISIONS AND AMENDMENTS TO THIS DRAWING. THE CONTRACTOR SHALL BE RESPONSIBLE FOR OBTAINING THE LATEST REVISIONS AND AMENDMENTS TO THIS DRAWING.

Grid Lines

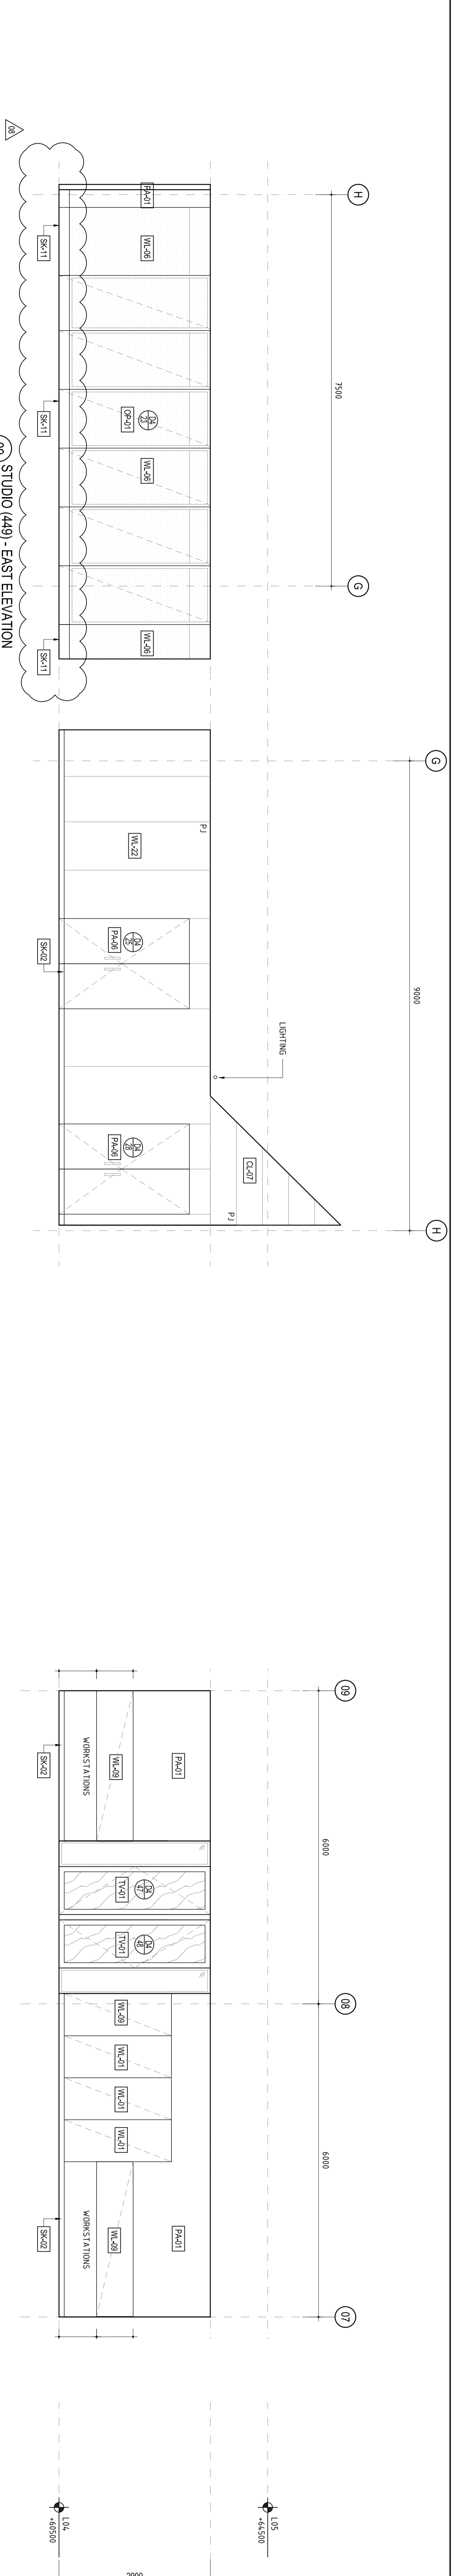

Rev	Issue	Author	Checked	Date
1	Issue			
2	Issue			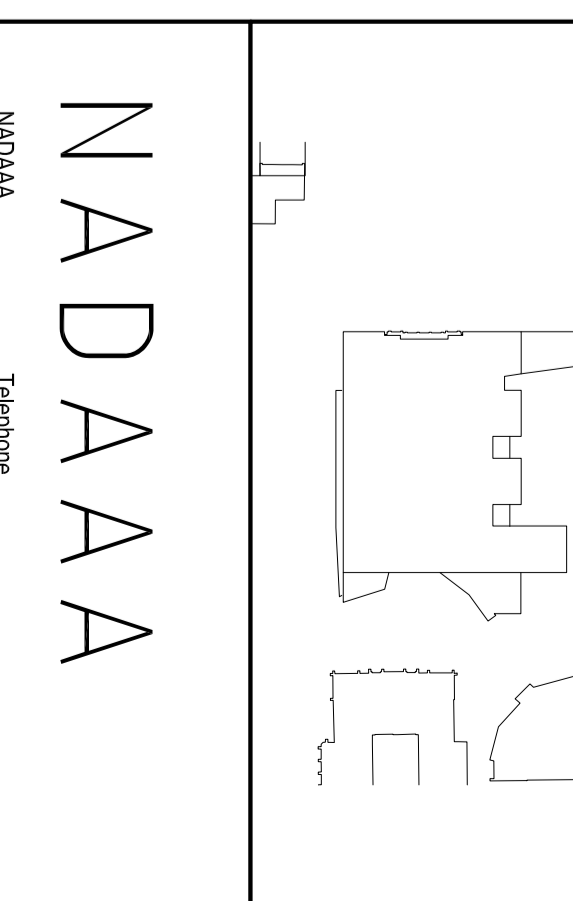
NADAAA
 NADAAA Architects
 10/110 Sturt Street
 Melbourne VIC 3000
 Tel: +61 3 9624 8700
 www.nadaaa.com.au

John Wardle Architects
 2011 John Wardle Architects
 Level 10, 180 Russell Street, Melbourne, Victoria, 3000 Australia
 Tel: +61 3 9624 8700
 www.johnwardlearchitects.com

University of Melbourne
 Parkville Campus

Faculty of Architecture
 Building and Planning

Interior & Joinery Elevations

FOR CONSTRUCTION