

THIS DRAWING IS AN UNCONTROLLED COPY UNLESS STAMPED OTHERWISE

CONTRACTORS SHALL VERIFY JOB DIMENSIONS BEFORE ANY JOB COMMENCES. ALL SHOP DRAWINGS SHALL BE SUBMITTED TO THE SUPERINTENDENT AND MANUFACTURERS SHALL NOT COMMENCE FROM THE RETURN OF DRAWINGS SHOWN BY THE CONSULTANT. DIMENSIONS SHALL TAKE PRECEDENCE OVER SCALES. THIS DRAWING SHALL BE READ IN CONJUNCTION WITH ALL RELEVANT CONTRACT SPECIFICATIONS AND DRAWINGS COPYRIGHT OF THIS DRAWING IS VESTED IN NADAAA

General Notes

SECURITY LEGEND


- DR DOOR RELEASE PUSH BUTTON REFER ELEC DRAWINGS
- CR CARD READER REFER ELEC DRAWINGS
- BGR BREAK GLASS DOOR RELEASE REFER ELEC DRAWINGS
- SP SECURITY PHONE
- IT IT HELP PHONE
- WIP WARDEN INTERCOM PHONE

GENERAL SERVICES LEGEND

- M MECHANICAL WALL MOUNTED SERVICES REFER MECHANICAL DRAWINGS
- DM DIMMER CONTROL REFER MECHANICAL DRAWINGS
- SP ELECTRICAL SWITCH PLATES REFER ELECTRICAL DRAWINGS

NOTES

- SET-OUT FOR ALL SERVICE FIXTURES DIMENSIONED FROM CENTRE-LINE UNLESS OTHERWISE NOTED.
- REFER SERVICES DOCUMENTATION FOR SPECIFICATION OF FIXTURES SHOWN ON THIS DRAWING.
- ALL FIXTURES TO BE SET-OUT IN PLAN

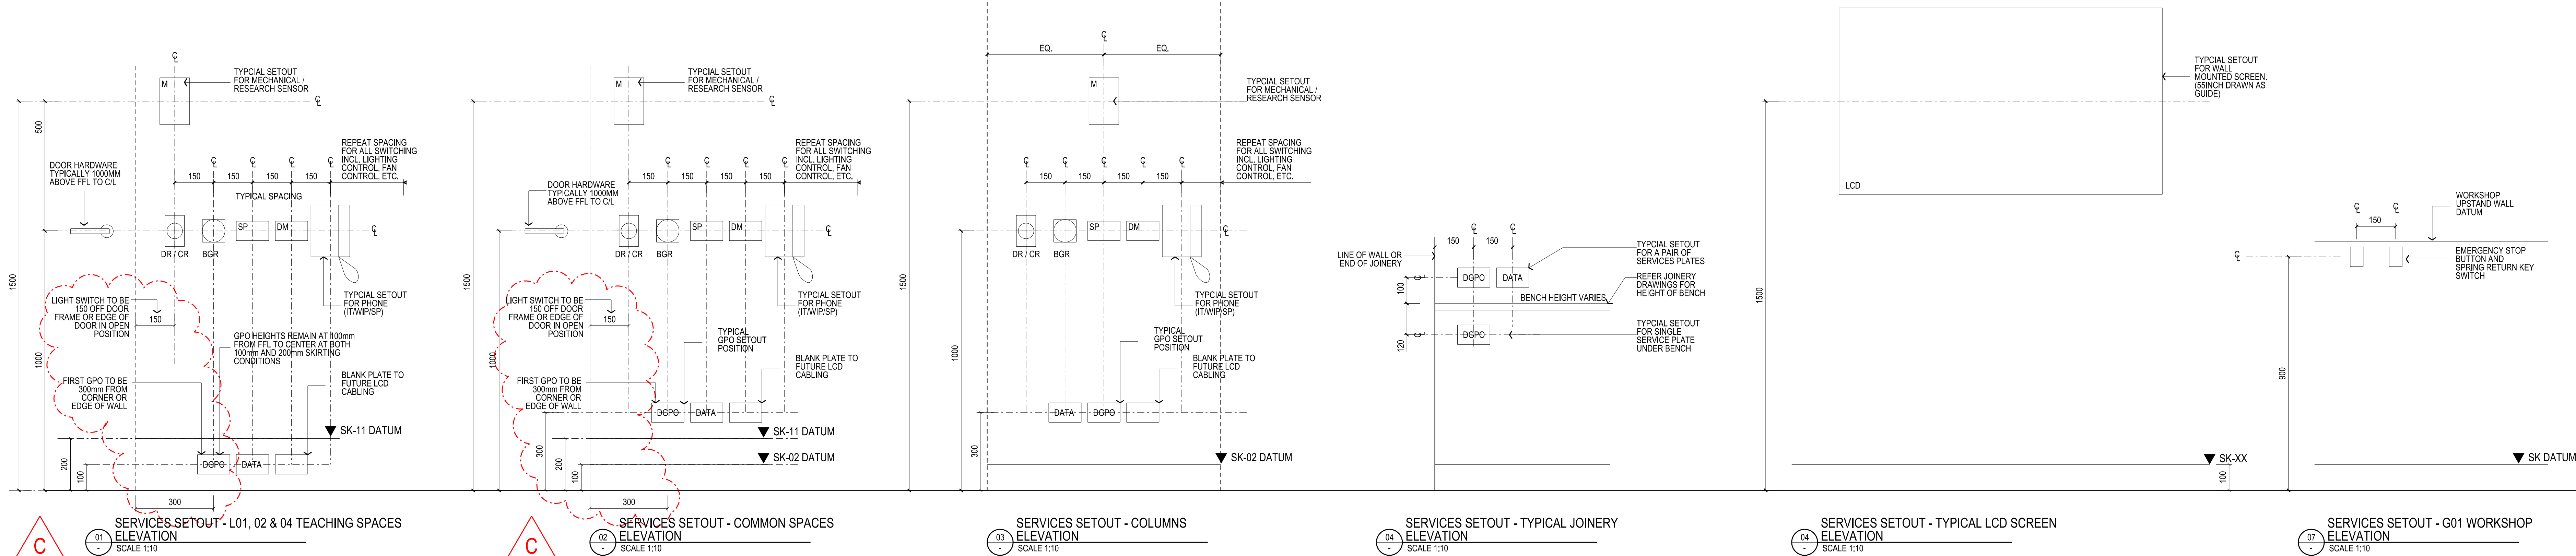

NOTE: INDICATIVE ONLY - NOT ALL FIXTURES MAY BE REQUIRED. PLAN SETOUTS TO BE DETERMINED FOR EACH SPACE.

Rev	Issue	Revision Description	And	Date
C	SG	REVISIONS AS CLOURED	-	06.13.13
B	SG	REVISIONS AS CLOURED	-	04.12.13
A	SG	G01 WORKSHOP LINE OF HEIGHTS	-	13.11.13
03	SG	REVISED LINE OF HEIGHTS SETOUT	-	29.08.13
02	SG	AMENDED TYPICAL GPO SETOUT DETAILS	-	18.07.13
01	SG	100% CD - TENDER ISSUE	-	07.09.12



**NADAAA**  
 NADAAA  
 1520 Washington Street No.2 Boston Massachusetts 02118 USA  
 Telephone +1 617 442 8232 Facsimile +1 688 442 1417 Email nadaaa@nadaaa.com

**John Wardle Architects**  
 25 Rokeby Street, Collingwood, Victoria 3066 Australia  
 Tel: +61 3 8662 0400 www.johnwardlearchitects.com  
 © 2012 John Wardle Architects ABN 83 006 814 268

Client **University of Melbourne Parkville Campus**

Project **Faculty of Architecture Building and Planning**

Title **LINE OF HEIGHTS SETOUT**

	Project No. <b>0913</b>	Scale: 1:10 @ A0
	Drawing No. <b>AR7300</b>	Revision <b>C</b>

Date Sep 2012 Drawn - Co-Ord - Chk -

FILENAME - SFILES

**FOR CONSTRUCTION**

