


CONTRACTORS SHALL VERIFY JOB DIMENSIONS BEFORE ANY JOB COMMENCES. ALL SHOP DRAWINGS SHALL BE SUBMITTED TO THE SUPERINTENDENT AND MANUFACTURERS SHALL NOT COMMENCE FROM THE RETURN OF UNAWARDED SHOP DRAWINGS ISSUED BY THE CONSULTANT. DIMENSIONS SHALL TAKE PRECEDENCE OVER SCALES. THIS DRAWING SHOULD BE READ IN CONJUNCTION WITH ALL RELEVANT CONTRACT SPECIFICATIONS AND DRAWINGS COPYRIGHT OF THIS DRAWING IS VESTED IN HANDLE.

General Notes

- Rw 35 AWT-01 AWT-02
 - Rw 40 AWT-03
 - Rw 45 AWT-04
 - Rw 50 AWT-05 AWT-06
 - Rw 55 AWT-07 AWT-08
 - Rw 60 AWT-09
- REFER TO ACOM SCHEDULE OF ACOUSTIC PARTITION TYPES

Acoustic Transfers - Refer to AR610 & AR611 for Acoustic Transfer Bulkhead / Duct Locations
 - Refer to Acom, U.L.A. Mechanical Engineer Specification & Drawings for Requirements

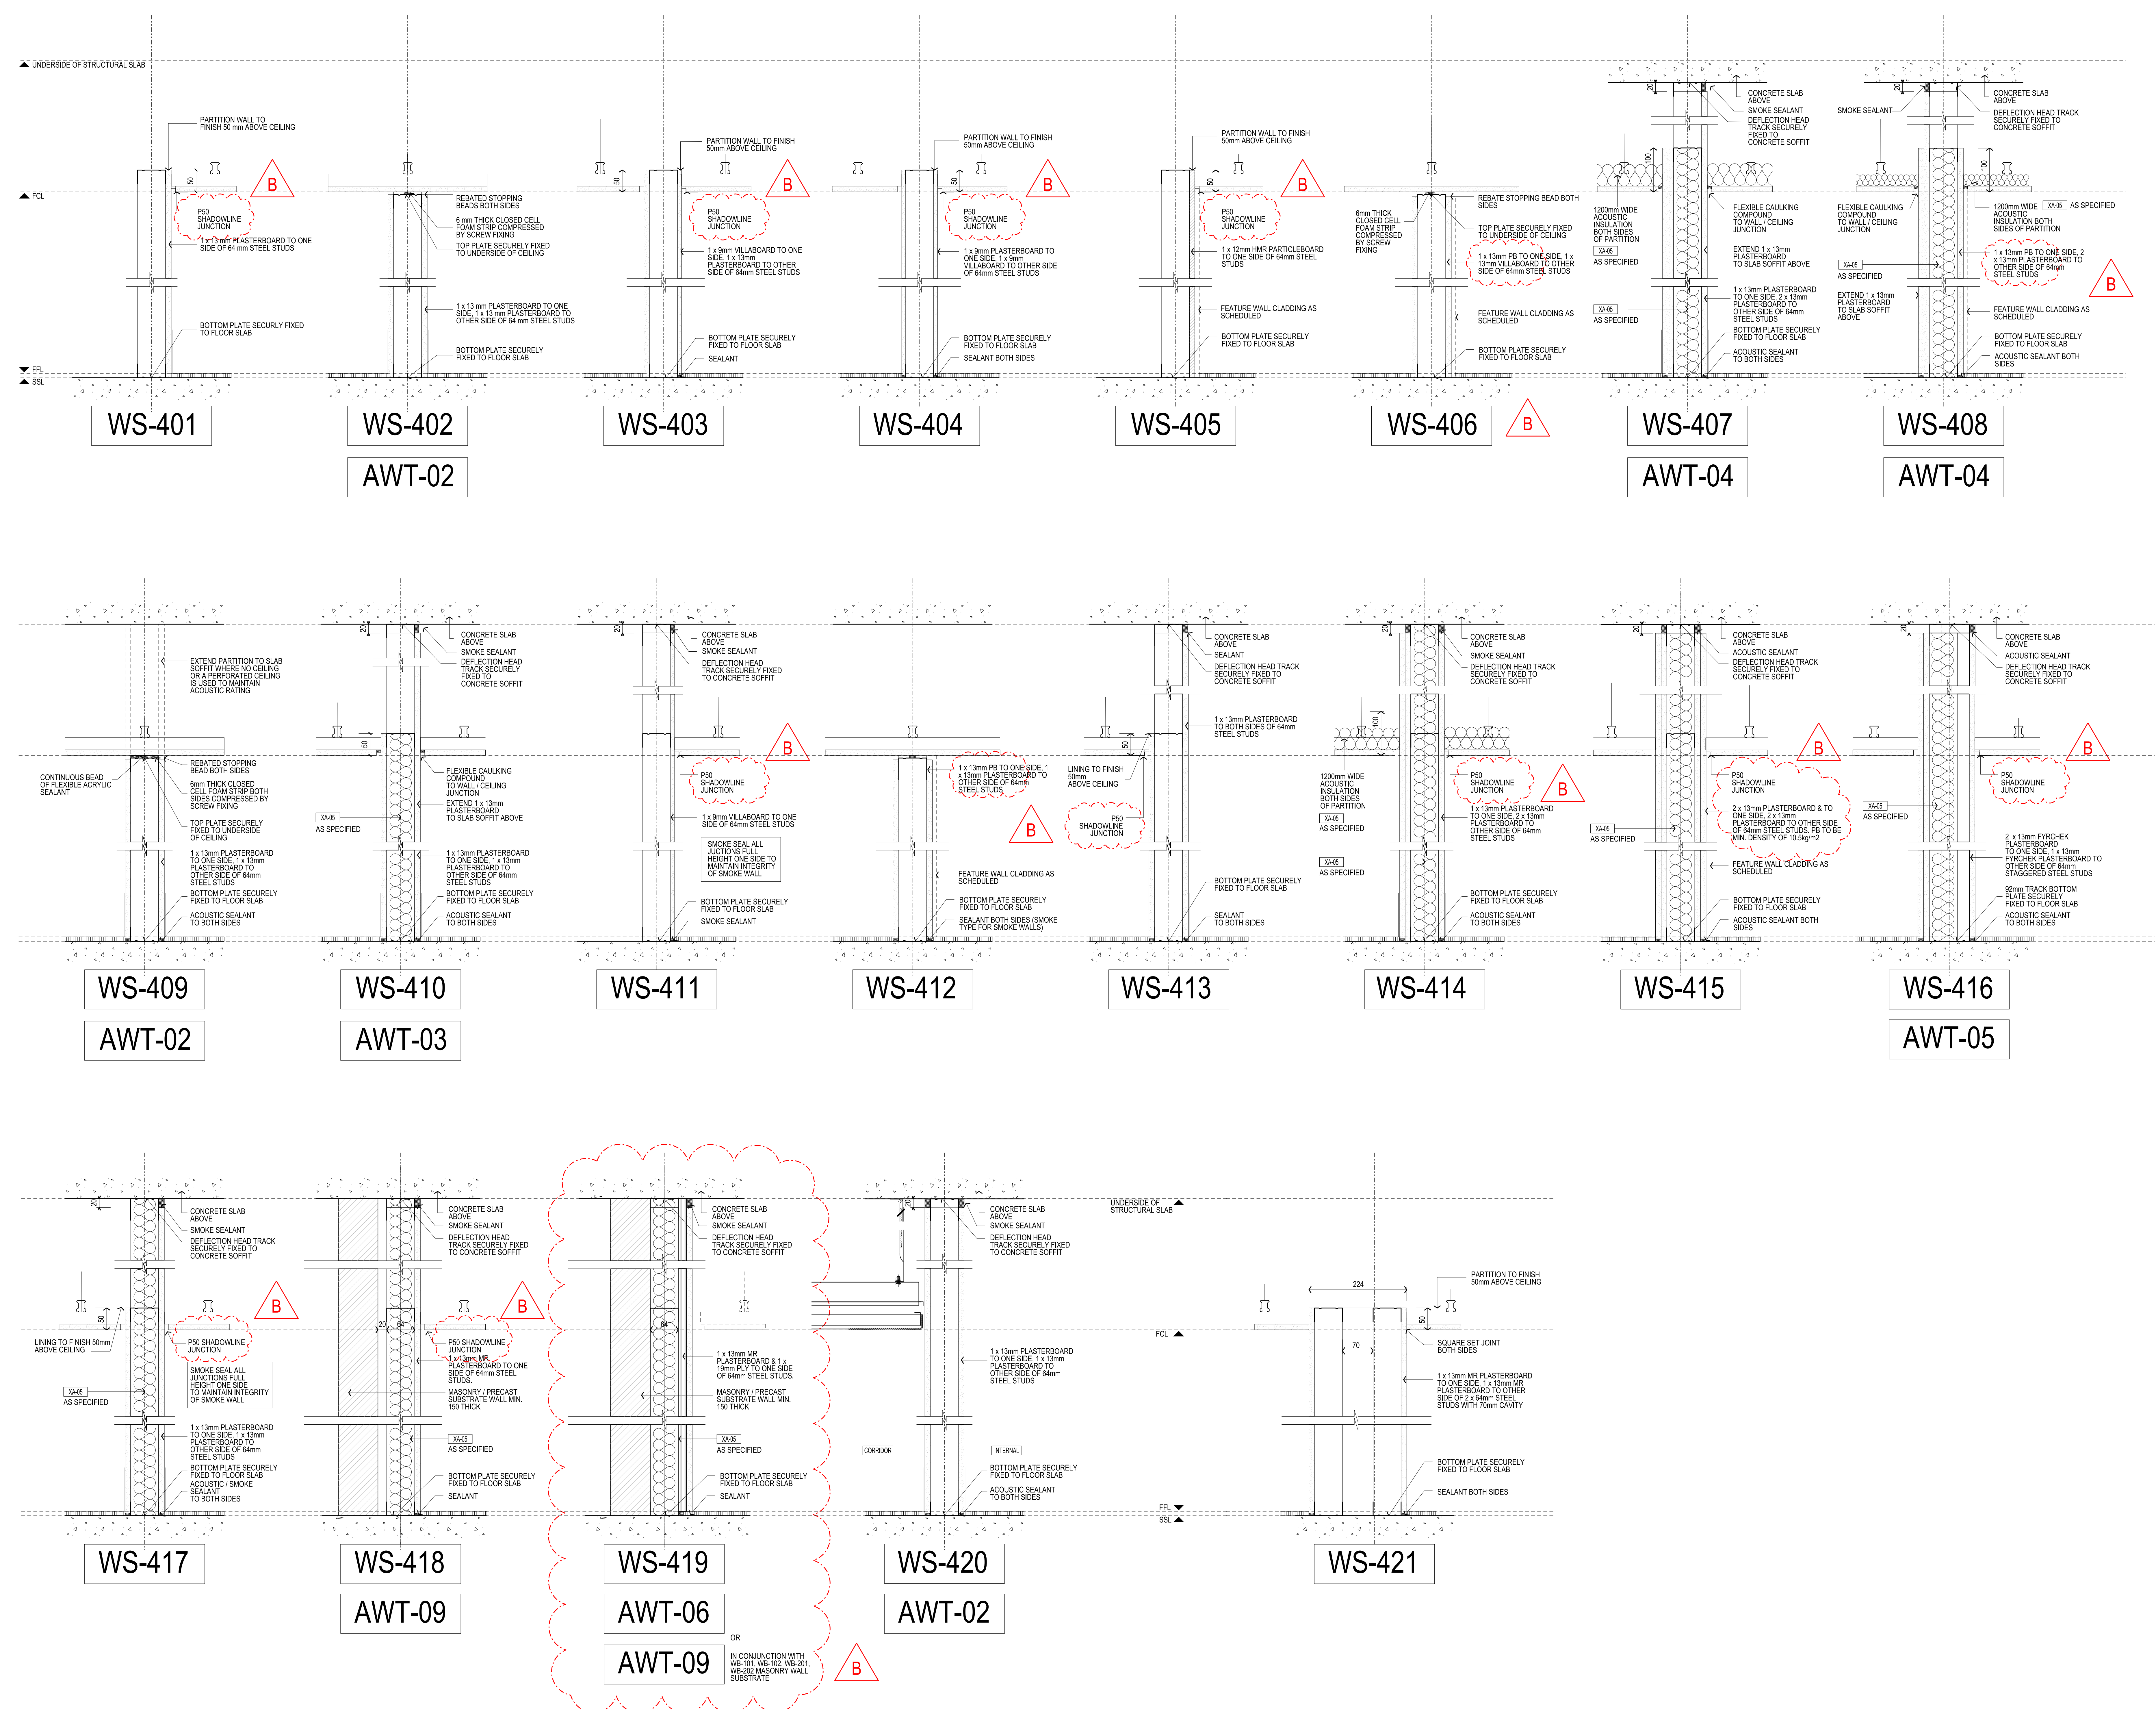

Rev	Issue	Revision Description	And	Date
B	SG	UPDATED AS CLOUDED	-	17.09.13
A	SG	UPDATES TO INCLUDE ACOUSTIC REVISIONS	-	20.08.13
09	SG	VALUE MANAGEMENT UPDATE	-	12.04.13
		WALL TYPE ADDED		
08	SG	100% CD - TENDER ISSUE	-	07.09.12
07	SG	90% CD ISSUE	-	10.08.12
06	SG	75% CD ISSUE	-	13.07.12
05	SG	50% CD ISSUE	-	01.06.12
04	SG	FINAL DO ISSUE	-	24.02.12
		WALL TYPE ADDED		
03	SG	DO UPDATE	-	27.01.12
02	SG	DO UPDATE	-	20.07.12
01	SG	DESIGN DEVELOPMENT ISSUE	-	22.12.11



NADAAA
 NADAAA
 1020 Washington Street No.2 Boston Massachusetts 02118 USA
 Telephone +1 817 442 8232 Facsimile +1 888 442 1417 Email nadaaa@nadaaa.com

John Wardle Architects
 25 Rokeby Street, Collingwood, Victoria 3066 Australia
 Tel: +61 3 8662 0400 www.johnwardlearchitects.com
 © 2012 John Wardle Architects ABN 63 006 814 268

Client: **University of Melbourne Parkville Campus**

Project: **Faculty of Architecture Building and Planning**

Title: **WALL TYPE DETAILS SHEET 2**

Project No.	0913	Scale	1:5 @ A0 1:10 @ A2
Drawing No.	AR7501	Revision	B

Date: Dec 2011
 Drawn: - Co-Ord: - Check: -

FILENAME: - SFRS

FOR CONSTRUCTION