
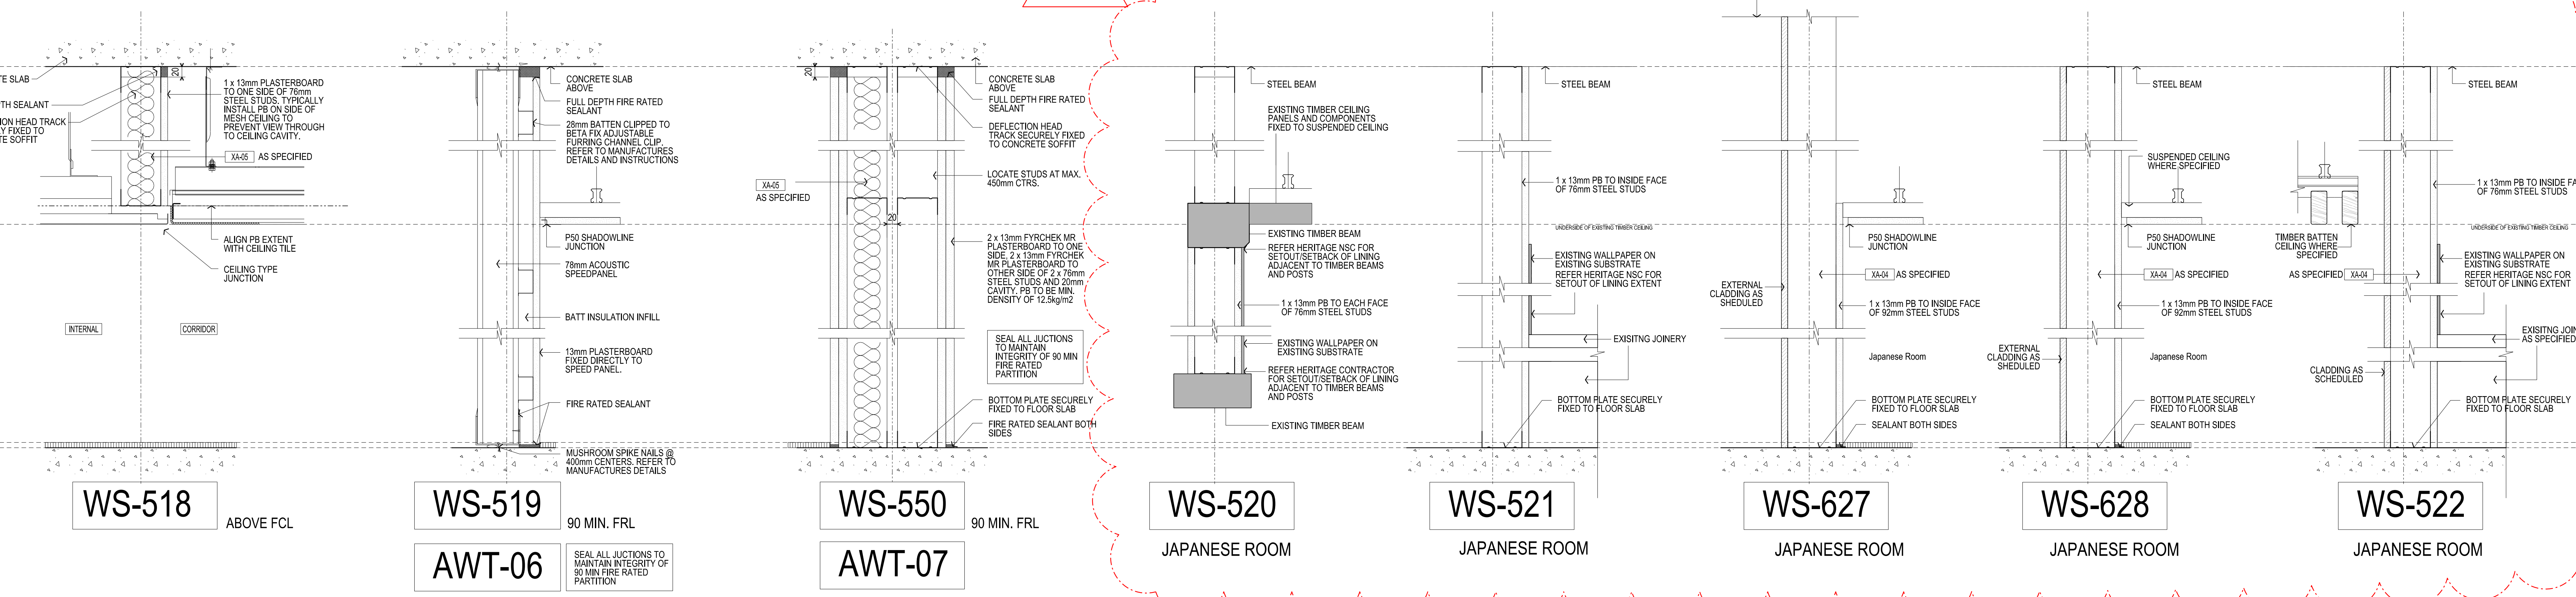
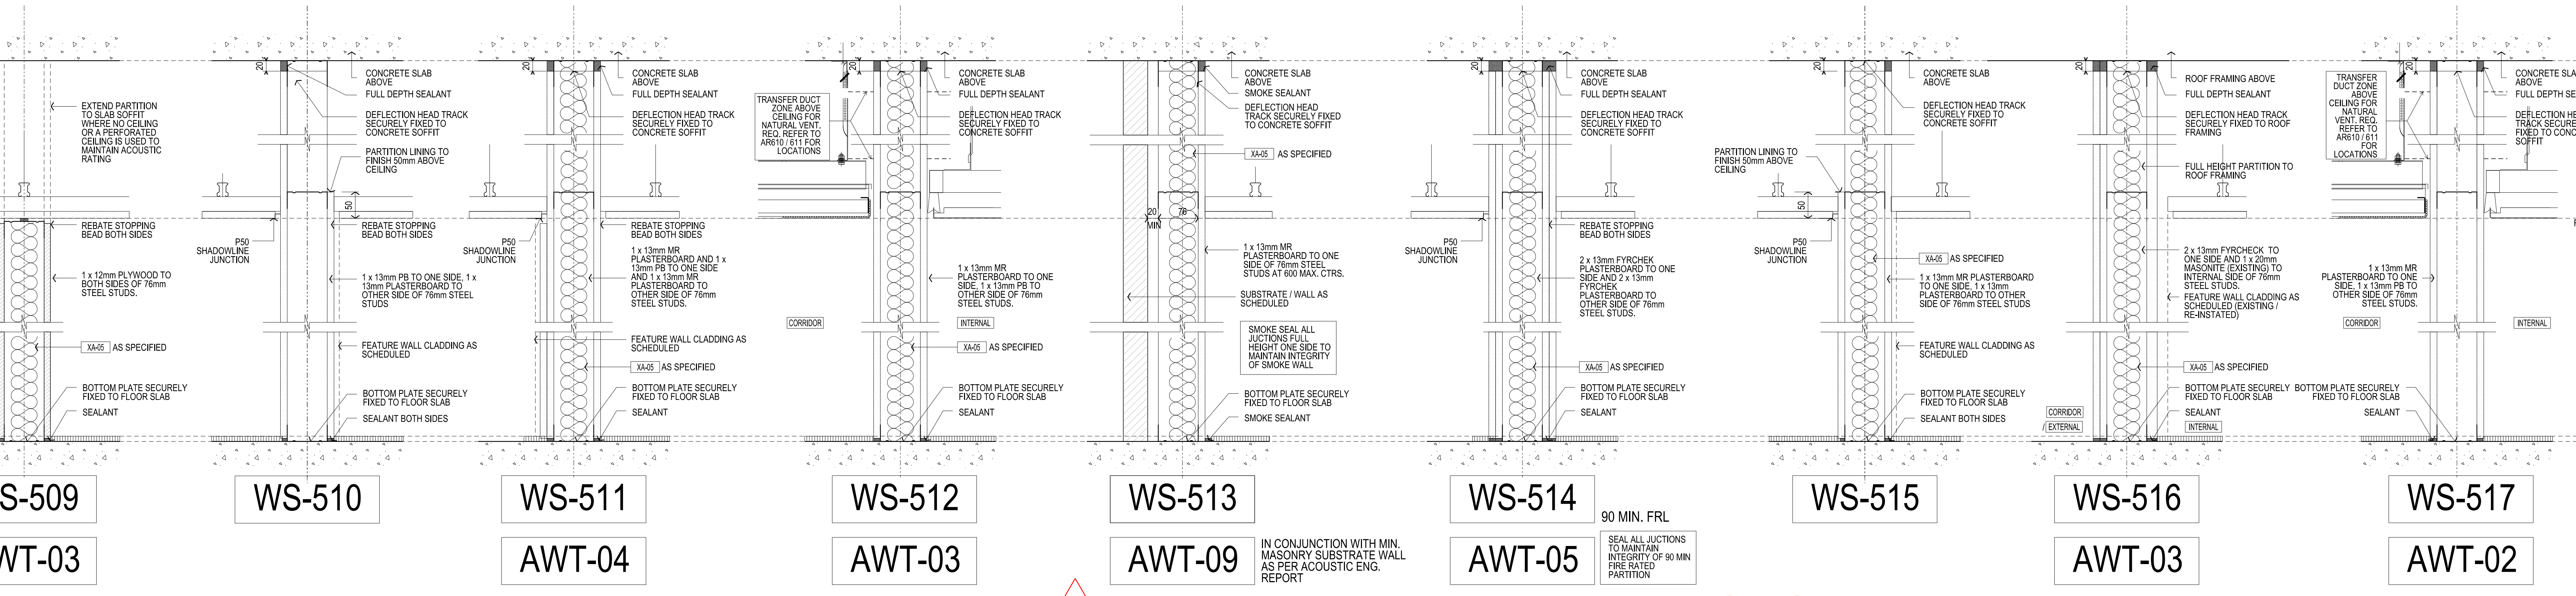


CONTRACTORS SHALL VERIFY JOB DIMENSIONS BEFORE ANY JOB COMMENCES. ALL SHOP DRAWINGS SHALL BE SUBMITTED TO THE SUPERINTENDENT AND MANUFACTURERS SHALL NOT COMMENCE FROM THE RETURN OF AWARDED SHOP DRAWINGS ISSUED BY THE CONSULTANT. DIMENSIONS SHALL TAKE PRECEDENCE OVER SCALES. THIS DRAWING SHOULD BE READ IN CONJUNCTION WITH ALL RELEVANT CONTRACT SPECIFICATIONS AND DRAWINGS COPYRIGHT OF THIS DRAWING IS VESTED IN WARDLE.

General Notes

- Rw 35 AWT-01 AWT-02
  - Rw 40 AWT-03
  - Rw 45 AWT-04
  - Rw 50 AWT-05 AWT-06
  - Rw 55 AWT-07 AWT-08
  - Rw 60 AWT-09
- REFER TO ACOM SCHEDULE OF ACOUSTIC PARTITION TYPES

Acoustic Transfers - Refer to AR610 & AR611 for Acoustic Transfer Bulkhead / Duct Locations  
 - Refer to Acom, U.L.A. Mechanical Engineer Specification & Drawings for Requirements

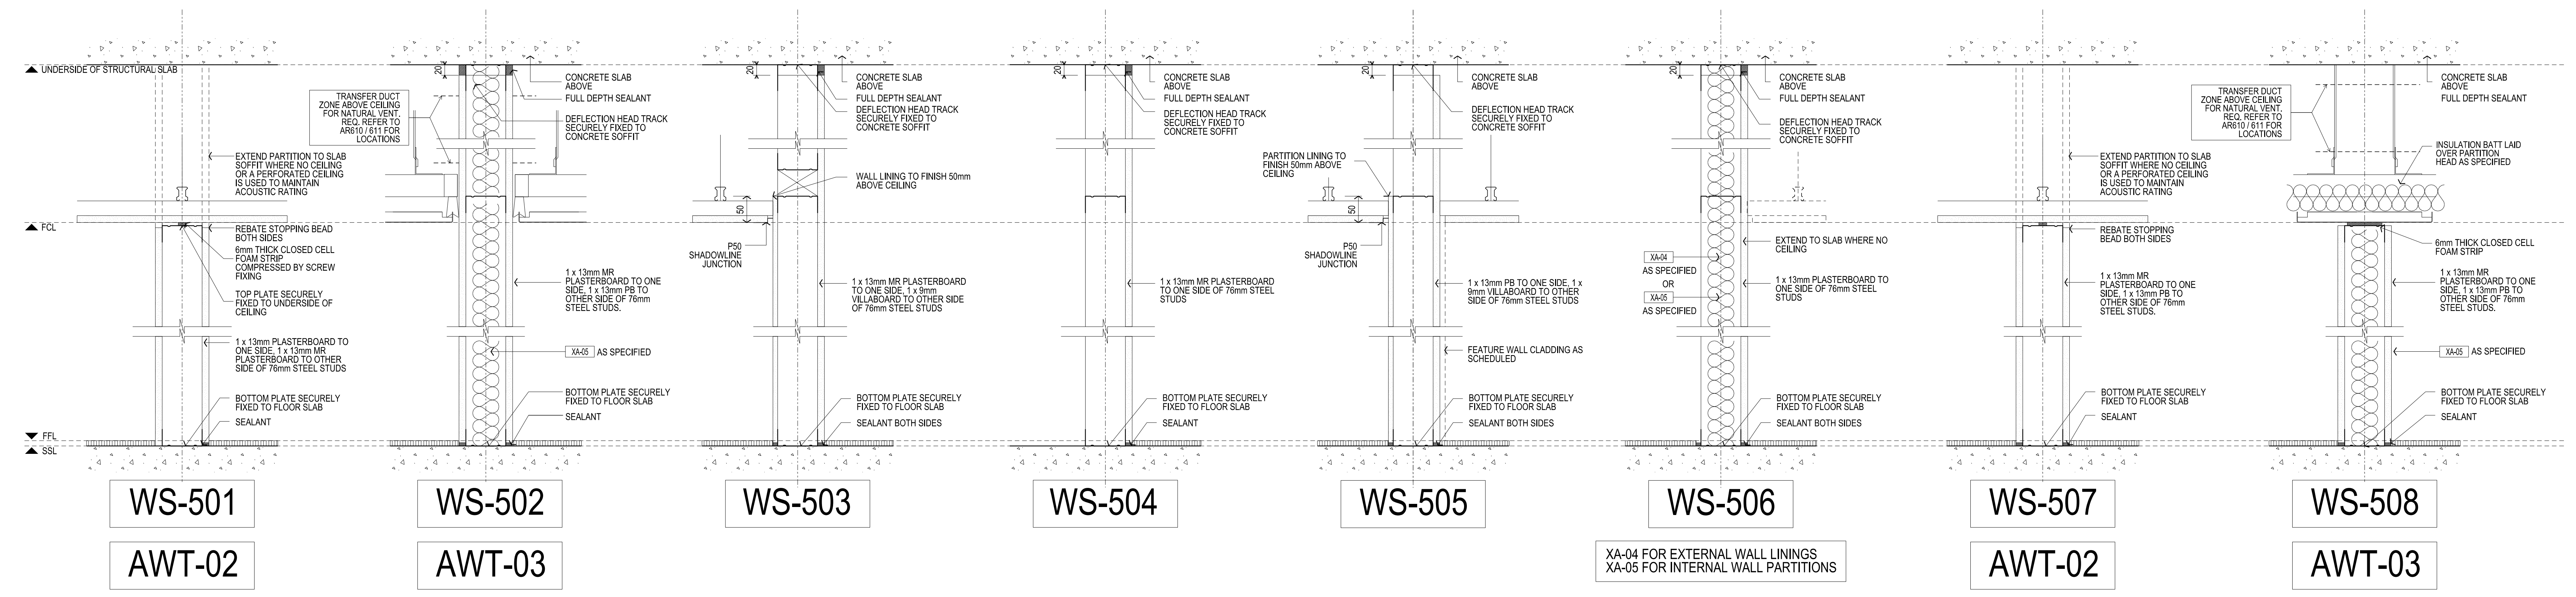

Rev	Issue	Revision Description	And	Date
H	SG	UPDATES AS CLOUED	-	15.01.14
G	SG	UPDATES AS CLOUED	-	19.11.13
F	SG	UPDATES AS CLOUED	-	12.11.13
E	SG	UPDATES AS CLOUED	-	24.09.13
D	SG	NEW WS-518 DETAIL ADDED, WS-508 UPDATED	-	18.09.13
C	SG	UPDATES AS CLOUED	-	17.09.13
B	SG	UPDATE TO XA CODE	-	23.08.13
A	SG	UPDATES TO INCLUDE ACOUSTIC REVISIONS	-	20.08.13
		WALL TYPE ADDED		
09	SG	100% CD - TENDER ISSUE	-	07.09.12
08	SG	90% CD ISSUE	-	10.08.12
07	SG	75% CD ISSUE	-	13.07.12
06	SG	60% CD ISSUE	-	01.06.12
05	SG	FINAL CD ISSUE	-	24.02.12
		WALL COMPOSITION REVISED WHERE INDICATED		
		WALL TYPES ADDED		
04	SG	DO ISSUE		XX.XX.XX
		WALL TYPES ADDED		
03	SG	DO UPDATE		27.01.12
		WALL TYPES ADDED		
02	SG	DO UPDATE		20.01.12
01	SG	DESIGN DEVELOPMENT ISSUE		22.12.11



Client University of Melbourne  
 Parkville Campus  
 Project Faculty of Architecture  
 Building and Planning

THE WALL TYPE DETAILS SHEET 3

Project No.	0913	Scale	1:5 @ A0 1:10 @ A2
Drawing No.	AR7502	Revision	H
Date	Dec 2011	Drawn	-
Co-Ord	-	Check	-

FILENAME - SFILES

FOR CONSTRUCTION