


CONTRACTORS SHALL VERIFY JOB DIMENSIONS BEFORE ANY JOB COMMENCES. ALL SHOP DRAWINGS SHALL BE SUBMITTED TO THE SUPERINTENDENT AND MANUFACTURE SHALL NOT COMMENCE FROM THE RETURN OF UNAMENDED SHOP DRAWINGS ISSUED BY THE CONSULTANT. FIGURED DIMENSIONS SHALL TAKE PRECEDENCE OVER SCALED. THIS DRAWING SHOULD BE READ IN CONJUNCTION WITH ALL RELEVANT CONTRACT SPECIFICATIONS AND DRAWINGS COPYRIGHT OF THIS DRAWING IS VESTED IN WARDLE

General Notes



|    |    |                        |   |          |
|----|----|------------------------|---|----------|
| A  | SG | CONSTRUCTION ISSUE     | - | 06.01.14 |
| 03 | SG | VALUE MANAGEMENT ISSUE | - | 28.03.13 |
| 02 | JC | 100% CO - TENDER ISSUE | - | 07.09.12 |
| 01 | JC | 90% CO ISSUE           | - | 10.08.12 |

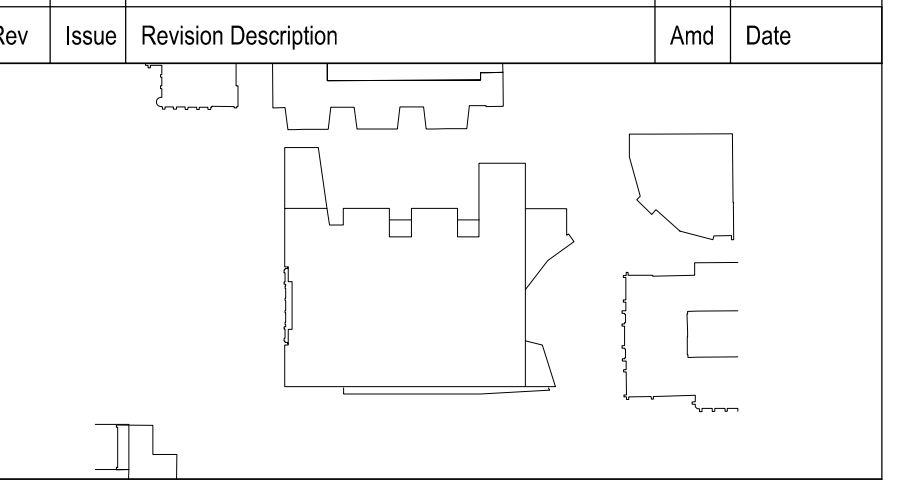

**NADAAA**  
 Telephone: +1 817 442 6232  
 Street No 2  
 Boston  
 Massachusetts  
 02118 USA  
 Email: nad@nadaaa.com

**John Wardle Architects**  
 © 2011 John Wardle Architects  
 Level 10, 180 Russell Street, Melbourne Victoria 3000 Australia  
 Tel: +613 9654 8700 www.johnwardlearchitects.com

Client: **University of Melbourne Parkville Campus**  
 Project: **Faculty of Architecture Building and Planning**  
 Title: **TYPICAL WALL FINISH DETAILS**

|             |        |          |       |
|-------------|--------|----------|-------|
| Project No. | 0913   | Scale    | 1:2   |
| Drawing No. | AR7550 | Revision | A     |
| Date        |        | Co-Ord   | Check |

FOR CONSTRUCTION