



CONTRACTORS SHALL VERIFY JOB DIMENSIONS BEFORE ANY JOB COMMENCES. ALL SHOP DRAWINGS SHALL BE SUBMITTED TO THE SUPERINTENDENT AND MANUFACTURE SHALL NOT COMMENCE PRIOR TO THE RETURN OF EXAMINED SHOP DRAWINGS ISSUED BY THE CONSULTANT. FIGURED DIMENSIONS SHALL TAKE PRECEDENCE OVER SCALED. THIS DRAWING SHOULD BE READ IN CONJUNCTION WITH ALL RELEVANT CONTRACT SPECIFICATIONS AND DRAWING COPYRIGHT OF THIS DRAWING IS VESTED IN WARDLE


General Notes

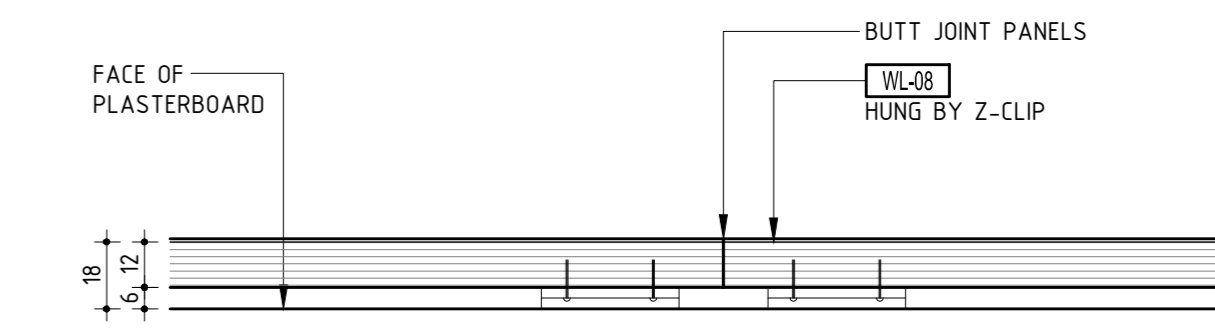


05 PLAN DET - WHITEBOARD (WL-08)  
SCALE: 1:2

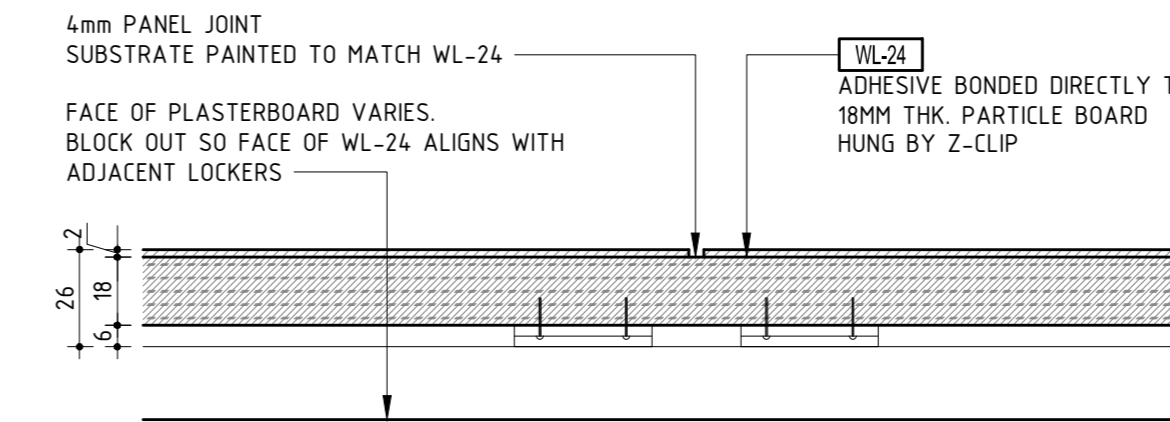


09 PLAN DET - METALLIC LAMINATE (WL-24)  
SCALE: 1:2

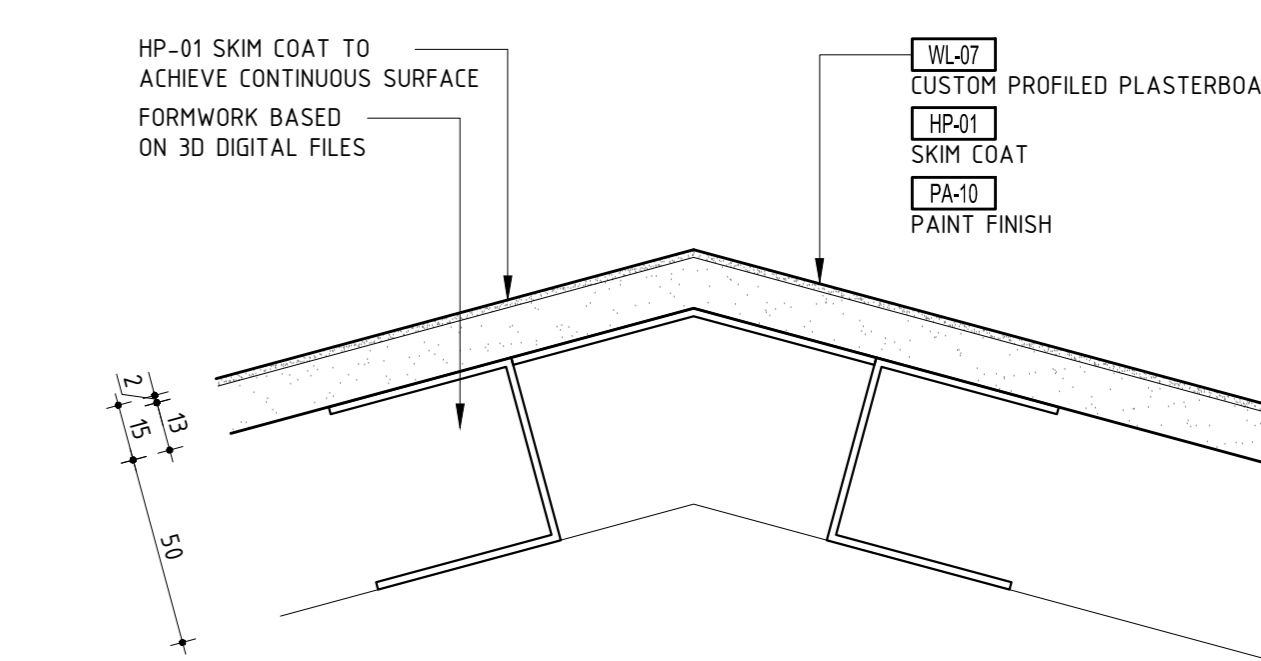

04 PLAN DET - COMPLEX PLASTER (WL-07)  
SCALE: 1:2

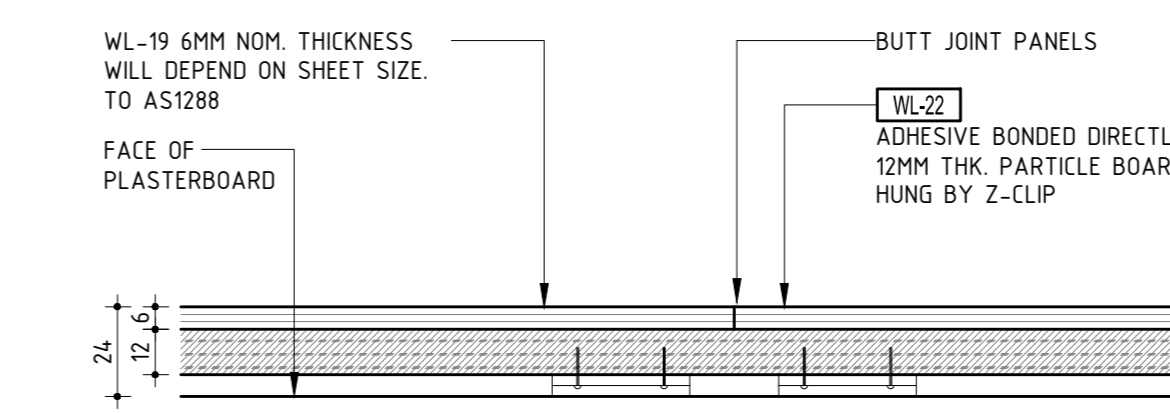


08 PLAN DET - COLOURBACK GLASS (WL-22)  
SCALE: 1:2

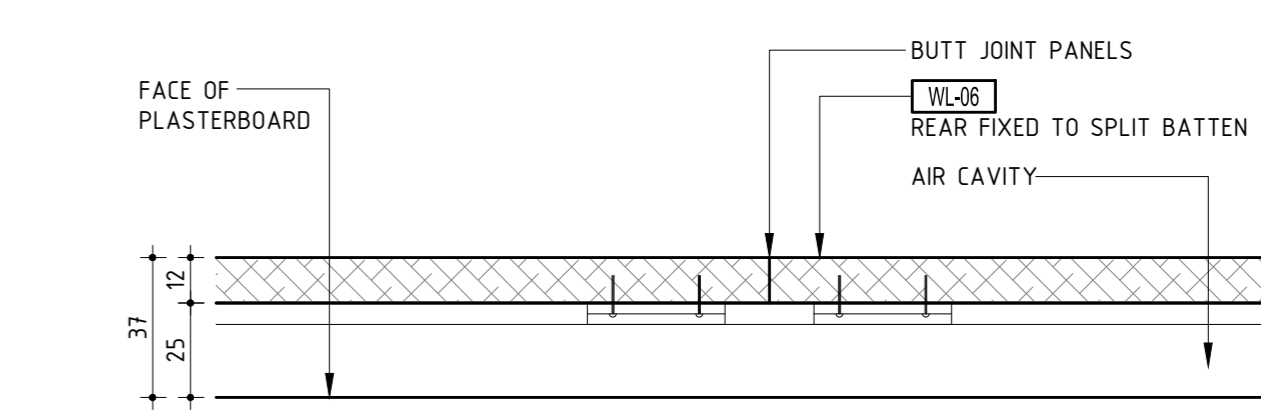


03 PLAN DET - ACOUSTIC PANEL (WL-06)  
SCALE: 1:2

18 REMOVED  
SCALE: 1:2

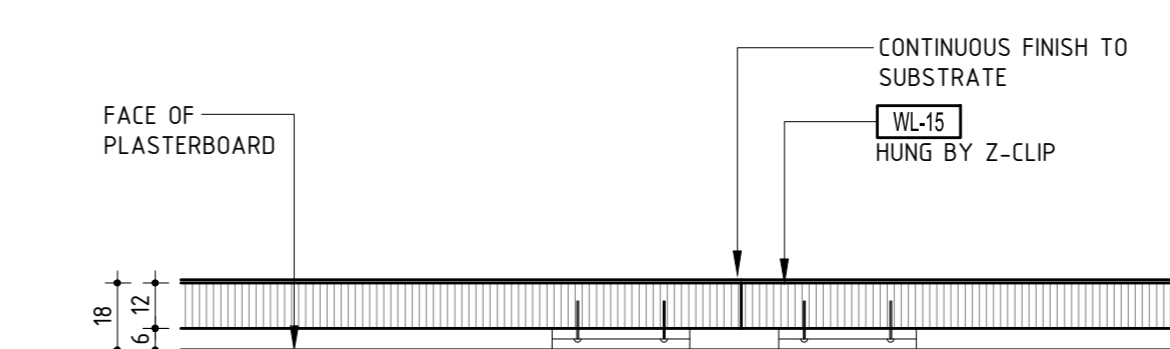


07 PLAN DET - SCREEN GOO (WL-15)  
SCALE: 1:2

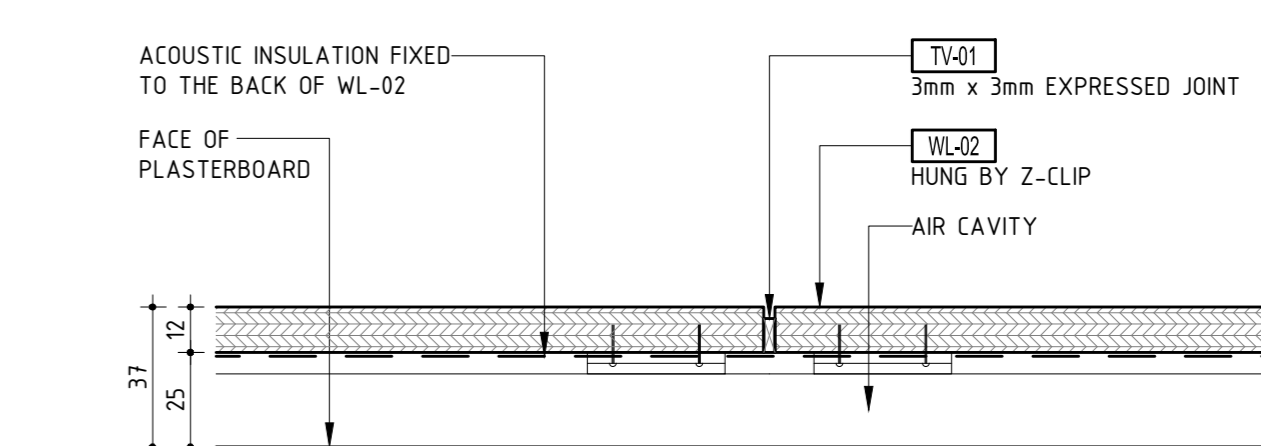


02 PLAN DET - MDF PANEL (WL-02)  
SCALE: 1:2

17 REMOVED  
SCALE: 1:2

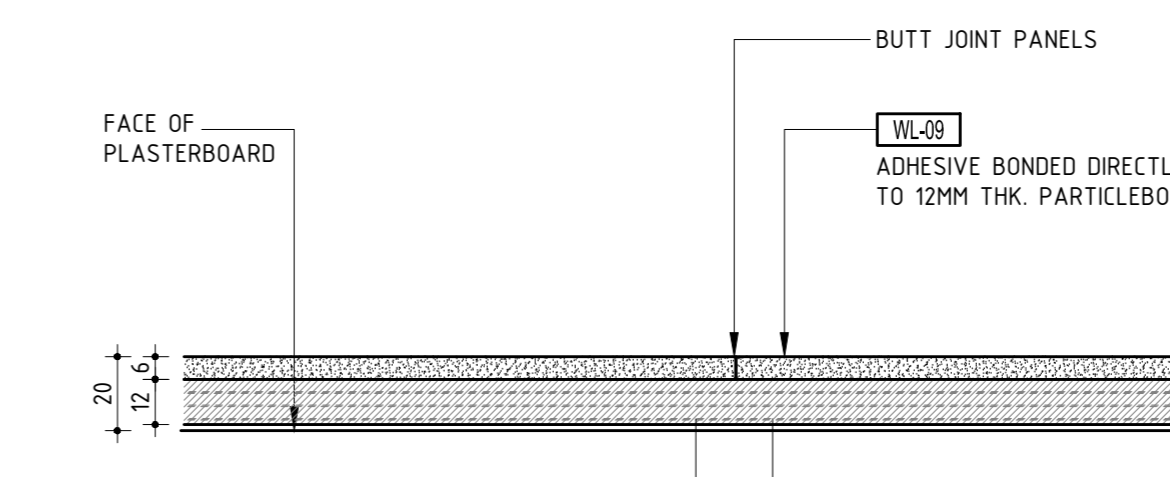


06 PLAN DET - PINBOARD (WL-09)  
SCALE: 1:2

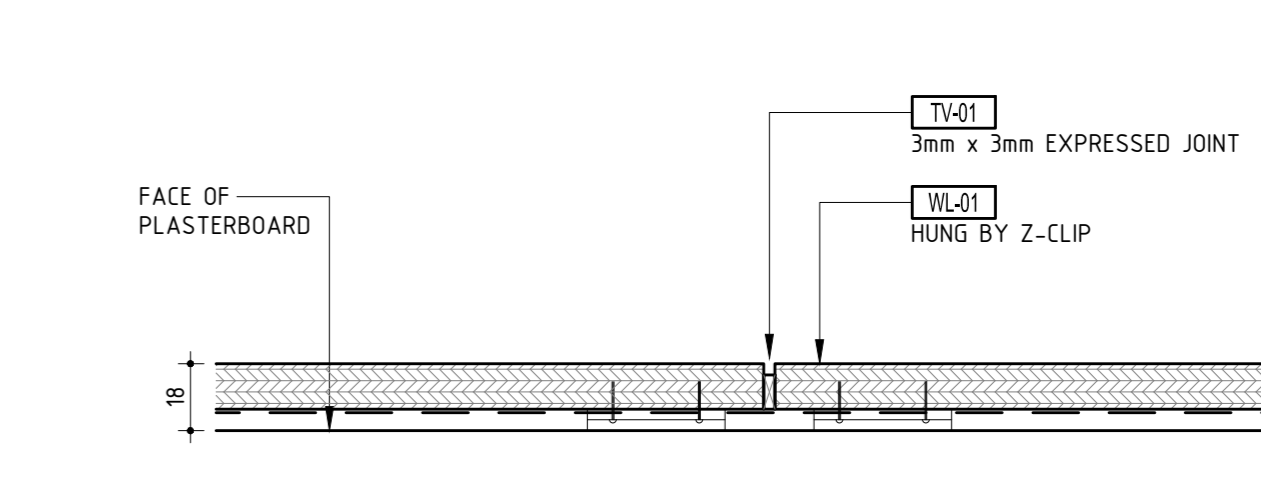

01 PLAN DET - MDF PANEL (WL-01)  
SCALE: 1:2

16 REMOVED  
SCALE: 1:2

Rev	Issue	Revision Description	Amd	Date
A	SG	CONSTRUCTION ISSUE	-	08.01.14
03	SG	VALUE MANAGEMENT ISSUE	-	28.03.13
02	JC	100% CD - TENDER ISSUE	-	07.08.12
01	JC	90% CD ISSUE	-	10.08.12

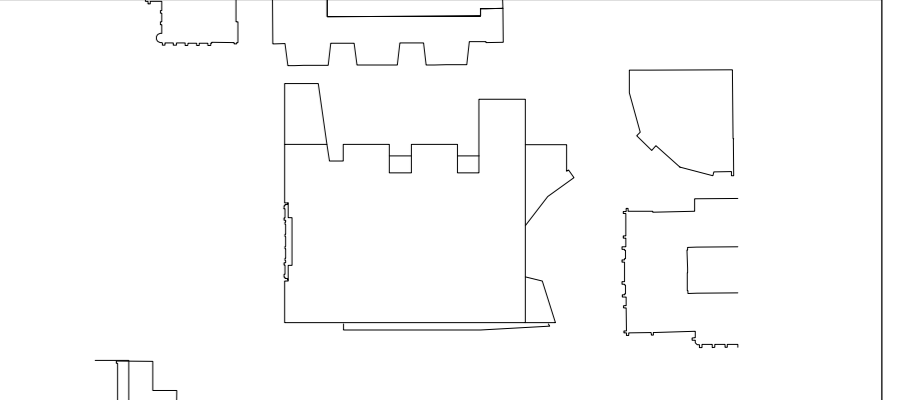

NADAAA

NADAAA Telephone +1 617 442 6232  
1900 Washington Street No 2 Facsimile +1 617 442 1417  
Boston Massachusetts Email nad@nadaaa.com  
02118 USA nad@nadaaa.com

**John Wardle Architects**  
© 2011 John Wardle Architects  
Level 10, 180 Russell Street, Melbourne Victoria 3000 Australia  
Tel : +613 9654 8700 www.johnwardlearchitects.com

Client **University of Melbourne Parkville Campus**

Project **Faculty of Architecture Building and Planning**

Title **TYPICAL WALL FINISH DETAILS**

Project No.	<b>0913</b>	Scale	1:2
Drawing No.	<b>AR7551</b>	Revision	<b>A</b>
Date	Drawn -	Co-Ord -	Check -

FILENAME: #####  
**FOR CONSTRUCTION**