



CONTRACTORS SHALL VERIFY DIMENSIONS BEFORE ANY JOB COMMENCES. ALL SHOP DRAWINGS SHALL BE SUBMITTED TO THE SUPERINTENDENT AND MANUFACTURER SHALL NOT COMMENCE PRIOR TO THE RETURN OF DIMENSIONED SHOP DRAWINGS. BY THE CONSULTANT FIGURED DIMENSIONS SHALL TAKE PRECEDENCE OVER SCALED. THIS DRAWING SHALL BE READ IN CONJUNCTION WITH ALL RELEVANT CONTRACT SPECIFICATIONS AND DRAWINGS COPYRIGHT OF THIS DRAWING IS VESTED IN HANDLE.


General Notes

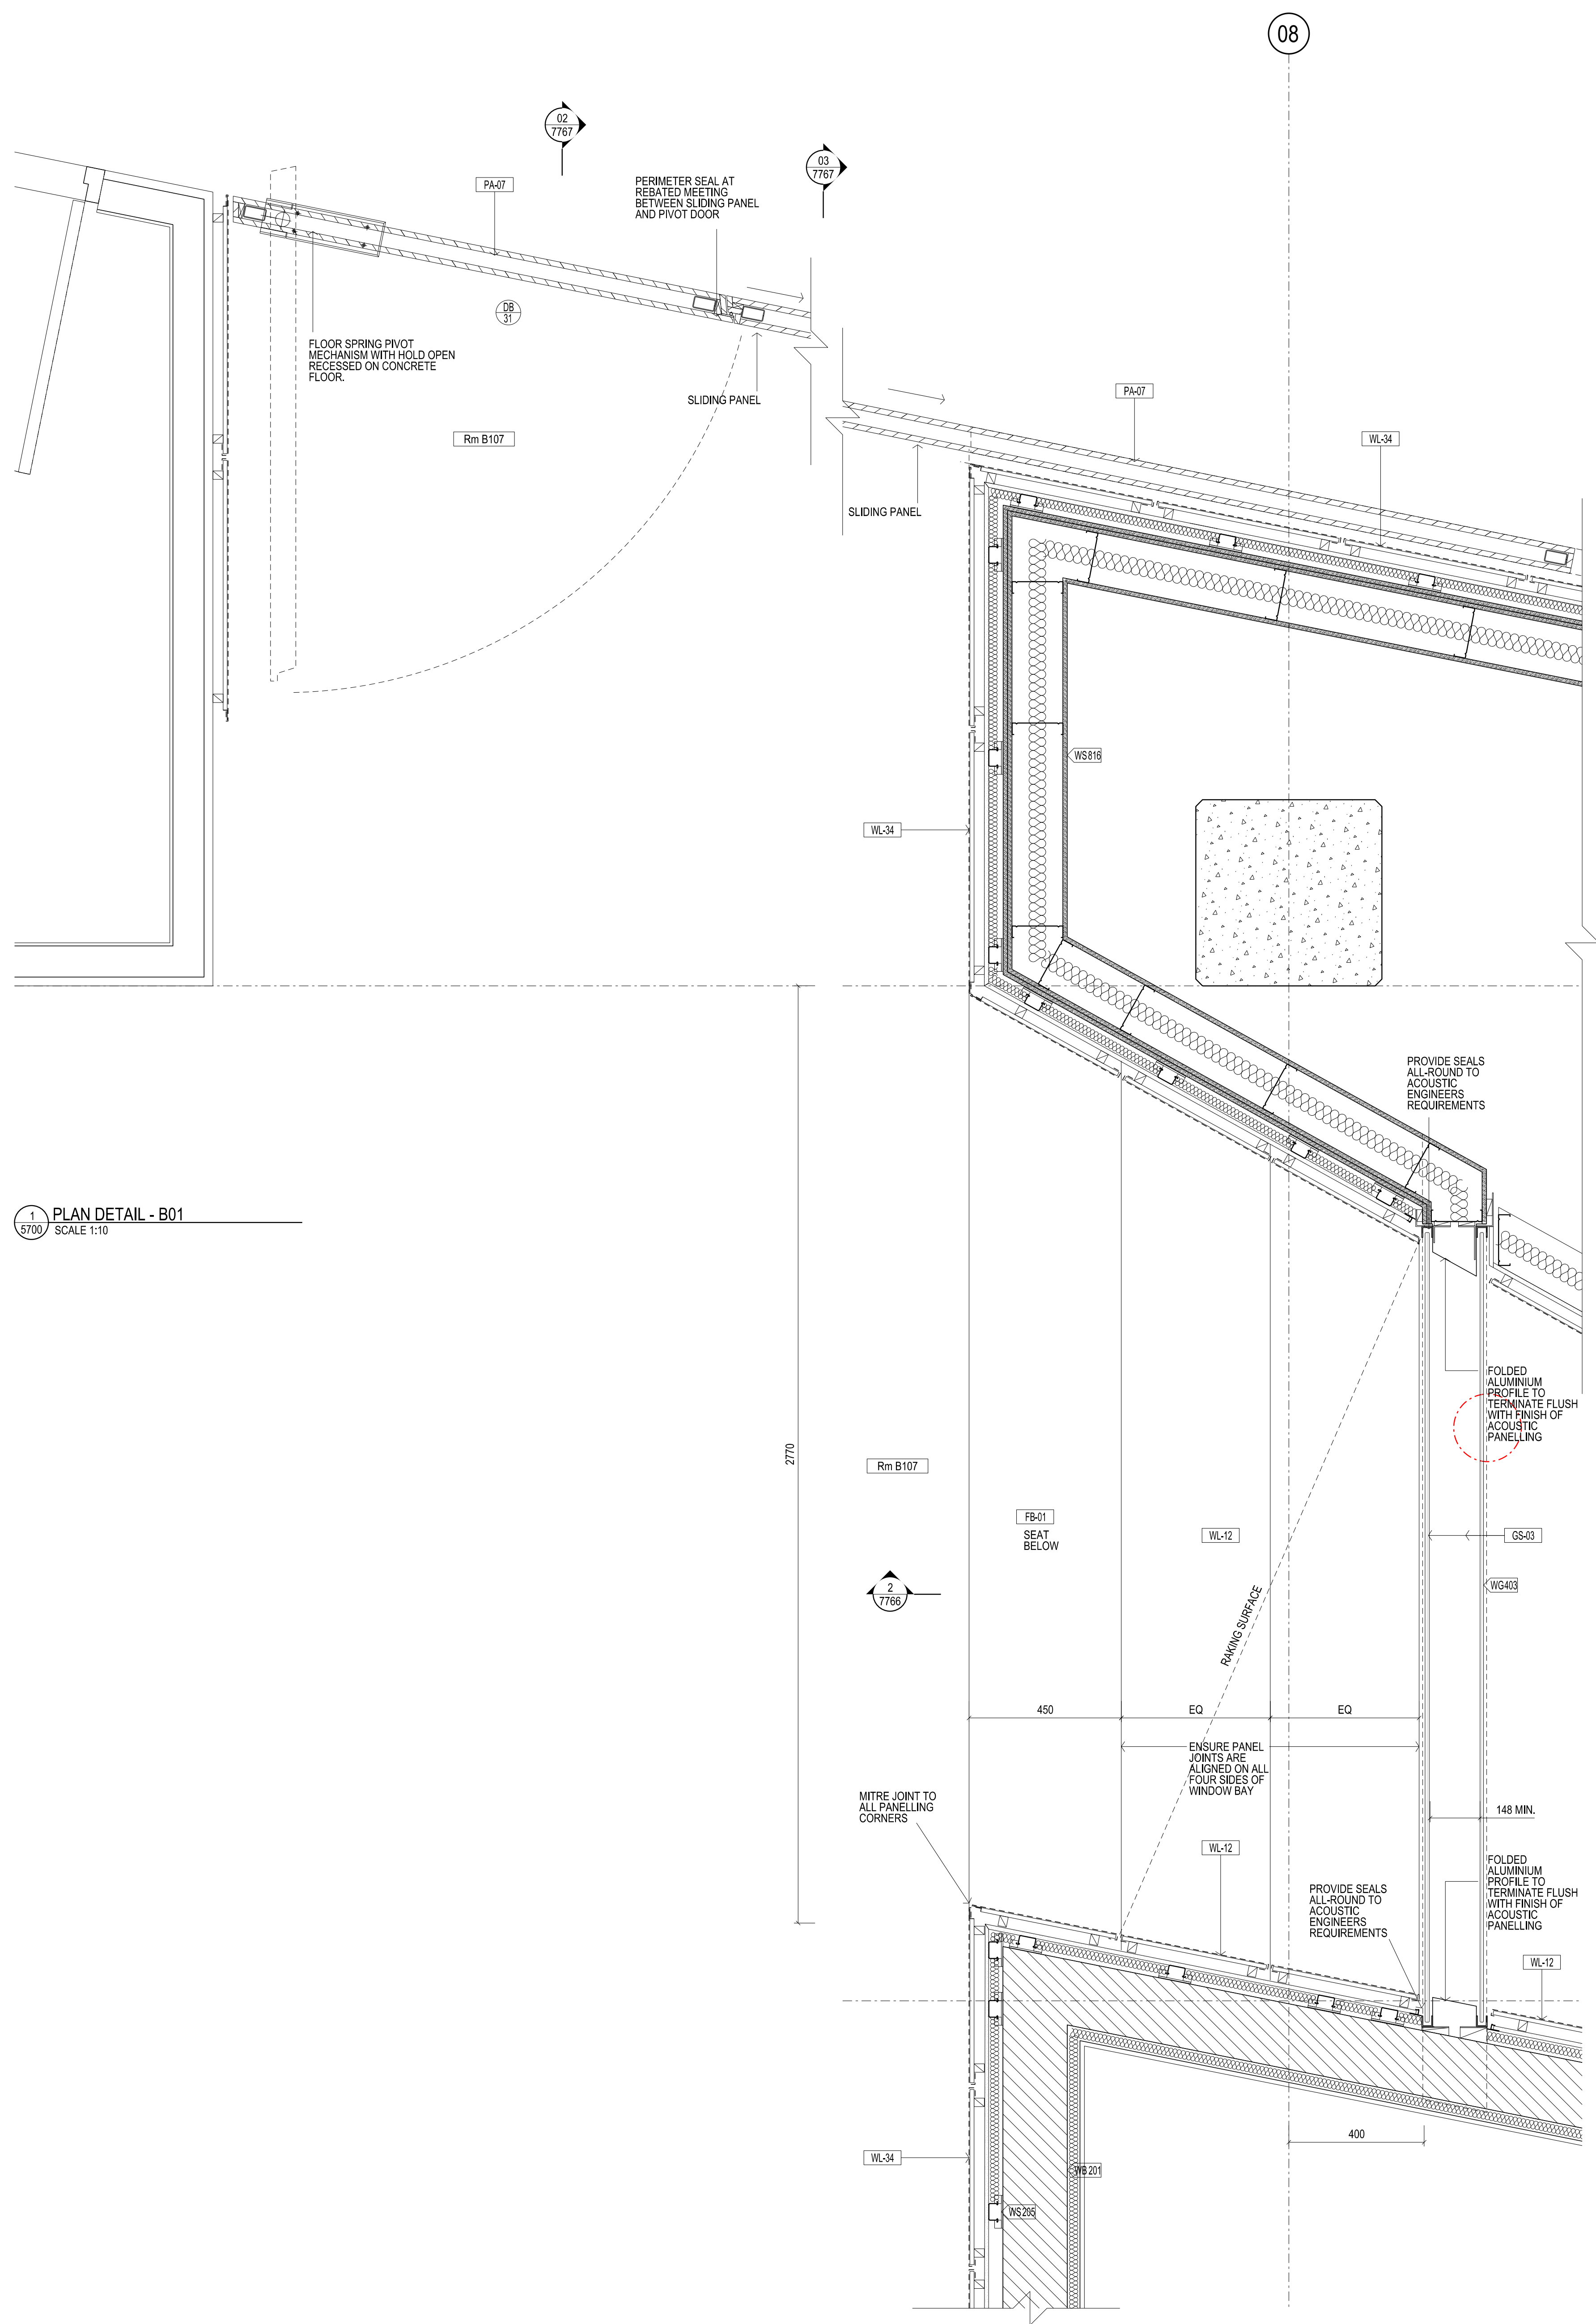

1 PLAN DETAIL - B01  
SCALE 1:10

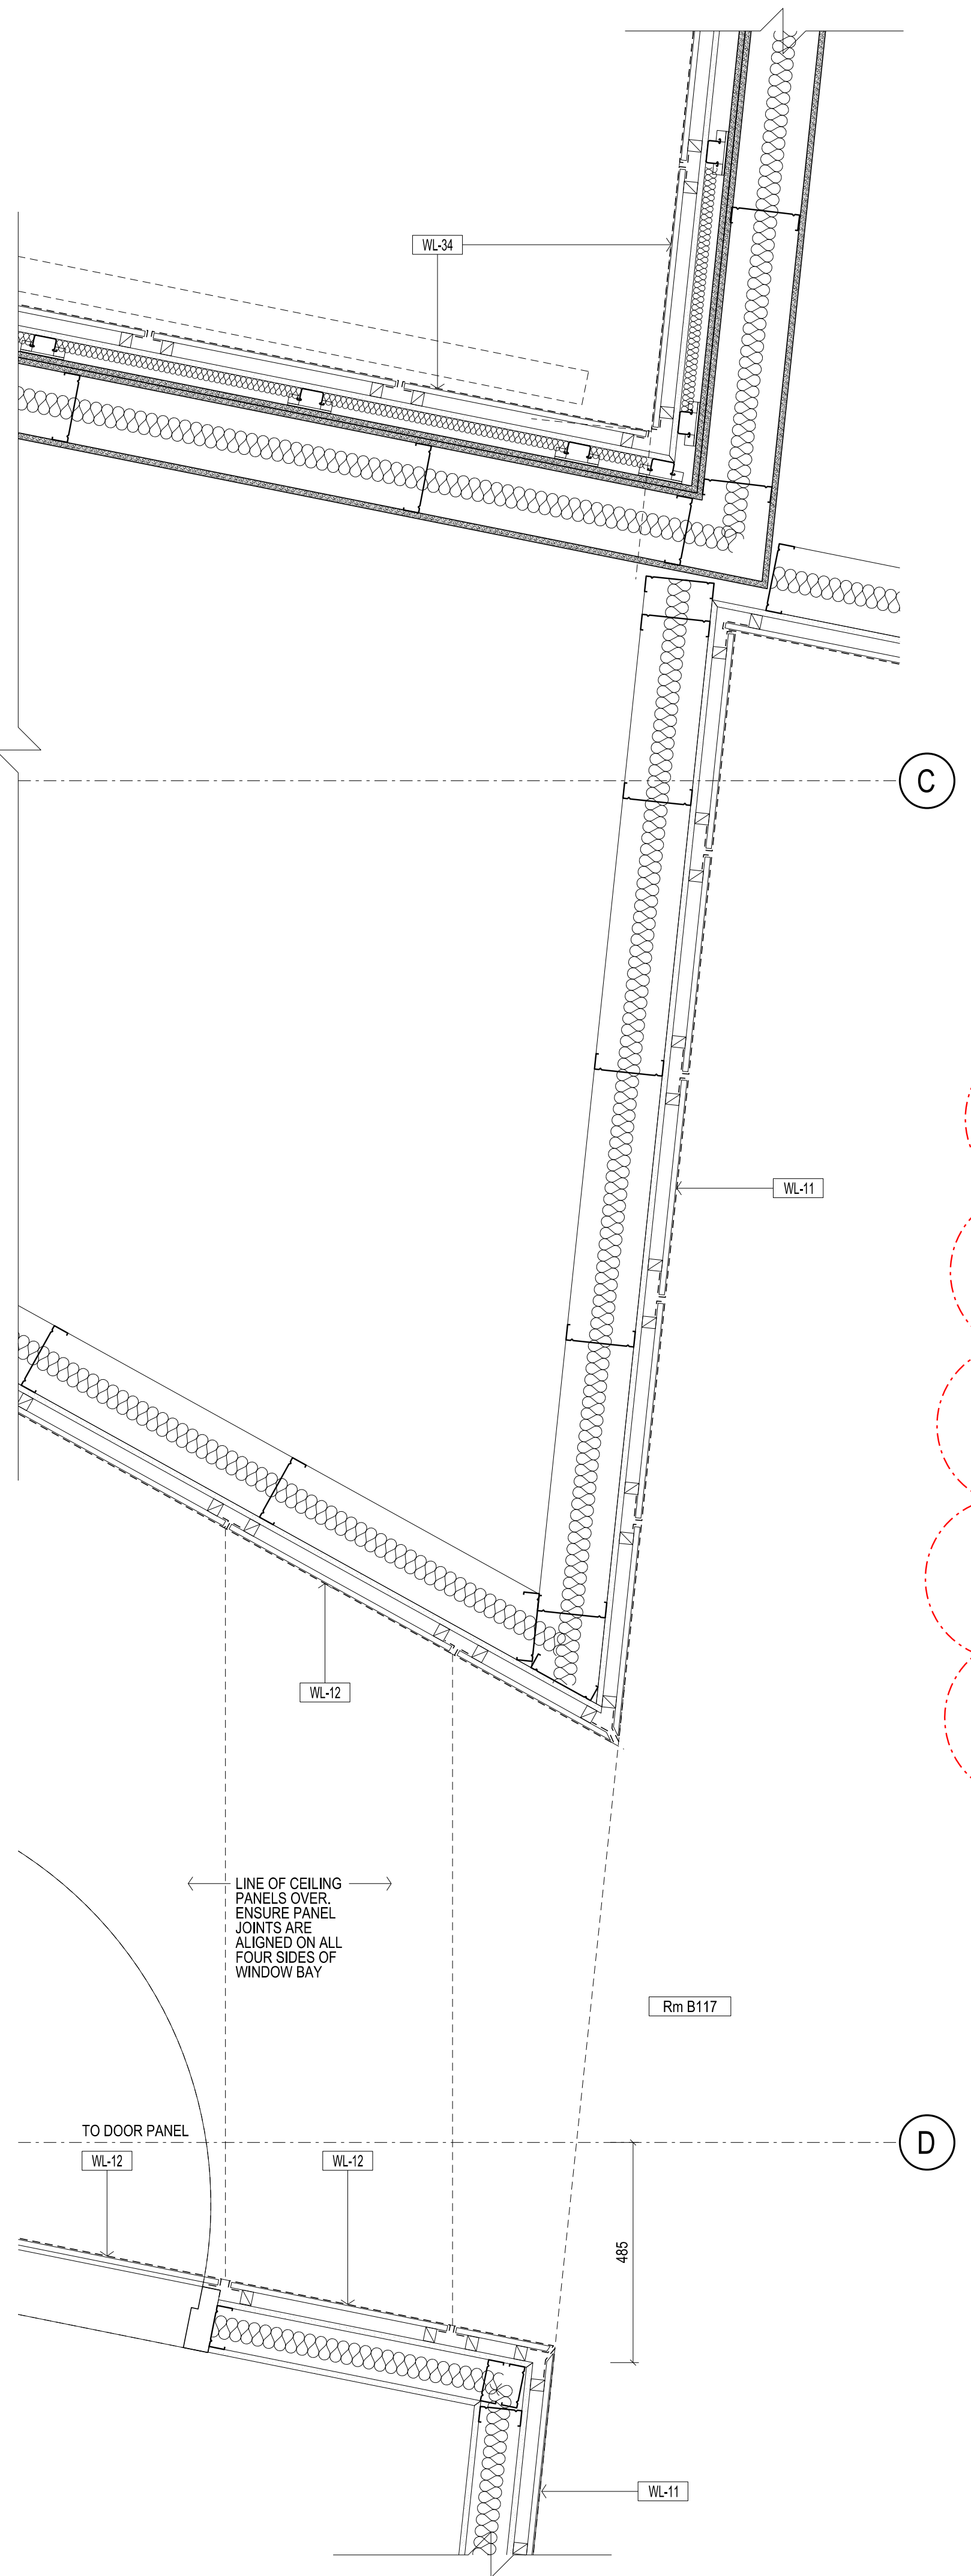

2 PLAN DETAIL - B01  
SCALE 1:10

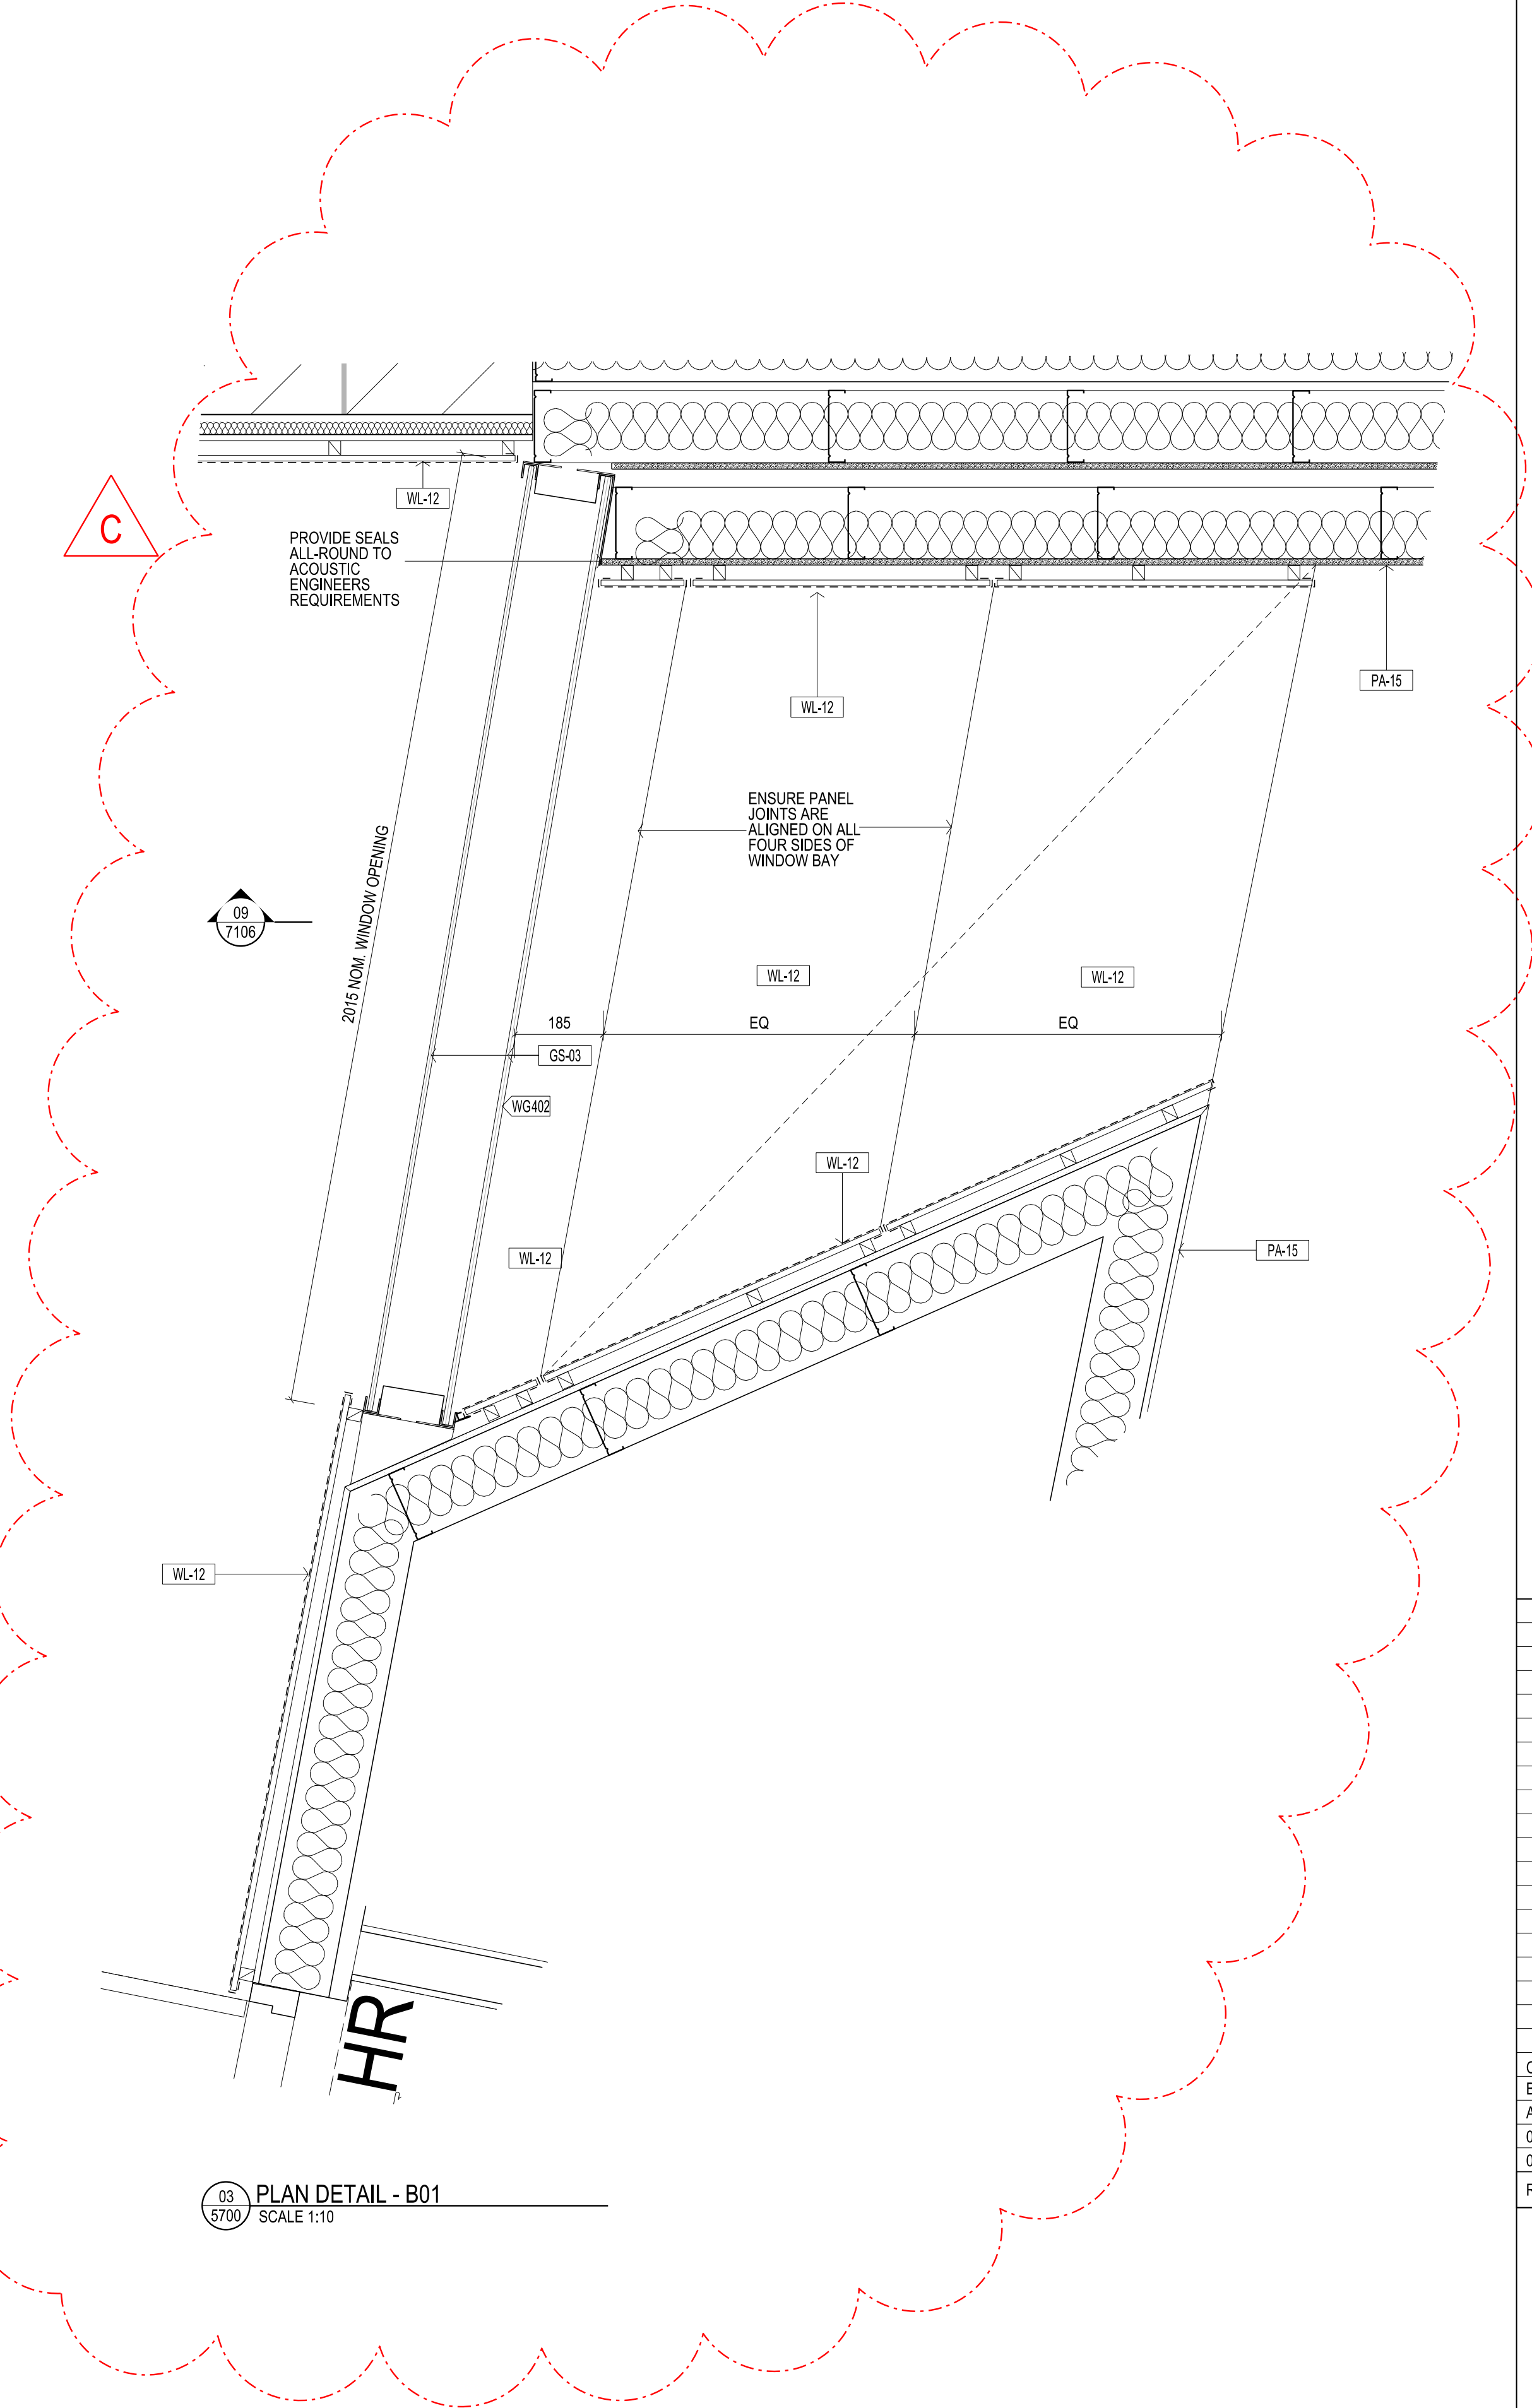

10 PLAN DETAIL - B01  
SCALE 1:10

Rev	Issue	Revision Description	And	Date
C	SG	UPDATES AS CLOUDED		03.02.14
B	SG	UPDATES AS CLOUDED		21.01.14
A	SG	BLOCKWORK REPLACED WITH STUDWORK		16.12.13
02	SG	100% CD - TENDER ISSUE		07.09.12
01	SG	95% CD ISSUE		10.08.12



**NADAAA**  
 NADAAA  
 1520 Washington Street No.2 Boston Massachusetts 02115 USA  
 Telephone +1 617 442 8232 Facsimile +1 688 442 1417 Email nadaa@nadaaa.com

**John Wardle Architects**  
 25 Rokeby Street, Collingwood, Victoria 3066 Australia  
 Tel: +61 3 8662 0400 www.johnwardlearchitects.com  
 © 2014 John Wardle Architects ABN 83 006 814 268

Client **University of Melbourne Parkville Campus**

Project **Faculty of Architecture Building and Planning**

Title **INTERNAL PLAN DETAILS B01 - SHEET 2**

Project No.	<b>0913</b>	Scale	1:10 @ A0 1:20 @ A2
Drawing No.	<b>AR 7701</b>	Revision	<b>C</b>

Date Jul 2012 Dwn - Co-Ord - Chk -

FILENAME - \$FILES

**FOR CONSTRUCTION**