


THIS DRAWING IS AN UNCONTROLLED COPY UNLESS STAMPED OTHERWISE

CONTRACTORS SHALL VERIFY DIMENSIONS BEFORE ANY JOB COMMENCES. ALL SHOP DRAWINGS SHALL BE SUBMITTED TO THE SUPERINTENDENT AND MANUFACTURER FOR APPROVAL PRIOR TO THE RETURN OF DIMENSIONS. DIMENSIONS SHOWN BY THE CONSULTANT SHALL TAKE PRECEDENCE OVER SCALES. THIS DRAWING SHALL BE READ IN CONJUNCTION WITH ALL RELEVANT CONTRACT SPECIFICATIONS AND DRAWINGS COPYRIGHT OF THIS DRAWING IS VESTED IN HANDLE.

General Notes

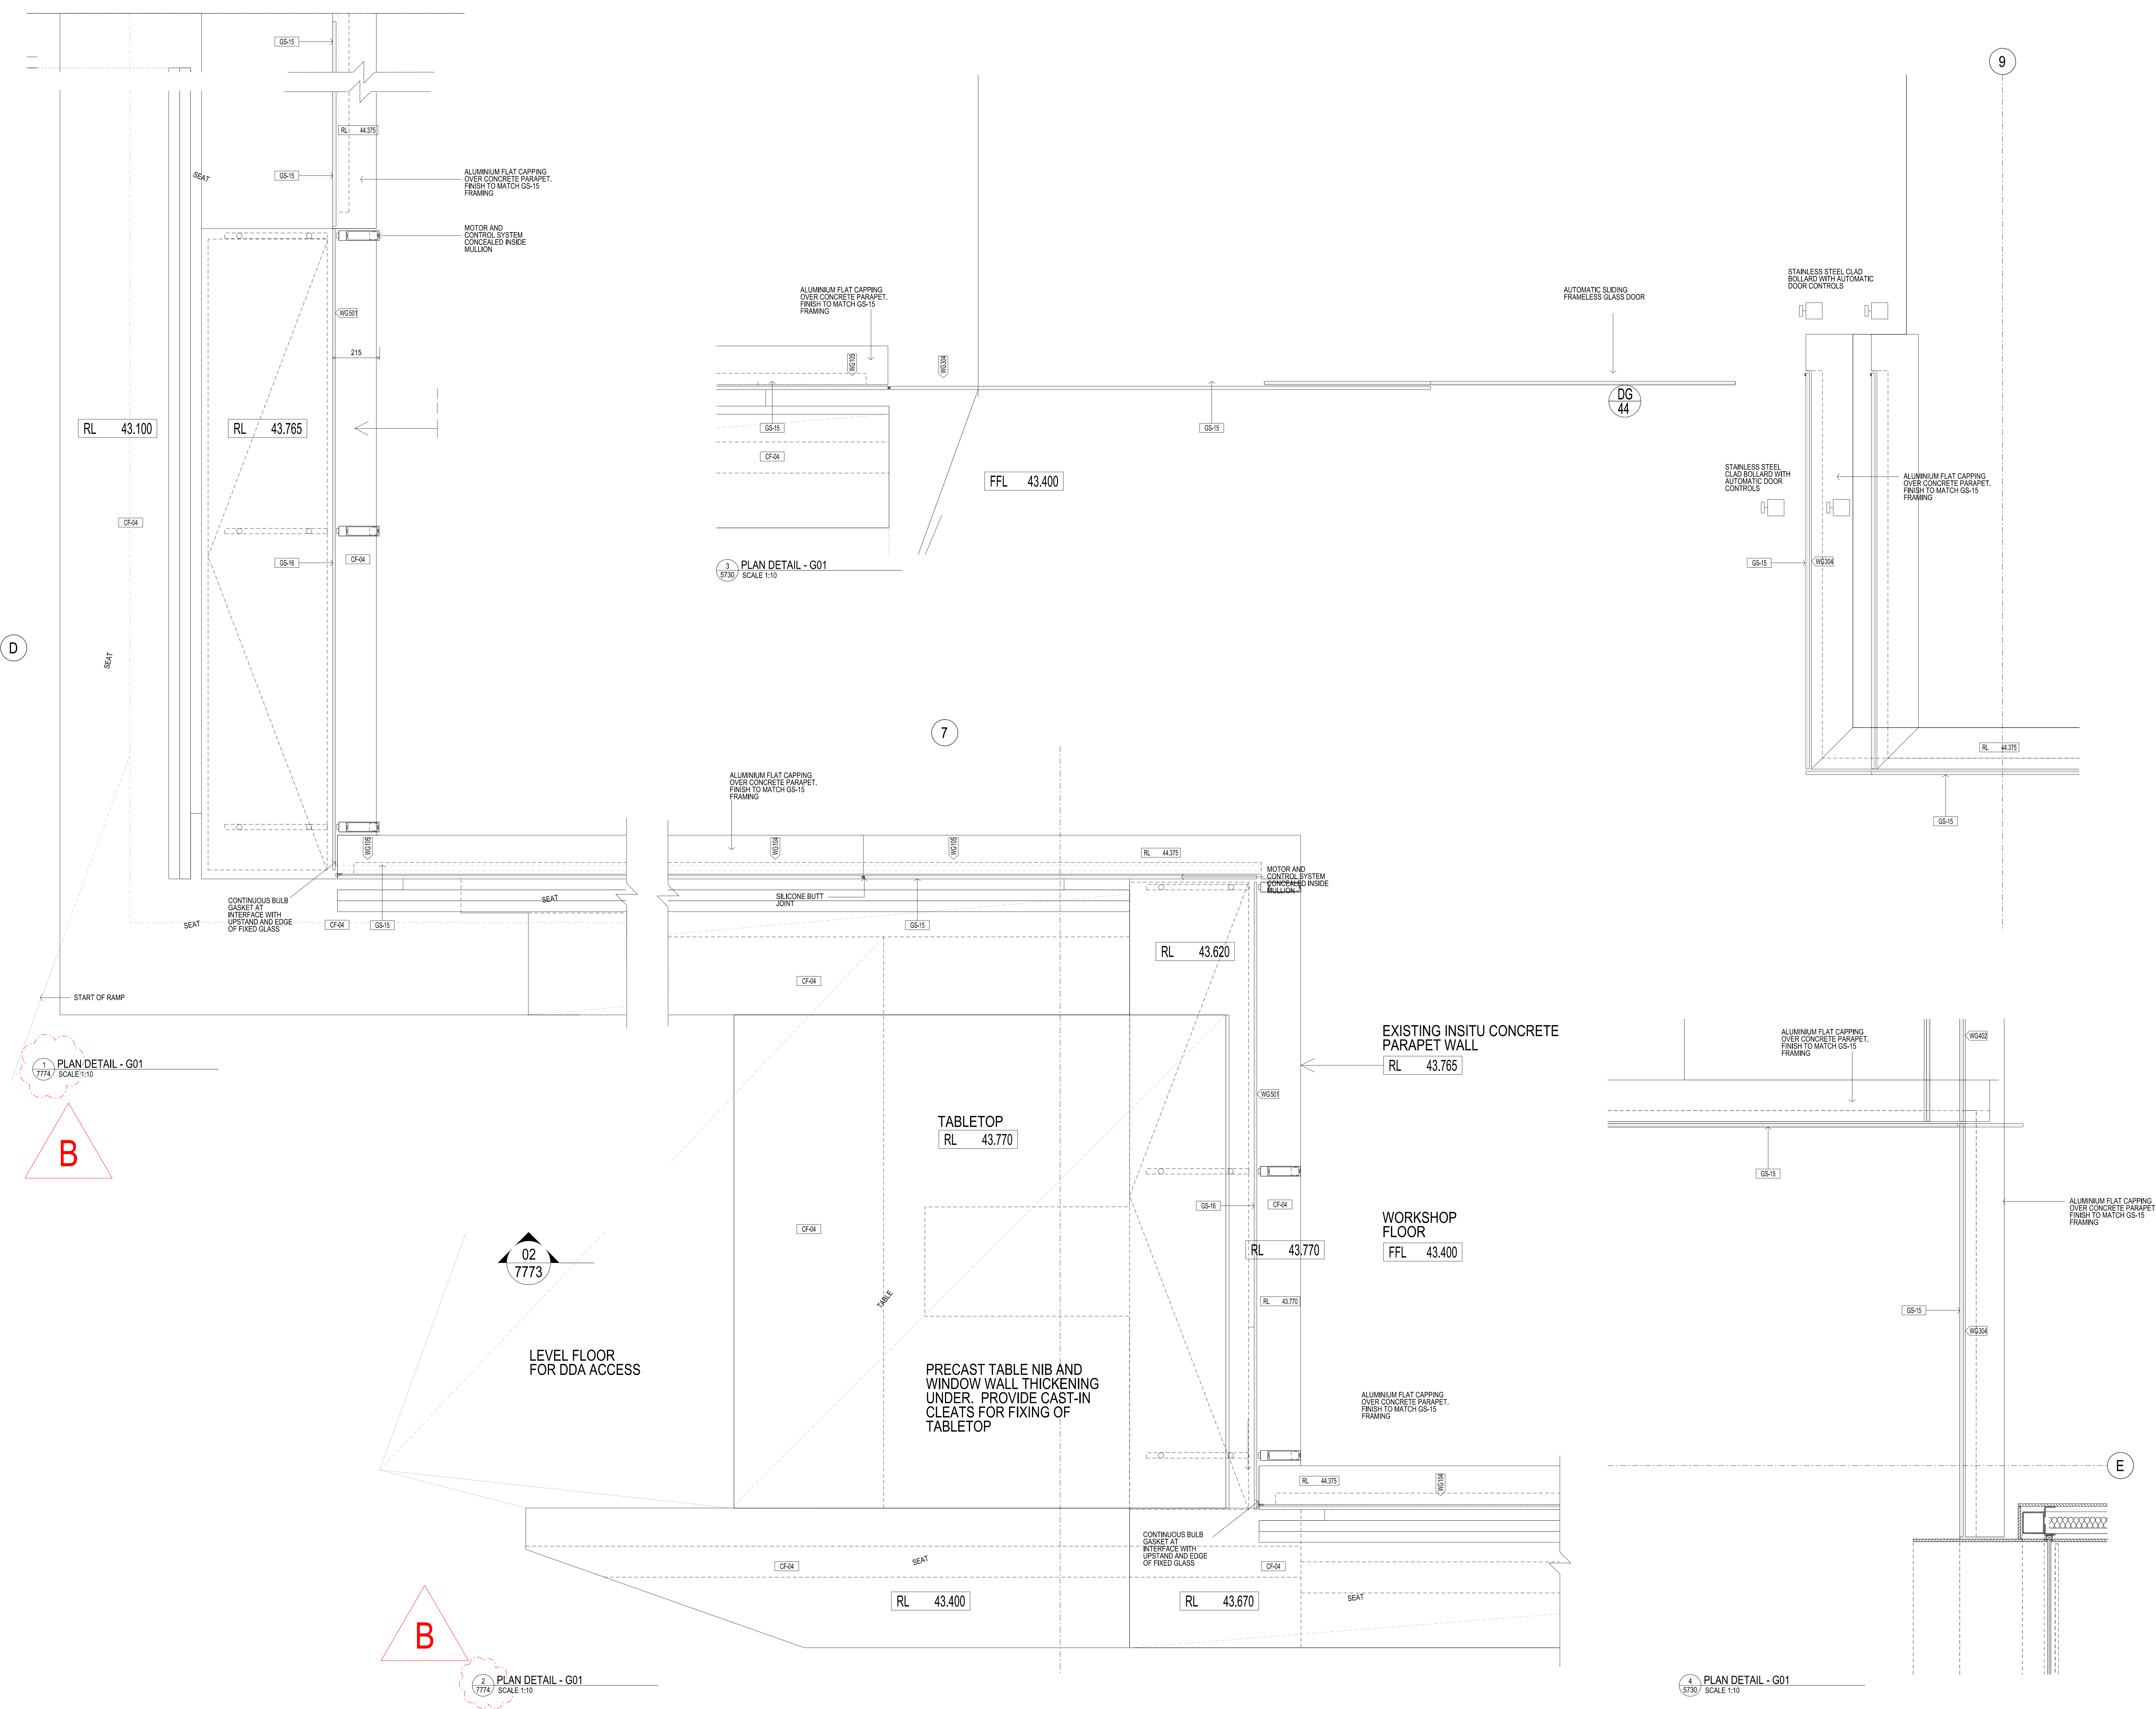

Rev	Issue	Revision Description	And	Date
B	SG	BENCH SEAT AMENDMENTS	-	06.12.13
A	SG	BENCH SEAT AMENDMENTS	-	27.11.13
02	SG	100% CD - TENDER ISSUE	-	07.09.12
01	SG	90% CD ISSUE	-	10.08.12



**NADAAA**  
 NADAAA  
 1520 Washington Street No.2 Boston Massachusetts 02118 USA  
 Telephone +1 617 442 8232 Facsimile +1 688 442 1417 Email nad@nadaaa.com

**John Wardle Architects**  
 25 Rokeby Street, Collingwood, Victoria 3066 Australia  
 Tel: +61 3 8662 0400 www.johnwardlearchitects.com  
 © 2012 John Wardle Architects ABN 83 006 814 268

Client: University of Melbourne Parkville Campus  
 Project: Faculty of Architecture Building and Planning  
 Title: INTERNAL PLAN DETAILS G01 - SHEET 1

Project No.	0913	Scale	1:10 @ A0 1:20 @ A2
Drawing No.	AR 7710	Revision	B
Date	Jul 2012	Dwn	
Co-Ord		Check	

FILENAME - \$FILES  
**FOR CONSTRUCTION**