



THIS DRAWING IS AN UNCONTROLLED COPY UNLESS STAMPED OTHERWISE

CONTRACTORS SHALL VERIFY JOB DIMENSIONS BEFORE ANY JOB COMMENCES. ALL SHOP DRAWINGS SHALL BE SUBMITTED TO THE SUPERINTENDENT AND MANUFACTURE SHALL NOT COMMENCE PRIOR TO THE RETURN OF DIMENSIONED SHOP DRAWINGS SIGNED BY THE CONSULTANT. FIGURED DIMENSIONS SHALL TAKE PRECEDENCE OVER SCALES. THIS DRAWING SHOULD BE READ IN CONJUNCTION WITH ALL RELEVANT CONTRACT SPECIFICATIONS AND DRAWINGS COPYRIGHT OF THIS DRAWING IS VESTED IN WARDLE


General Notes

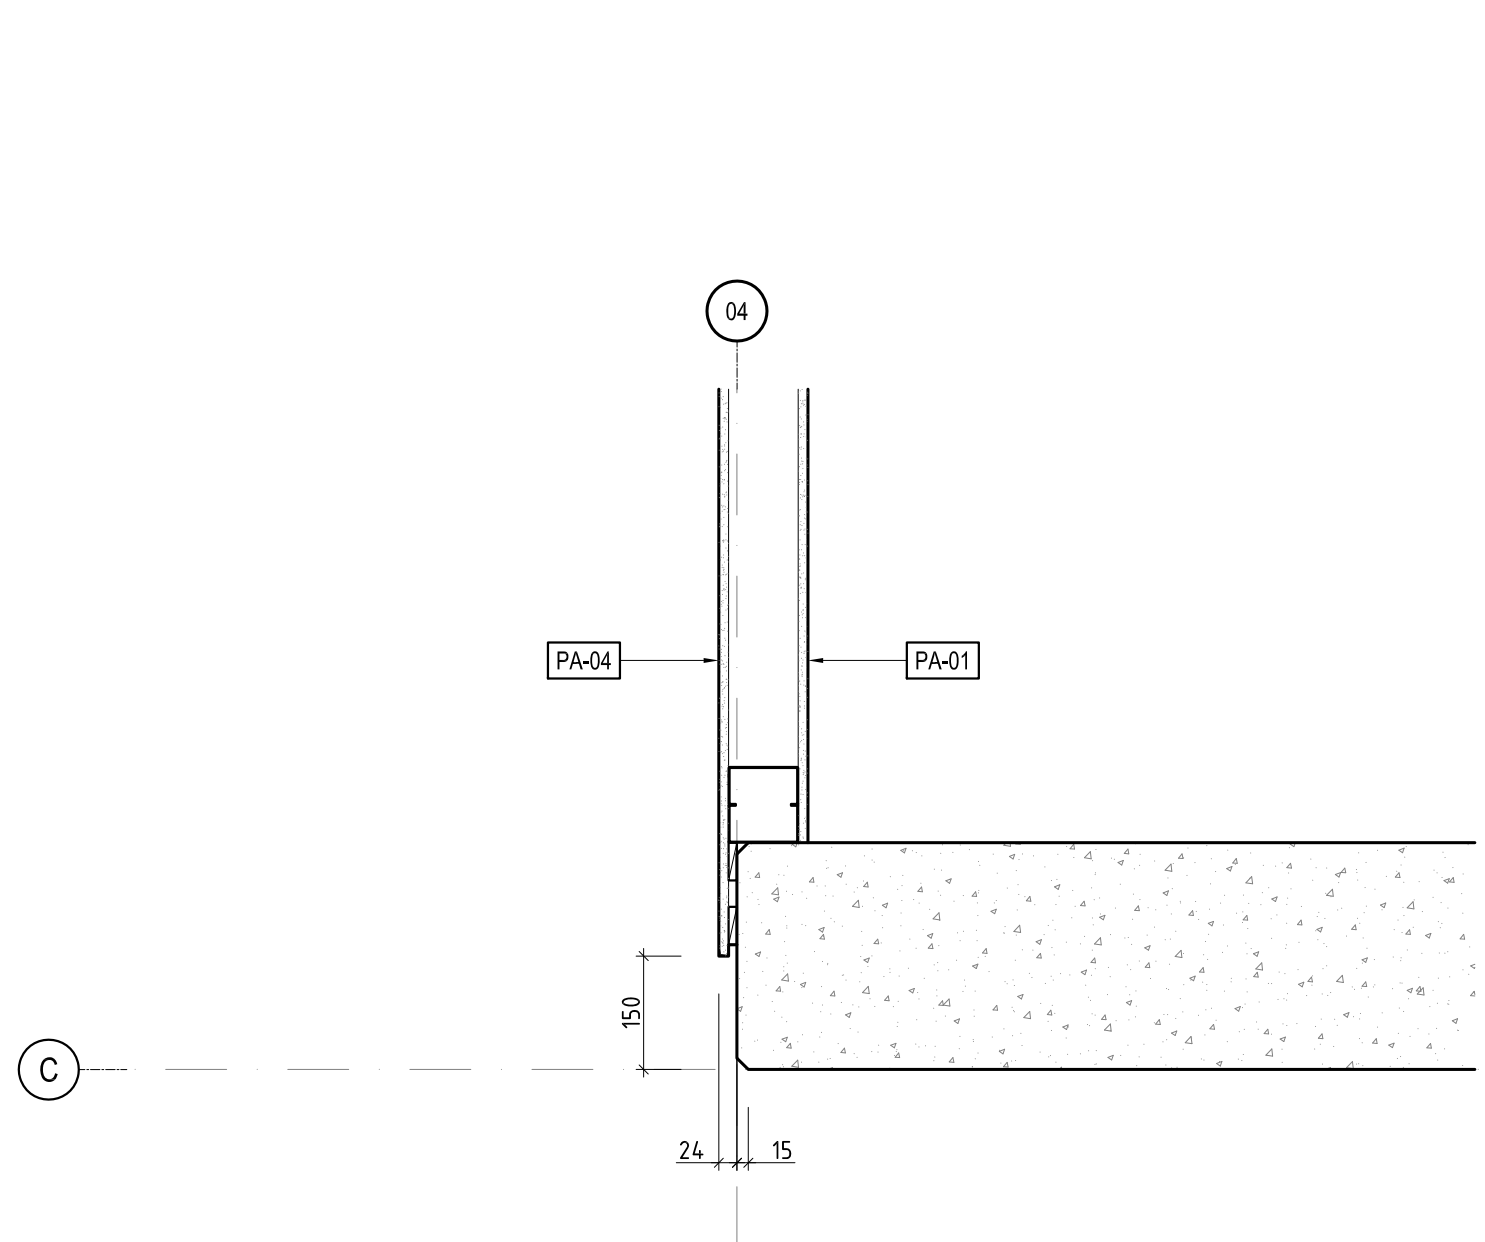


17 PLAN DETAIL - LINING @ WEST SIDE OF NW CORE  
SCALE: 1:10

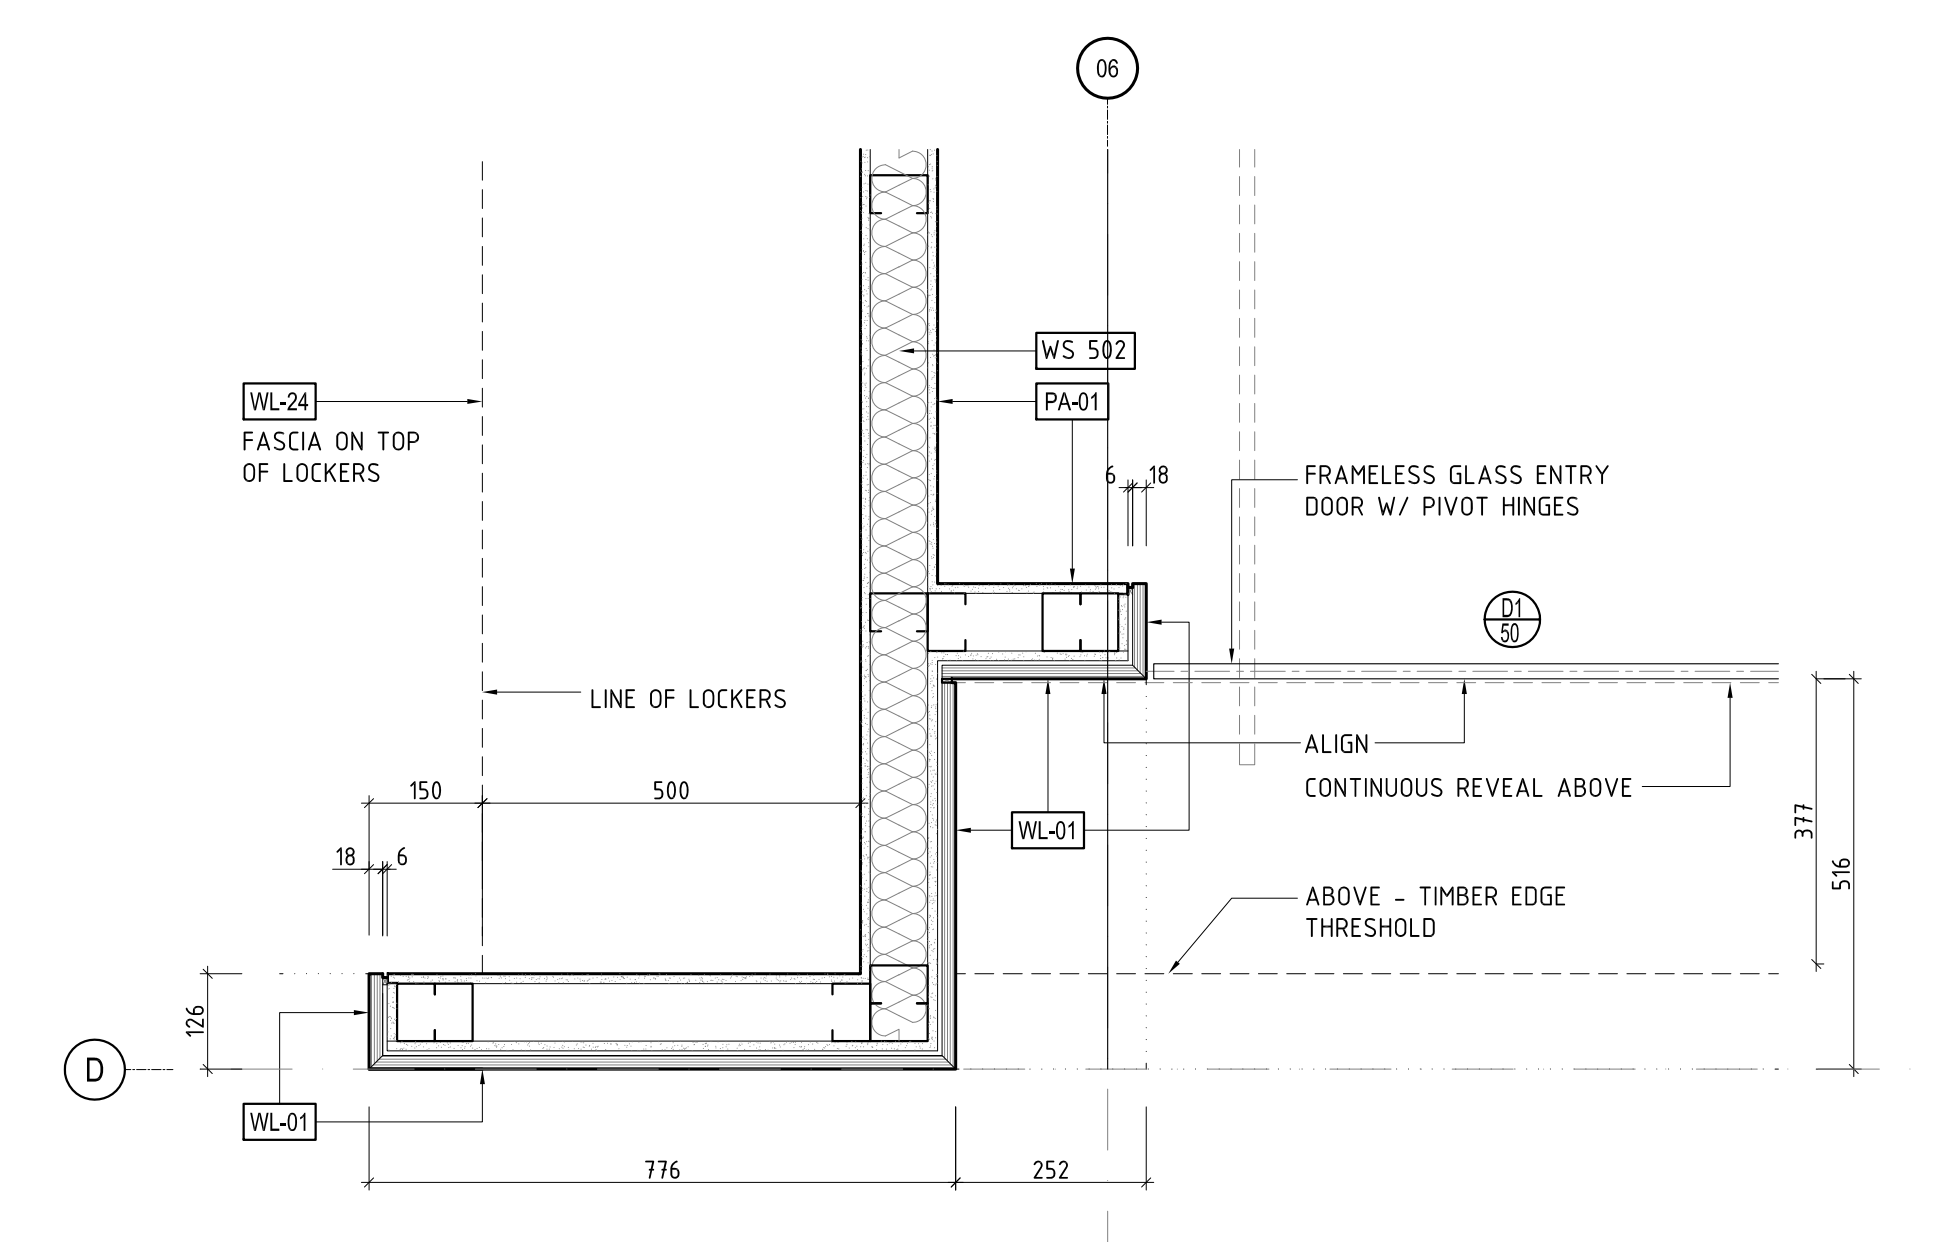


16 PLAN DETAIL - L01 NORTH EDGE @ HALL - PRINT ROOM  
SCALE: 1:10

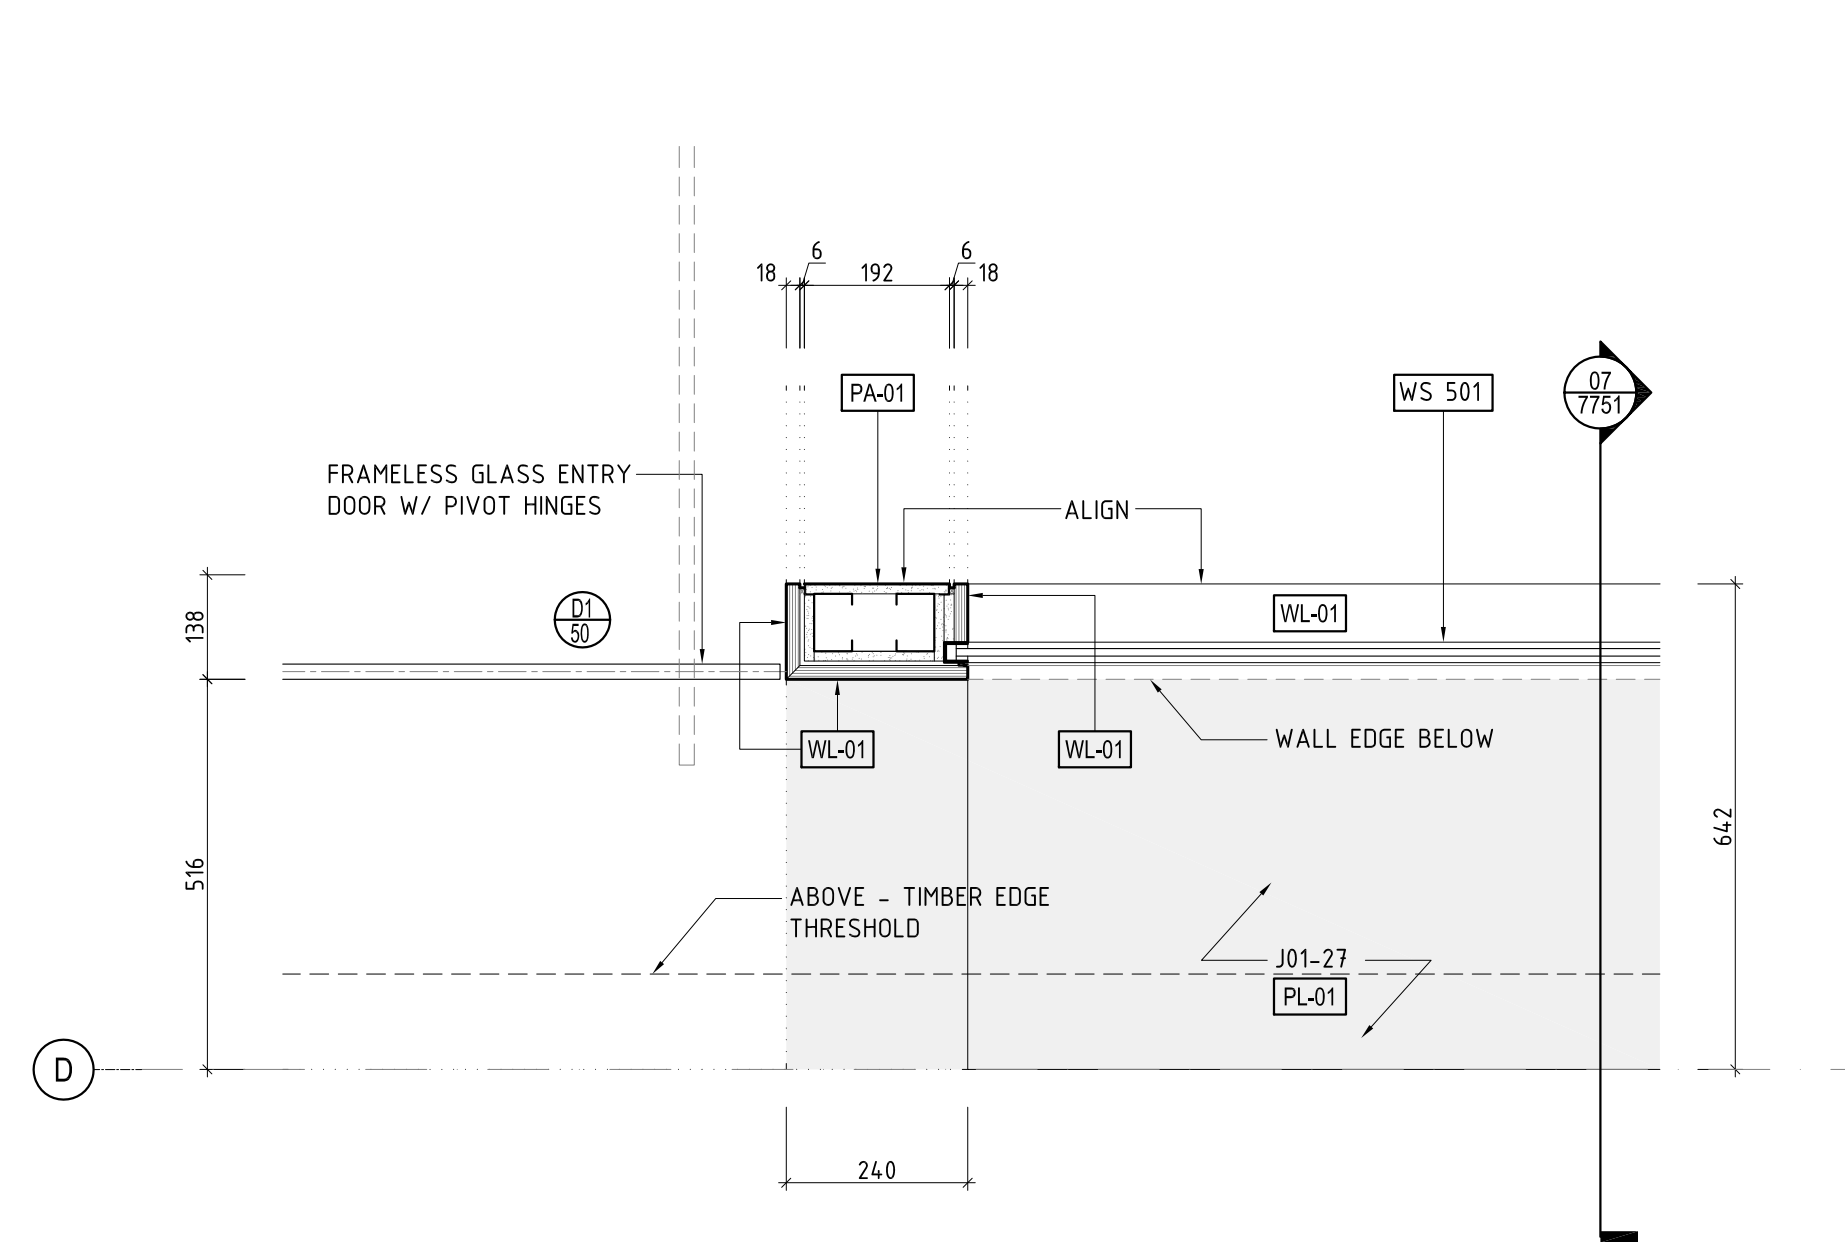


15 PLAN DETAIL - L01 NORTH EDGE @ HALL - PRINT ROOM  
SCALE: 1:10

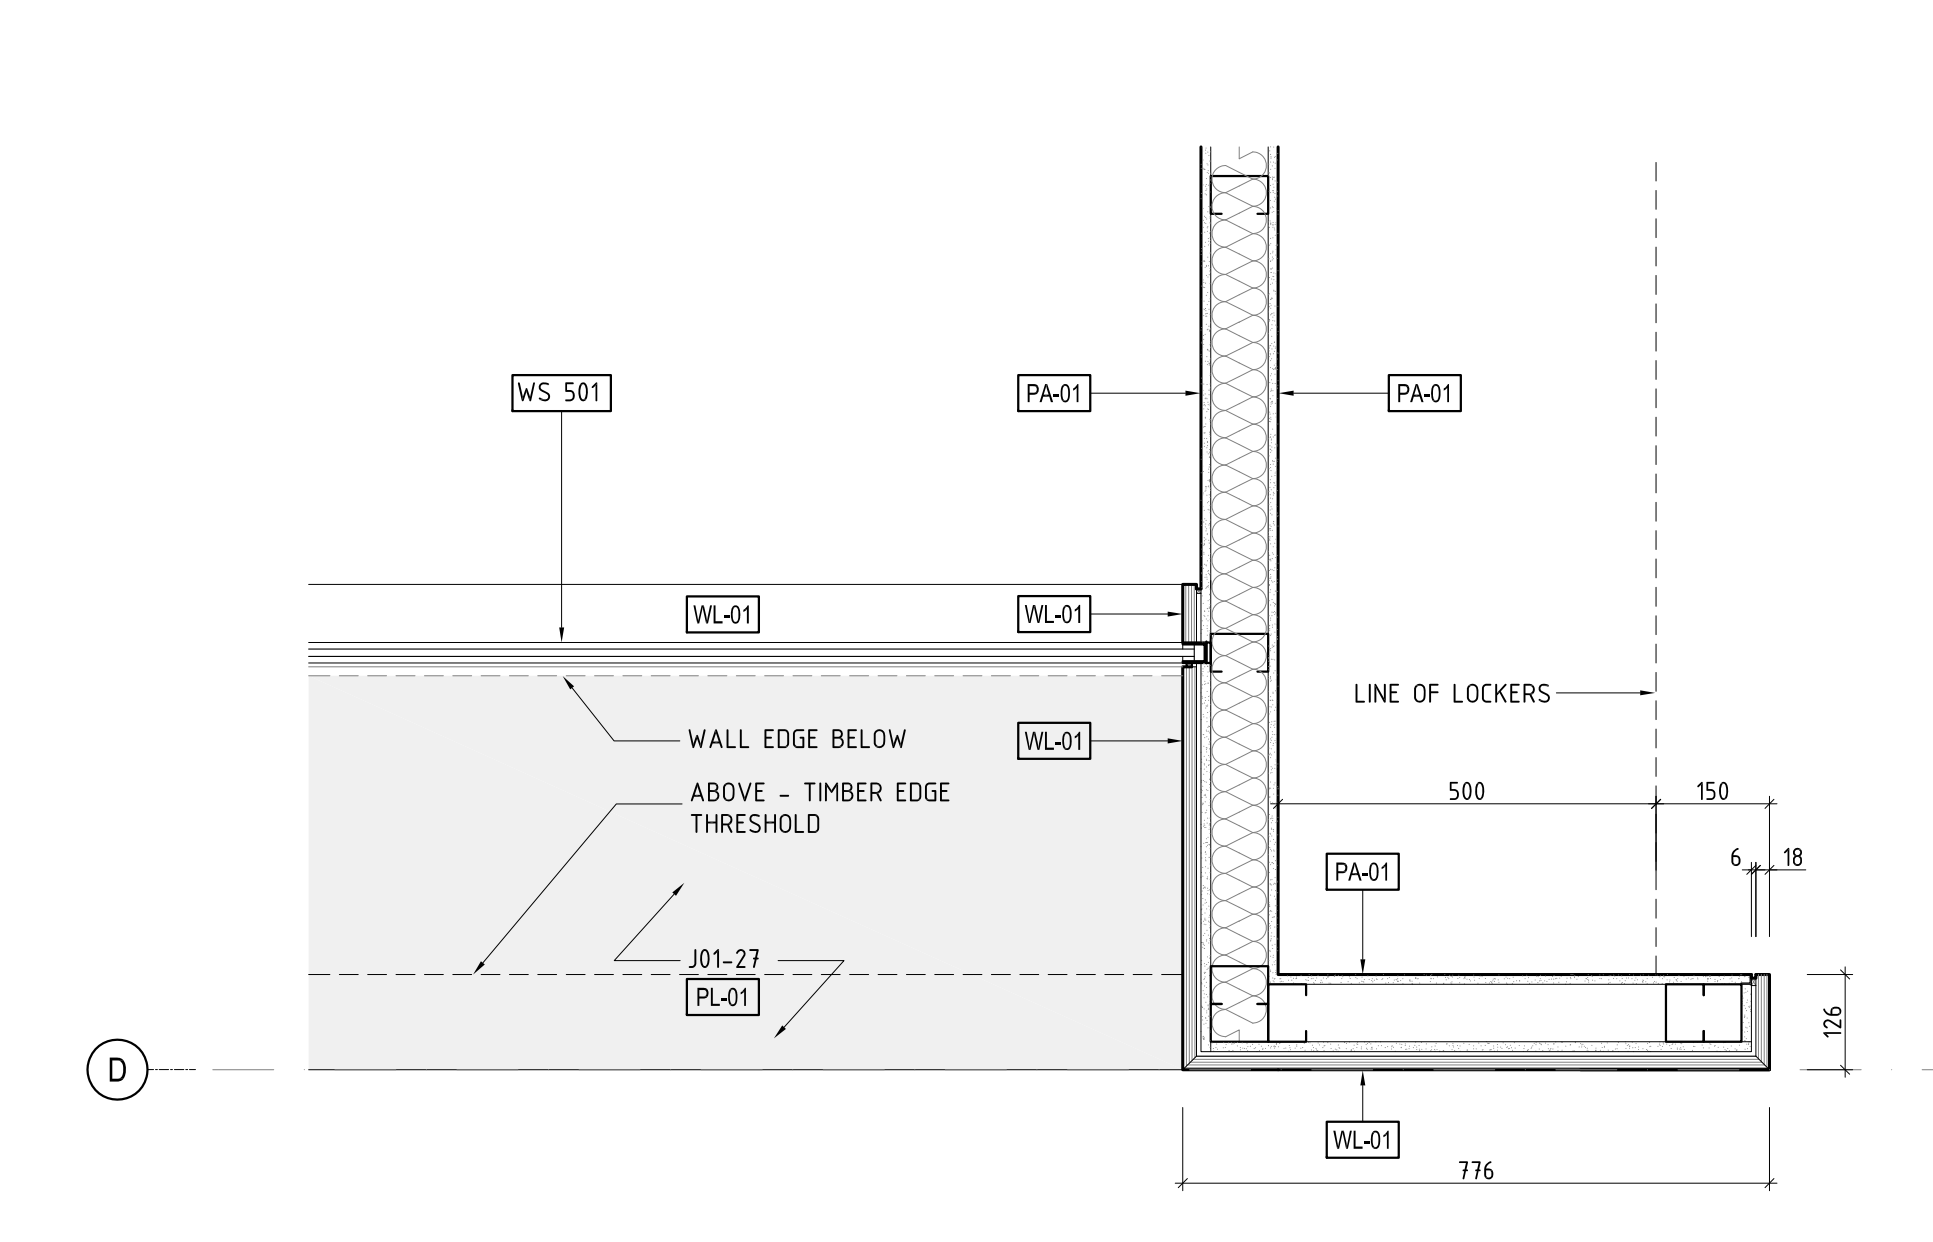


14 PLAN DETAIL - L01 NORTH EDGE @ HALL - PRINT ROOM  
SCALE: 1:10

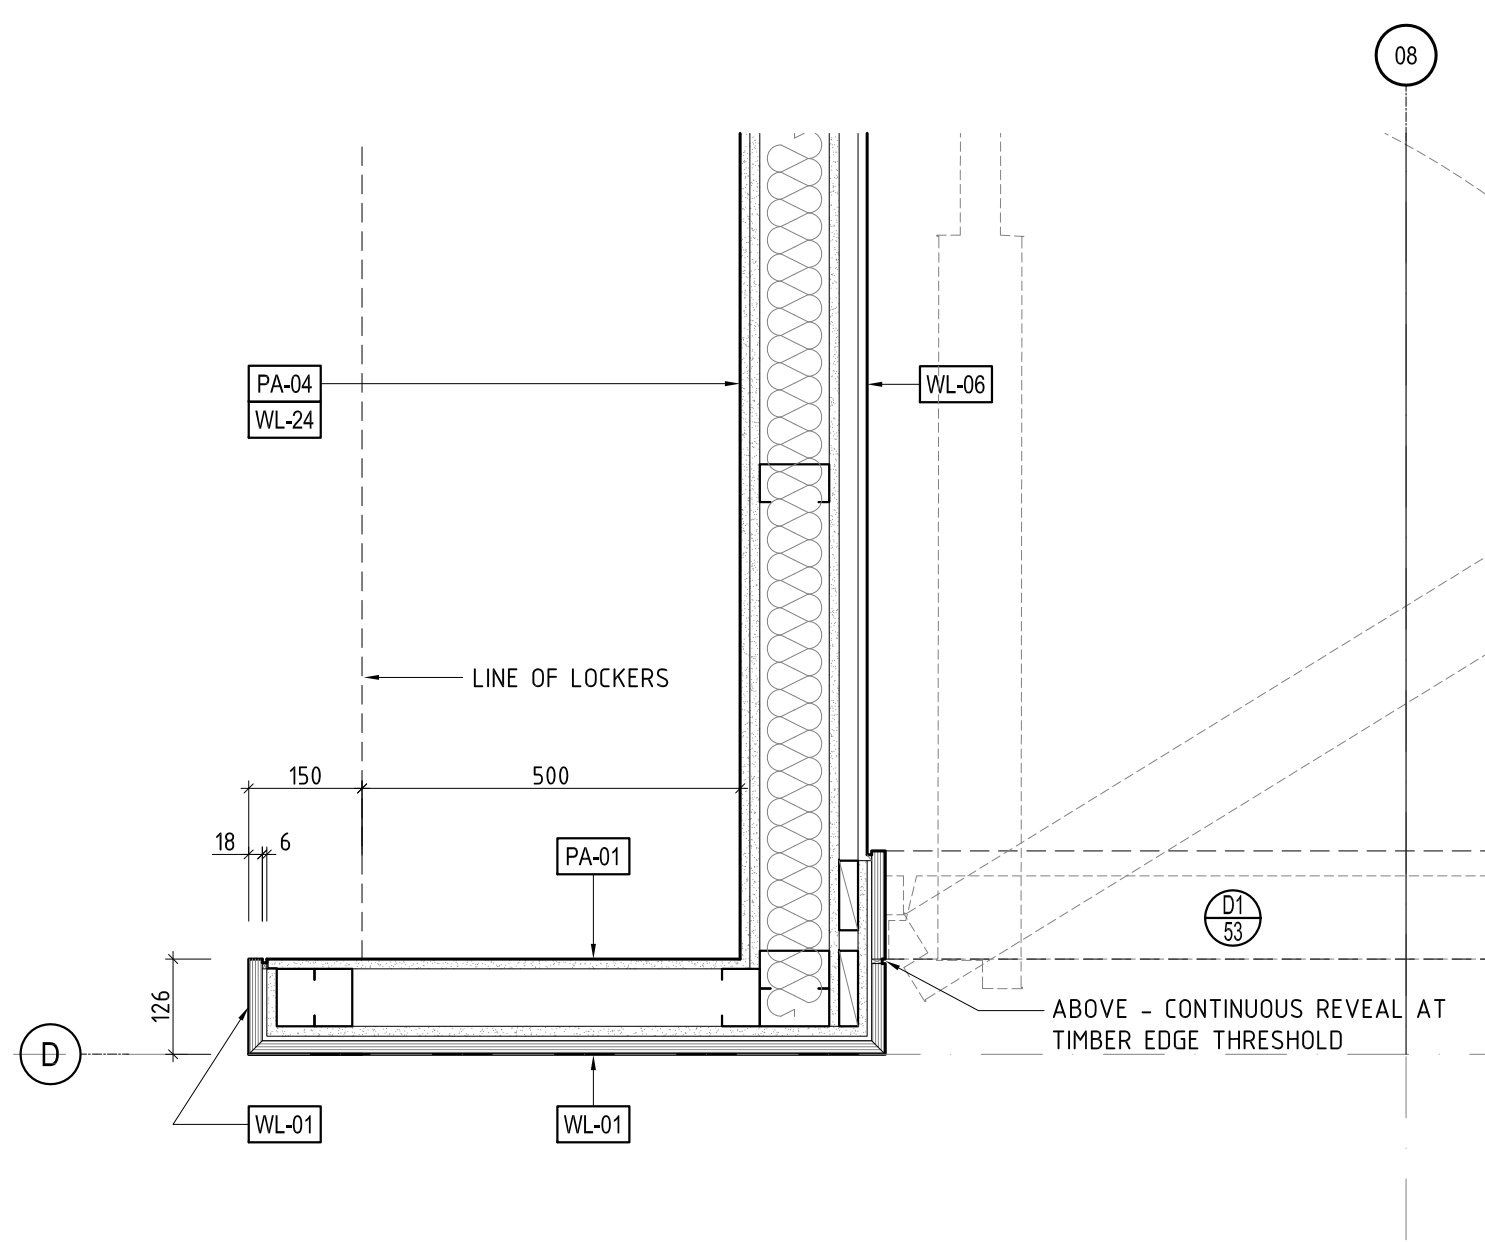


13 PLAN DETAIL - L01 NORTH EDGE @ HALL - CAD LAB  
SCALE: 1:10

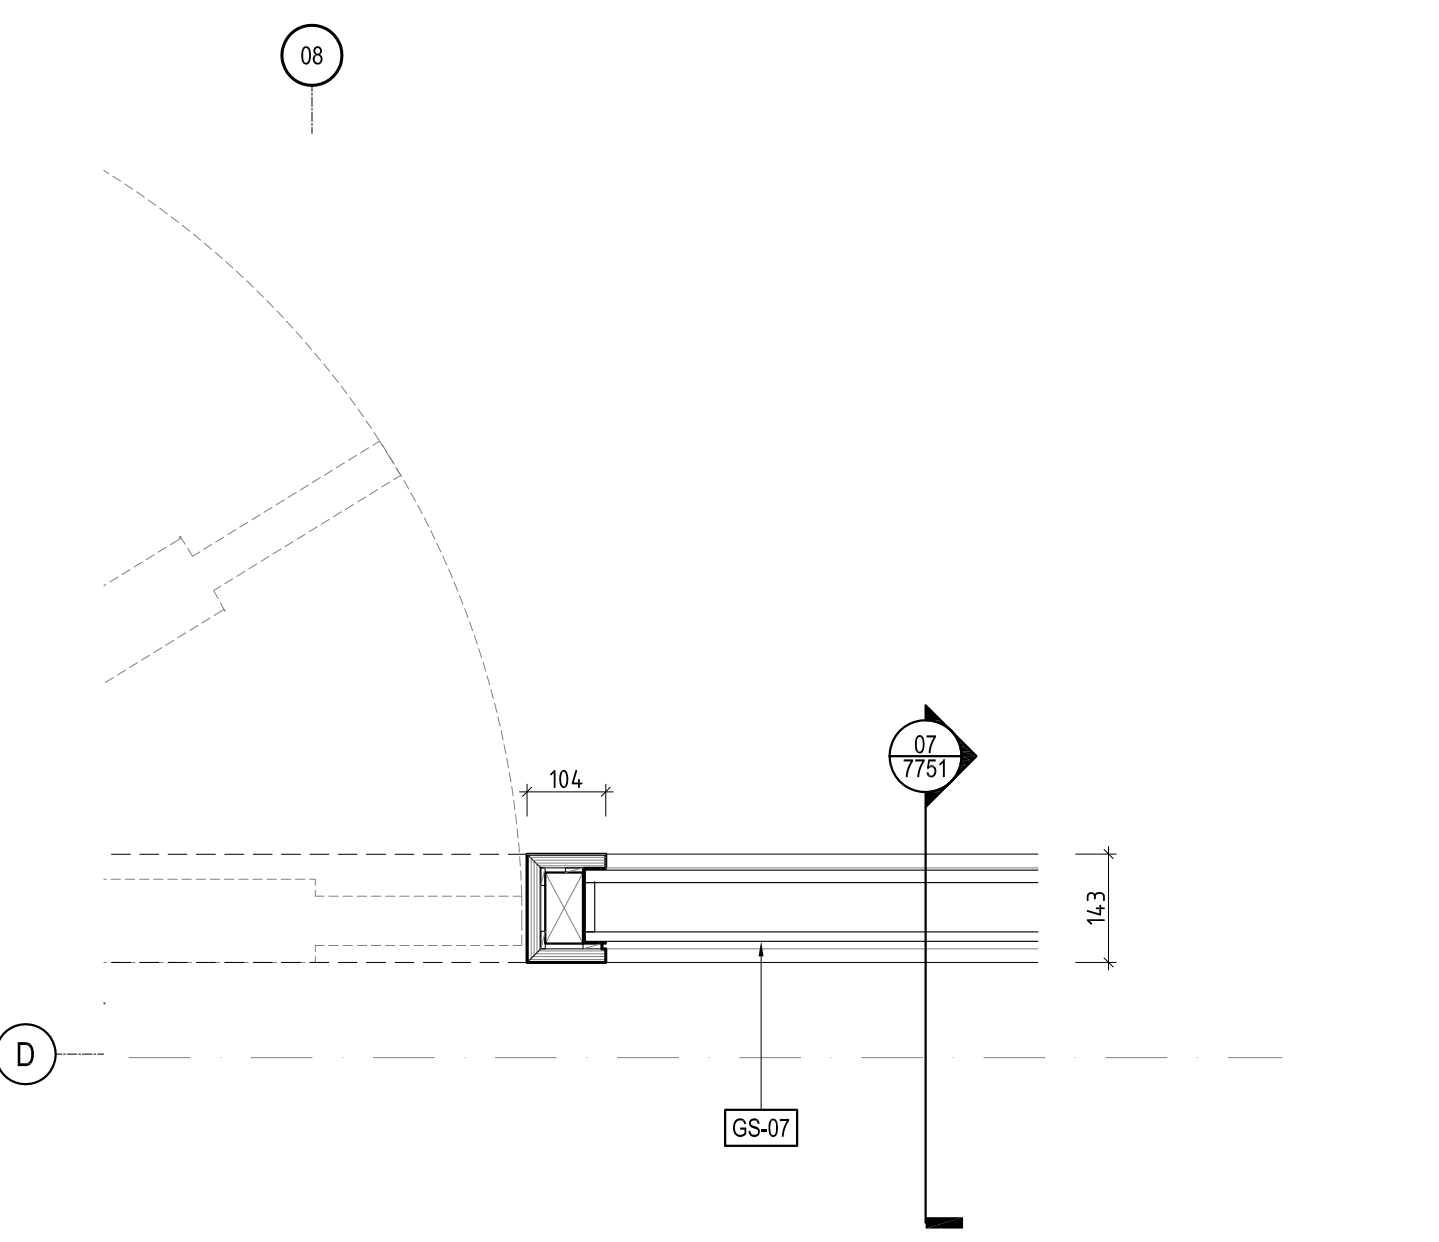


12 PLAN DETAIL - PLAN DETAIL - L01 NORTH EDGE @ HALL - CAD LAB  
SCALE: 1:10

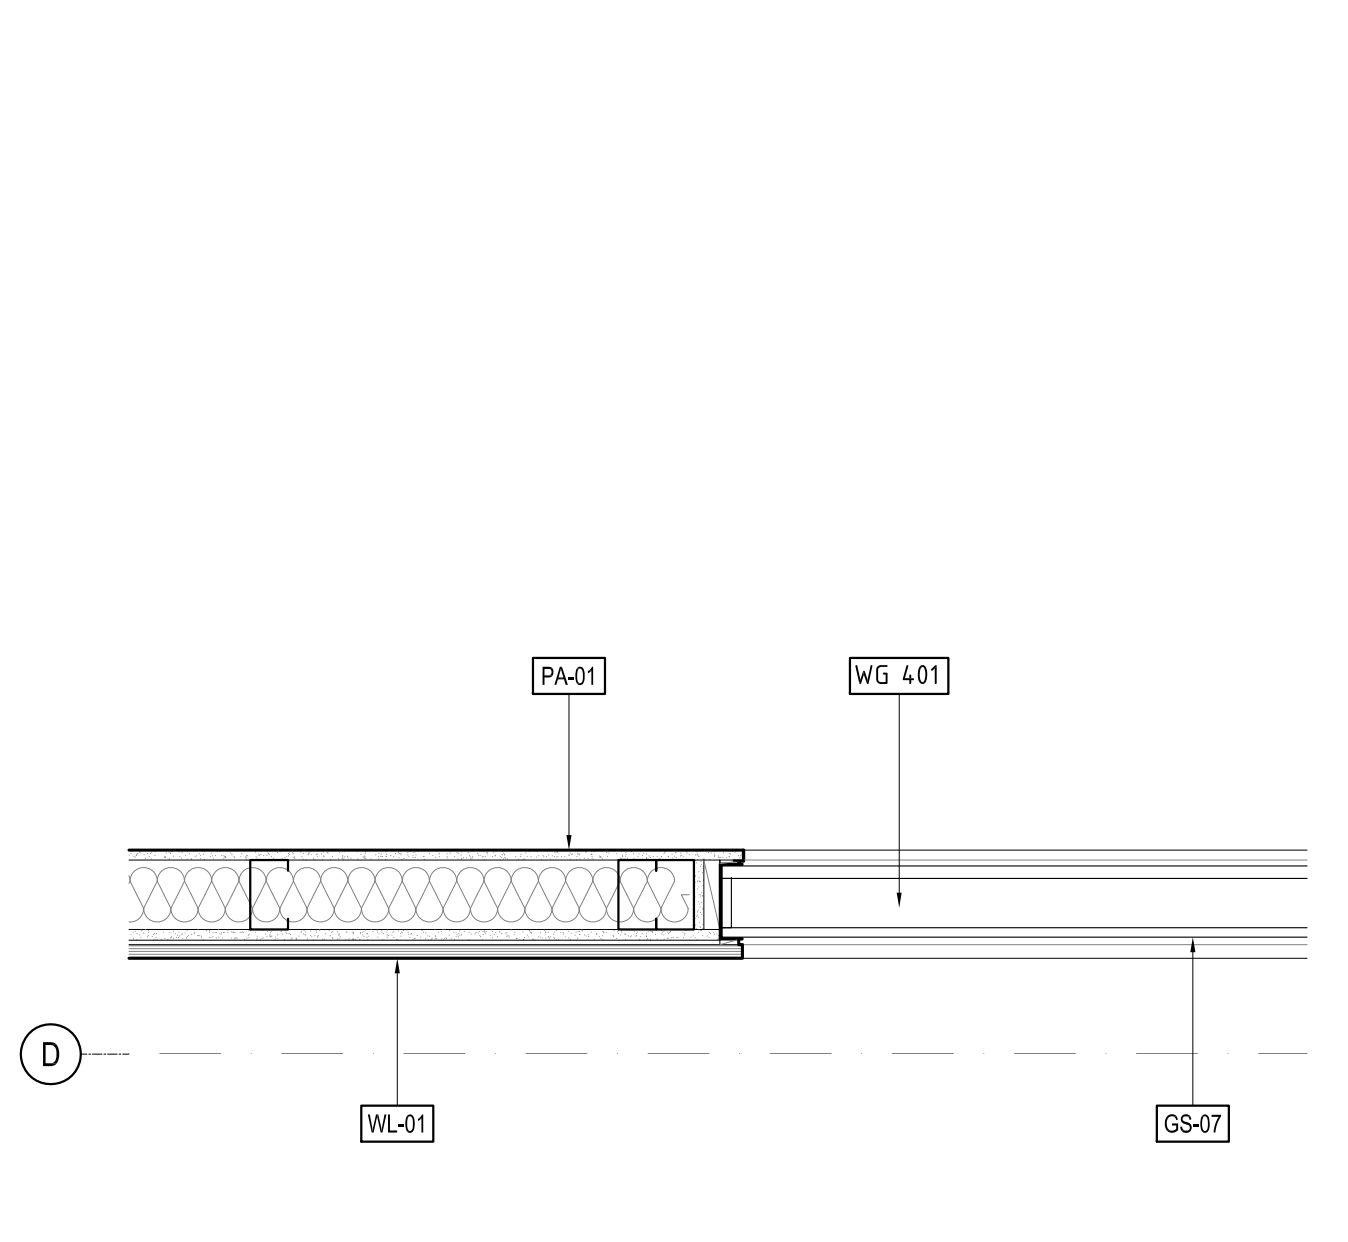


11 PLAN DETAIL - PLAN DETAIL - L01 NORTH EDGE @ HALL - CAD LAB  
SCALE: 1:10

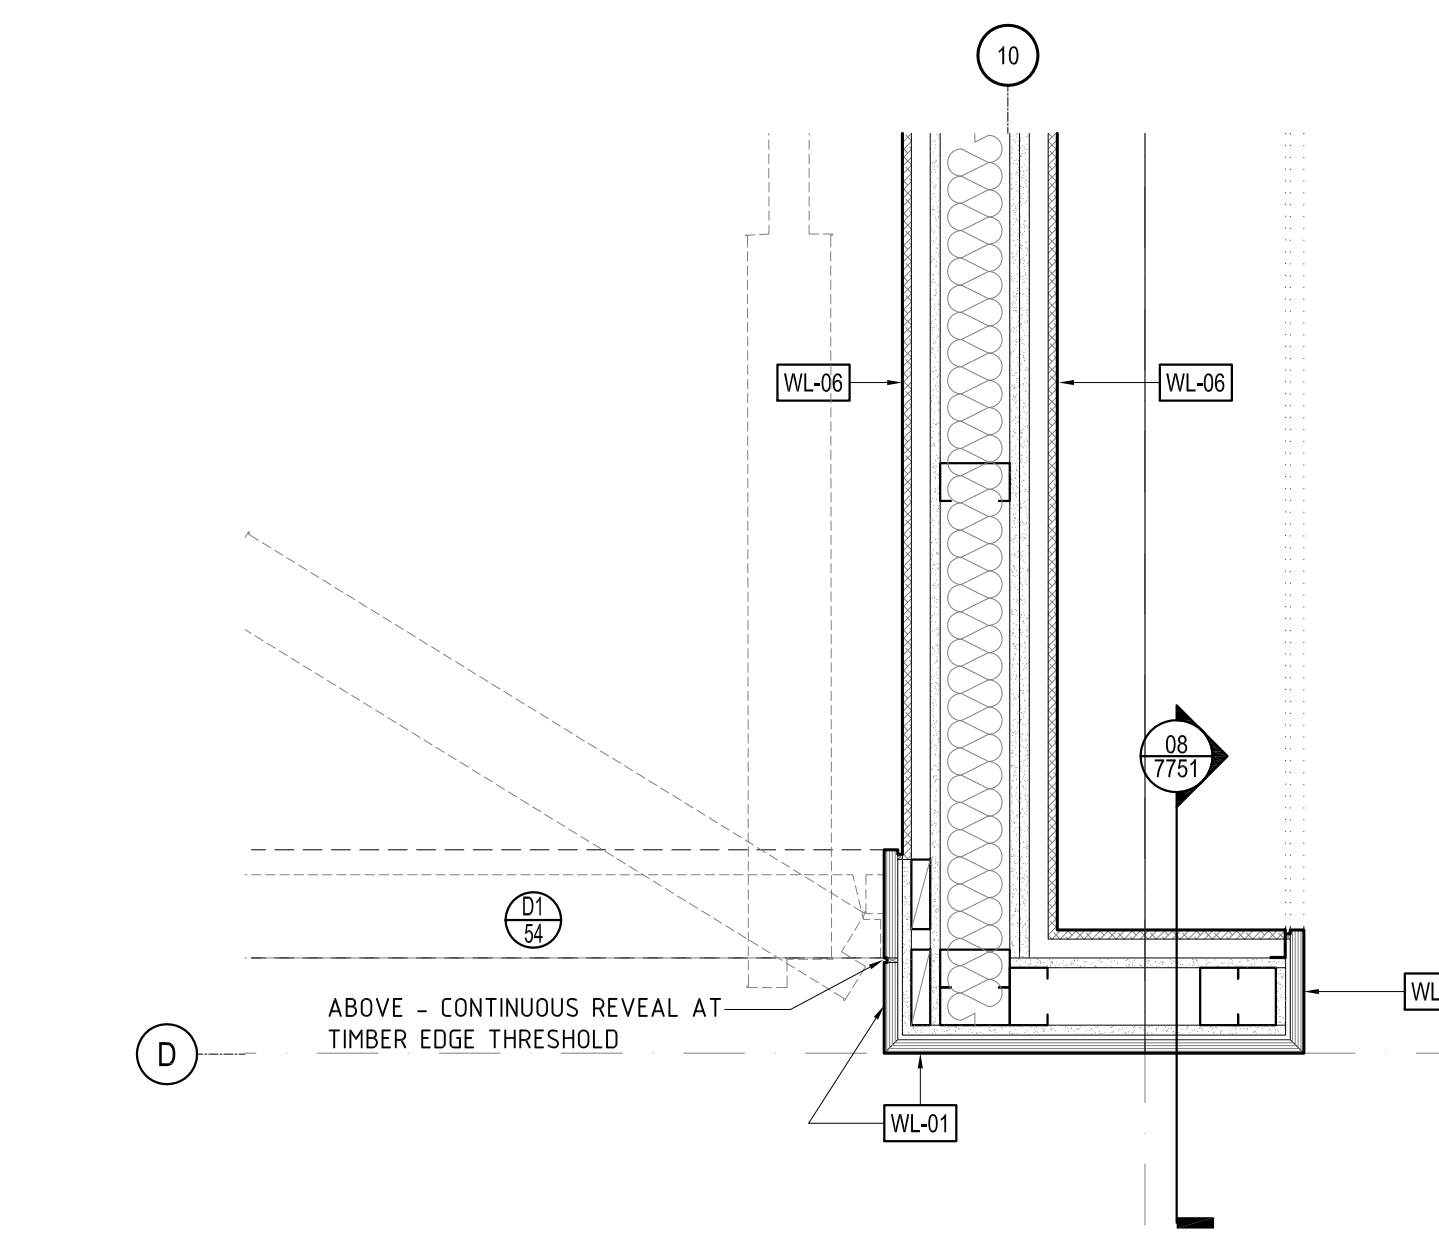


10 PLAN DETAIL - L01 NORTH EDGE @ HALL - CAD LAB  
SCALE: 1:10

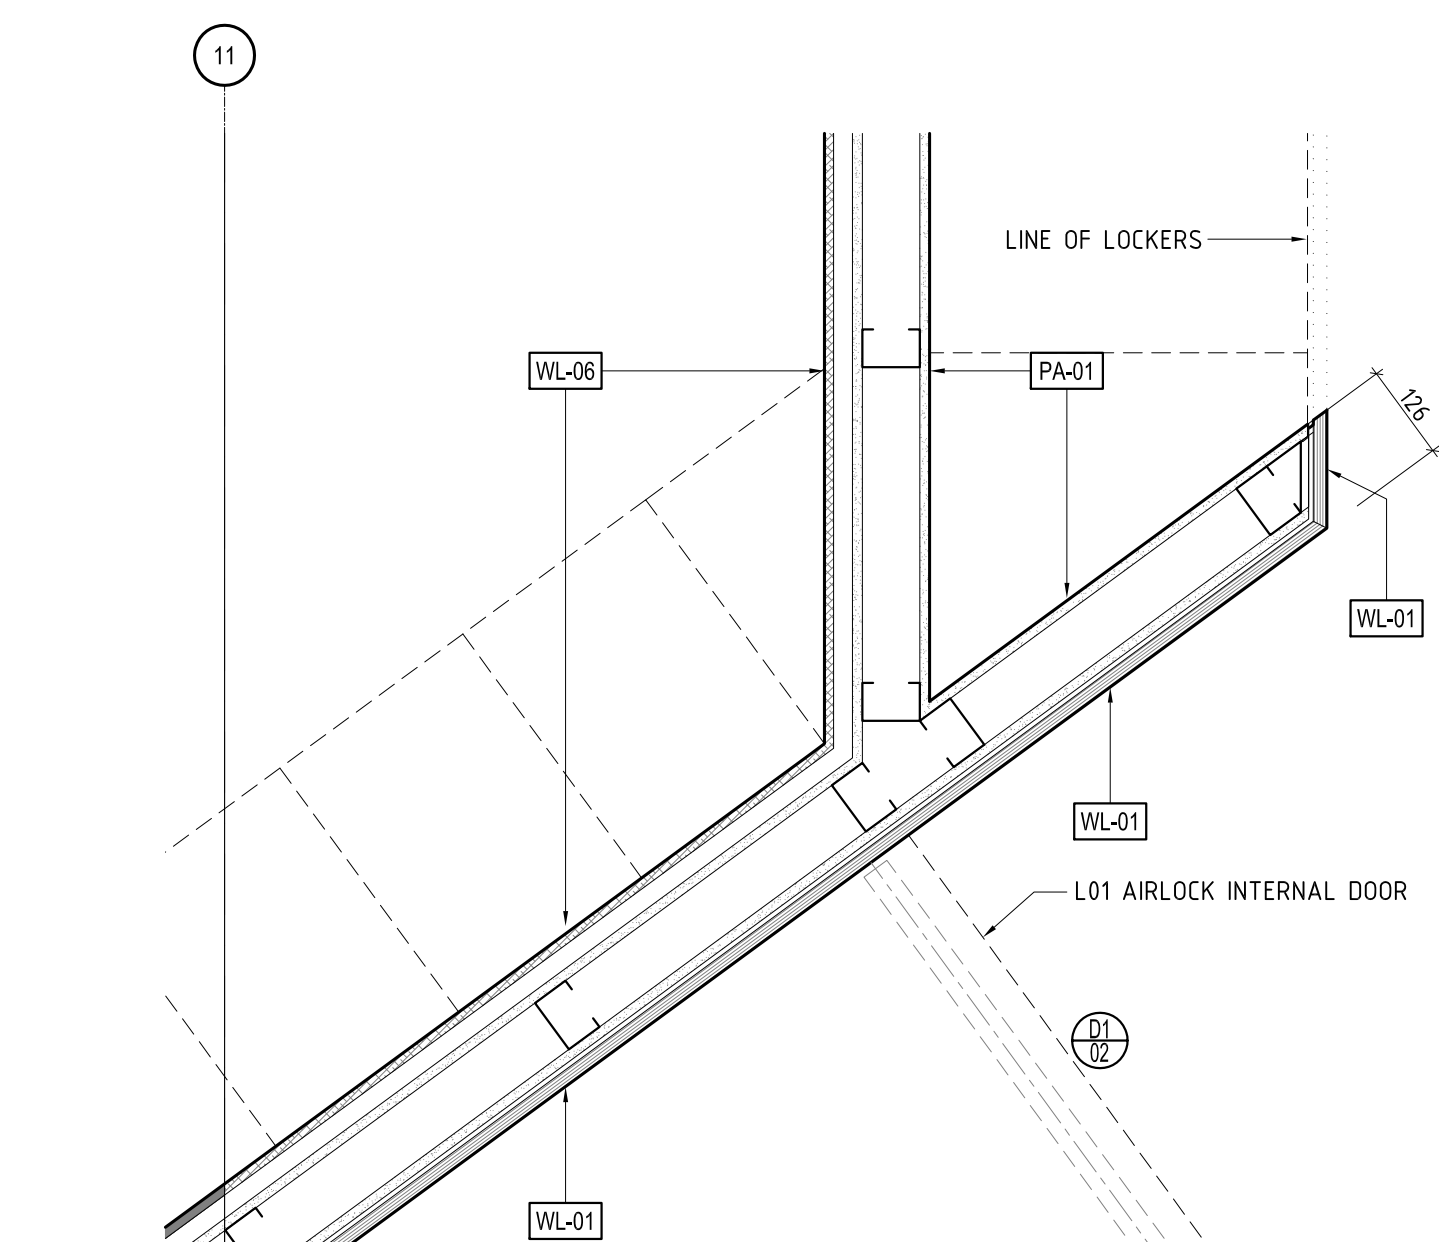


09 PLAN DETAIL - L01 NORTH EDGE @ HALL - AIRLOCK  
SCALE: 1:10

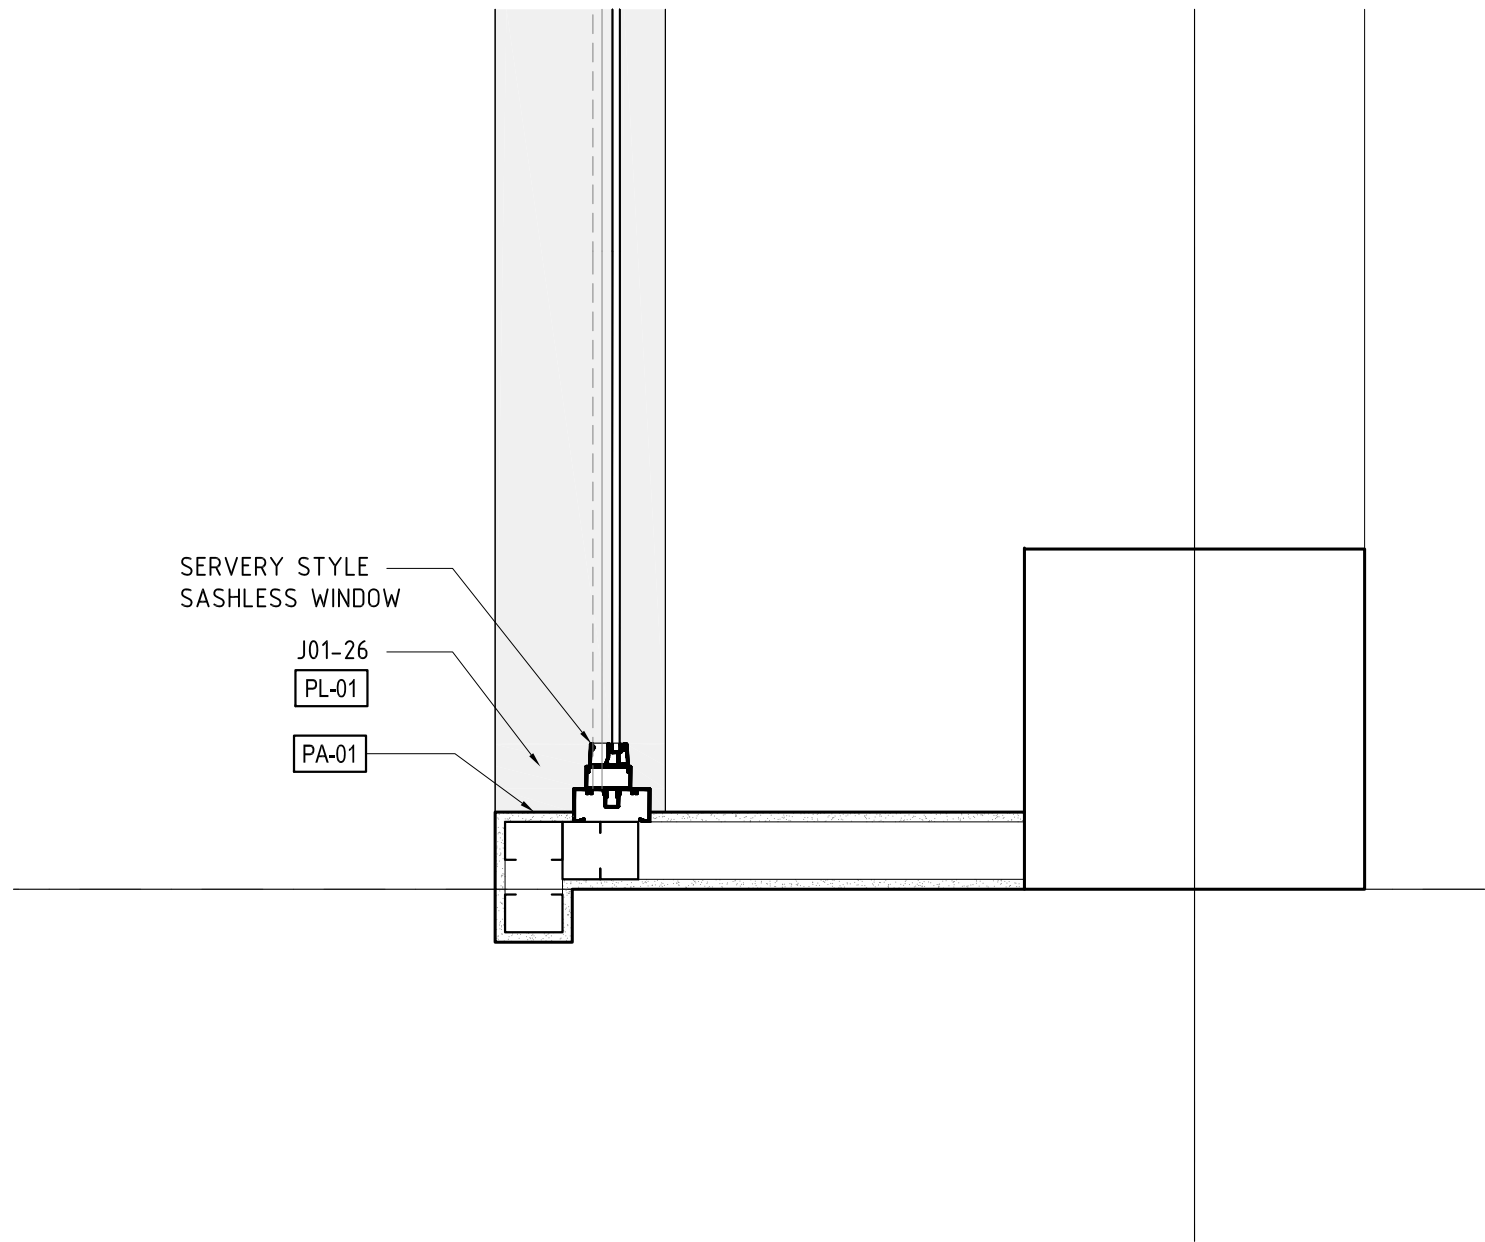


09 PLAN DETAIL - SEVERY STYLE WINDOW  
SCALE: 1:10

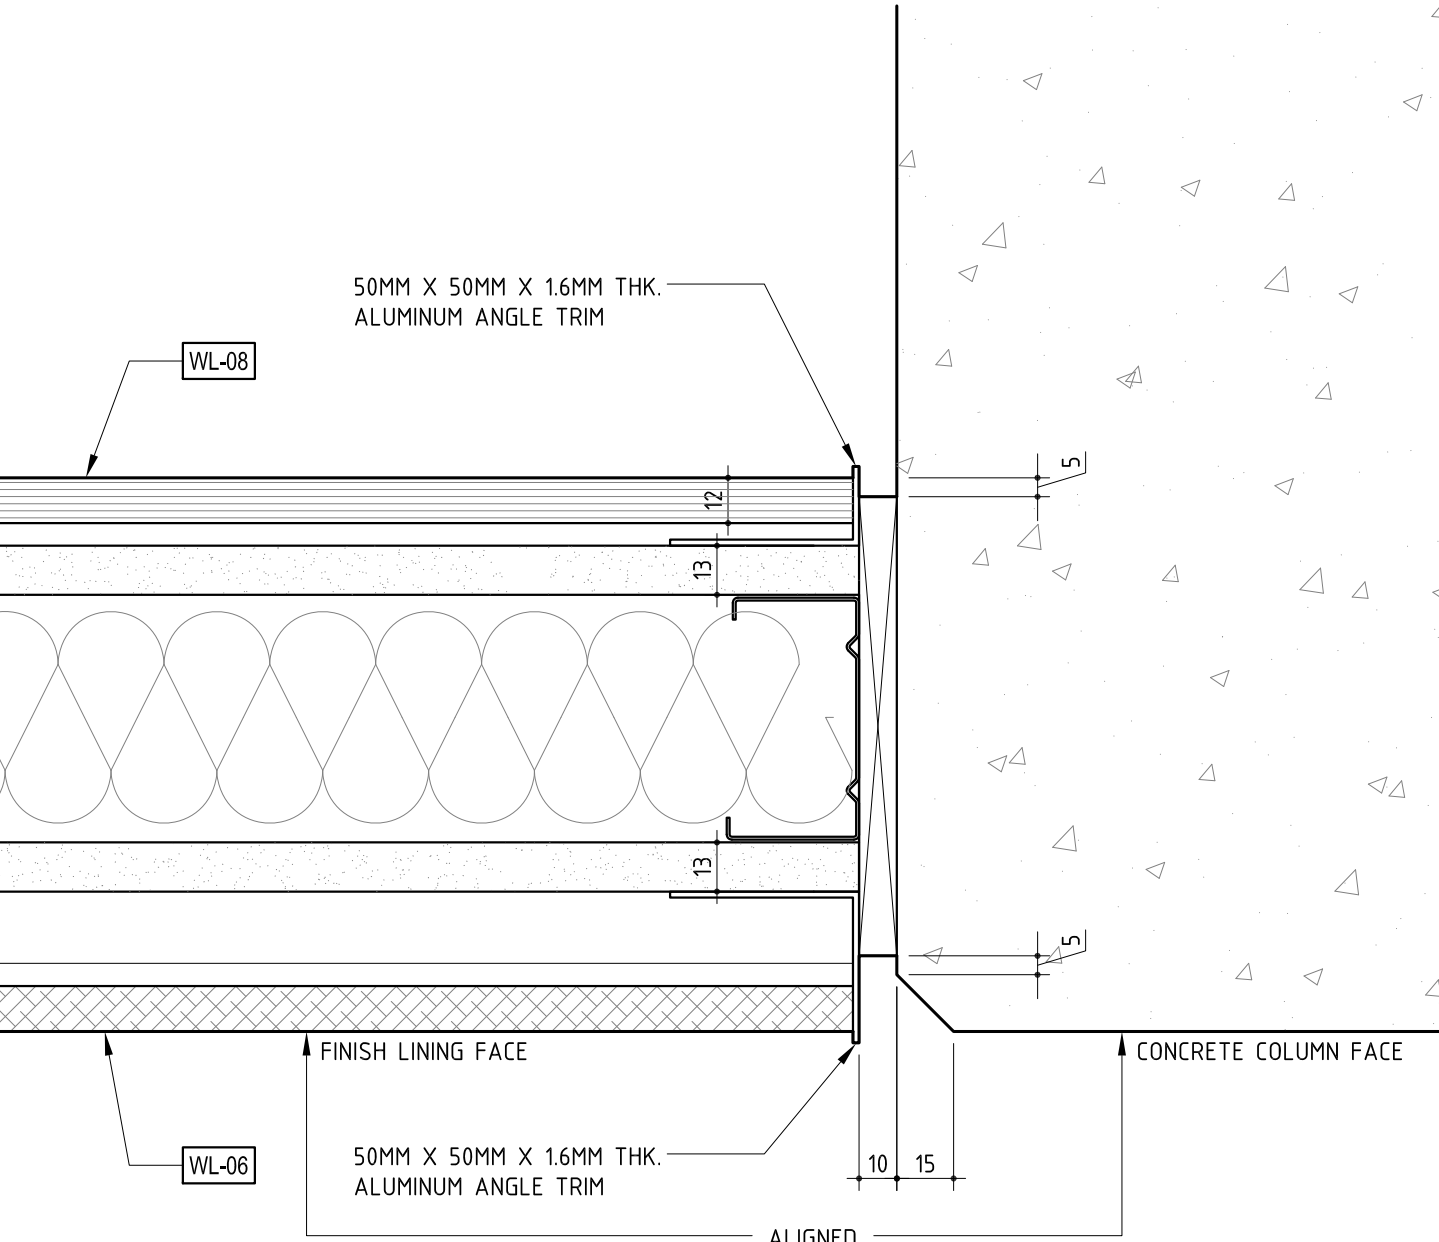


08 PLAN DETAIL - WALL ALIGNMENT @ COLUMN  
SCALE: 1:2

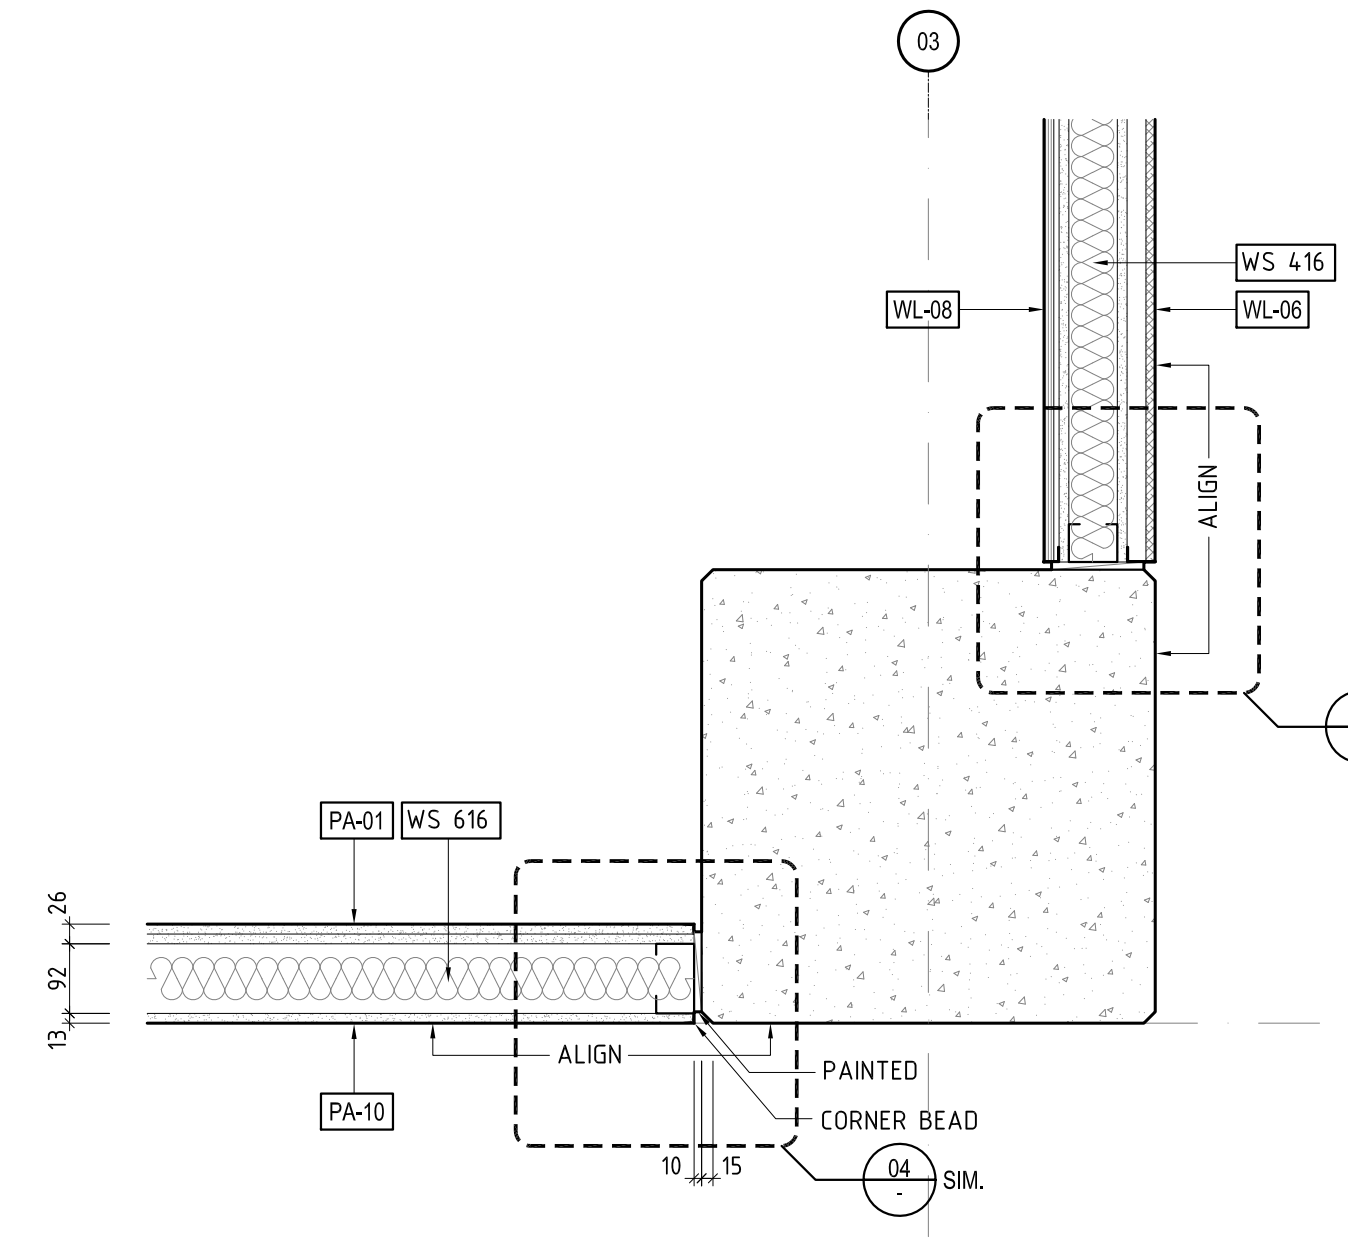


07 PLAN DETAIL - L01 NORTH FLANKING WALL @ J. REED ATRIUM  
SCALE: 1:10

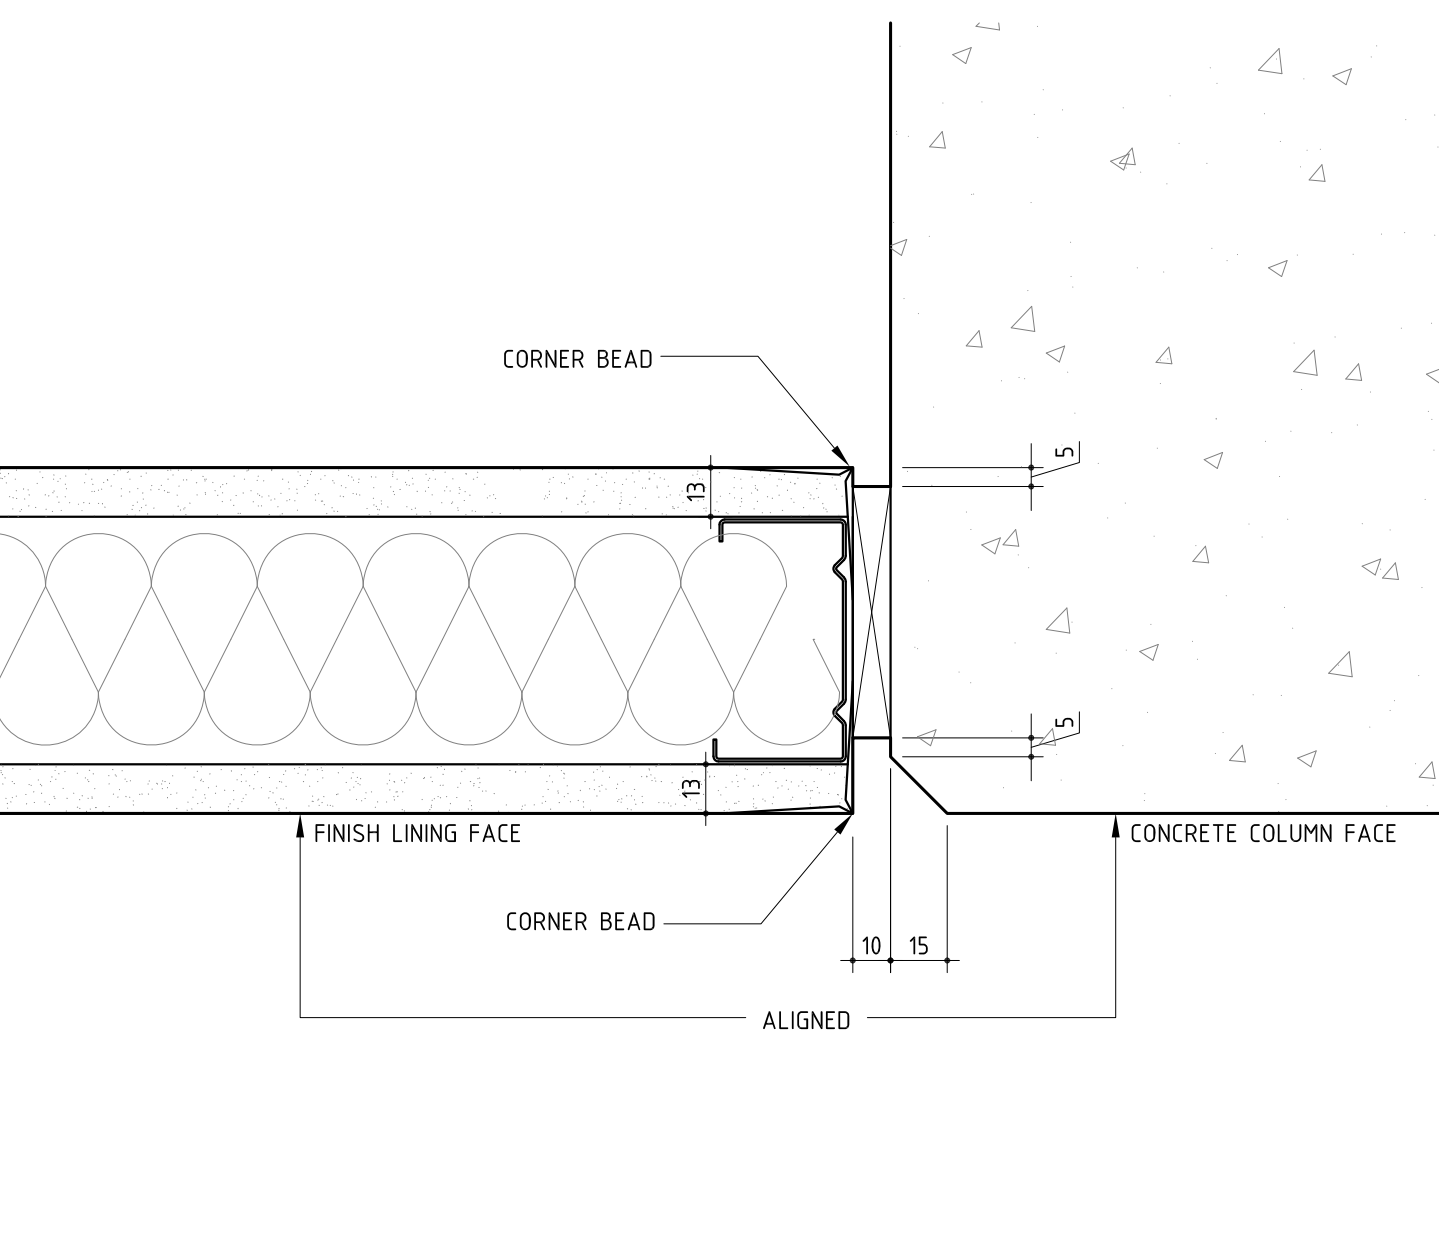


04 PLAN DETAIL - TYPICAL WALL ALIGNMENT @ COLUMN  
SCALE: 1:2

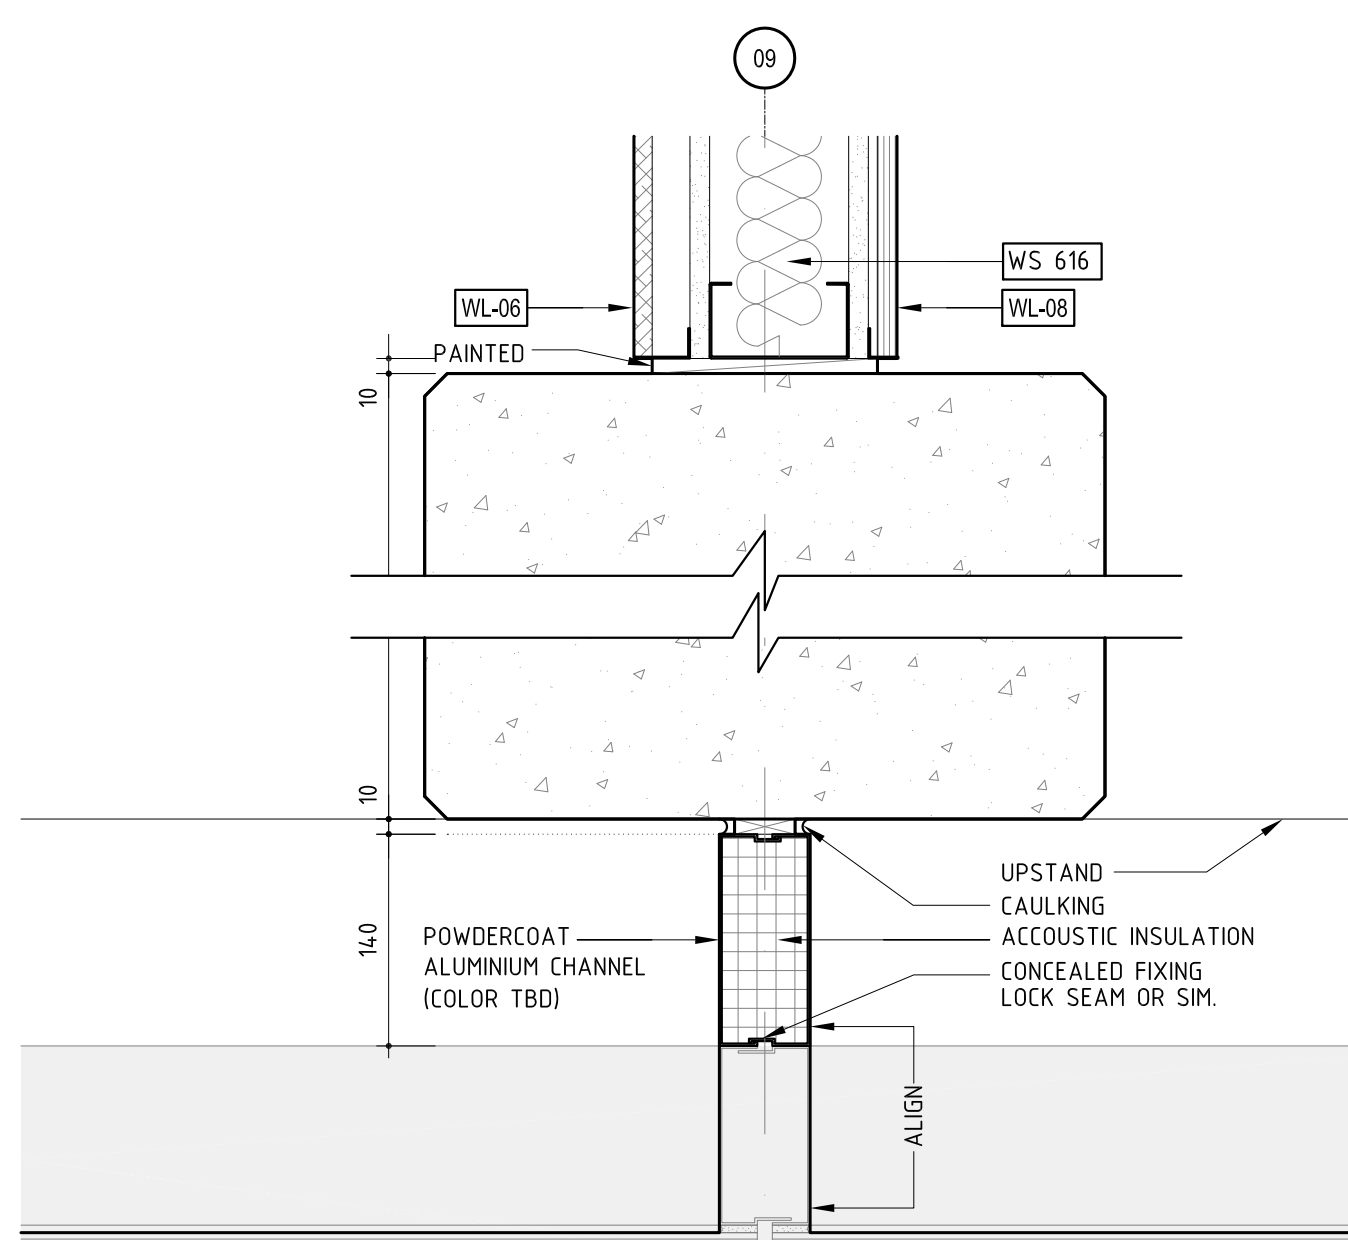

03 PLAN DETAIL - L01 SOUTH FACADE JUNCTION  
SCALE: 1:5

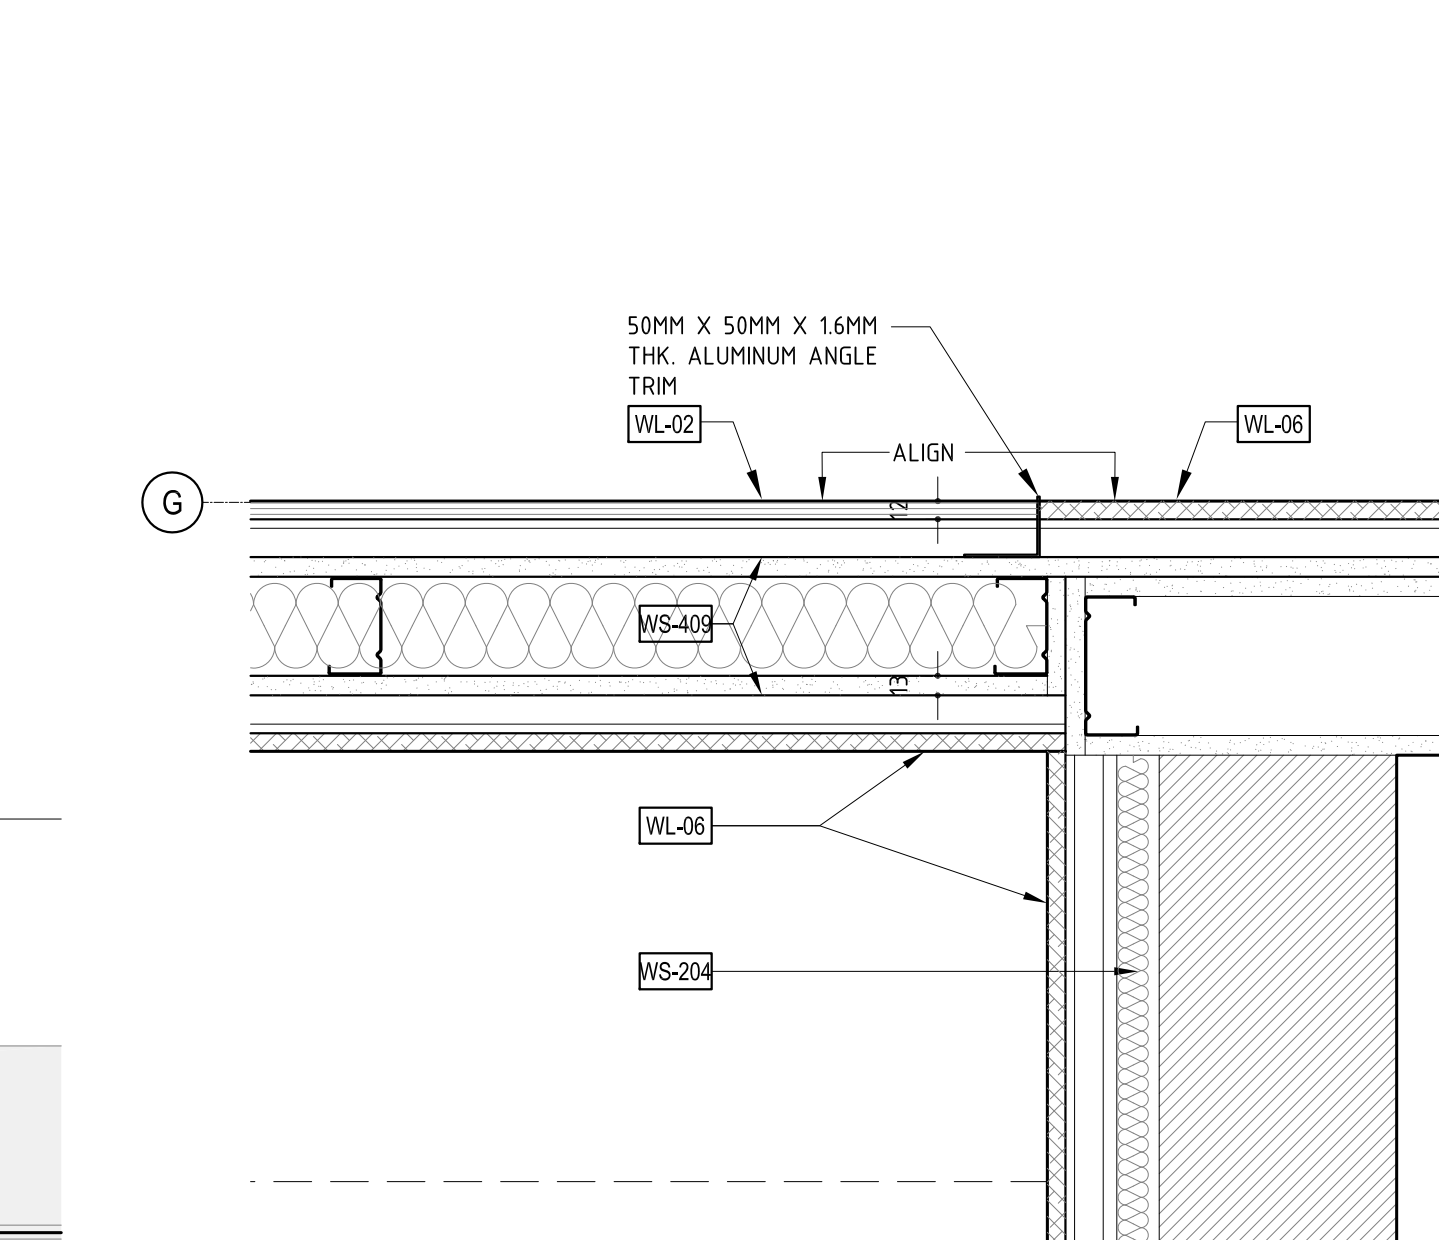


02 PLAN DETAIL - L01 SOUTH EDGE @ HALL  
SCALE: 1:5

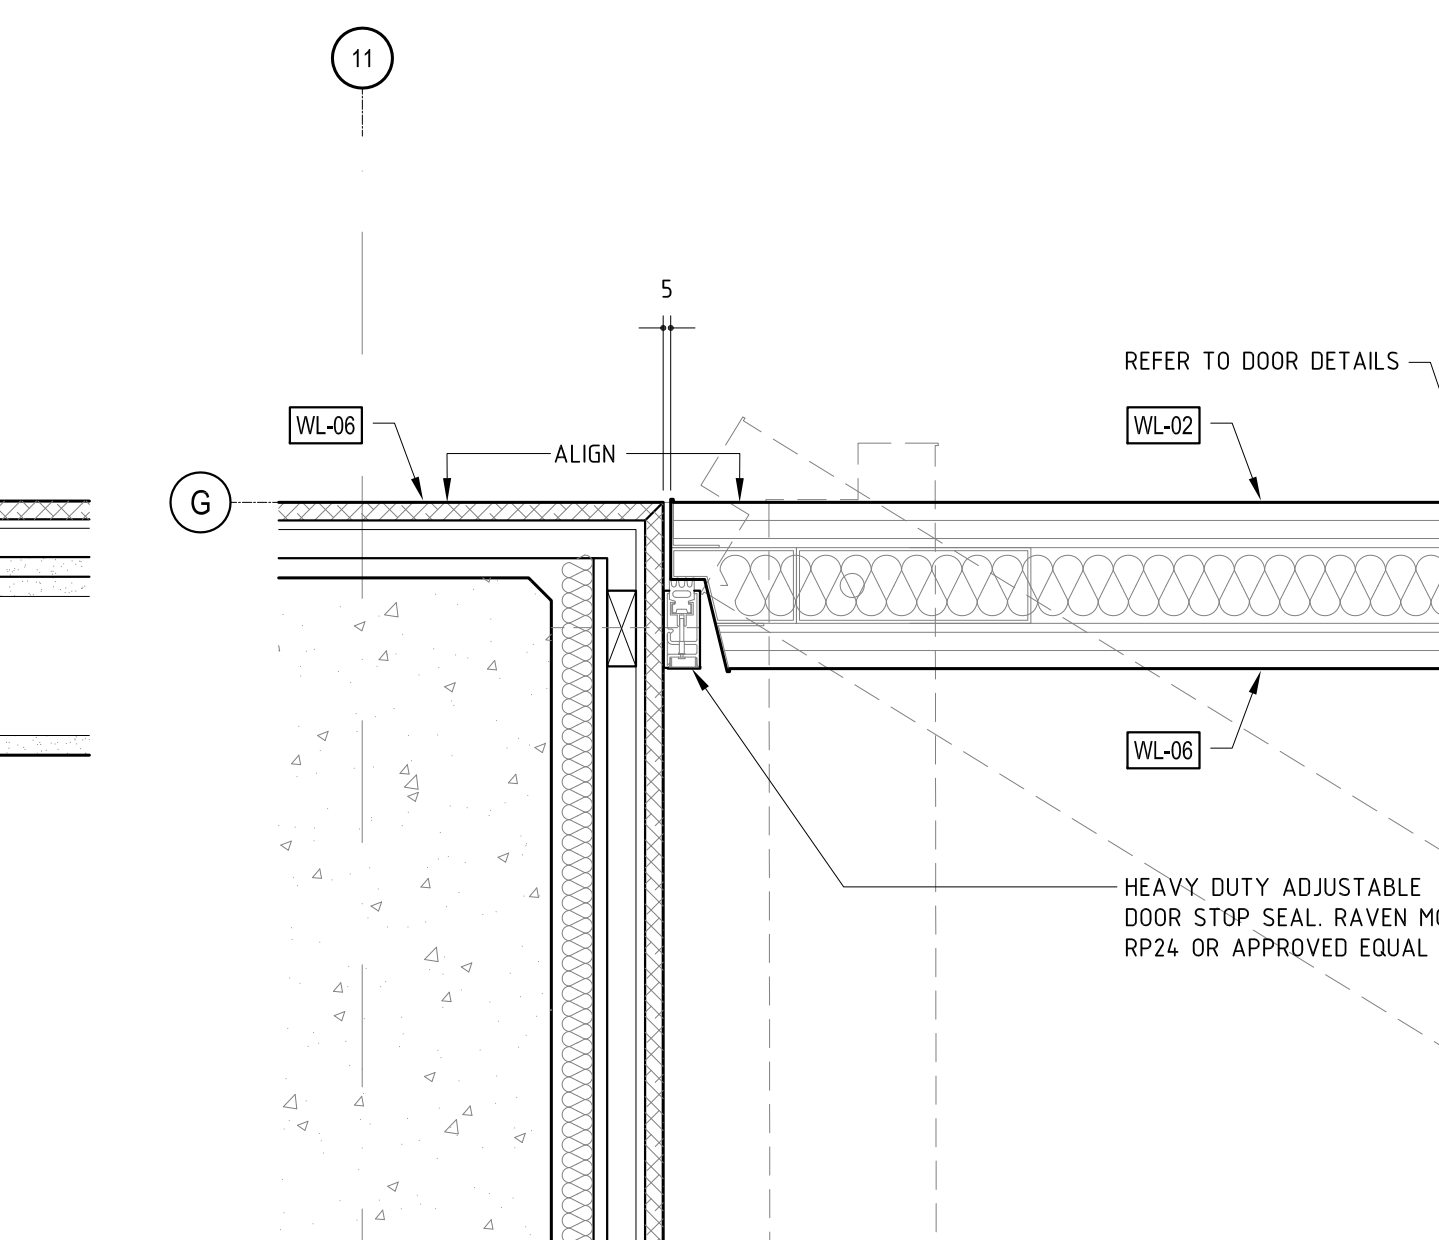

01 PLAN DETAIL - L01 SOUTH EDGE @ HALL  
SCALE: 1:5

Rev	Issue	Revision Description	Amd	Date
A	SG	CONSTRUCTION ISSUE	-	08.01.14
05	SG	TENDER ISSUE	-	14.08.13
04	SG	VALUE MANAGEMENT ISSUE	-	28.03.13
03	JC	100% CD - TENDER ISSUE	-	07.09.12
02	JC	90% CD ISSUE	-	10.08.12
01	JC	75% CD ISSUE	-	13.07.12

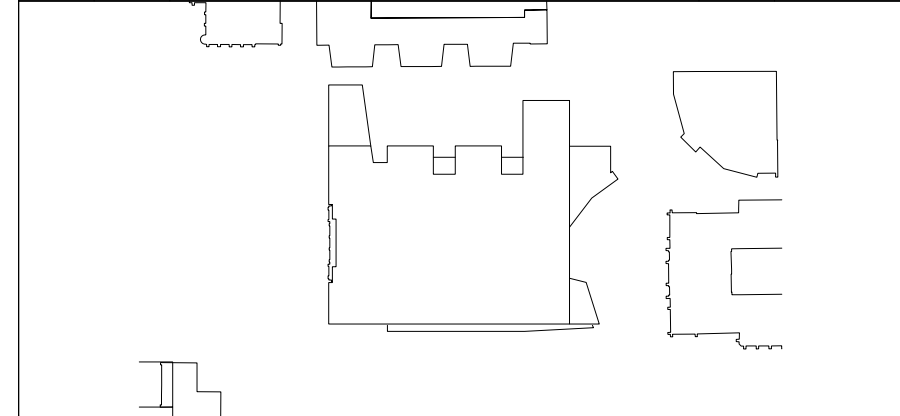

**NADAAA**  
 NADAAA  
 1502 Washington Street No.2  
 Boston  
 Massachusetts  
 02118 USA  
 Telephone  
 +1 617 442 8232  
 Facsimile  
 +1 688 442 1417  
 Email  
 nad@nadaaa.com

**John Wardle Architects**  
 © 2011 John Wardle Architects  
 Level 10, 180 Russell Street, Melbourne Victoria 3000 Australia  
 Tel : +613 9654 8700 www.johnwardlearchitects.com

Client **University of Melbourne Parkville Campus**

Project **Faculty of Architecture Building and Planning**

Title **INTERNAL PLAN DETAILS - L01**

Project No.	<b>0913</b>	Scale	1:10, 1:5, 1:2
Drawing No.	<b>AR7750</b>	Revision	<b>A</b>

Date: JAN 2014 Dwn - Co-Ord - Chk -

FILENAME: #####

**FOR CONSTRUCTION**