


CONTRACTORS SHALL VERIFY JOB DIMENSIONS BEFORE ANY JOB COMMENCES. ALL SHOP DRAWINGS SHALL BE SUBMITTED TO THE SUPERINTENDENT AND MANUFACTURE SHALL NOT COMMENCE PRIOR TO THE RETURN OF UNAMBIGUOUS SHOP DRAWINGS ISSUED BY THE CONSULTANT. FIGURED DIMENSIONS SHALL TAKE PRECEDENCE OVER SCALED THIS DRAWING SHOULD BE READ IN CONJUNCTION WITH ALL RELEVANT CONTRACT SPECIFICATIONS AND DRAWINGS COPYRIGHT OF THIS DRAWING IS VESTED IN WARDLE


General Notes

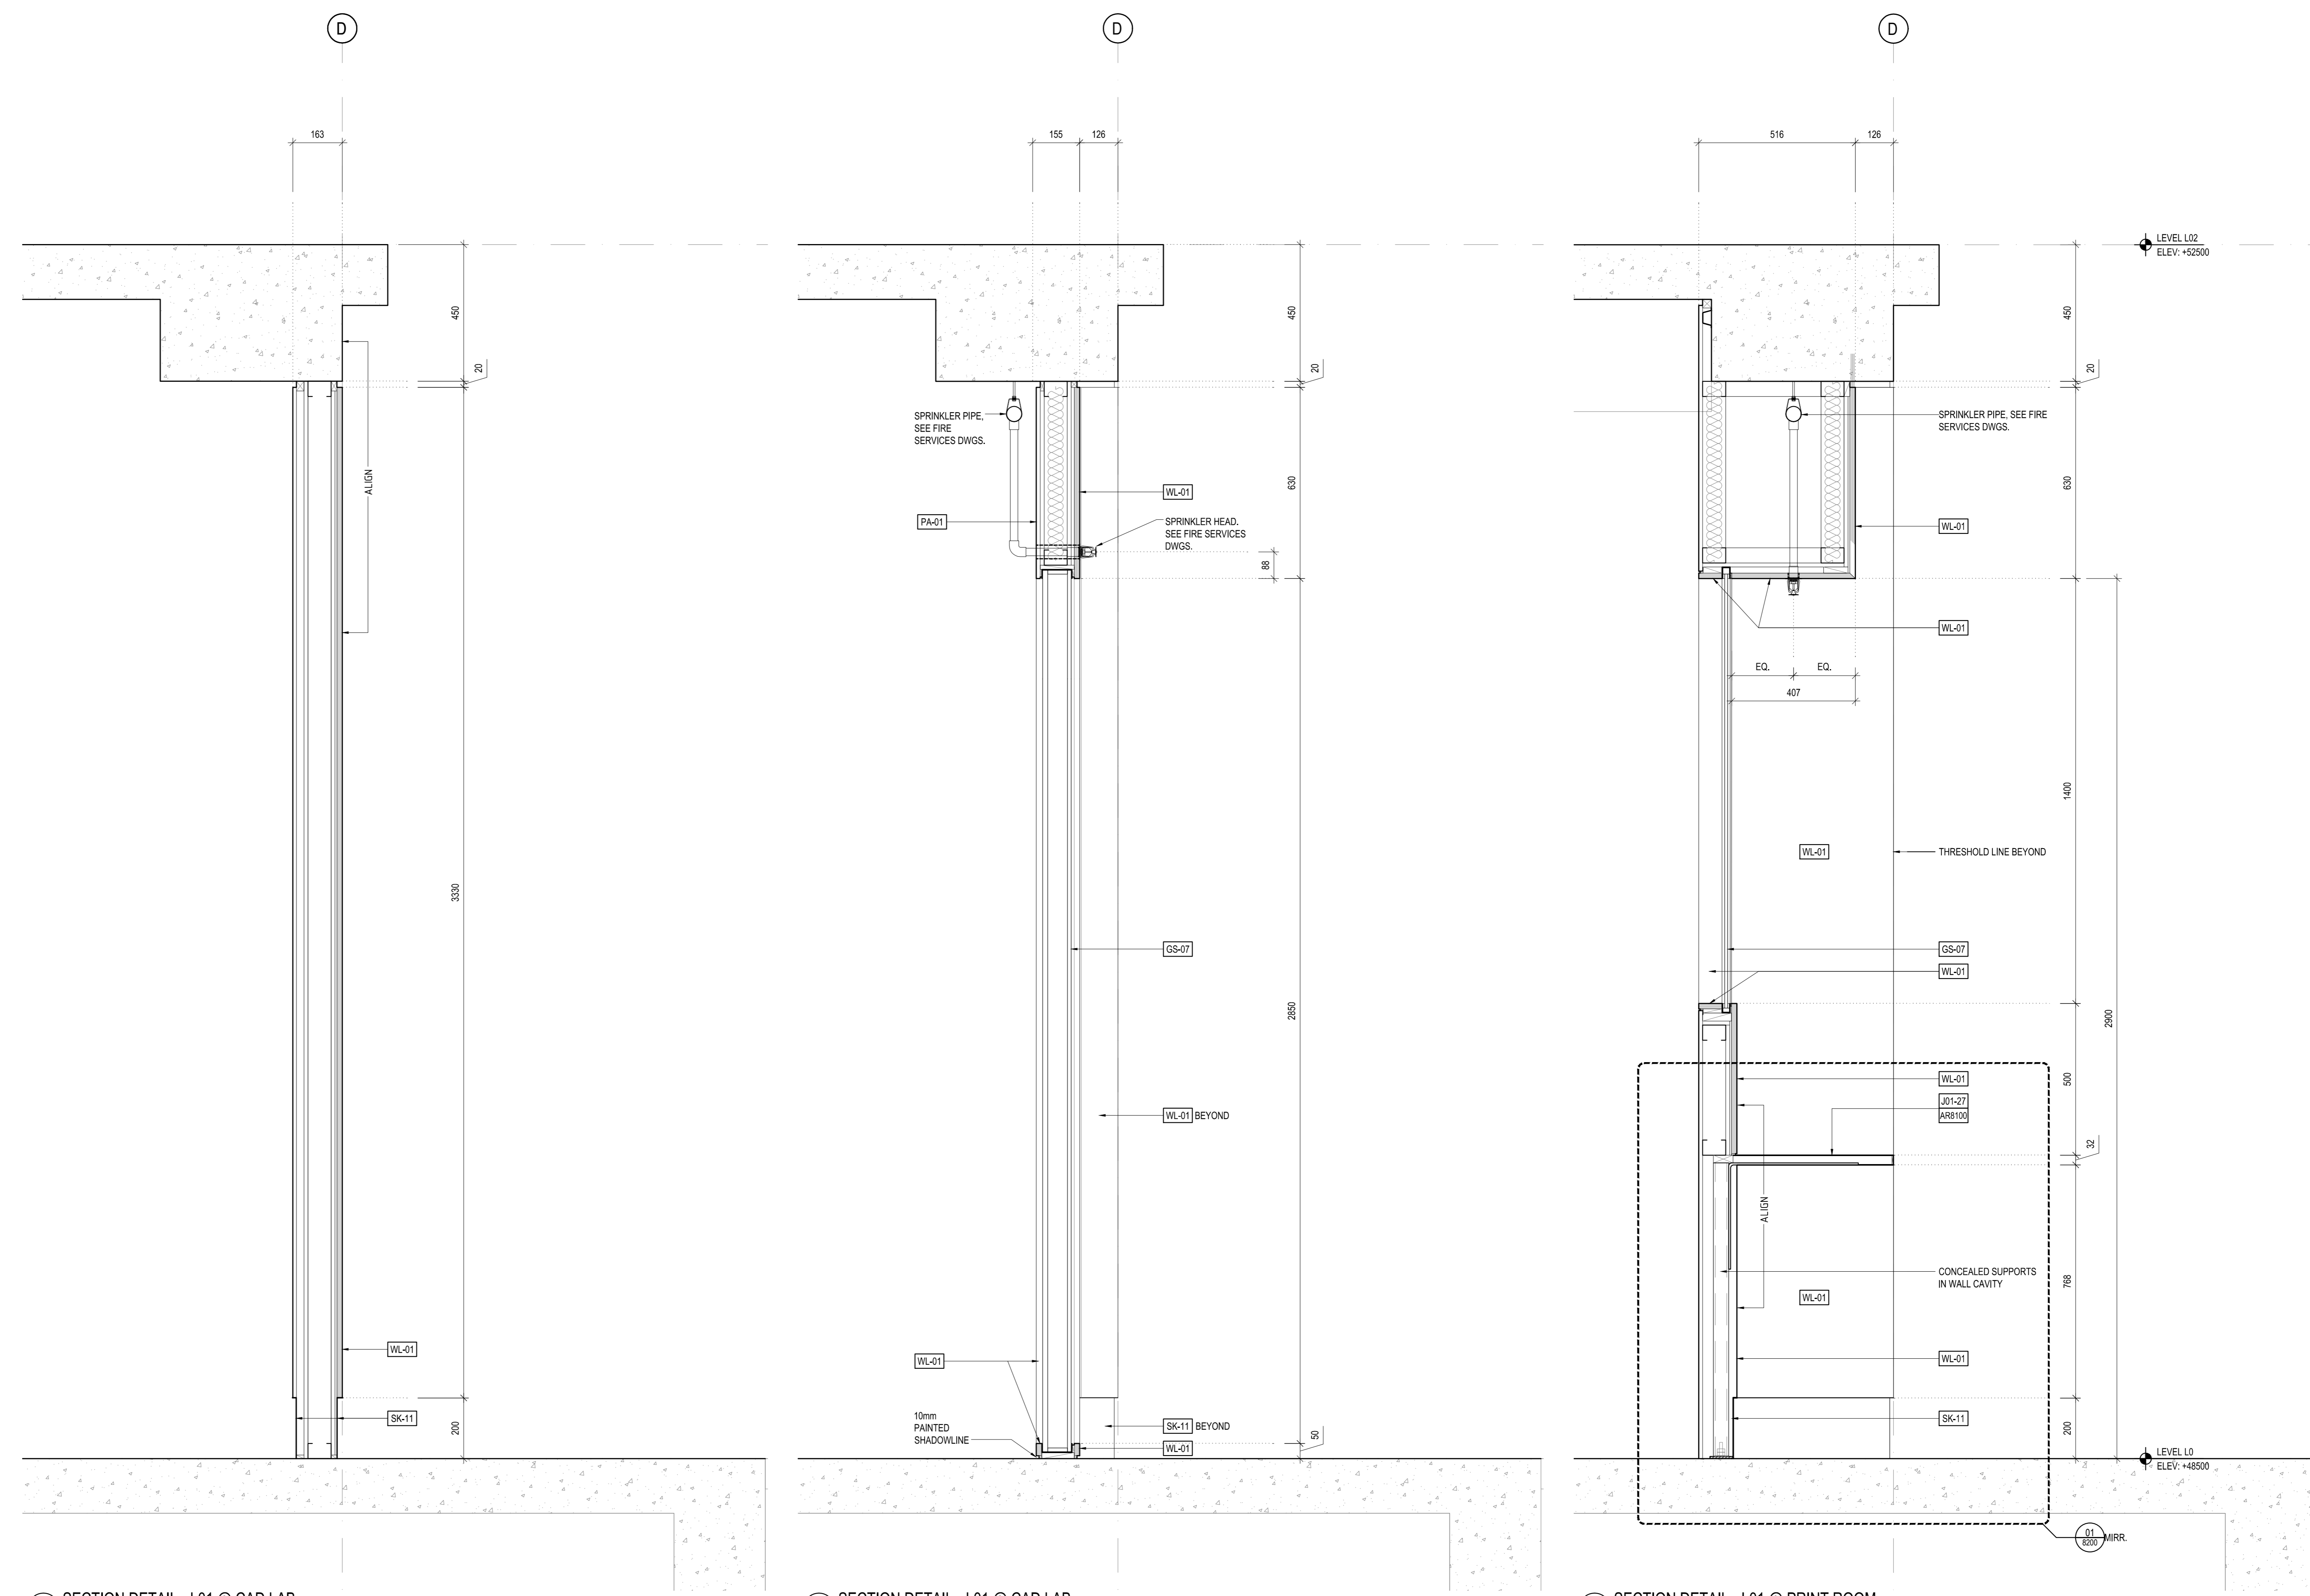


08 SECTION DETAIL - L01 @ CAD LAB
SCALE 1:10

07 SECTION DETAIL - L01 @ CAD LAB
SCALE 1:10

06 SECTION DETAIL - L01 @ PRINT ROOM
SCALE 1:10

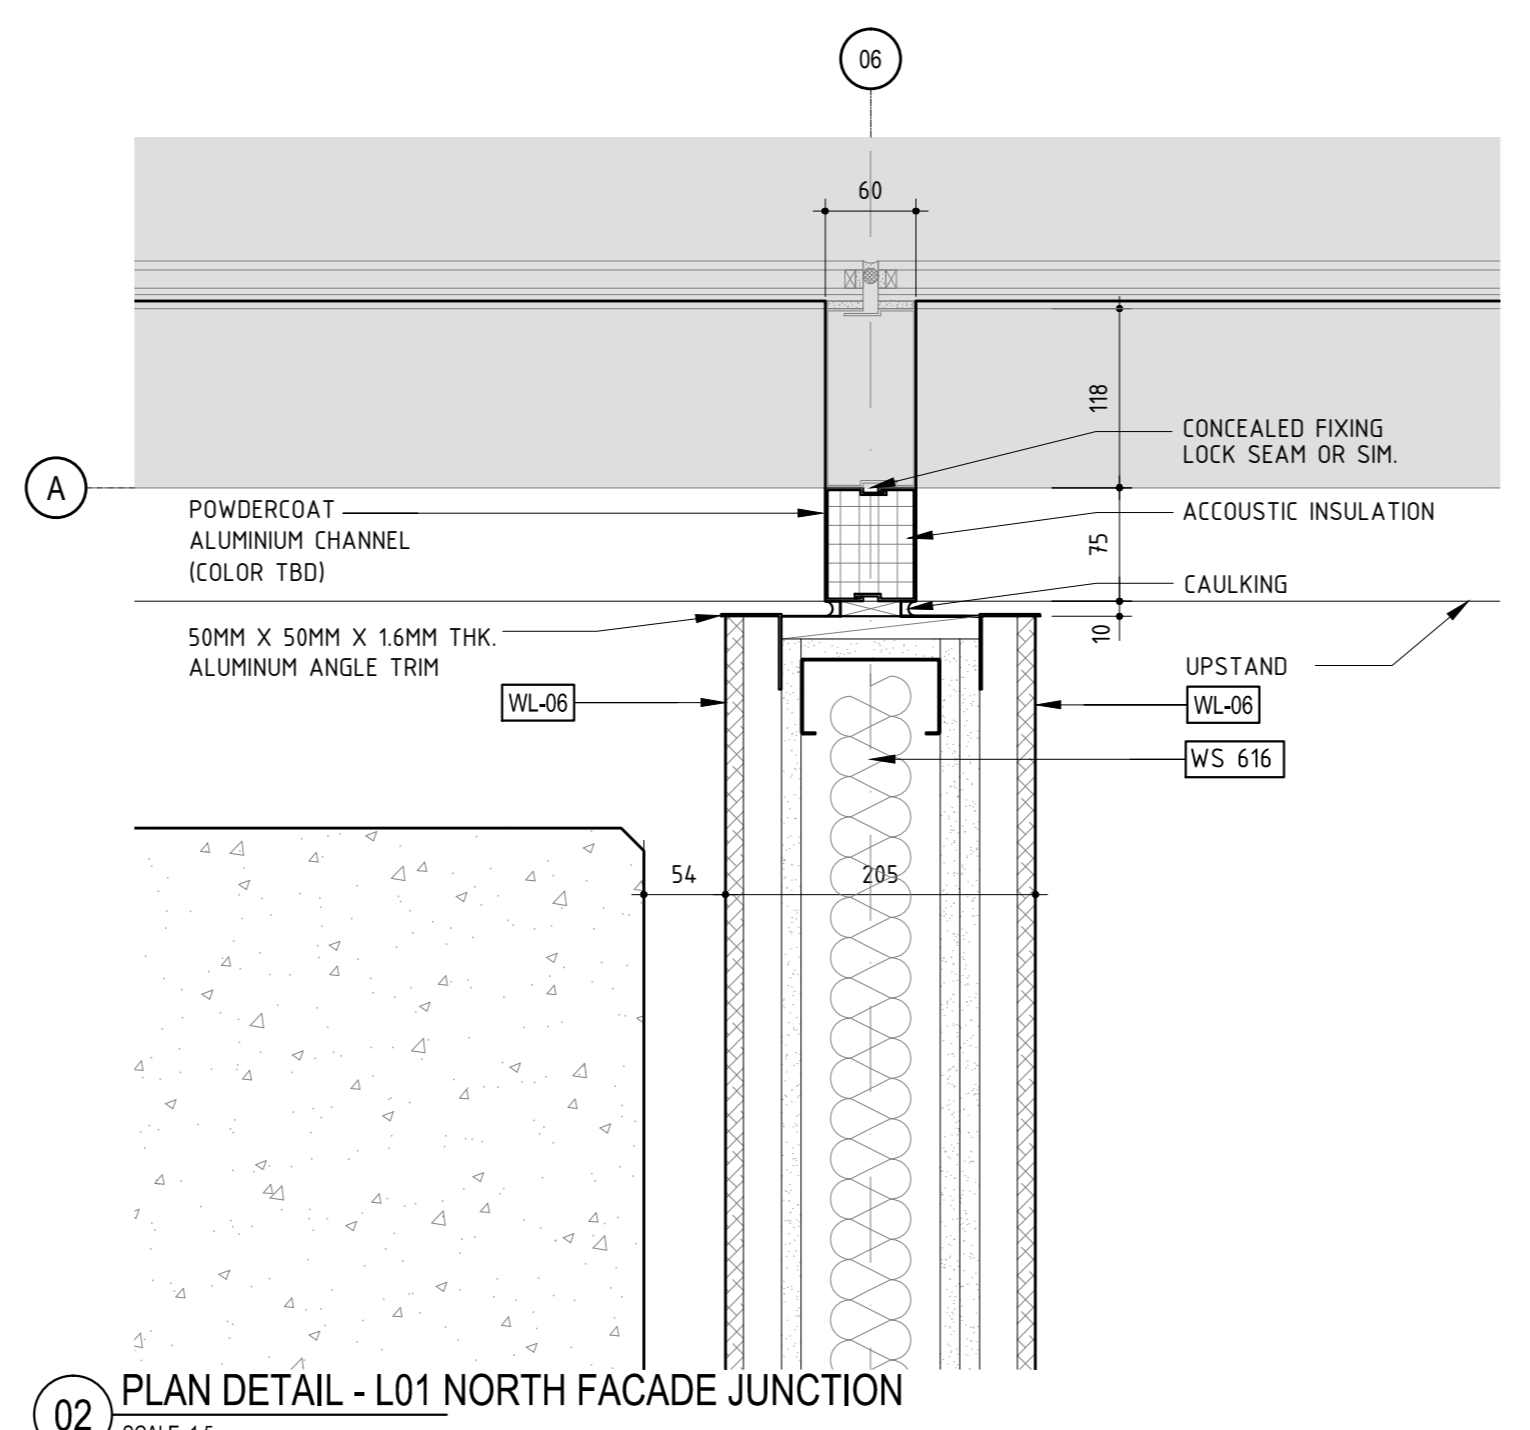


02 PLAN DETAIL - L01 NORTH FACADE JUNCTION
SCALE 1:5

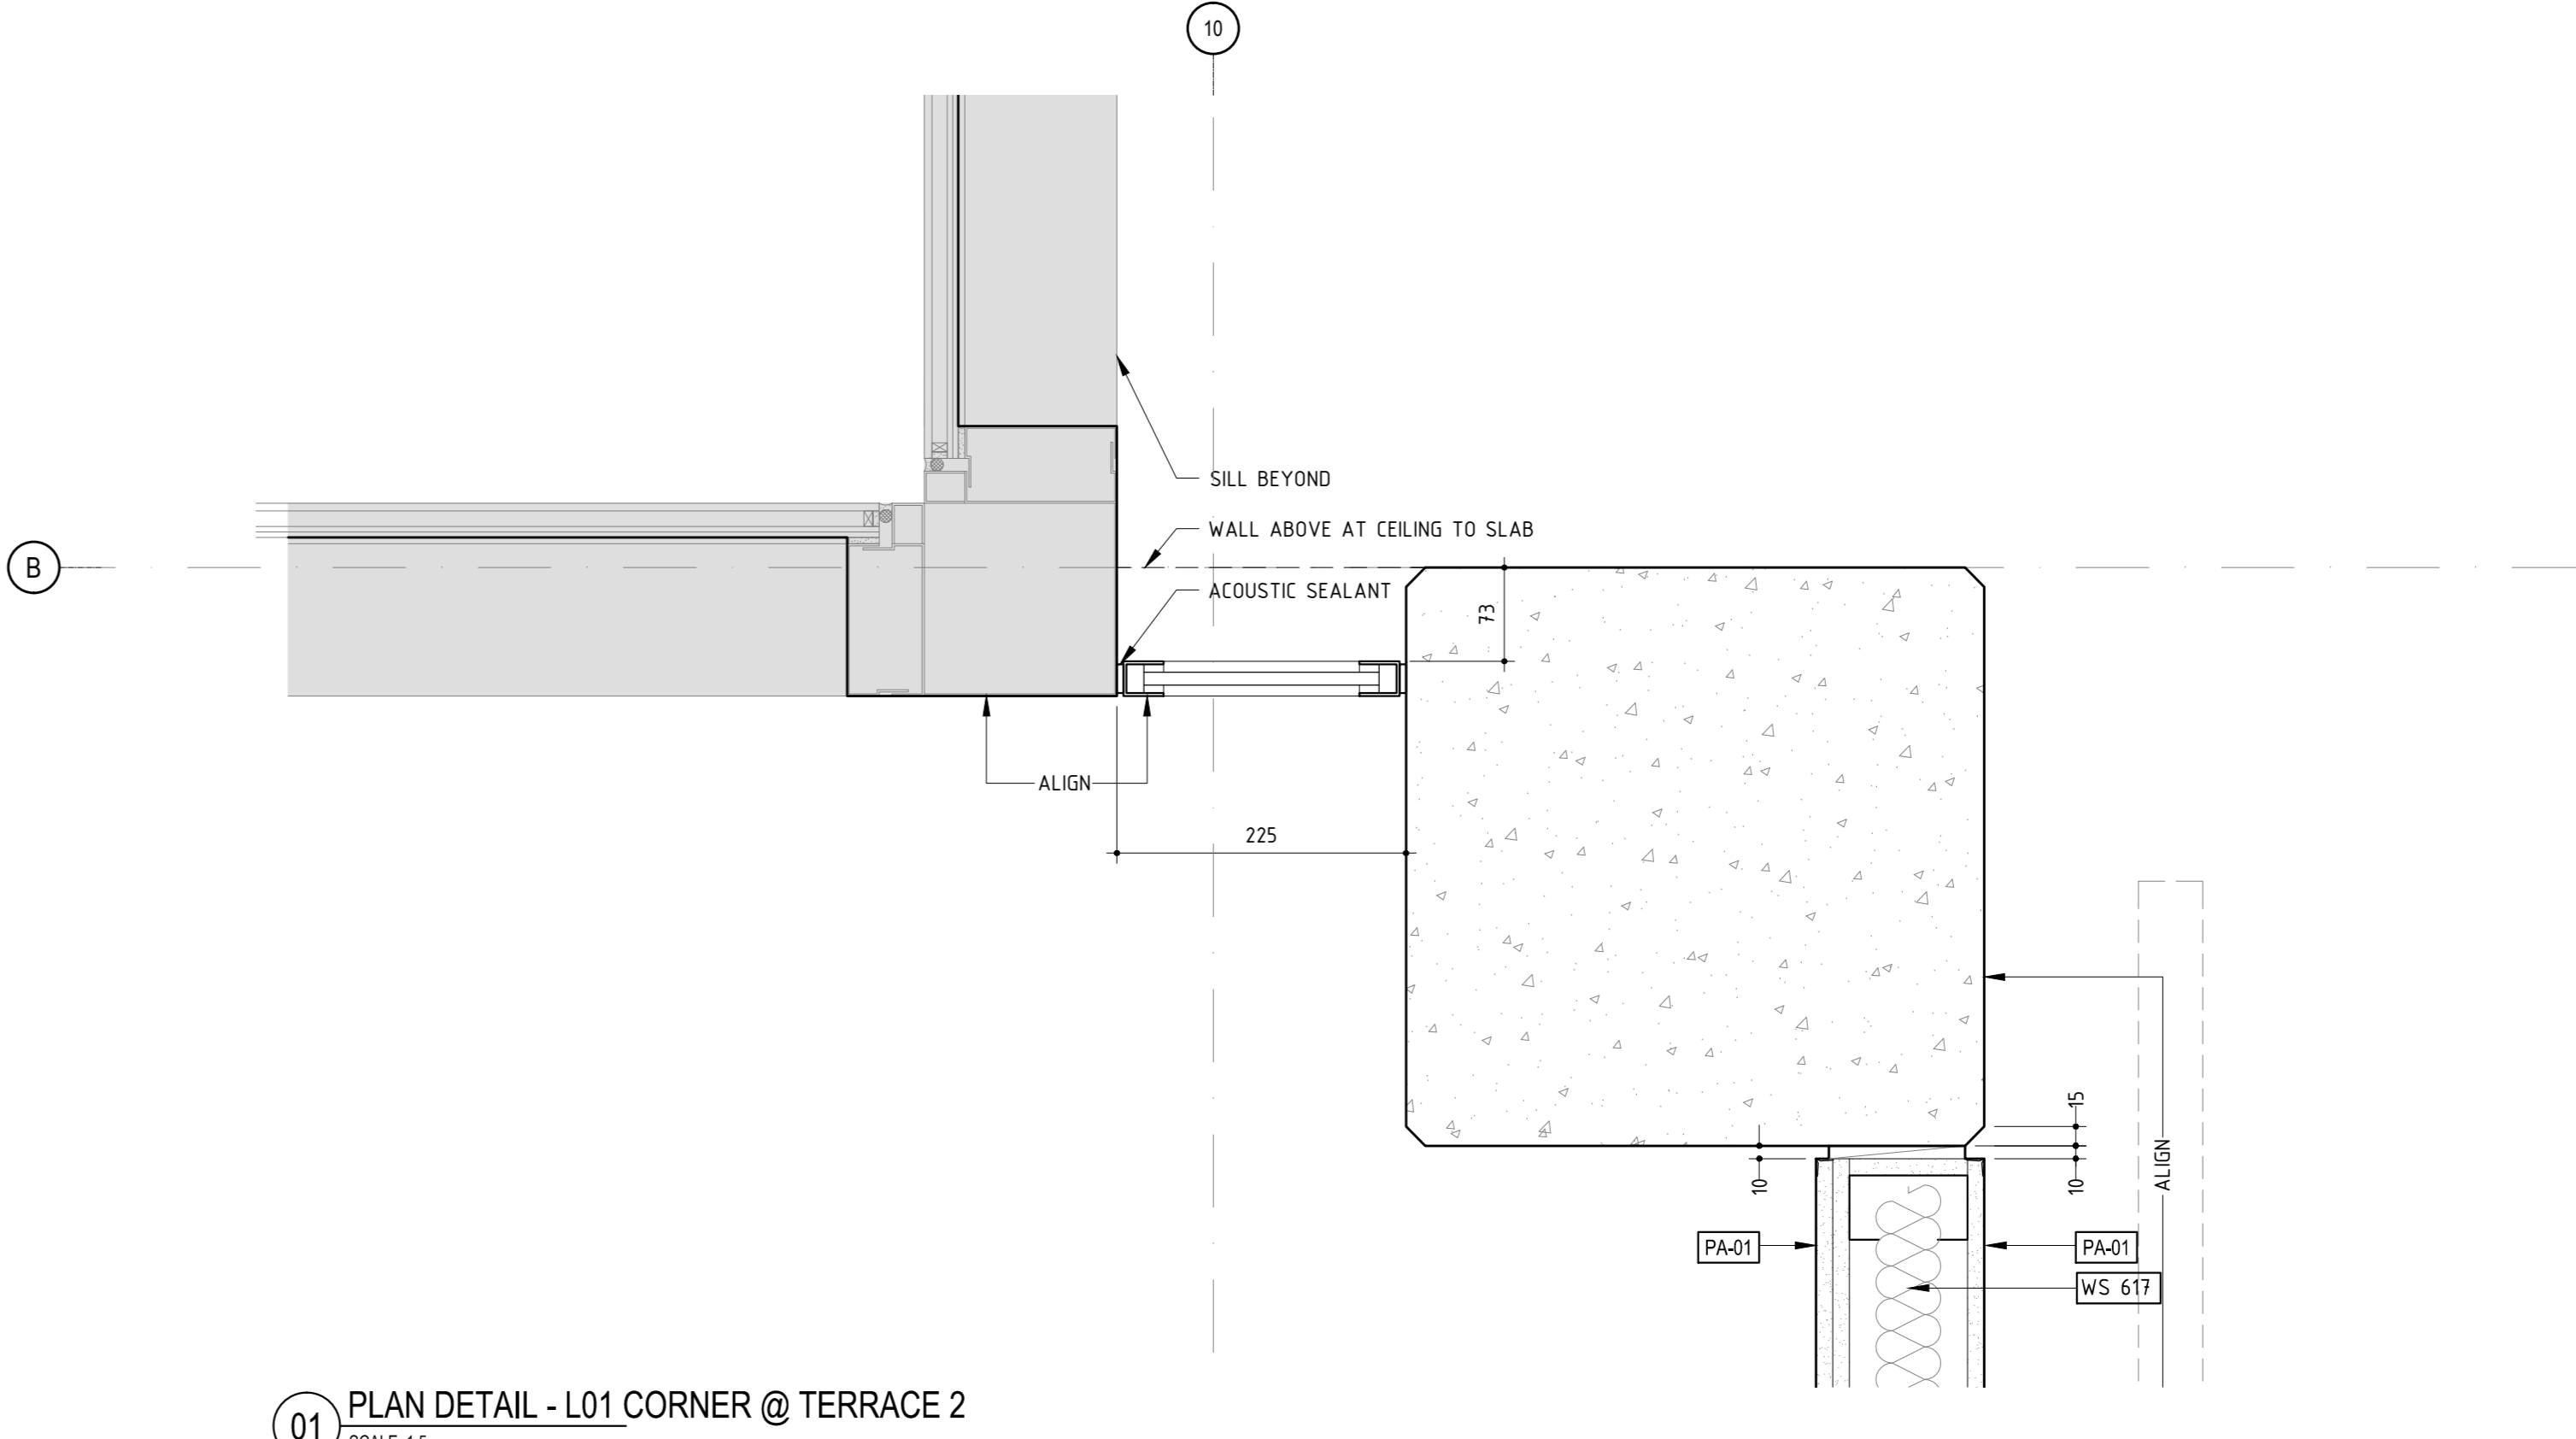

01 PLAN DETAIL - L01 CORNER @ TERRACE 2
SCALE 1:5

A	SG	CONSTRUCTION ISSUE	-	08.01.14
03	SG	VALUE MANAGEMENT ISSUE	-	28.03.13
02	JC	100% CD - TENDER ISSUE	-	07.08.12
01	JC	90% CD ISSUE	-	10.08.12

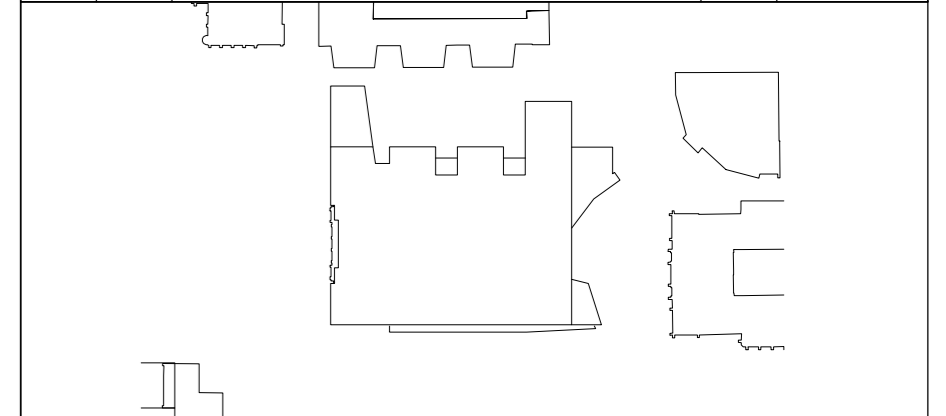

NADAAA
 NADAAA
 1320 Wellington Street No.2
 Boston Massachusetts 02118 USA
 Telephone +1 617 442 8232
 Facsimile +1 688 442 1417
 Email nada@nadaaa.com

John Wardle Architects
 © 2011 John Wardle Architects
 Level 10, 180 Russell Street, Melbourne Victoria 3000 Australia
 Tel : +613 9654 8700 www.johnwardlearchitects.com

Client **University of Melbourne Parkville Campus**
 Project **Faculty of Architecture Building and Planning**
 Title **INTERNAL PLAN DETAILS - L01**

Project No.	0913	Scale	1:10, 1:5
Drawing No.	AR7751	Revision	A
Date	JAN 2014	Drawn	-
FILENAME	####	Co-Ord	-
		Check	-

FOR CONSTRUCTION