


CONTRACTORS SHALL VERIFY JOB DIMENSIONS BEFORE ANY JOB COMMENCES. ALL SHOP DRAWINGS SHALL BE SUBMITTED TO THE SUPERINTENDENT AND MANUFACTURER SHALL NOT COMMENCE FROM THE RETURN OF DRAWINGS SHOWN. BY THE CONSULTANT FIGURED DIMENSIONS SHALL TAKE PRECEDENCE OVER SCALED. THIS DRAWING SHALL BE READ IN CONJUNCTION WITH ALL RELEVANT CONTRACT SPECIFICATIONS AND DRAWINGS COPYRIGHT OF THIS DRAWING IS VESTED IN HANDLE.

General Notes

Table with 4 columns: Rev, Issue, Revision Description, and Date. It contains a list of revisions for the drawing.

Table with 4 columns: A, SG, Issued for Construction, and Date. It contains a list of construction schedule items.

Table with 4 columns: Rev, Issue, Revision Description, and Date. It contains a list of revisions for the drawing.

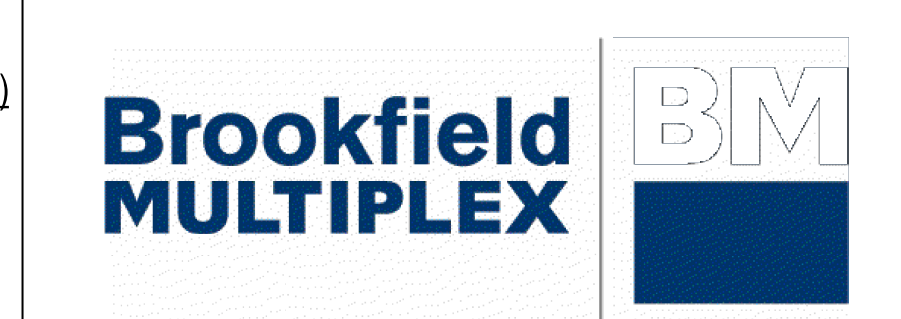

NADAAA
1920 Washington Street No.2 Boston Massachusetts 02118 USA
Telephone: +1 817 442 8232
Facsimile: +1 888 442 1417
Email: nad@nadaaa.com

John Wardle Architects
25 Rokeby Street, Collingwood, Victoria 3066 Australia
Tel: +61 3 8662 0400 www.johnwardlearchitects.com
© 2012 John Wardle Architects ABN 83 006 814 268

Client: University of Melbourne Parkville Campus
Project: Faculty of Architecture Building and Planning

Title: SECTION DETAILS - TYPICAL WALL FINISH DETAILS

Table with 4 columns: Project No., Drawing No., Scale, and Revision. It contains project and drawing information.

Date: Dec 2011 Drawn: Co-Ord: Check:

FILENAME: SFR18

FOR CONSTRUCTION

