



General Notes

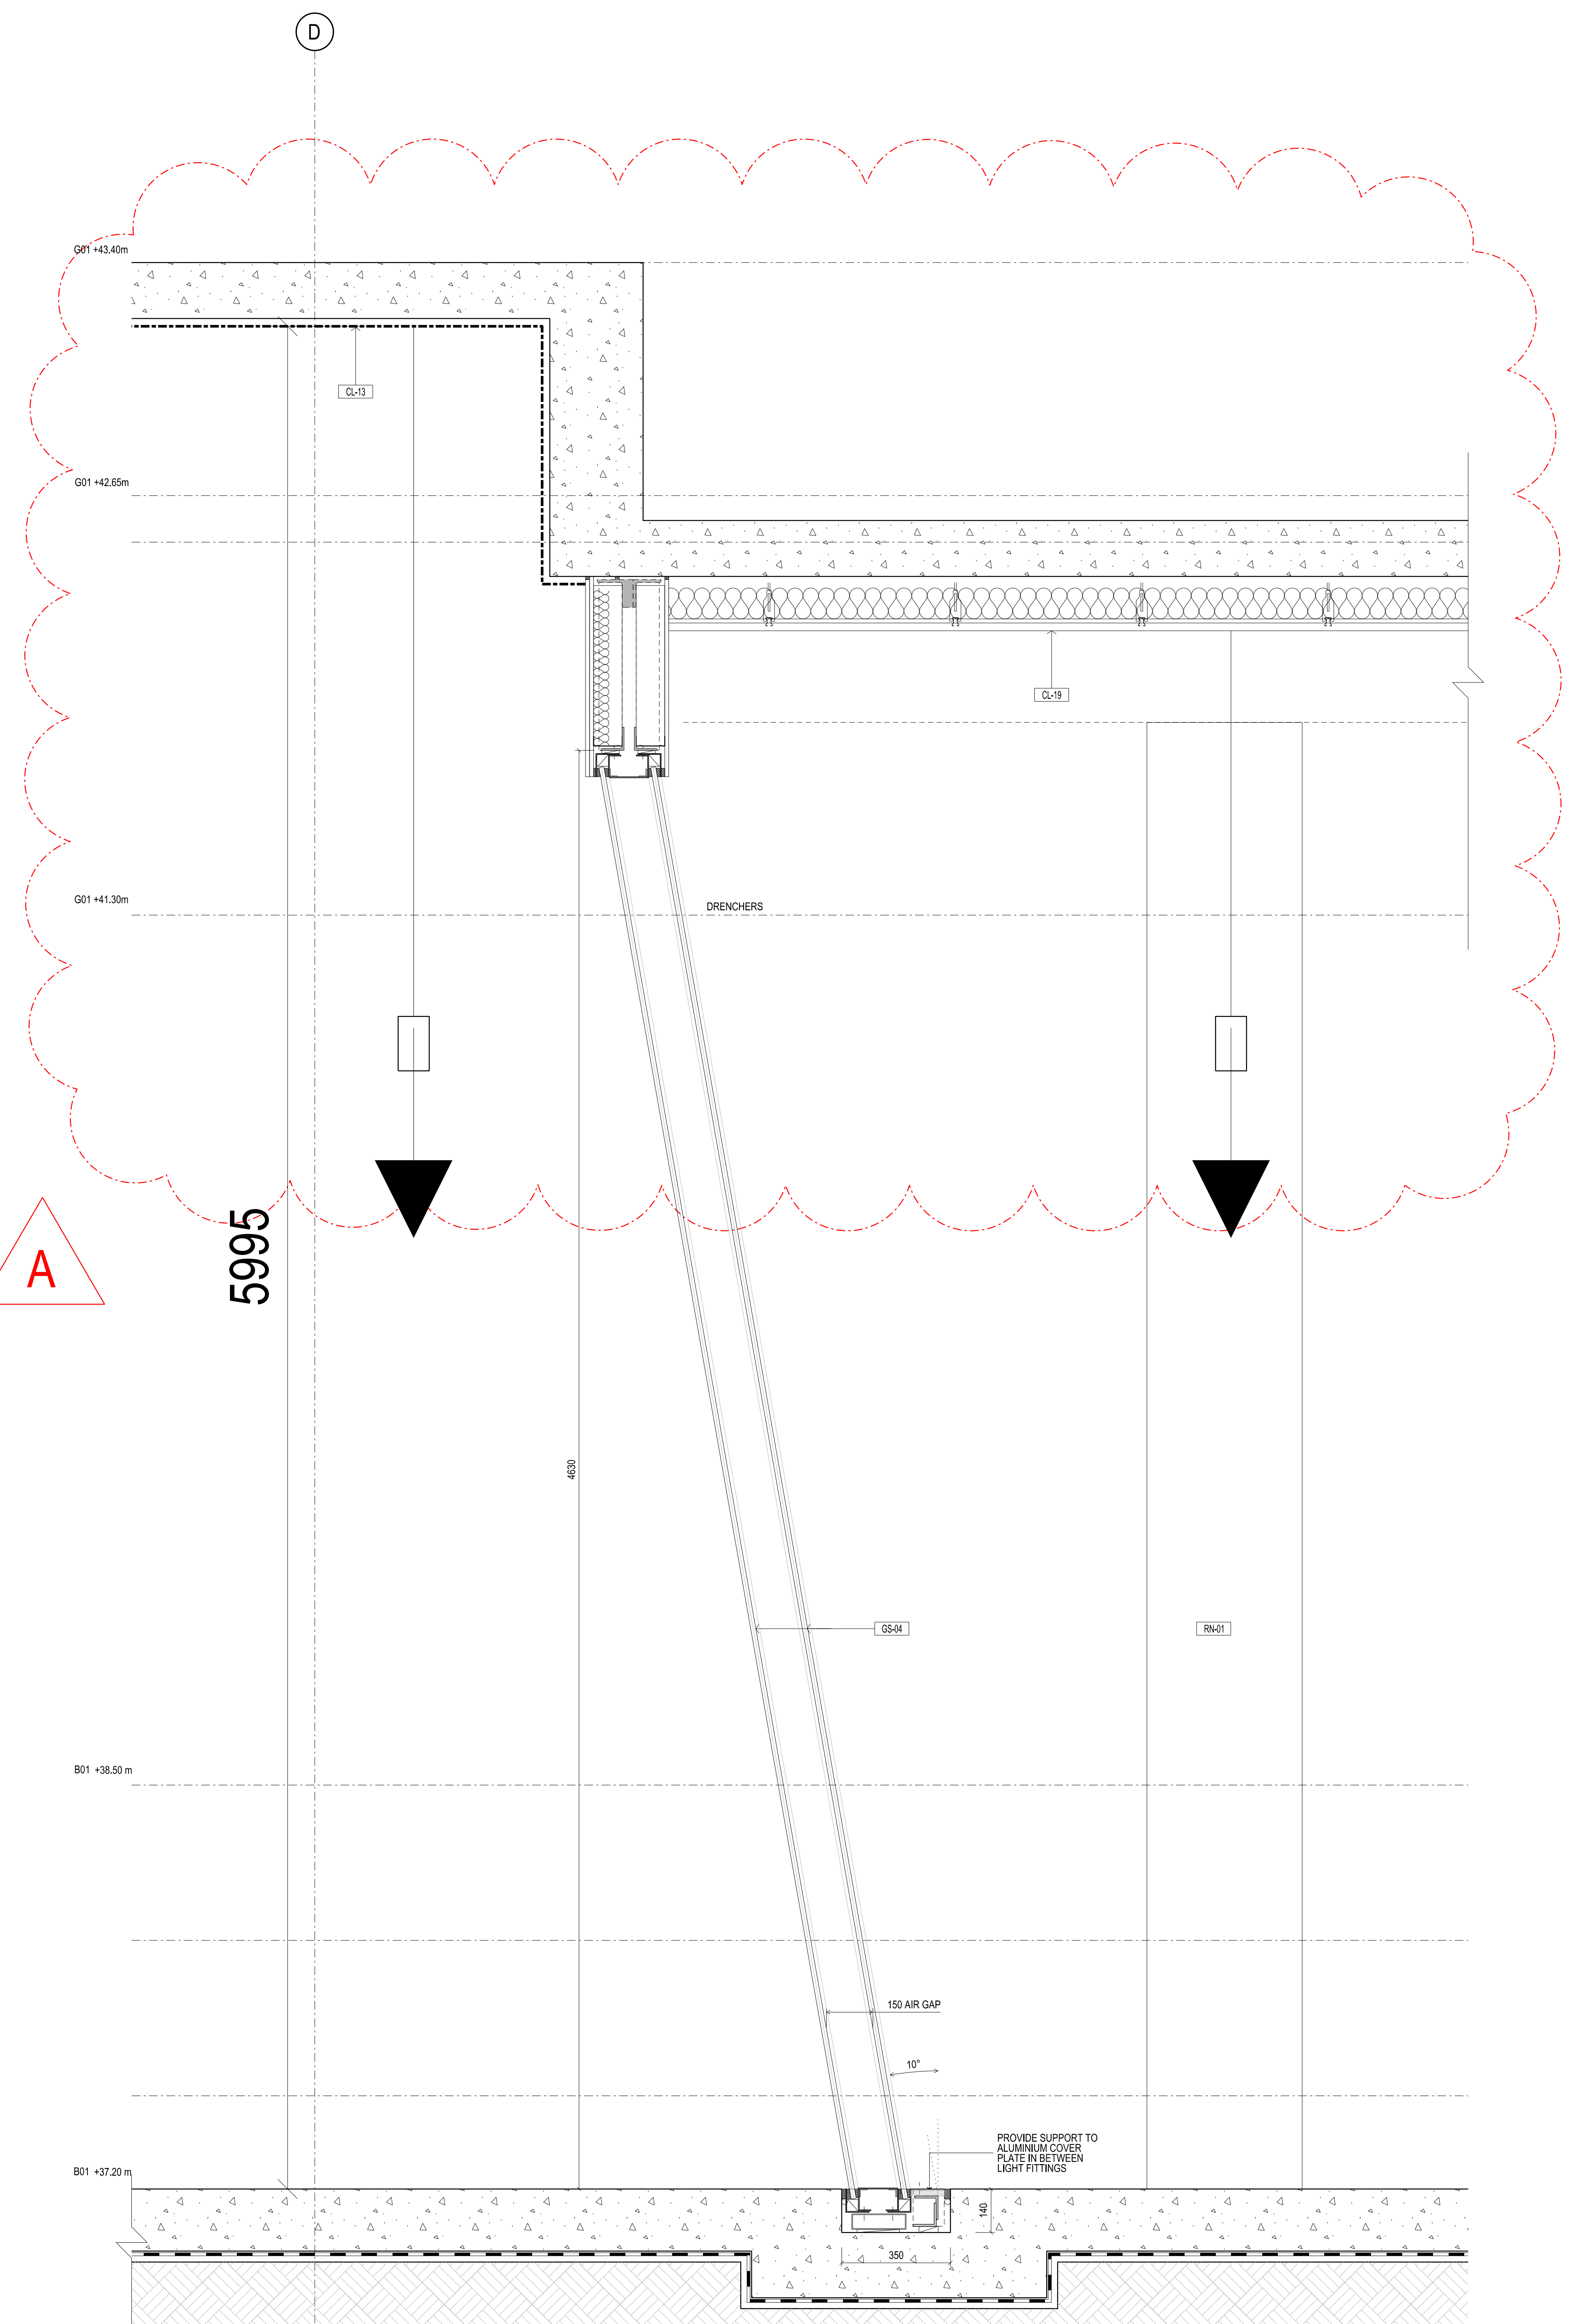

Rev	Issue	Revision Description	Amd	Date
A	SG	ISSUED FOR CONSTRUCTION		10.01.14
01	SG	100% CO - TENDER ISSUE		07.09.12

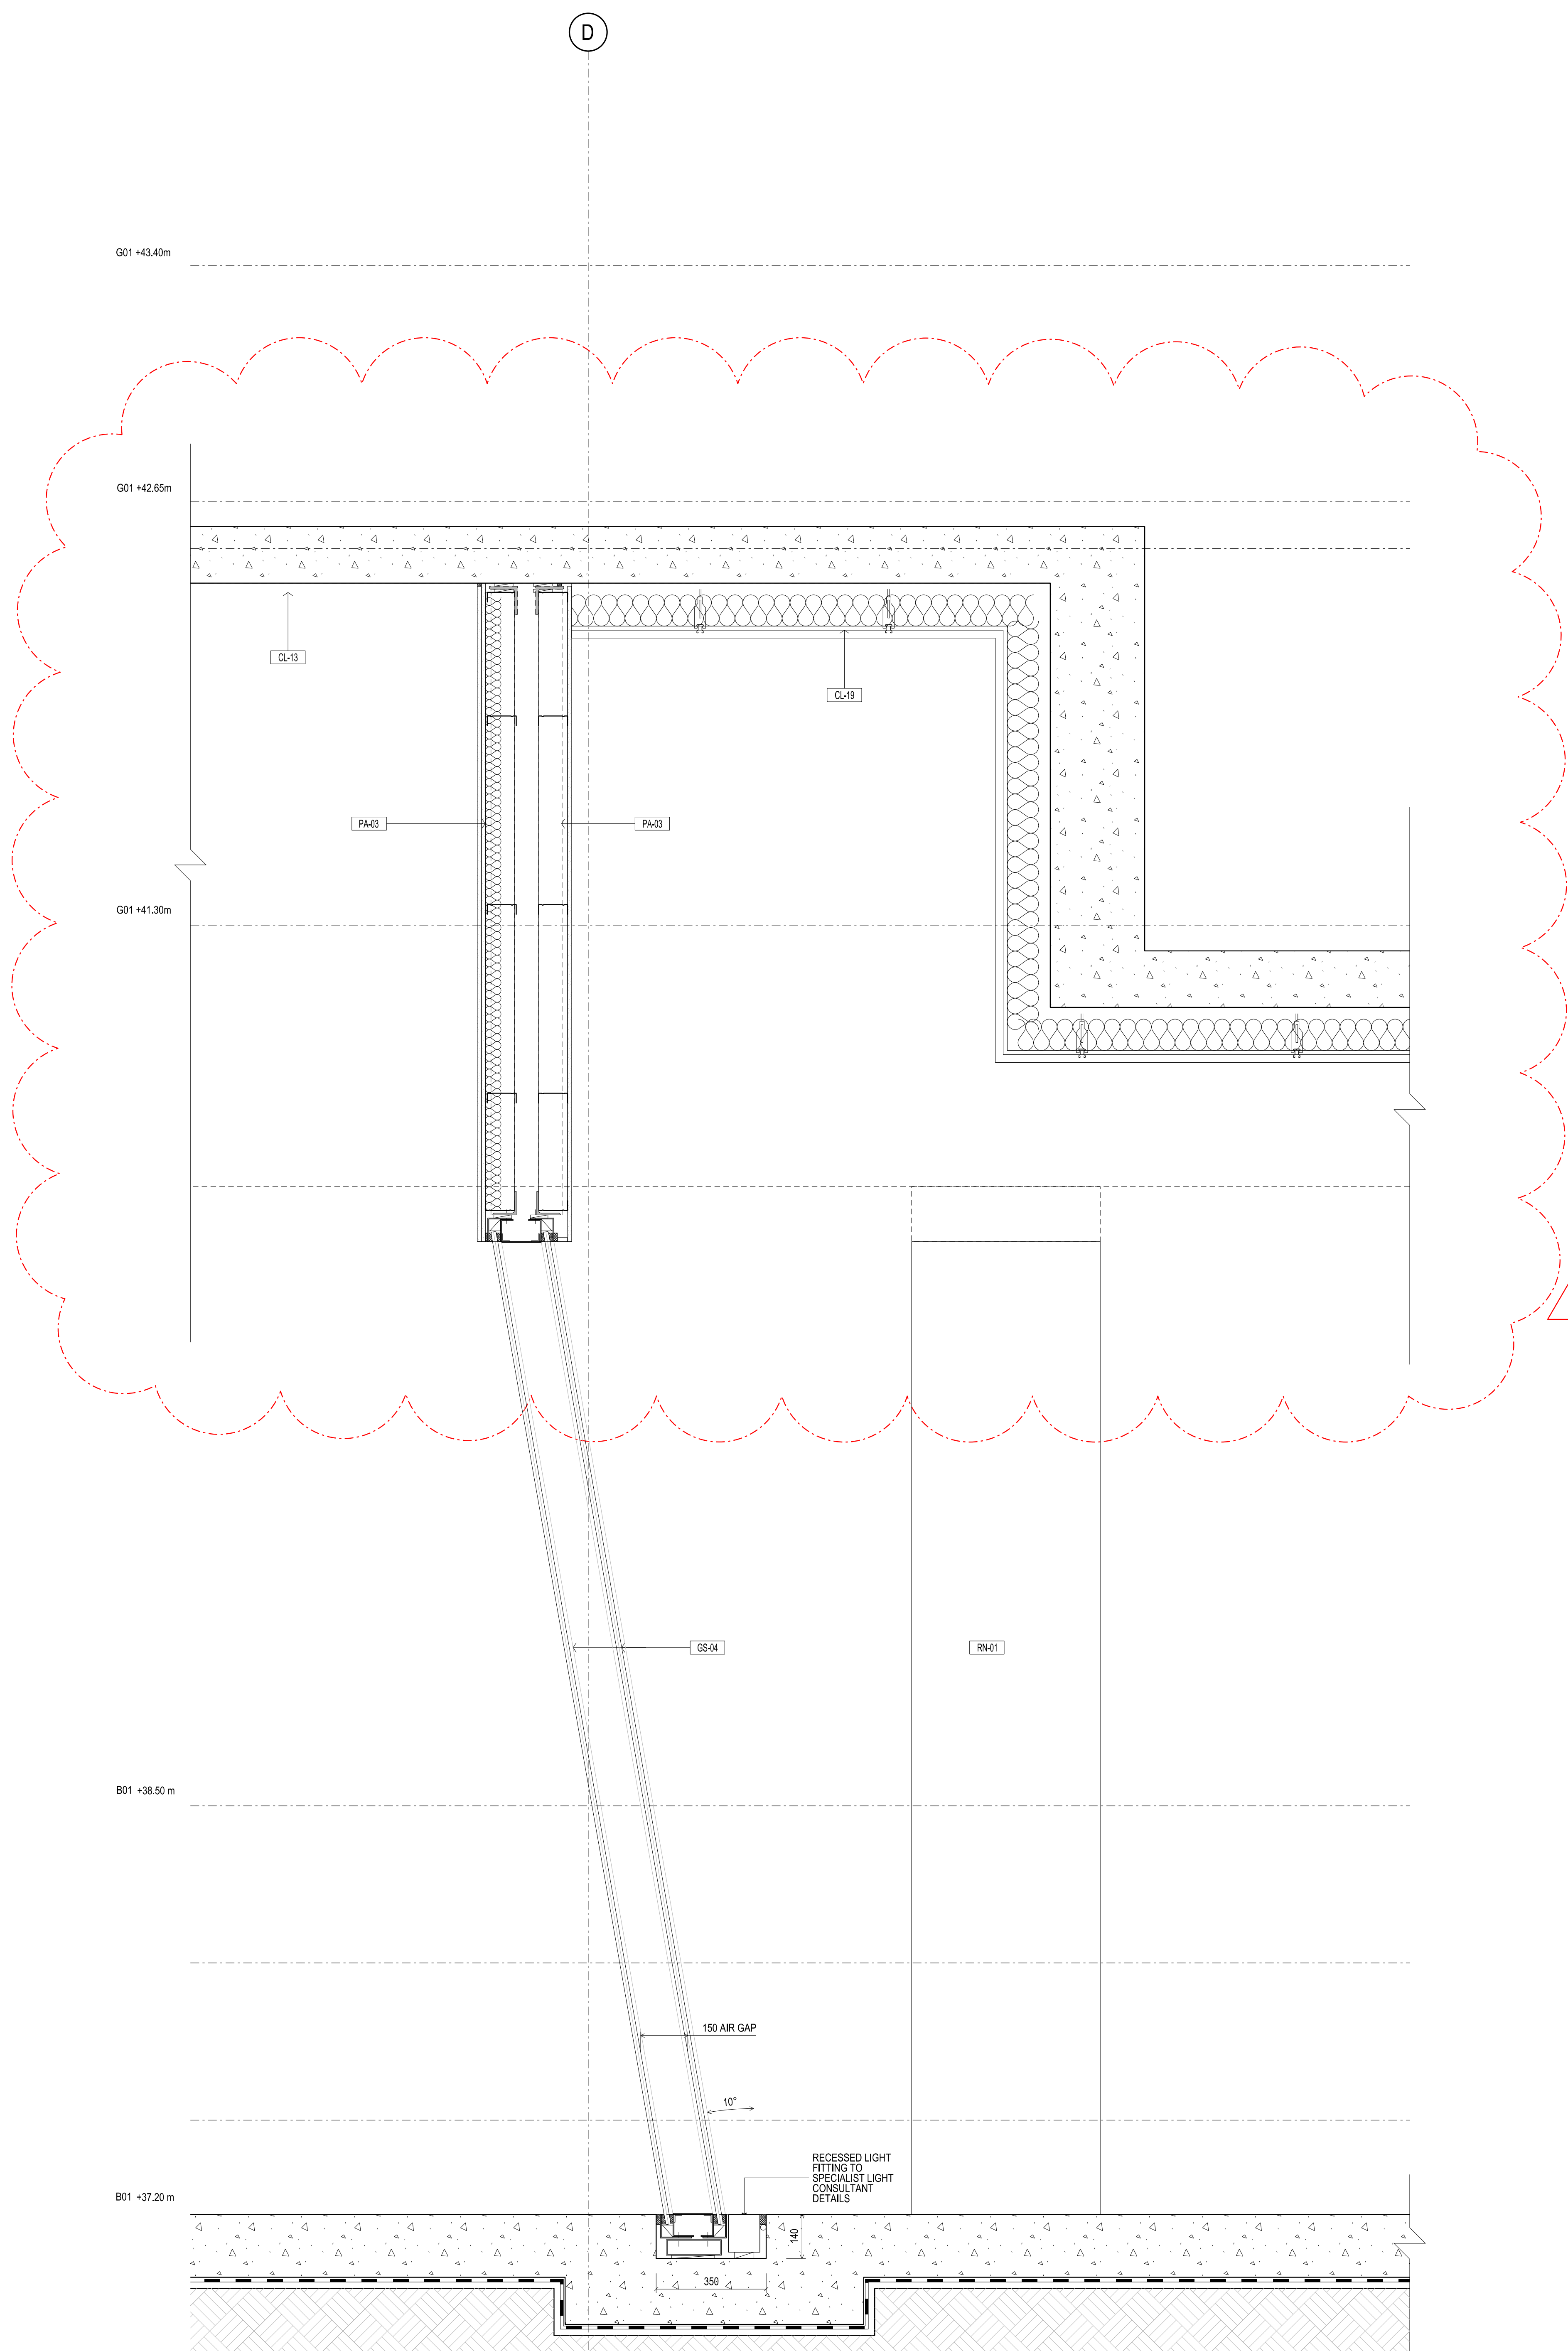

NADAAA
 NADAAA
 1520 Washington Street No.2 Boston Massachusetts 02118 USA
 Telephone: +1 617 442 8232
 Facsimile: +1 688 442 1417
 Email: nadaaa@nadaaa.com

John Wardle Architects
 25 Rokeby Street, Collingwood, Victoria 3066 Australia
 Tel: +61 3 8662 0400 www.johnwardlearchitects.com
 © 2012 John Wardle Architects ABN 83 006 814 268

Client: University of Melbourne Parkville Campus
 Project: Faculty of Architecture Building and Planning

Title: INTERNAL WALL SECTION DETAILS B01 - SHEET 1

Project No.	0913	Scale	1:10 @ A0 1:20 @ A2
Drawing No.	AR 7765	Revision	A

Date	Jul 2012	Dwn	Co-Ord	Chk
FILENAME	SFILES			

FOR CONSTRUCTION