


1 SECTION DETAIL - B01
7106 SCALE 1:10



2 SECTION DETAIL - B01
7105 SCALE 1:10

Rev	Issue	Revision Description	And	Date
B	SG	BLOCKWORK REPLACED WITH STUDWORK	-	16.12.13
A	SG	LED LIGHT FITTING ADDED	-	30.09.13
03	SG	WL-14 DELETED AS PER VM	-	18.07.13
02	SG	100% CD - TENDER ISSUE	-	07.09.12
01	SG	90% CD ISSUE	-	10.08.12

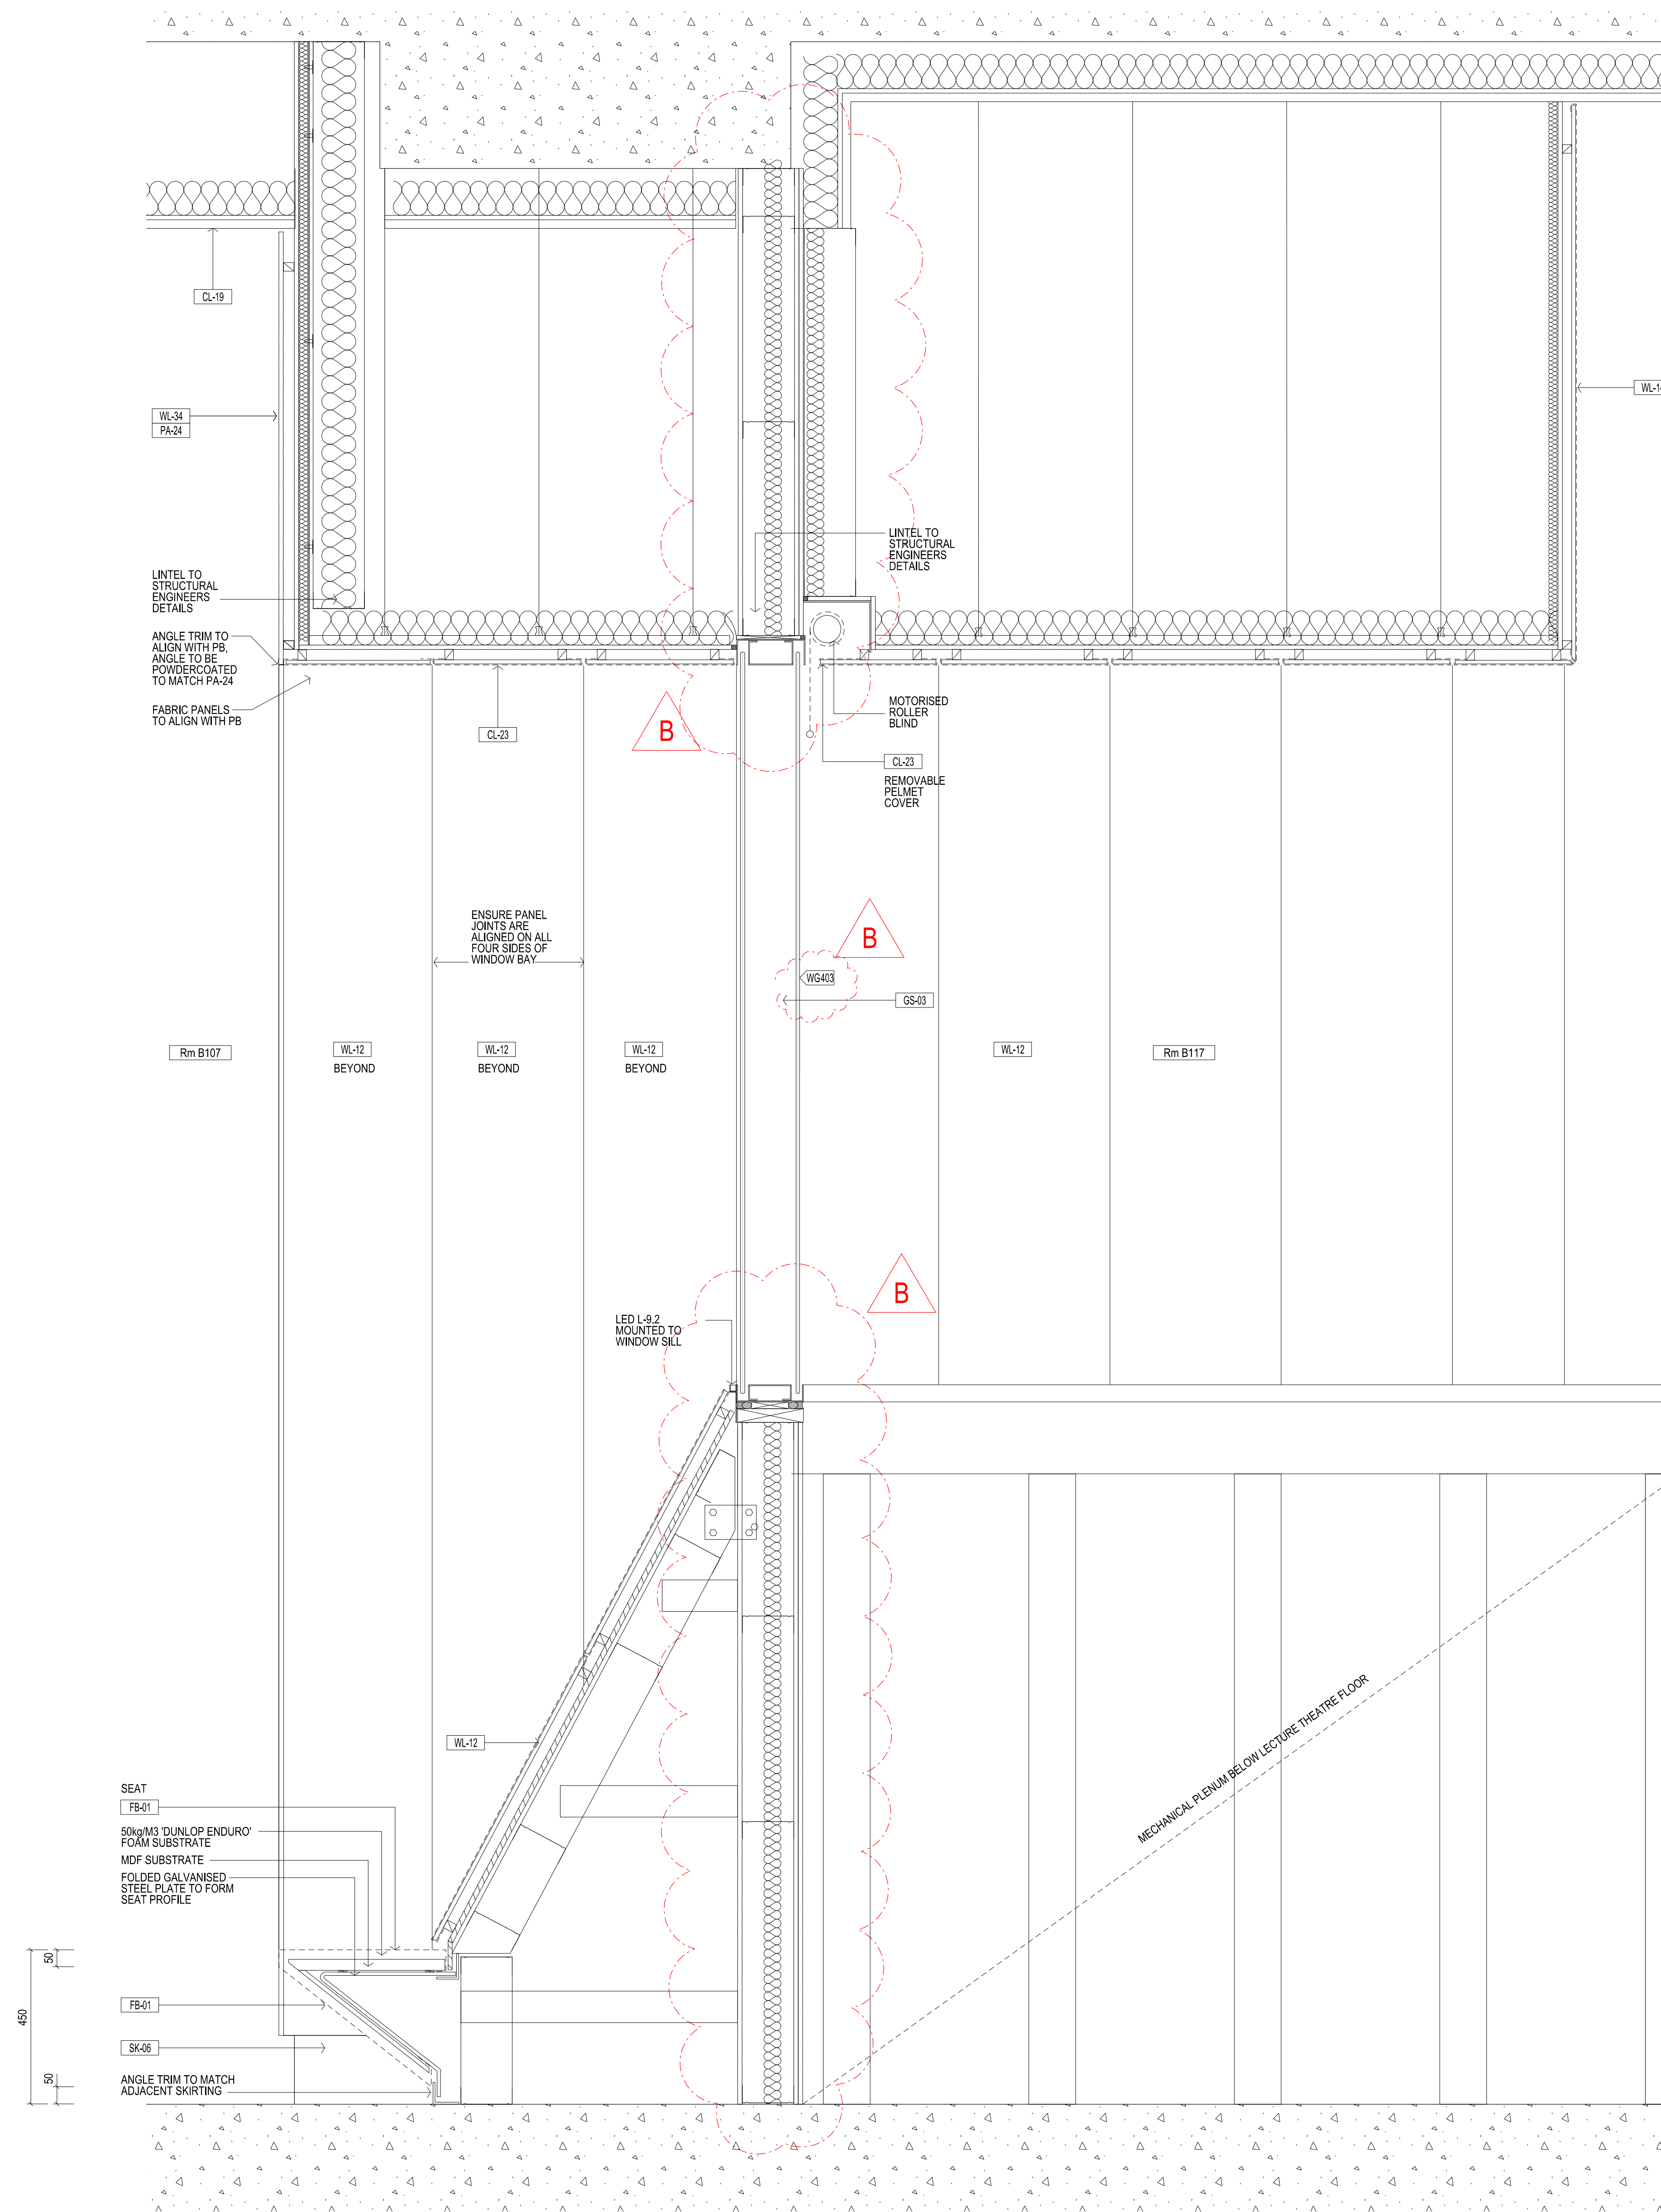

NADAAA
 NADAAA
 1520 Washington Street No.2
 Boston Massachusetts 02118 USA
 Telephone +1 817 442 8232
 Facsimile +1 888 442 1417
 Email nad@nadaaa.com

John Wardle Architects
 25 Rokeby Street, Collingwood, Victoria 3066 Australia
 Tel: +61 3 8662 0400 www.johnwardlearchitects.com
 © 2012 John Wardle Architects ABN 83 006 814 268

Client **University of Melbourne Parkville Campus**

Project **Faculty of Architecture Building and Planning**

Title **INTERNAL WALL SECTION DETAILS B01 - SHEET 1**

Project No.	0913	Scale	1:10 @ A0 1:20 @ A2
Drawing No.	AR 7766	Revision	B

Date Jul 2012 Dwn - Co-Ord - Chk -

FILENAME - \$FILES

FOR CONSTRUCTION