

CONTRACTORS SHALL VERIFY DIMENSIONS BEFORE ANY JOB COMMENCES. ALL SHOP DRAWINGS SHALL BE SUBMITTED TO THE SUPERINTENDENT AND MANUFACTURER SHALL NOT COMMENCE PRIOR TO THE RETURN OF POWERED SHOP DRAWINGS ISSUED BY THE CONSULTANT. FIGURED DIMENSIONS SHALL TAKE PRECEDENCE OVER SCALES. THIS DRAWING SHALL BE READ IN CONJUNCTION WITH ALL RELEVANT CONTRACT SPECIFICATIONS AND DRAWINGS COPYRIGHT OF THIS DRAWING IS VESTED IN WARDLE

General Notes

Rev	Issue	Revision Description	And	Date
A	SG	BLOCKWORK REPLACED WITH STUDWORK	-	16.12.13
03	SG	CL-07 & WL-14 DELETED AS PER VM	-	18.07.13
	SG	CEILING LEVELS CLARIFIED	-	
02	SG	100% CD - TENDER ISSUE	-	07.08.12
01	SG	90% CD ISSUE	-	10.08.12



**NADAAA**  
 NADAAA  
 1020 Washington Street No.2 Boston Massachusetts 02118 USA  
 Telephone +1 617 442 8232 Facsimile +1 688 442 1417 Email nad@nadaaa.com

**John Wardle Architects**  
 25 Rokeby Street, Collingwood, Victoria 3066 Australia  
 Tel: +61 3 8662 0400 www.johnwardlearchitects.com  
 © 2012 John Wardle Architects ABN 83 006 814 268


Client **University of Melbourne Parkville Campus**

Project **Faculty of Architecture Building and Planning**


Title **INTERNAL WALL SECTION DETAILS B01 - SHEET 1**

Project No.	<b>0913</b>	Scale	1:10 @ A0 1:20 @ A2
Drawing No.	<b>AR 7767</b>	Revision	<b>A</b>
Date	Jul 2012	Dwn	Co-Ord
FILENAME - \$FILES		Chk	


**FOR CONSTRUCTION**

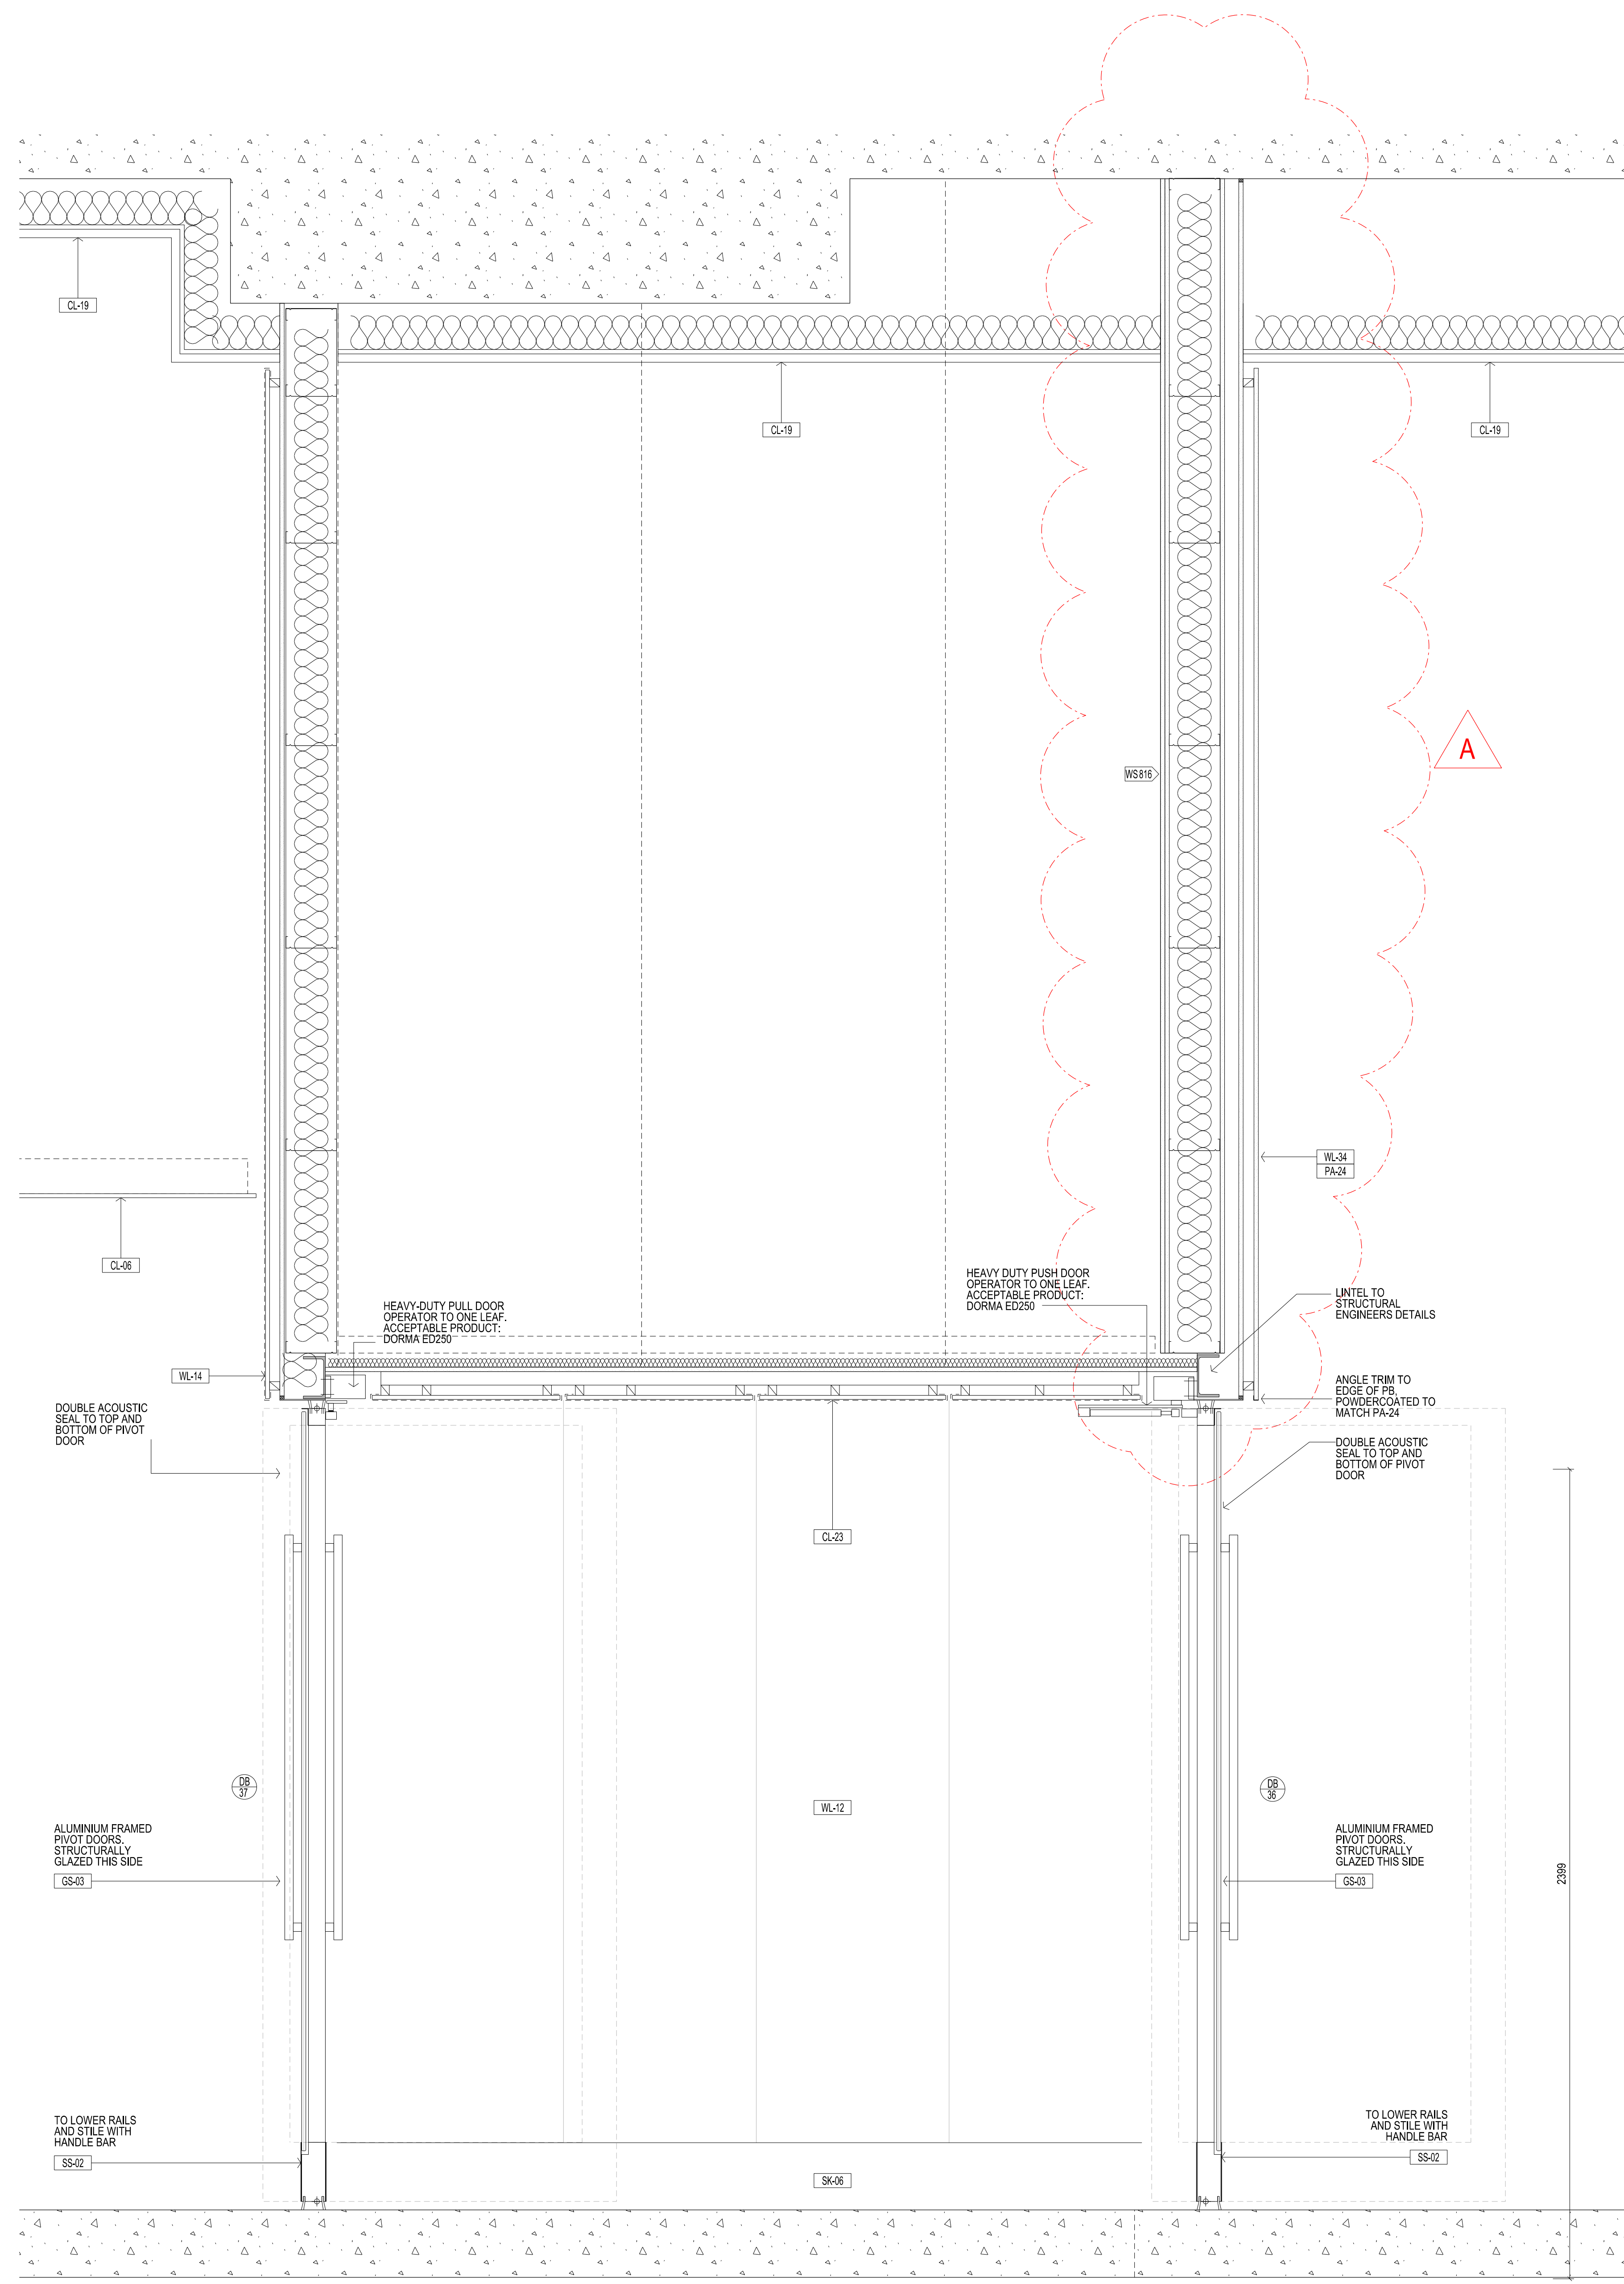

1 SECTION DETAIL - B01  
SCALE 1:10

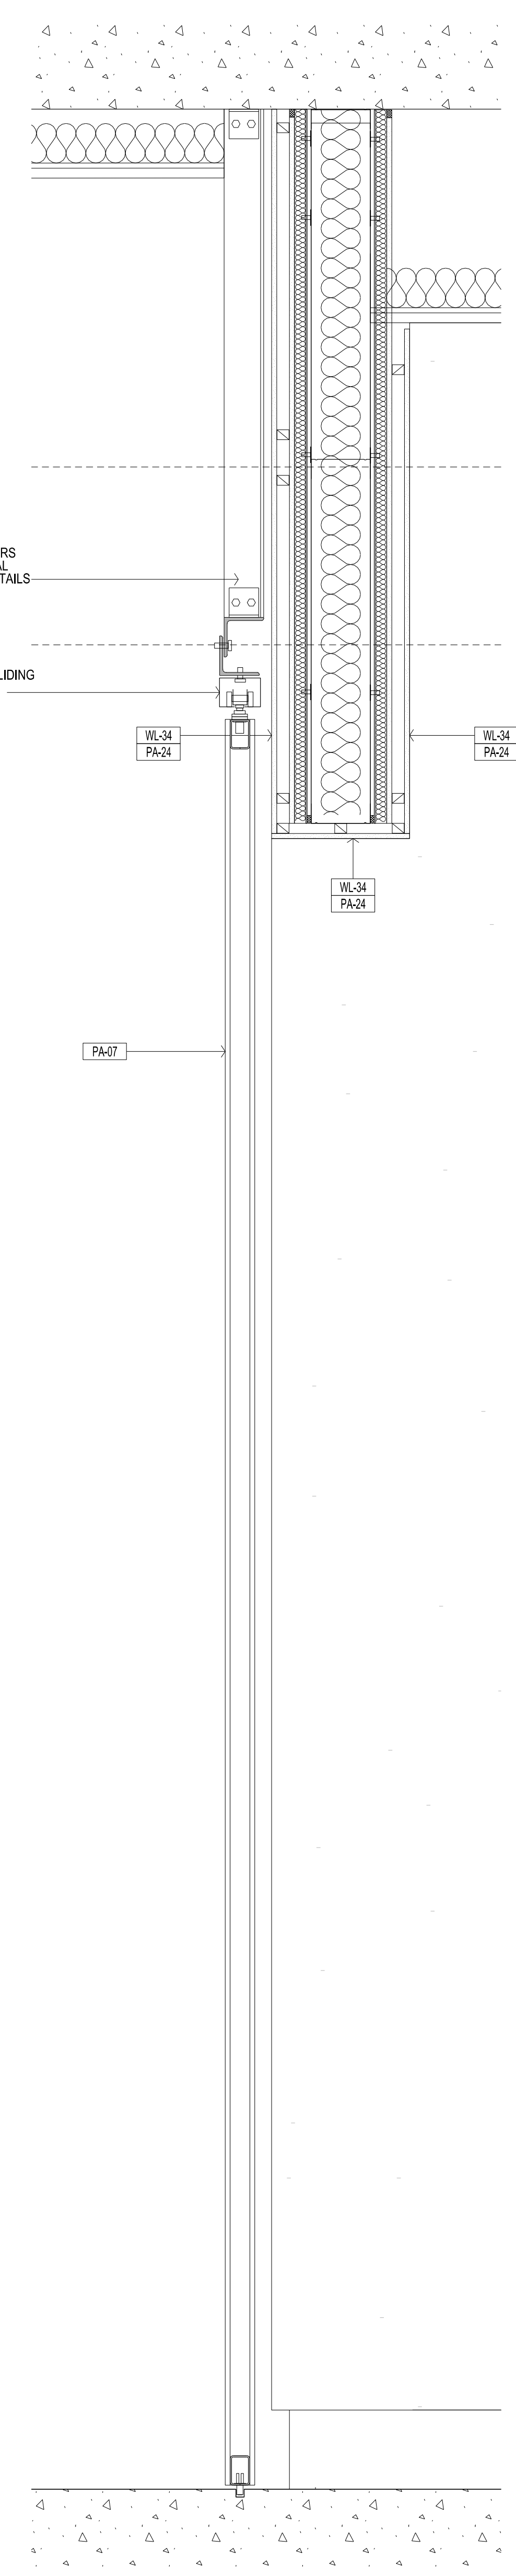

2 SECTION DETAIL - B01  
SCALE 1:10

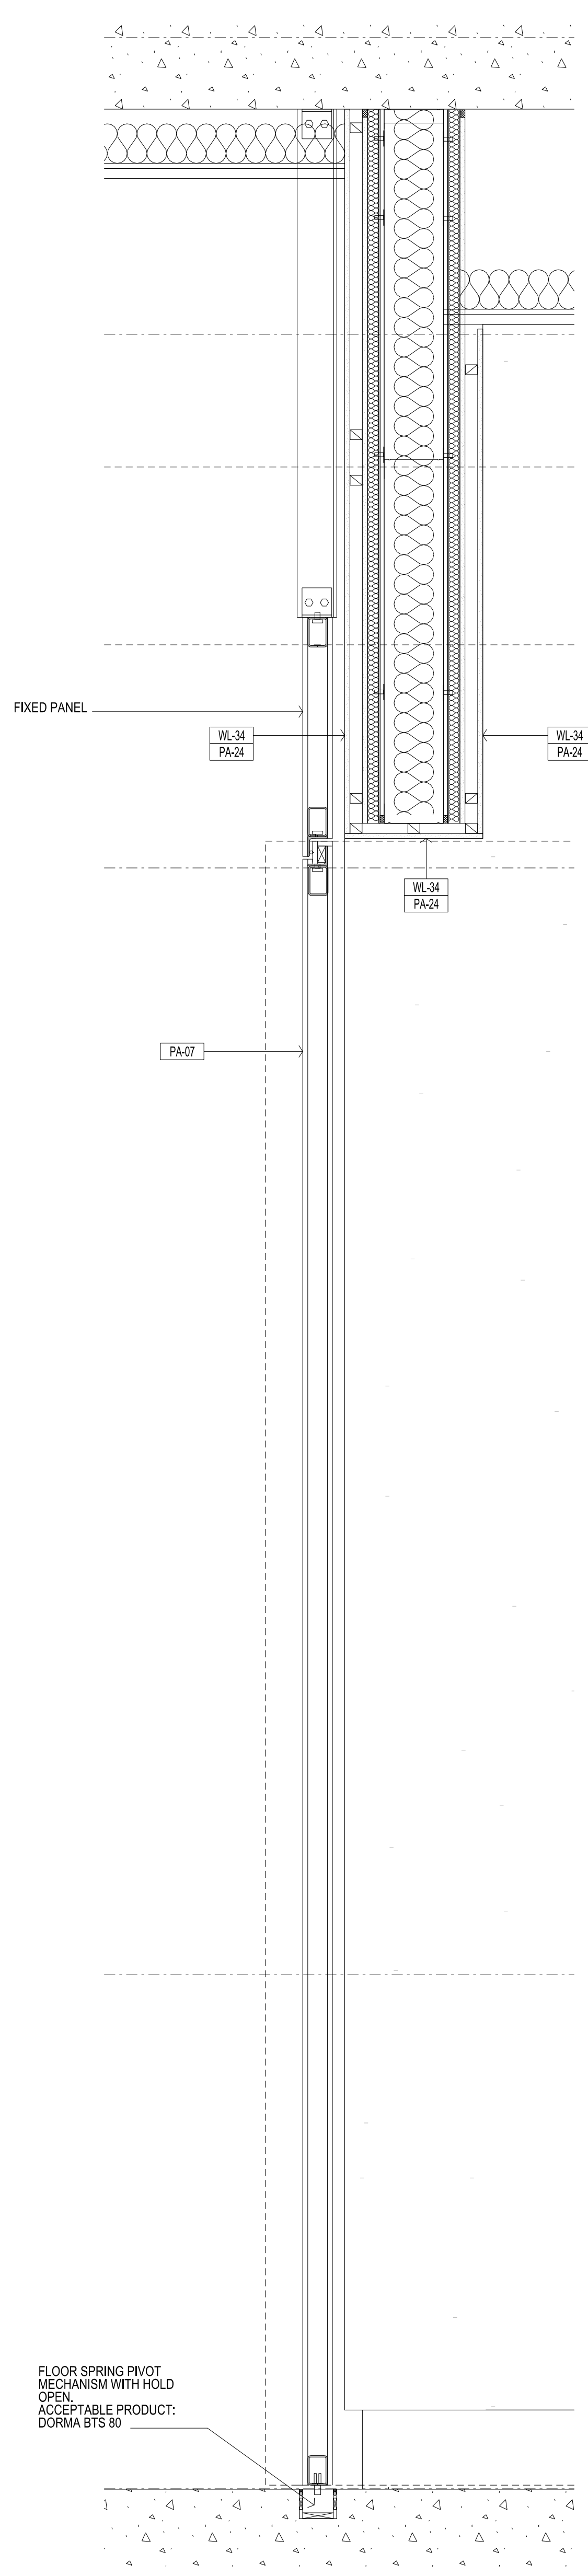

3 SECTION DETAIL - B01  
SCALE 1:10