



THIS DRAWING IS AN UNCONTROLLED COPY UNLESS STAMPED OTHERWISE

CONTRACTORS SHALL VERIFY JOB DIMENSIONS BEFORE ANY JOB COMMENCES. ALL SHOP DRAWINGS SHALL BE SUBMITTED TO THE SUPERINTENDENT AND MANUFACTURE SHALL NOT COMMENCE PRIOR TO THE RETURN OF DIMENSIONS SHOP DRAWINGS REVIEWED BY THE CONSULTANT. DIMENSIONS SHALL TAKE PRECEDENCE OVER SCALES. THIS DRAWING SHALL BE READ IN CONJUNCTION WITH ALL RELEVANT CONTRACT SPECIFICATIONS AND DRAWINGS COPYRIGHT OF THIS DRAWING IS VESTED IN WARDLE.

General Notes

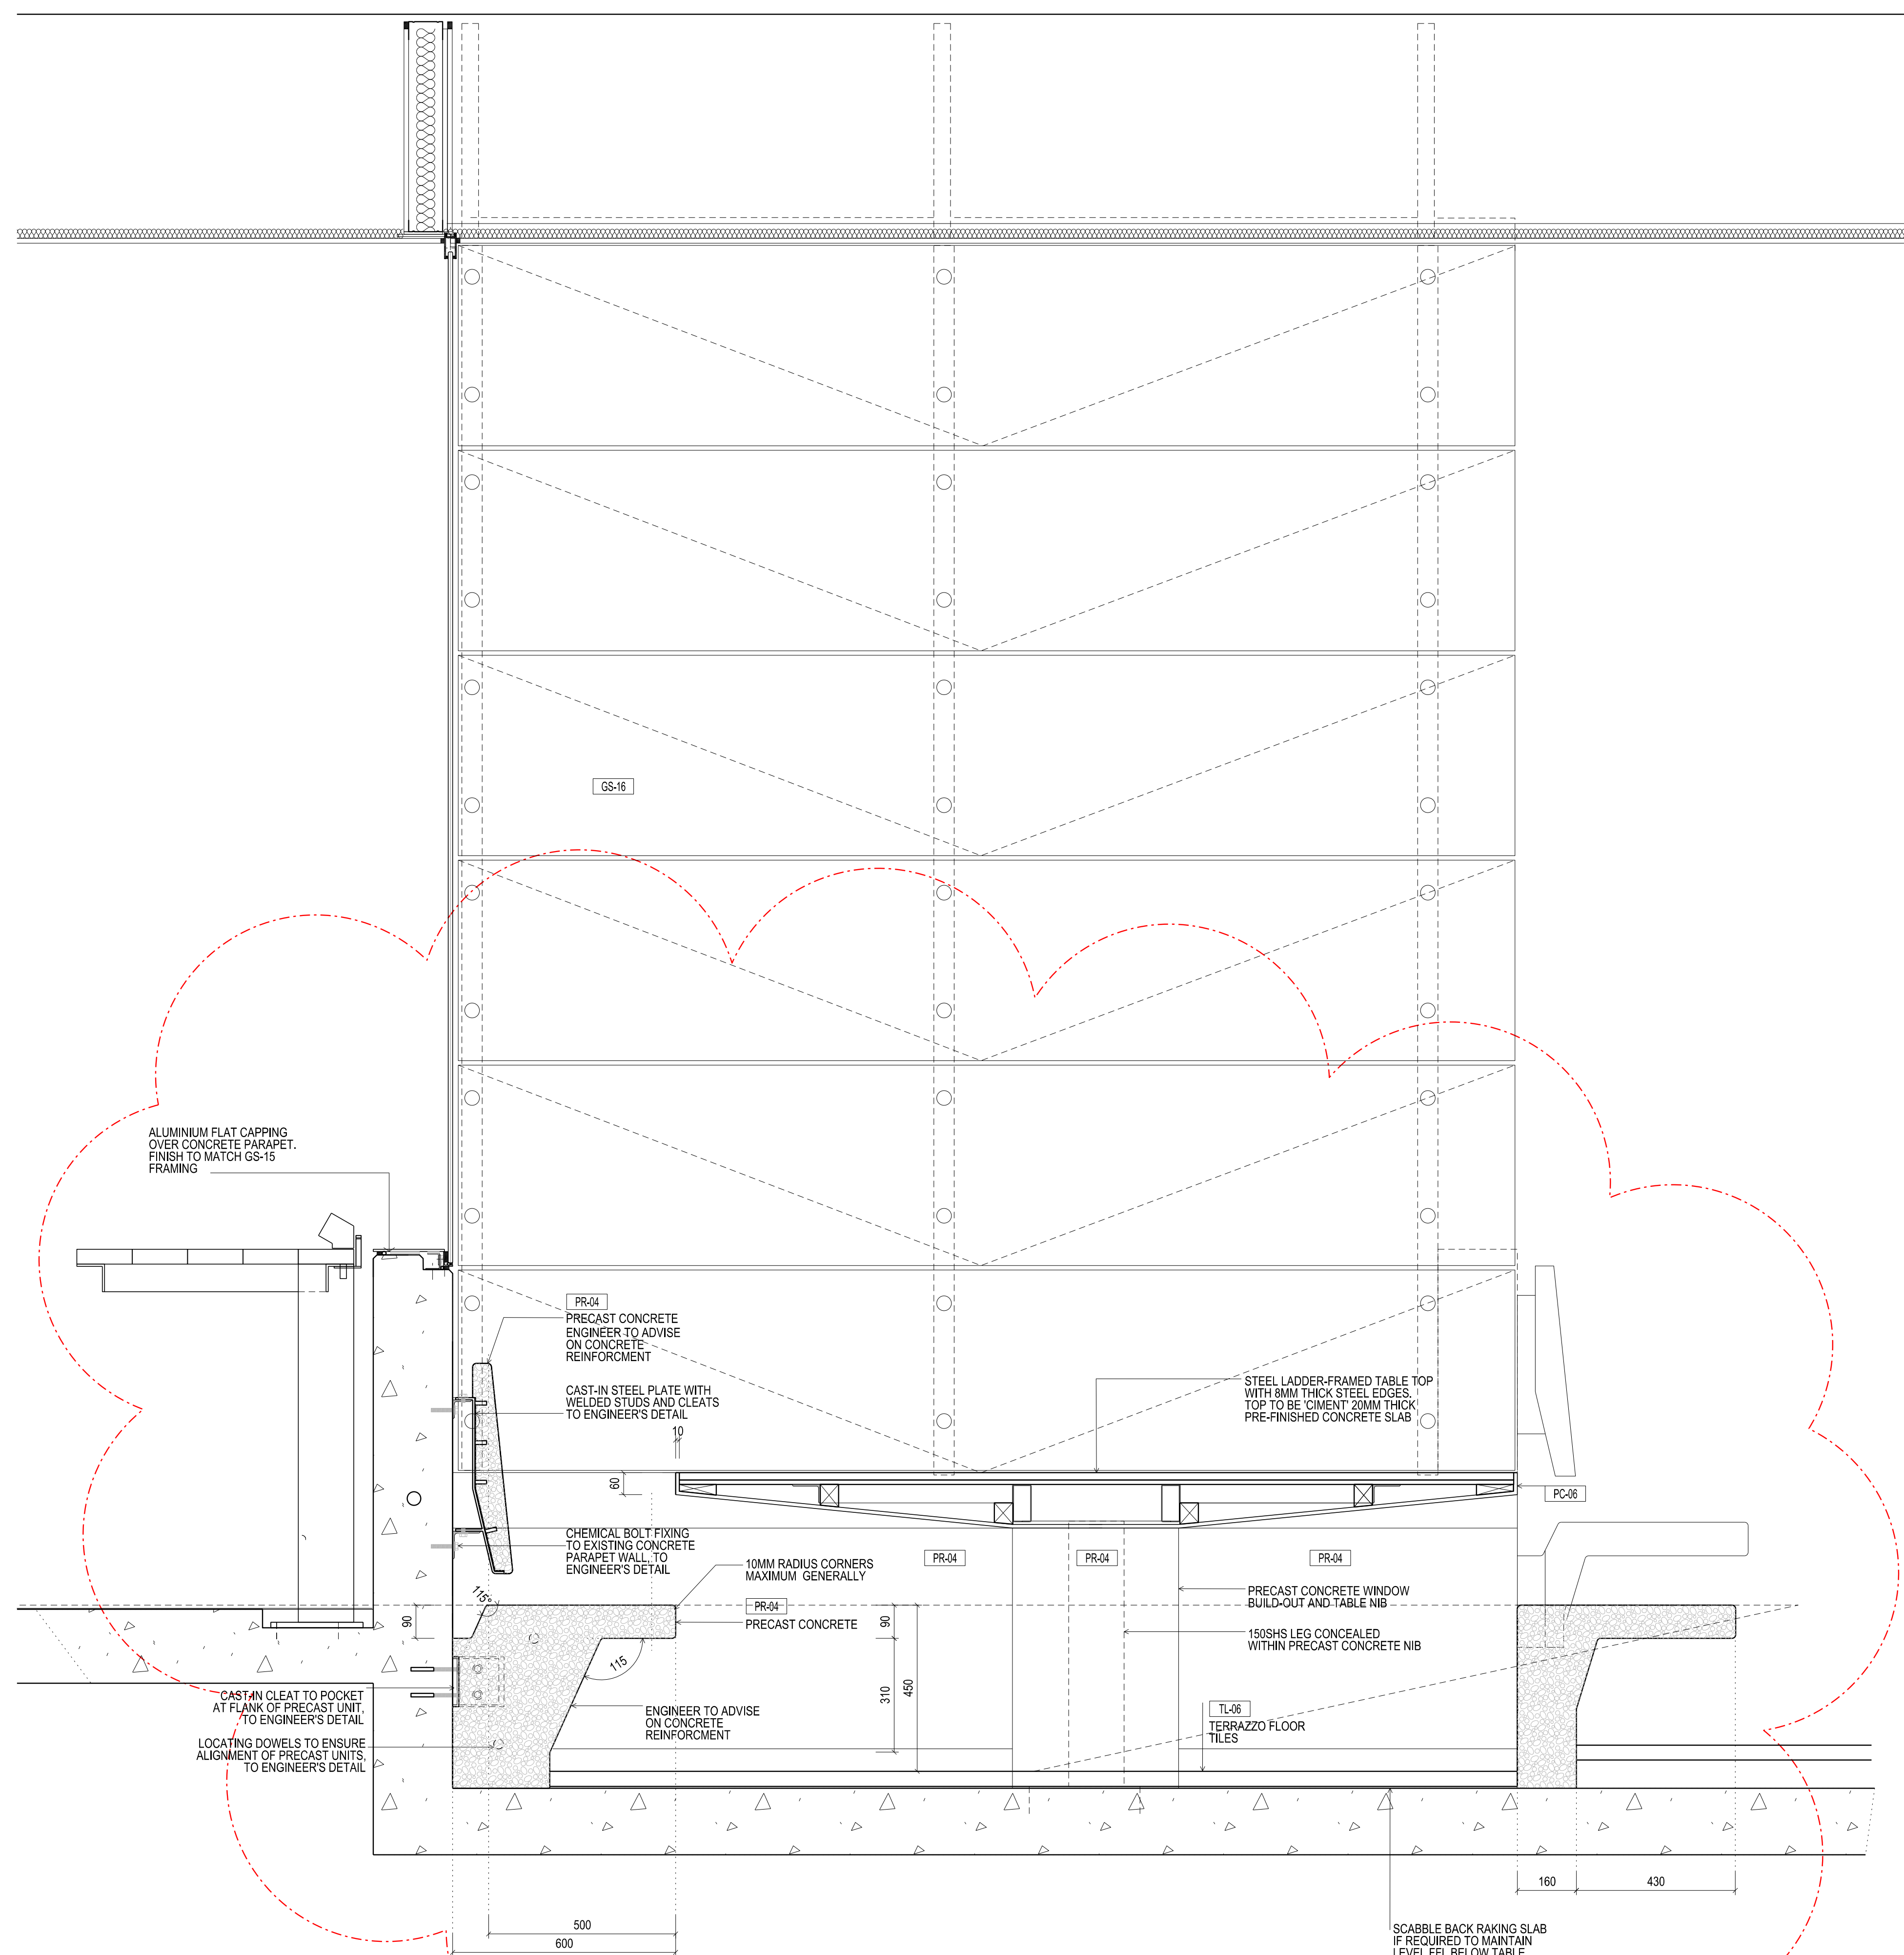

01 SECTION DETAIL - PC-04 BENCH SEATING SCALE 1:10

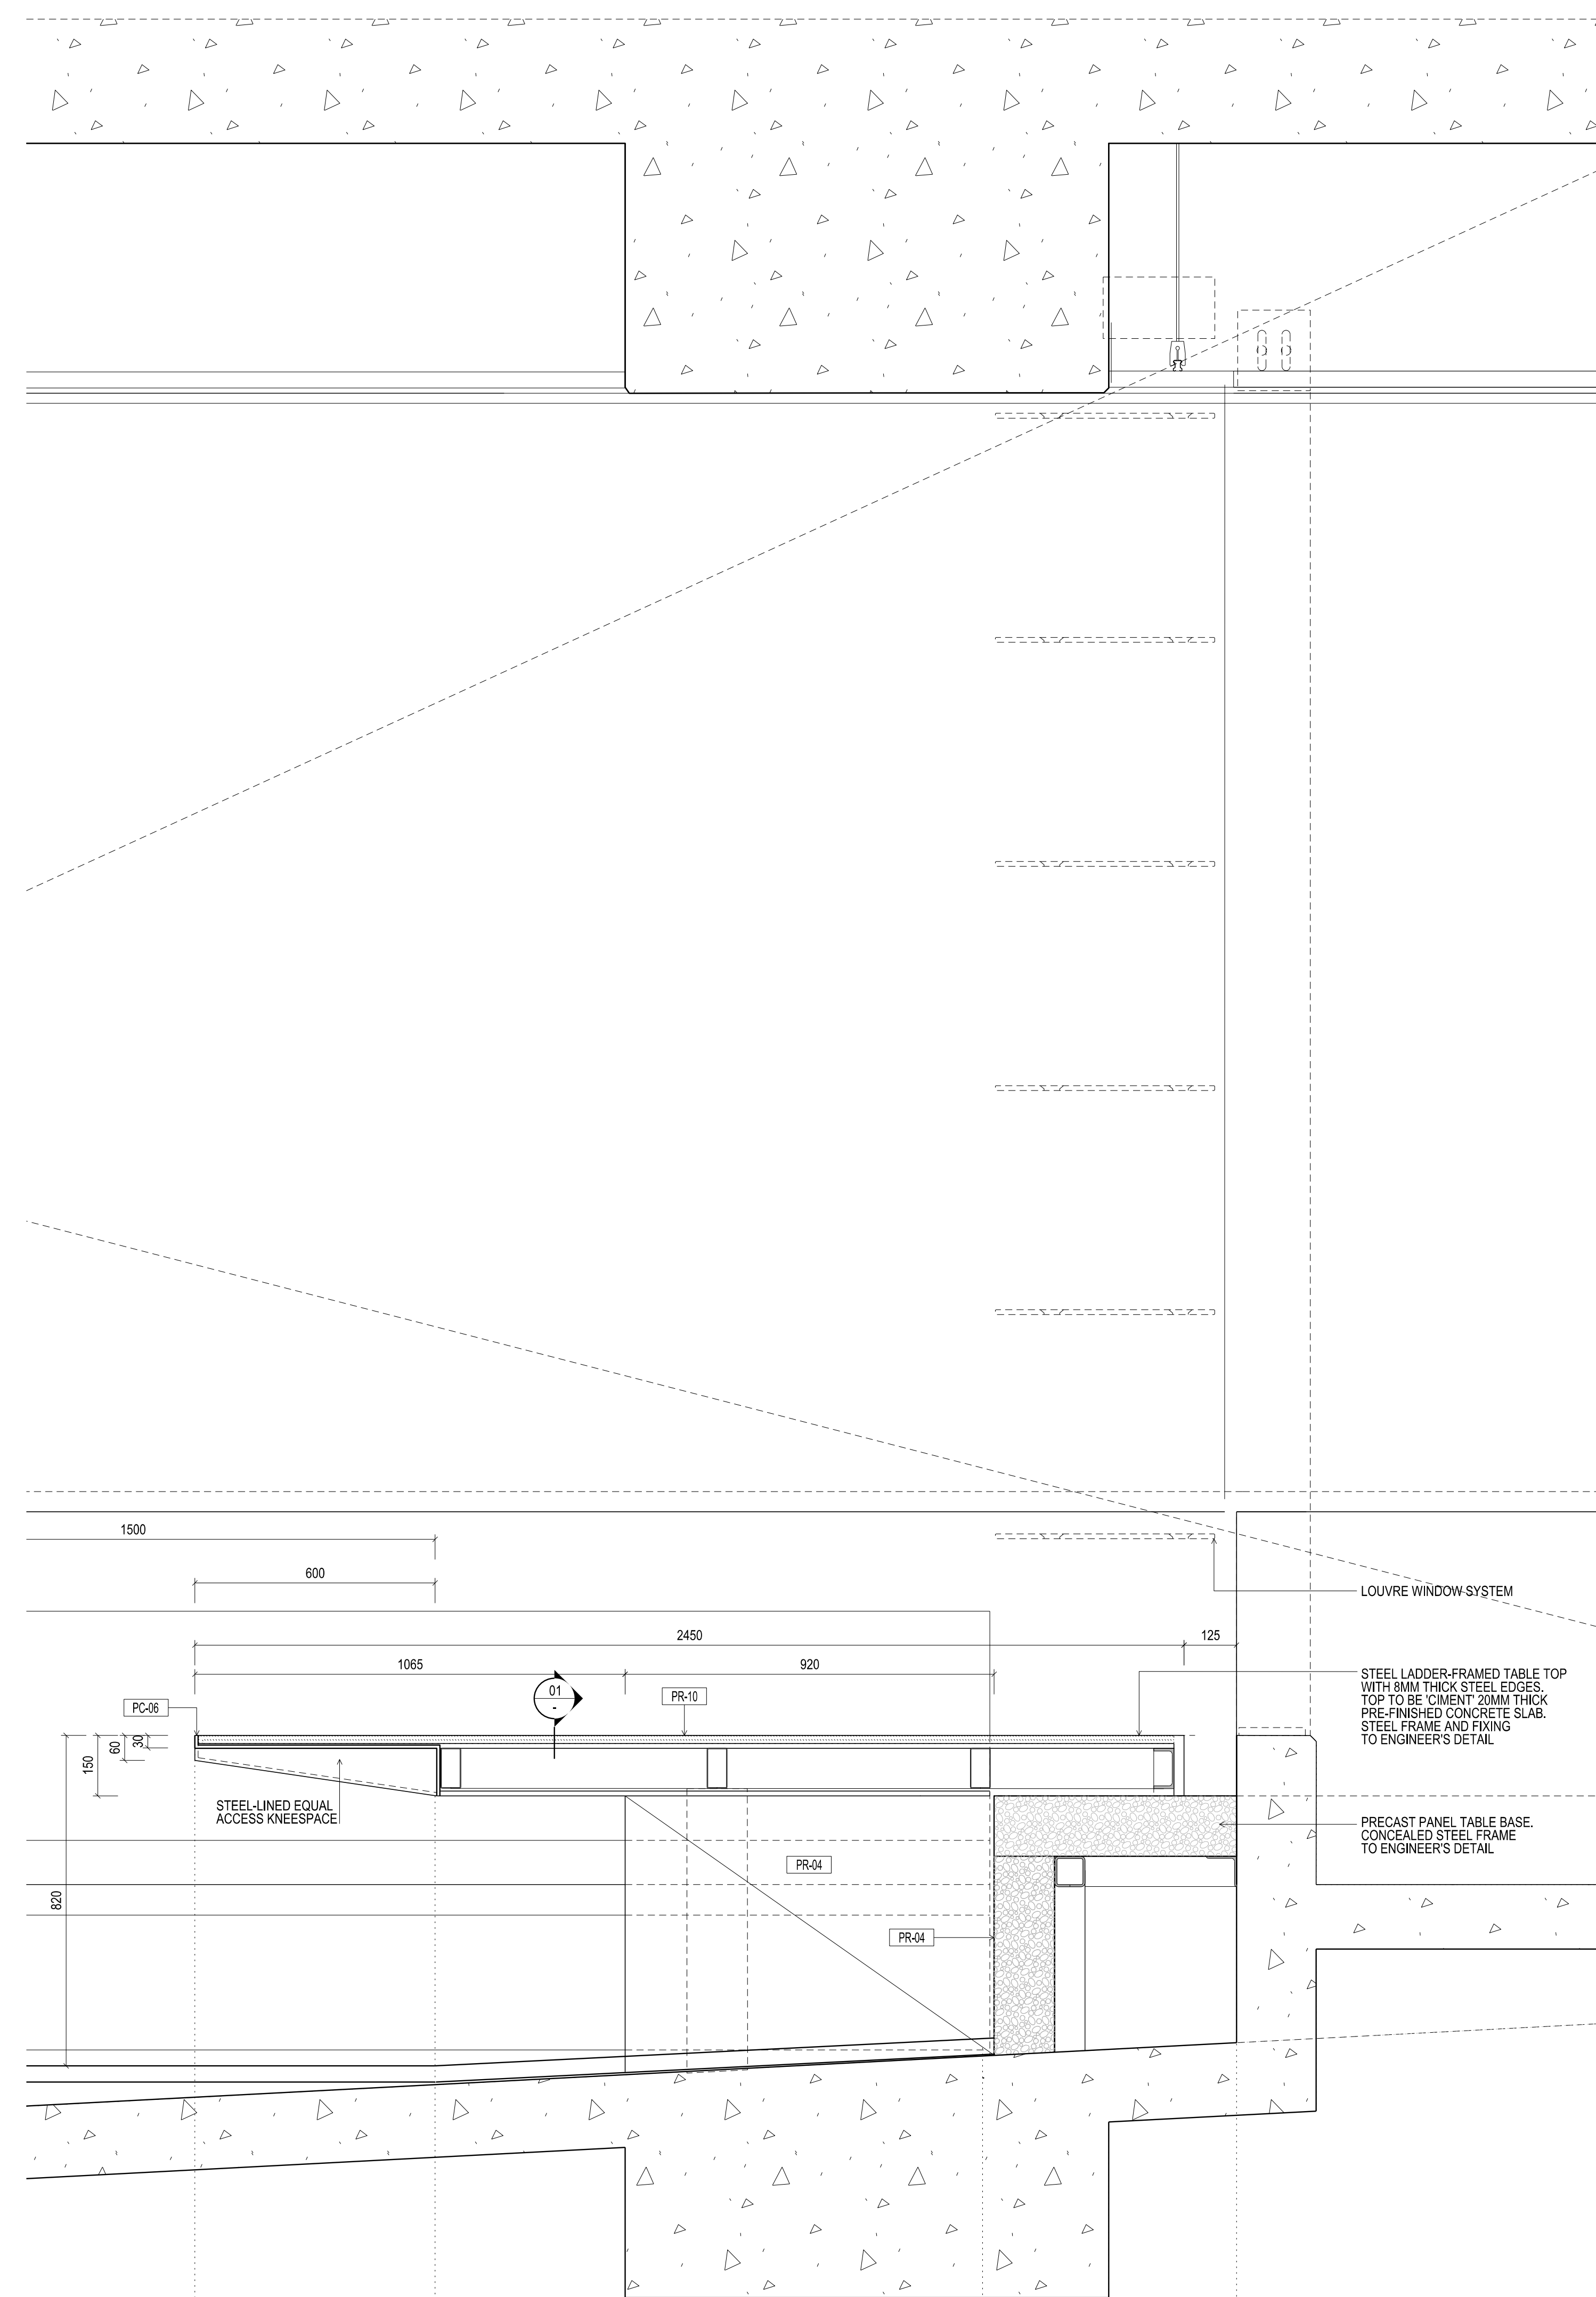

02 SECTION DETAIL - PC-04 BENCH SEATING & TABLE SCALE 1:10

Rev	Issue	Revision Description	And	Date
A	SG	FOR CONSTRUCTION		JL
	SG	AMEND PRECAST BENCH SEATING		
	SG	ADJ GLAZING LINE, ADJ CONC PROFILES		08.12.13
02	SG	100% CD - TENDER ISSUE		07.09.12
01	SG	90% CD ISSUE		10.09.12



**NADAAA**  
 NADAAA  
 1520 Washington Street No.2 Boston Massachusetts 02118 USA  
 Telephone +1 617 442 8232 Facsimile +1 617 442 1417 Email nad@nadaaa.com

**John Wardle Architects**  
 25 Rokeby Street, Collingwood, Victoria 3066 Australia  
 Tel: +61 3 8662 0400 www.johnwardlearchitects.com  
 © 2012 John Wardle Architects ABN 83 006 814 268

Client **University of Melbourne Parkville Campus**

Project **Faculty of Architecture Building and Planning**

Title **INTERNAL WALL SECTION DETAILS Ground Floor - SHEET 3**

Project No.	<b>0913</b>	Scale	1:10 @ A0 1:20 @ A2
Drawing No.	<b>AR 7773</b>	Revision	<b>A</b>

Date Jul 2012 Dwn - Co-Ord - Chk -

FILENAME - \$FILES

**FOR CONSTRUCTION**