


CONTRACTORS SHALL VERIFY DIMENSIONS BEFORE ANY WORK COMMENCES. ALL SHOP DRAWINGS SHALL BE SUBMITTED TO THE SUPERINTENDENT AND MANUFACTURER SHALL NOT COMMENCE PRIOR TO THE RETURN OF DIMENSIONS SHOP DRAWINGS REVIEWED BY THE CONSULTANT. DIMENSIONS SHALL TAKE PRECEDENCE OVER SCALES. THIS DRAWING SHALL BE READ IN CONJUNCTION WITH ALL RELATED CONTRACT SPECIFICATIONS AND DRAWINGS COPYRIGHT OF THIS DRAWING IS VESTED IN HANDLE.

General Notes



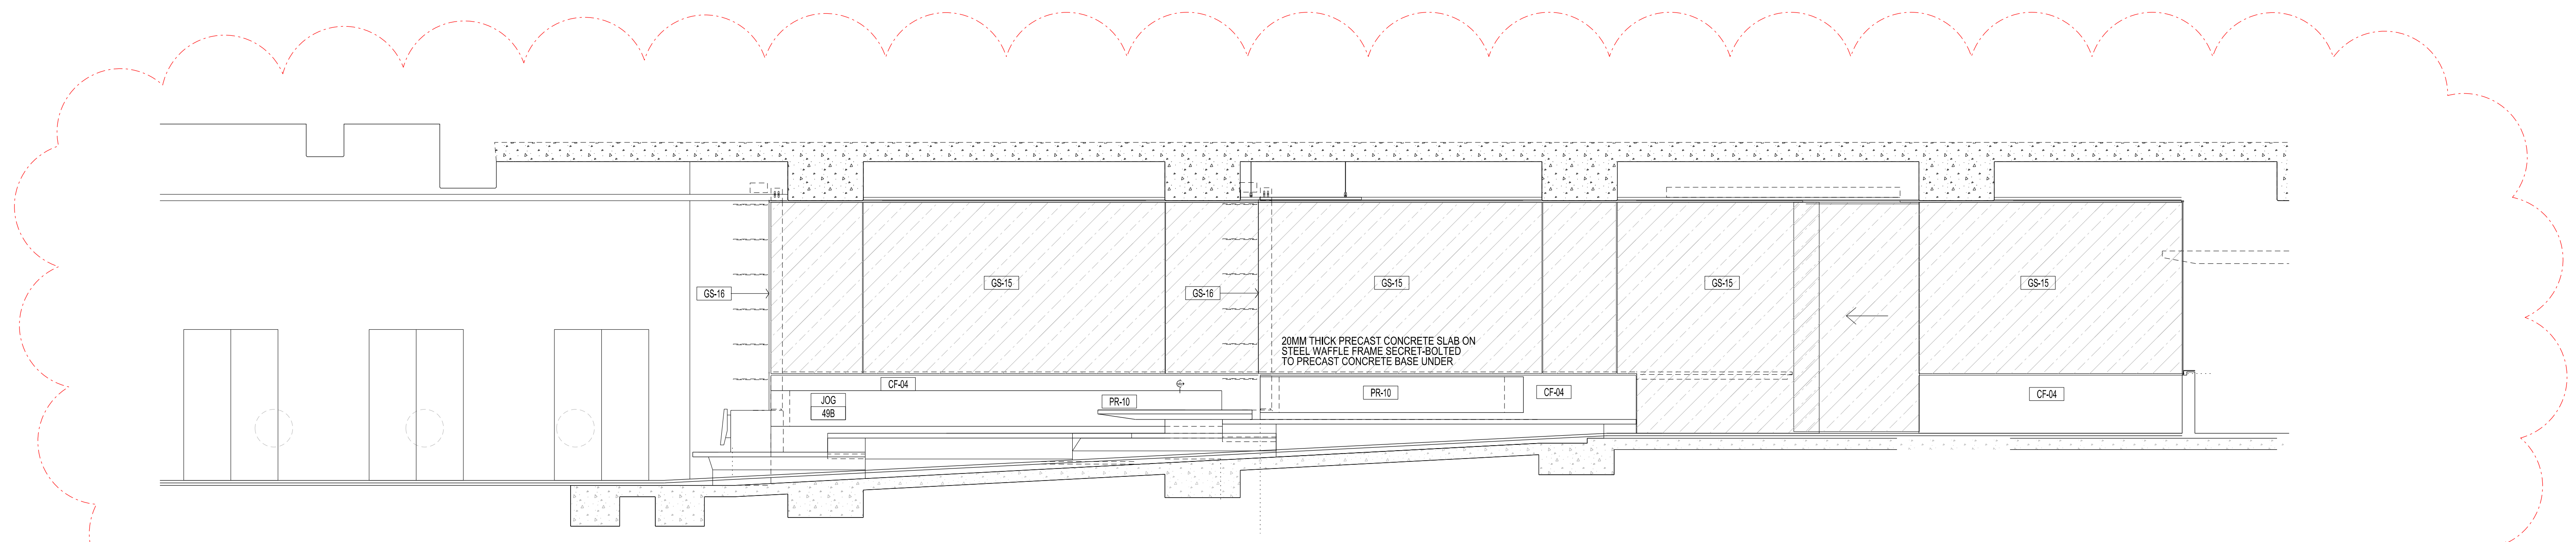


B

INTERNAL ELEVATION - GROUND FOYER

01 SCALE 1:1000

B

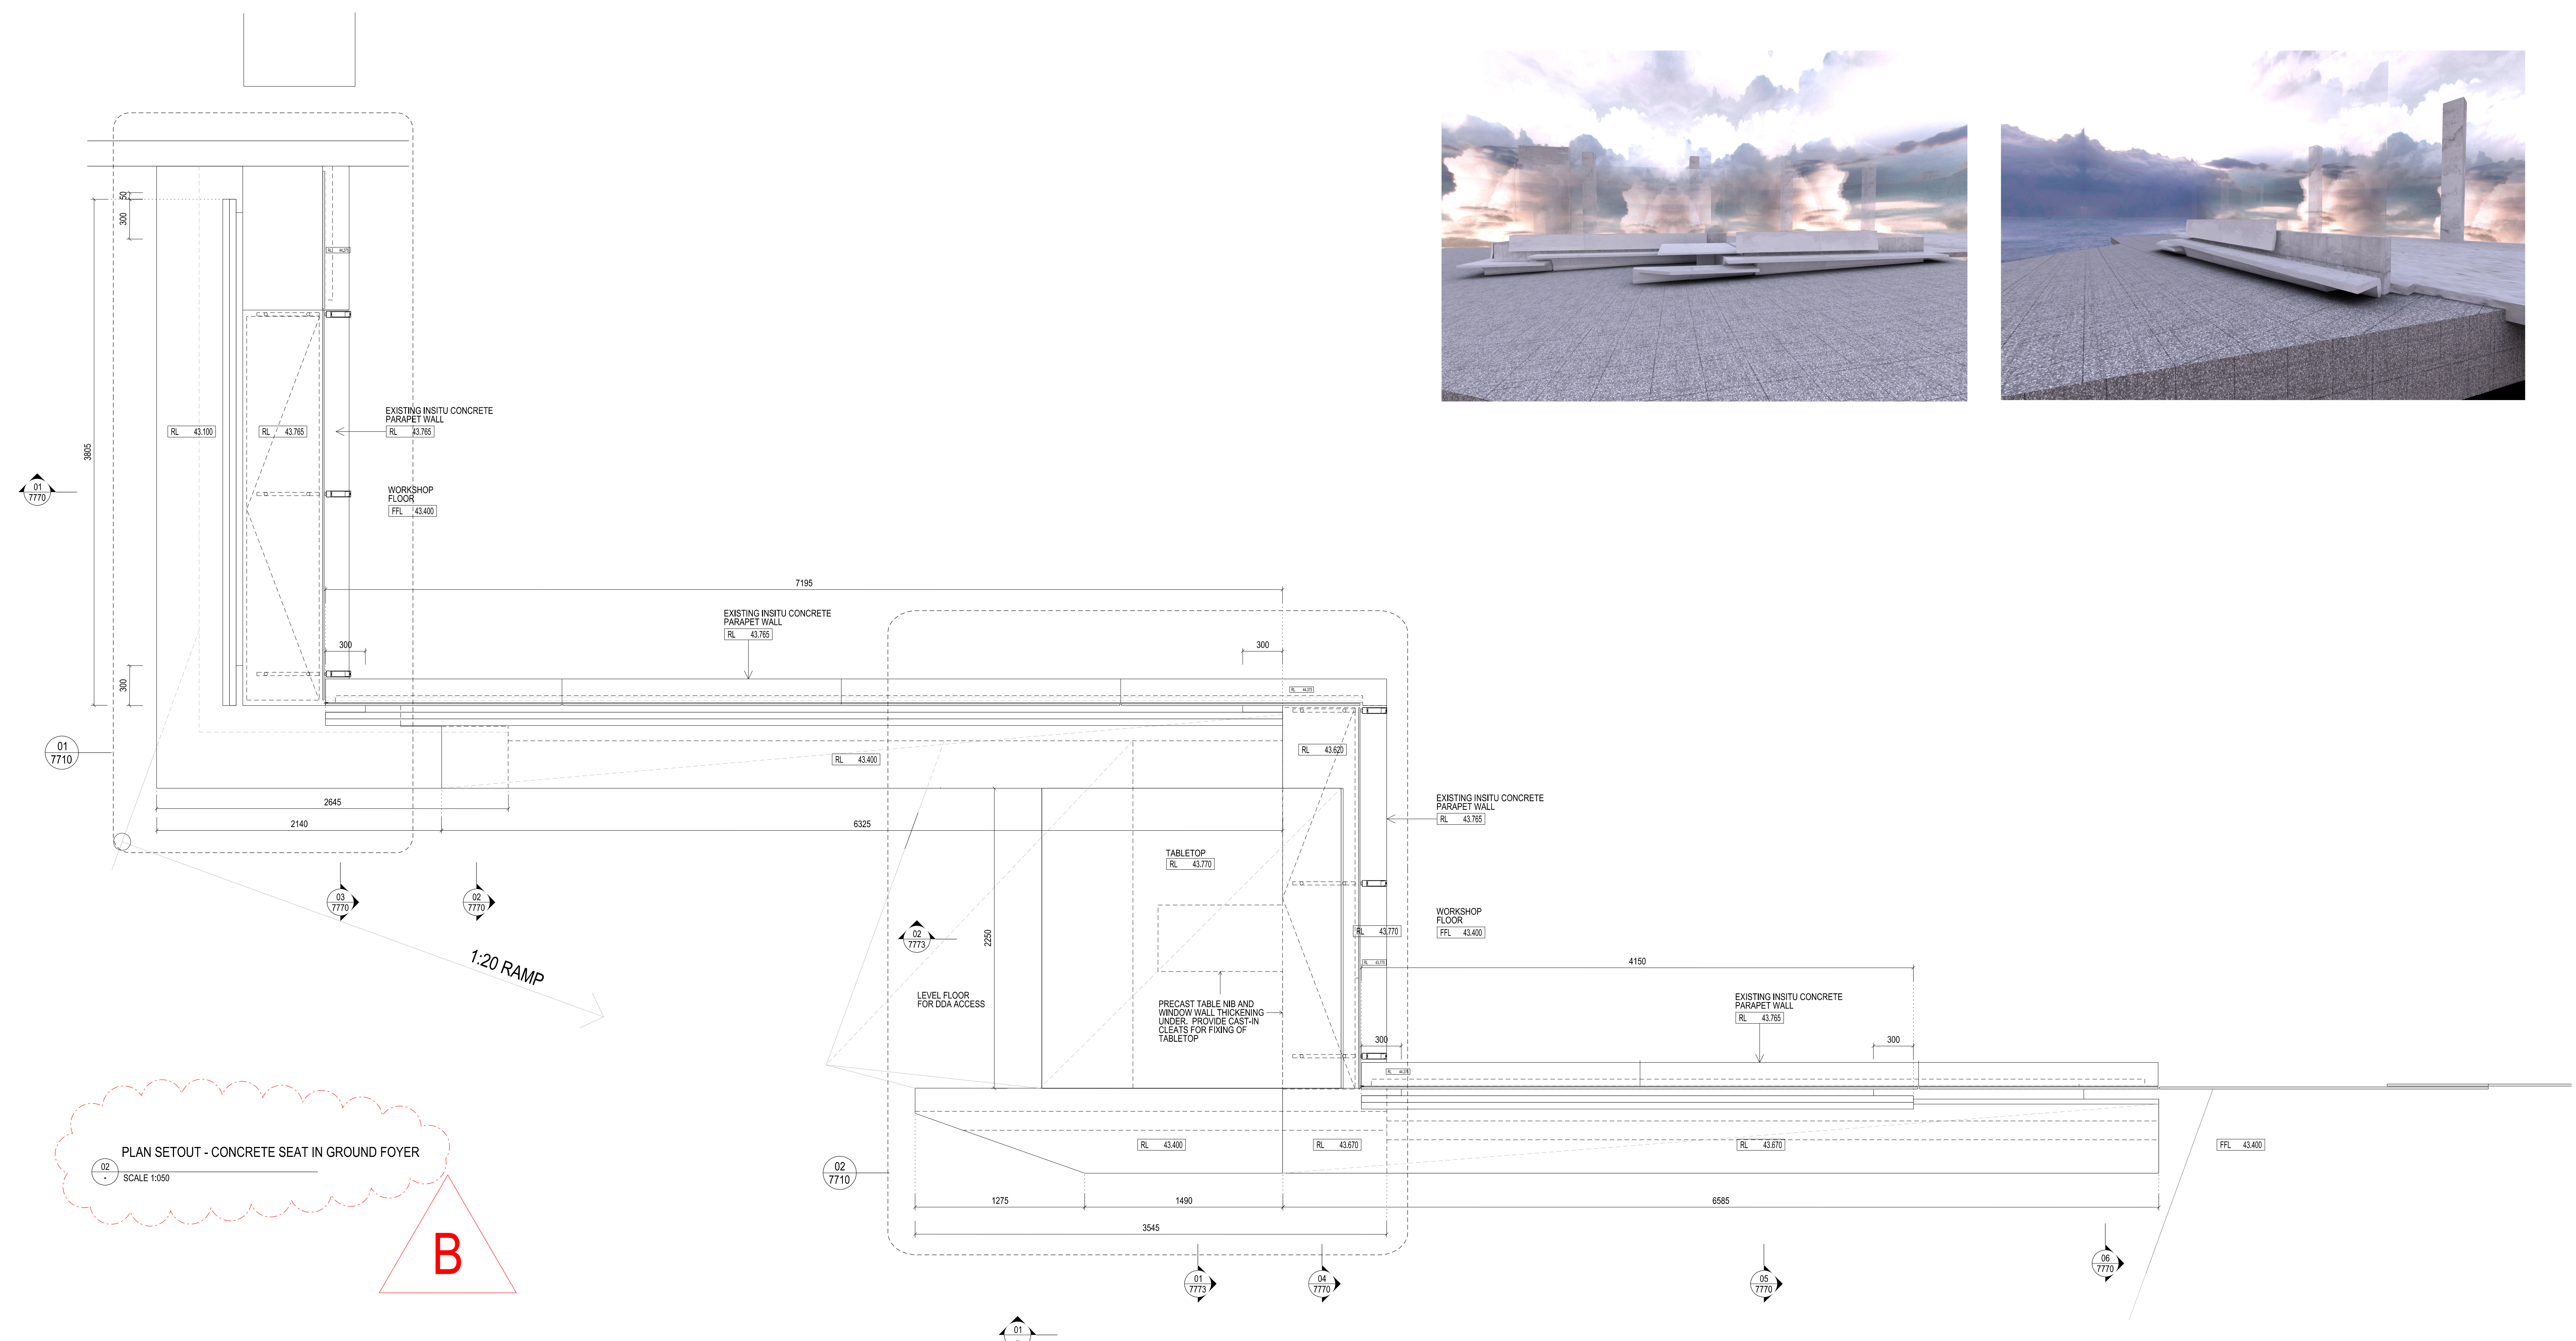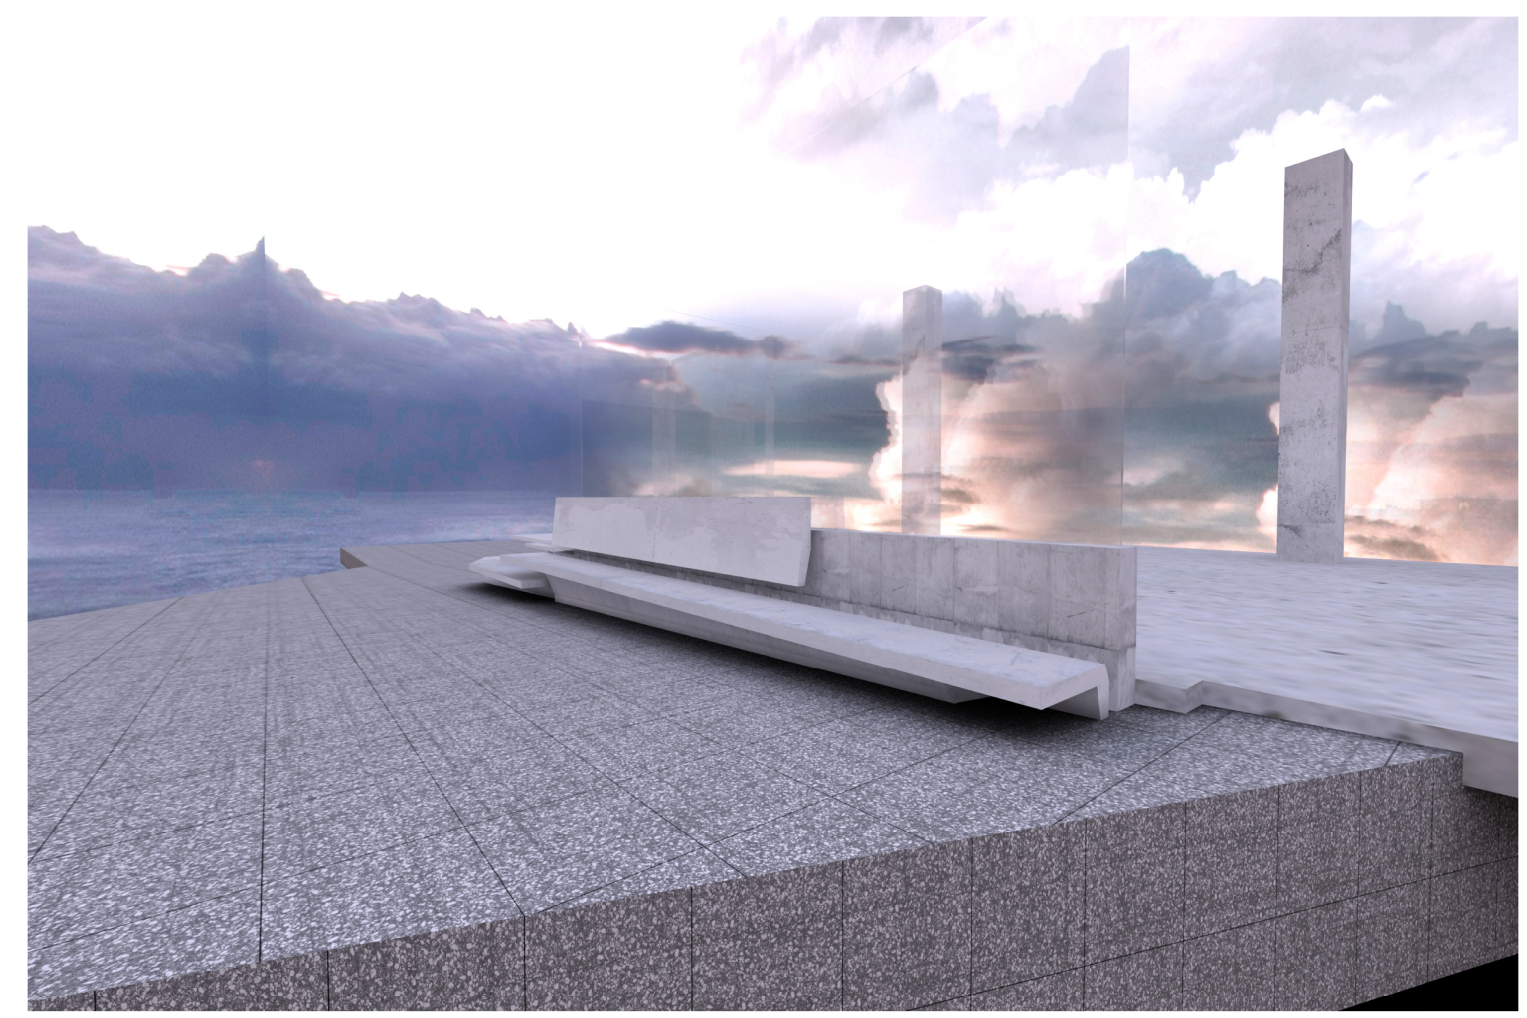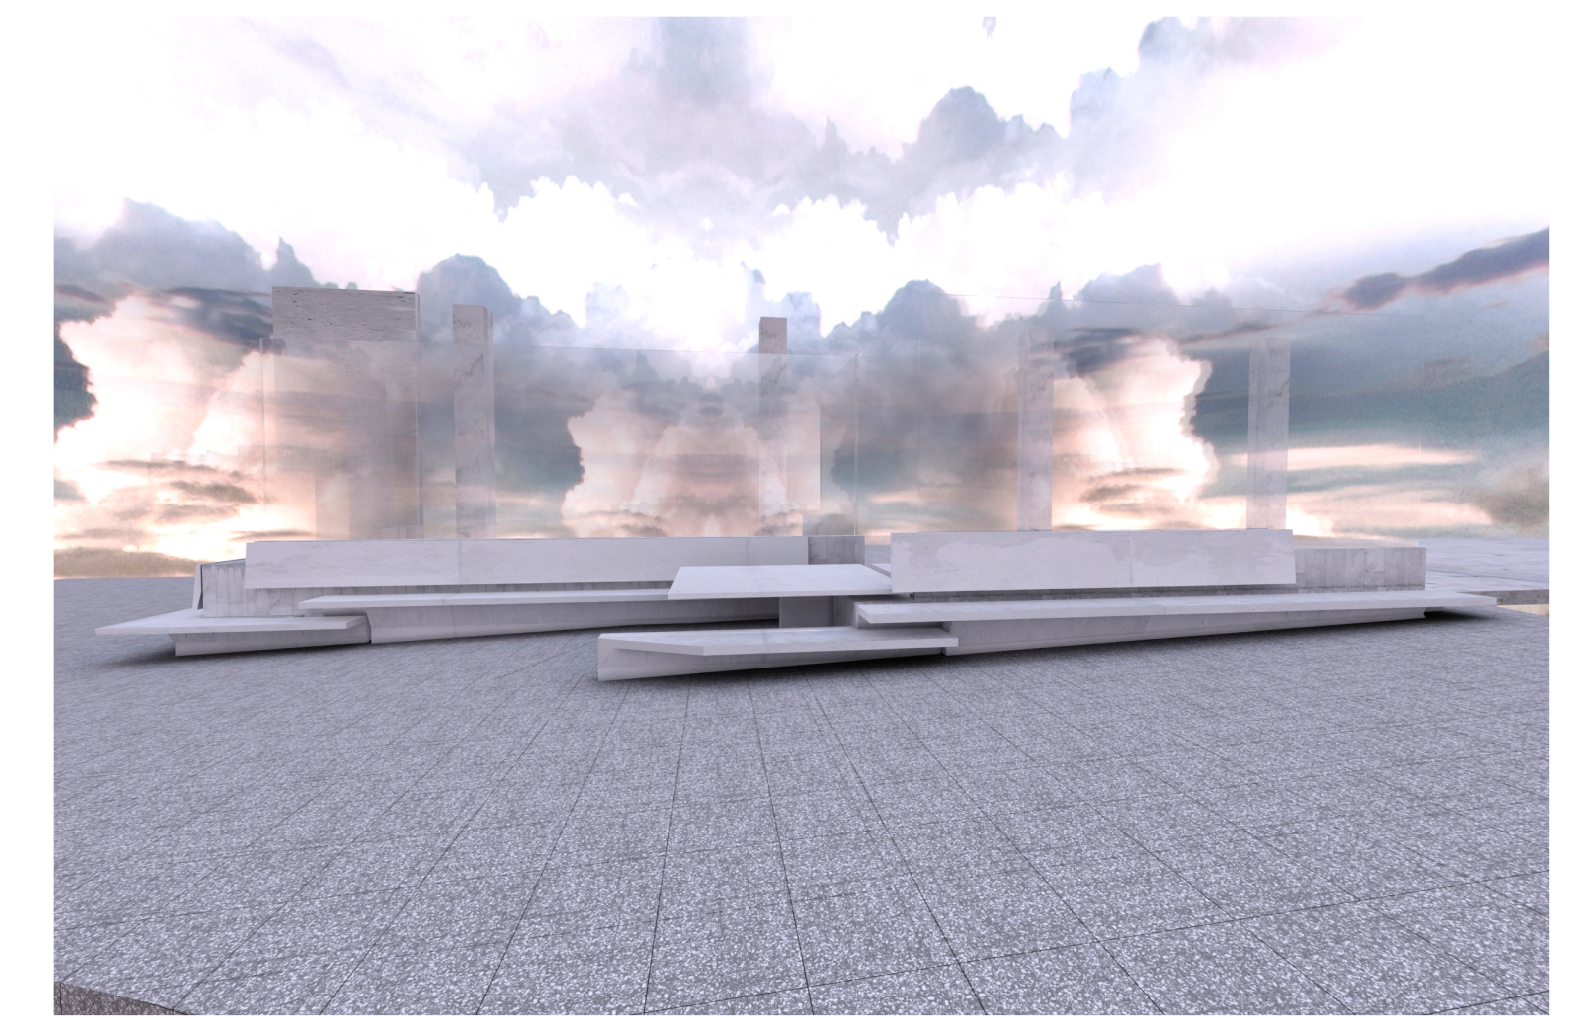

PLAN SETOUT - CONCRETE SEAT IN GROUND FOYER

02 SCALE 1:500

B

Rev	Issue	Revision Description	And	Date
B	SG	UPDATES AS CLOUDED		20.12.13
A	SG	FOR CONSTRUCTION		06.12.13
03	SG	TENDER ADDENDUM 4		08.10.12
02	SG	100% CO - TENDER ISSUE		07.09.12
A	SG	AMENDED PRECAST BENCH SEAT		27.11.13



**NADAAA**  
 NADAAA  
 1520 Washington Street No.2 Boston Massachusetts 02118 USA  
 Telephone +1 617 442 8232 Facsimile +1 688 442 1417 Email nad@nadaaa.com

**John Wardle Architects**  
 25 Rokeby Street, Collingwood, Victoria 3066 Australia  
 Tel: +61 3 8662 0400 www.johnwardlearchitects.com  
 © 2012 John Wardle Architects ABN 83 006 814 268

Client **University of Melbourne Parkville Campus**

Project **Faculty of Architecture Building and Planning**

Title **INTERIOR WALL DETAILS Ground Floor - Plan & Elevation**

Project No.	<b>0913</b>	Scale	1:20 @ A0
Drawing No.	<b>AR7774</b>	Revision	<b>B</b>

Date: May 2011 Drawn: Co-Ord: Check:

FILENAME - \$FILES

**FOR CONSTRUCTION**