

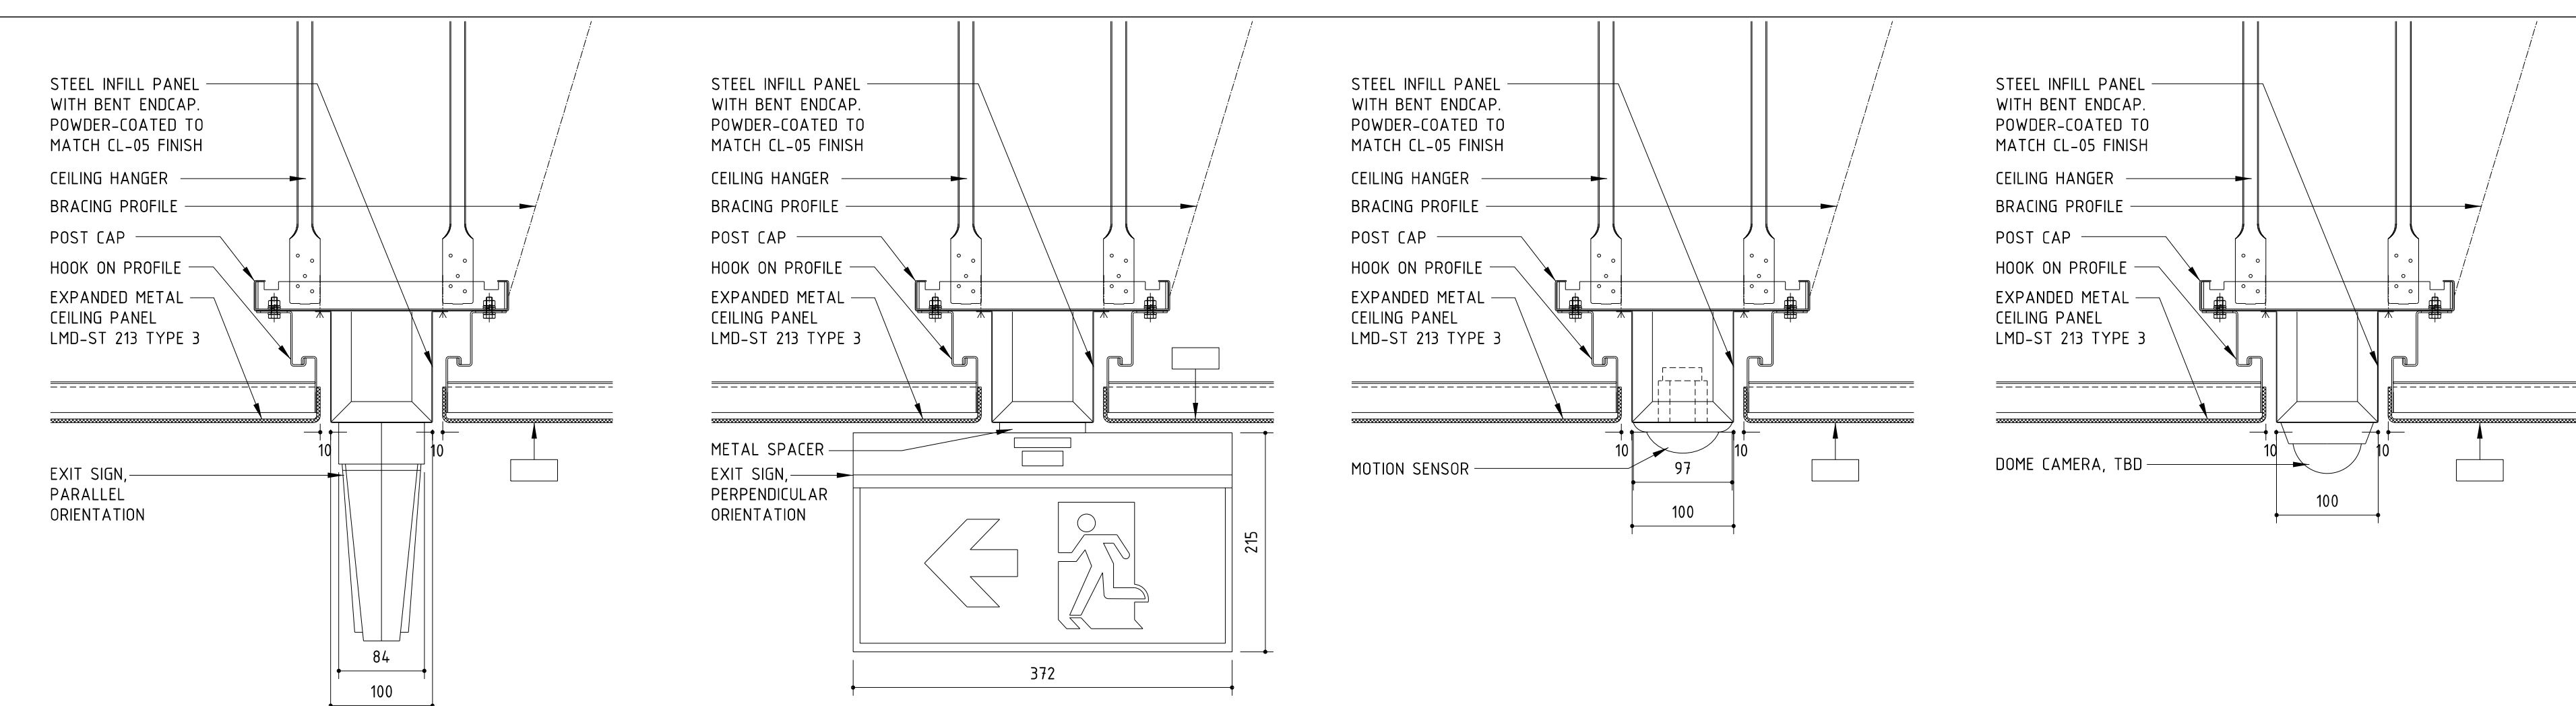
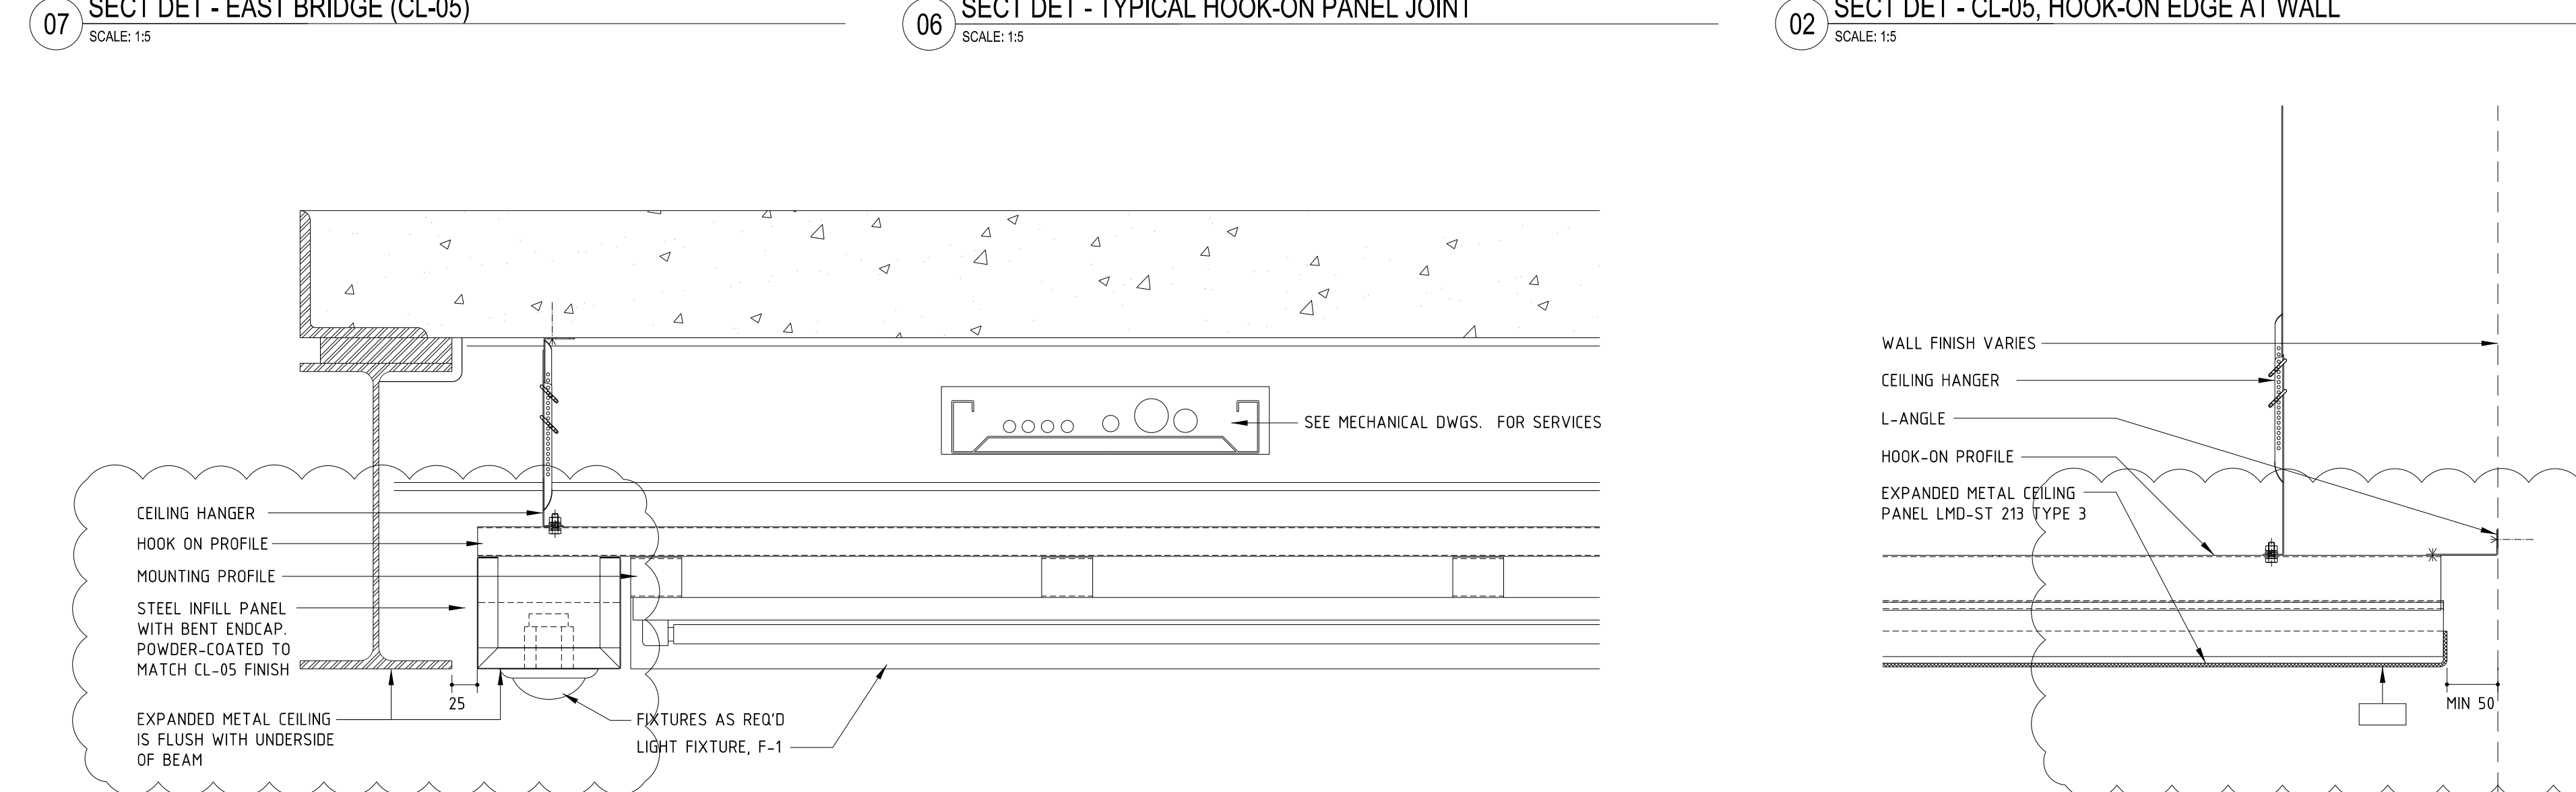
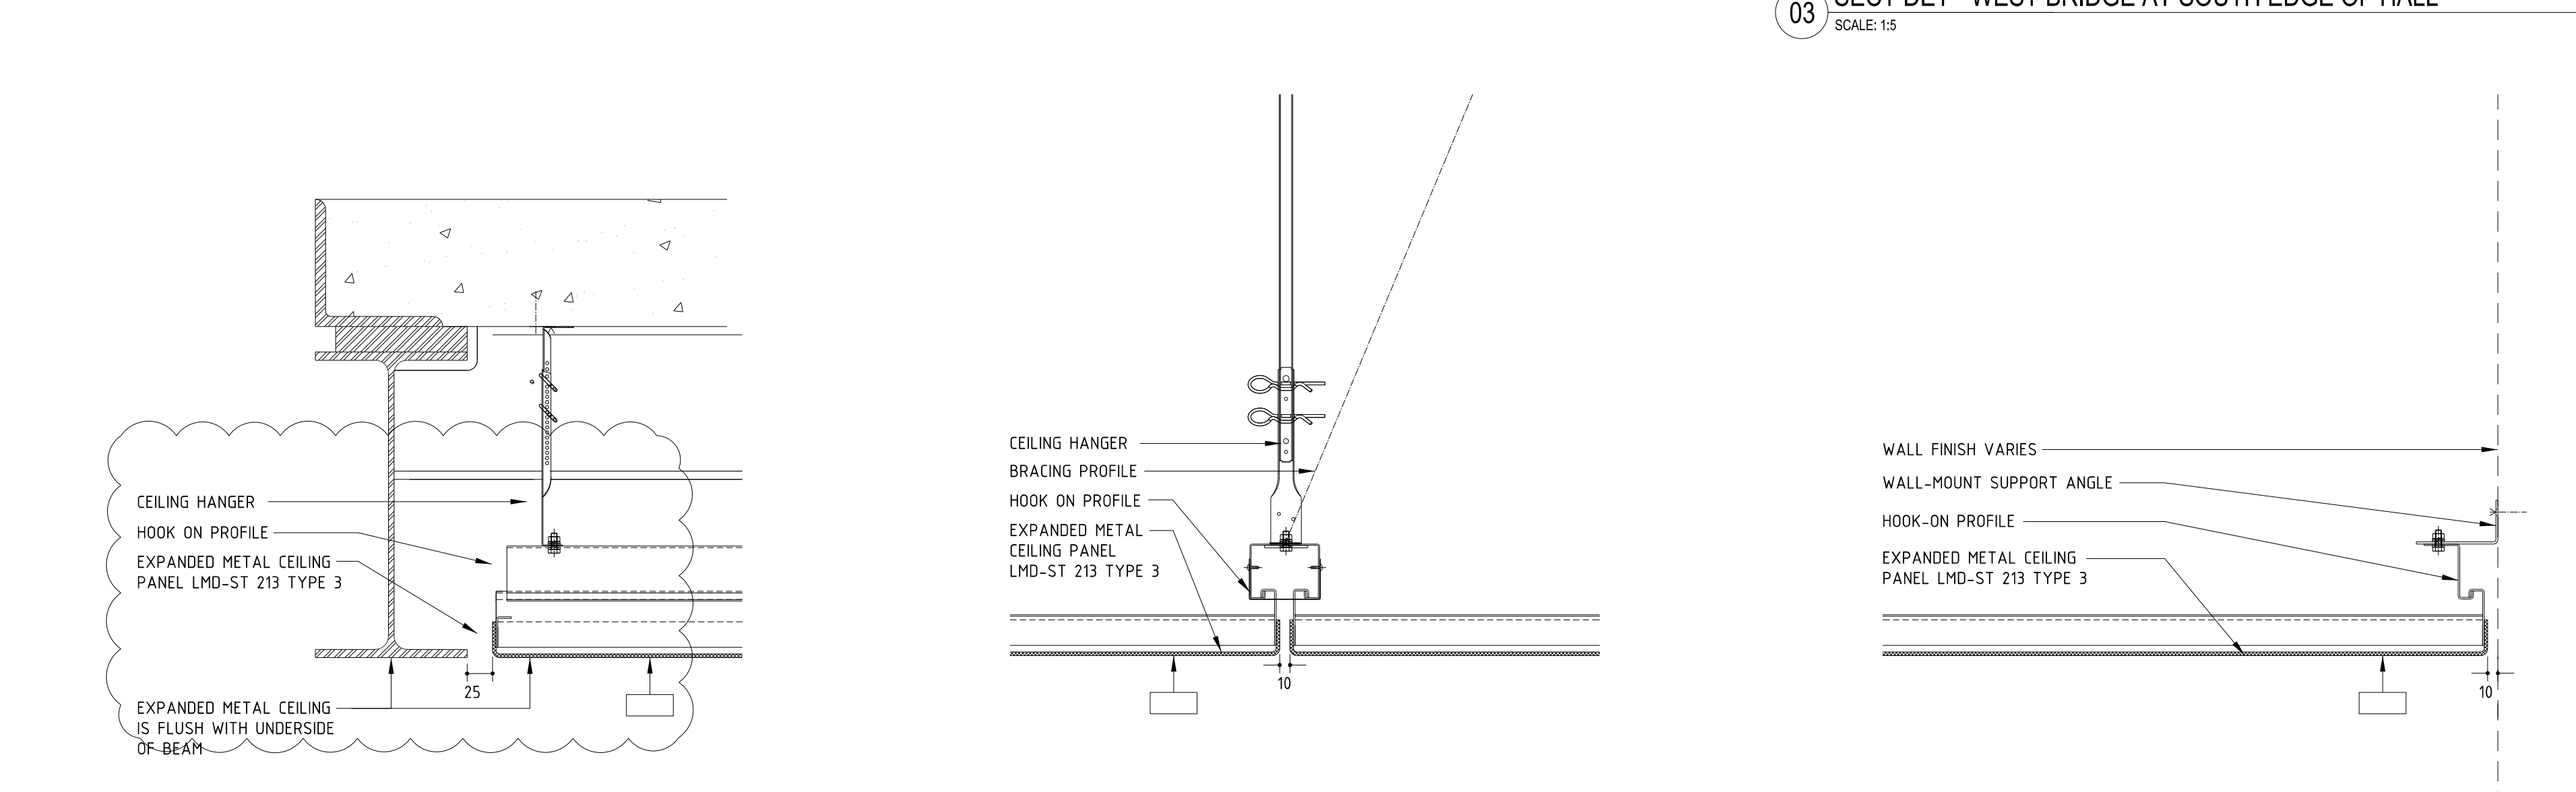
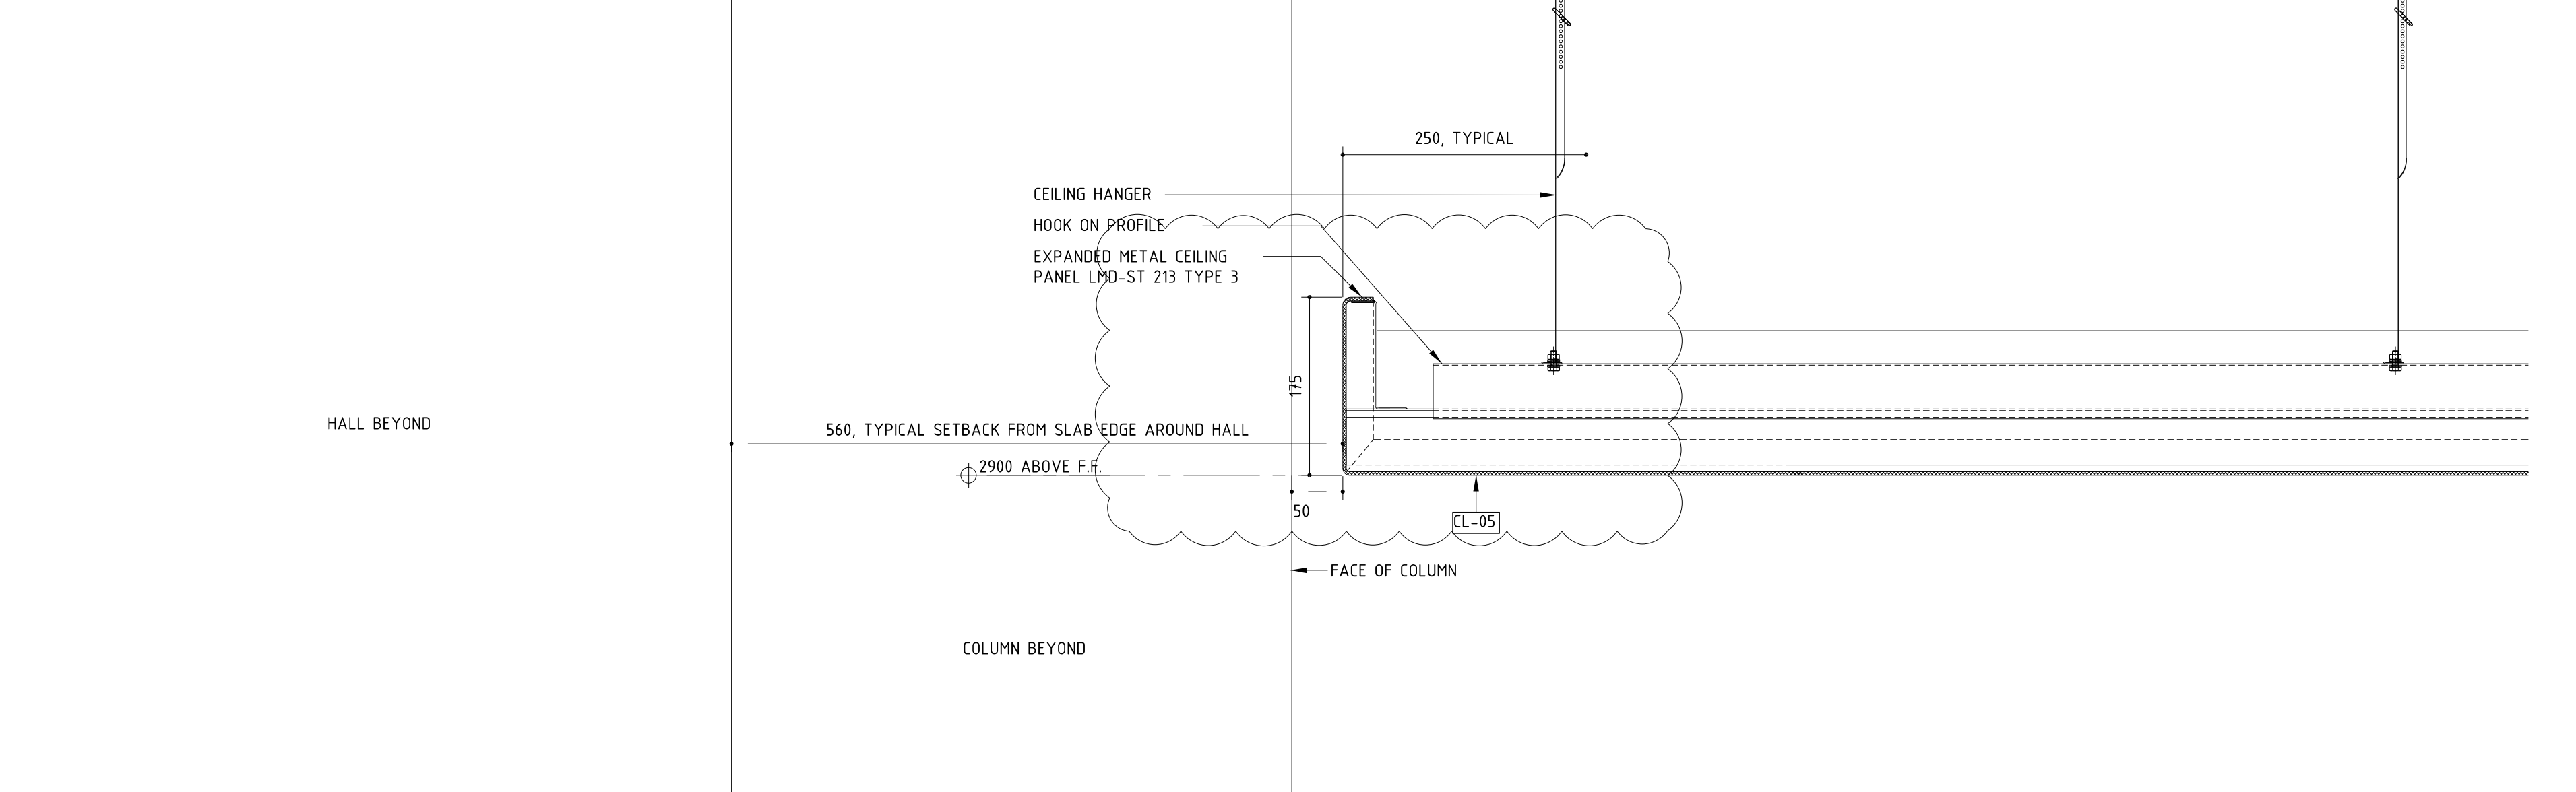
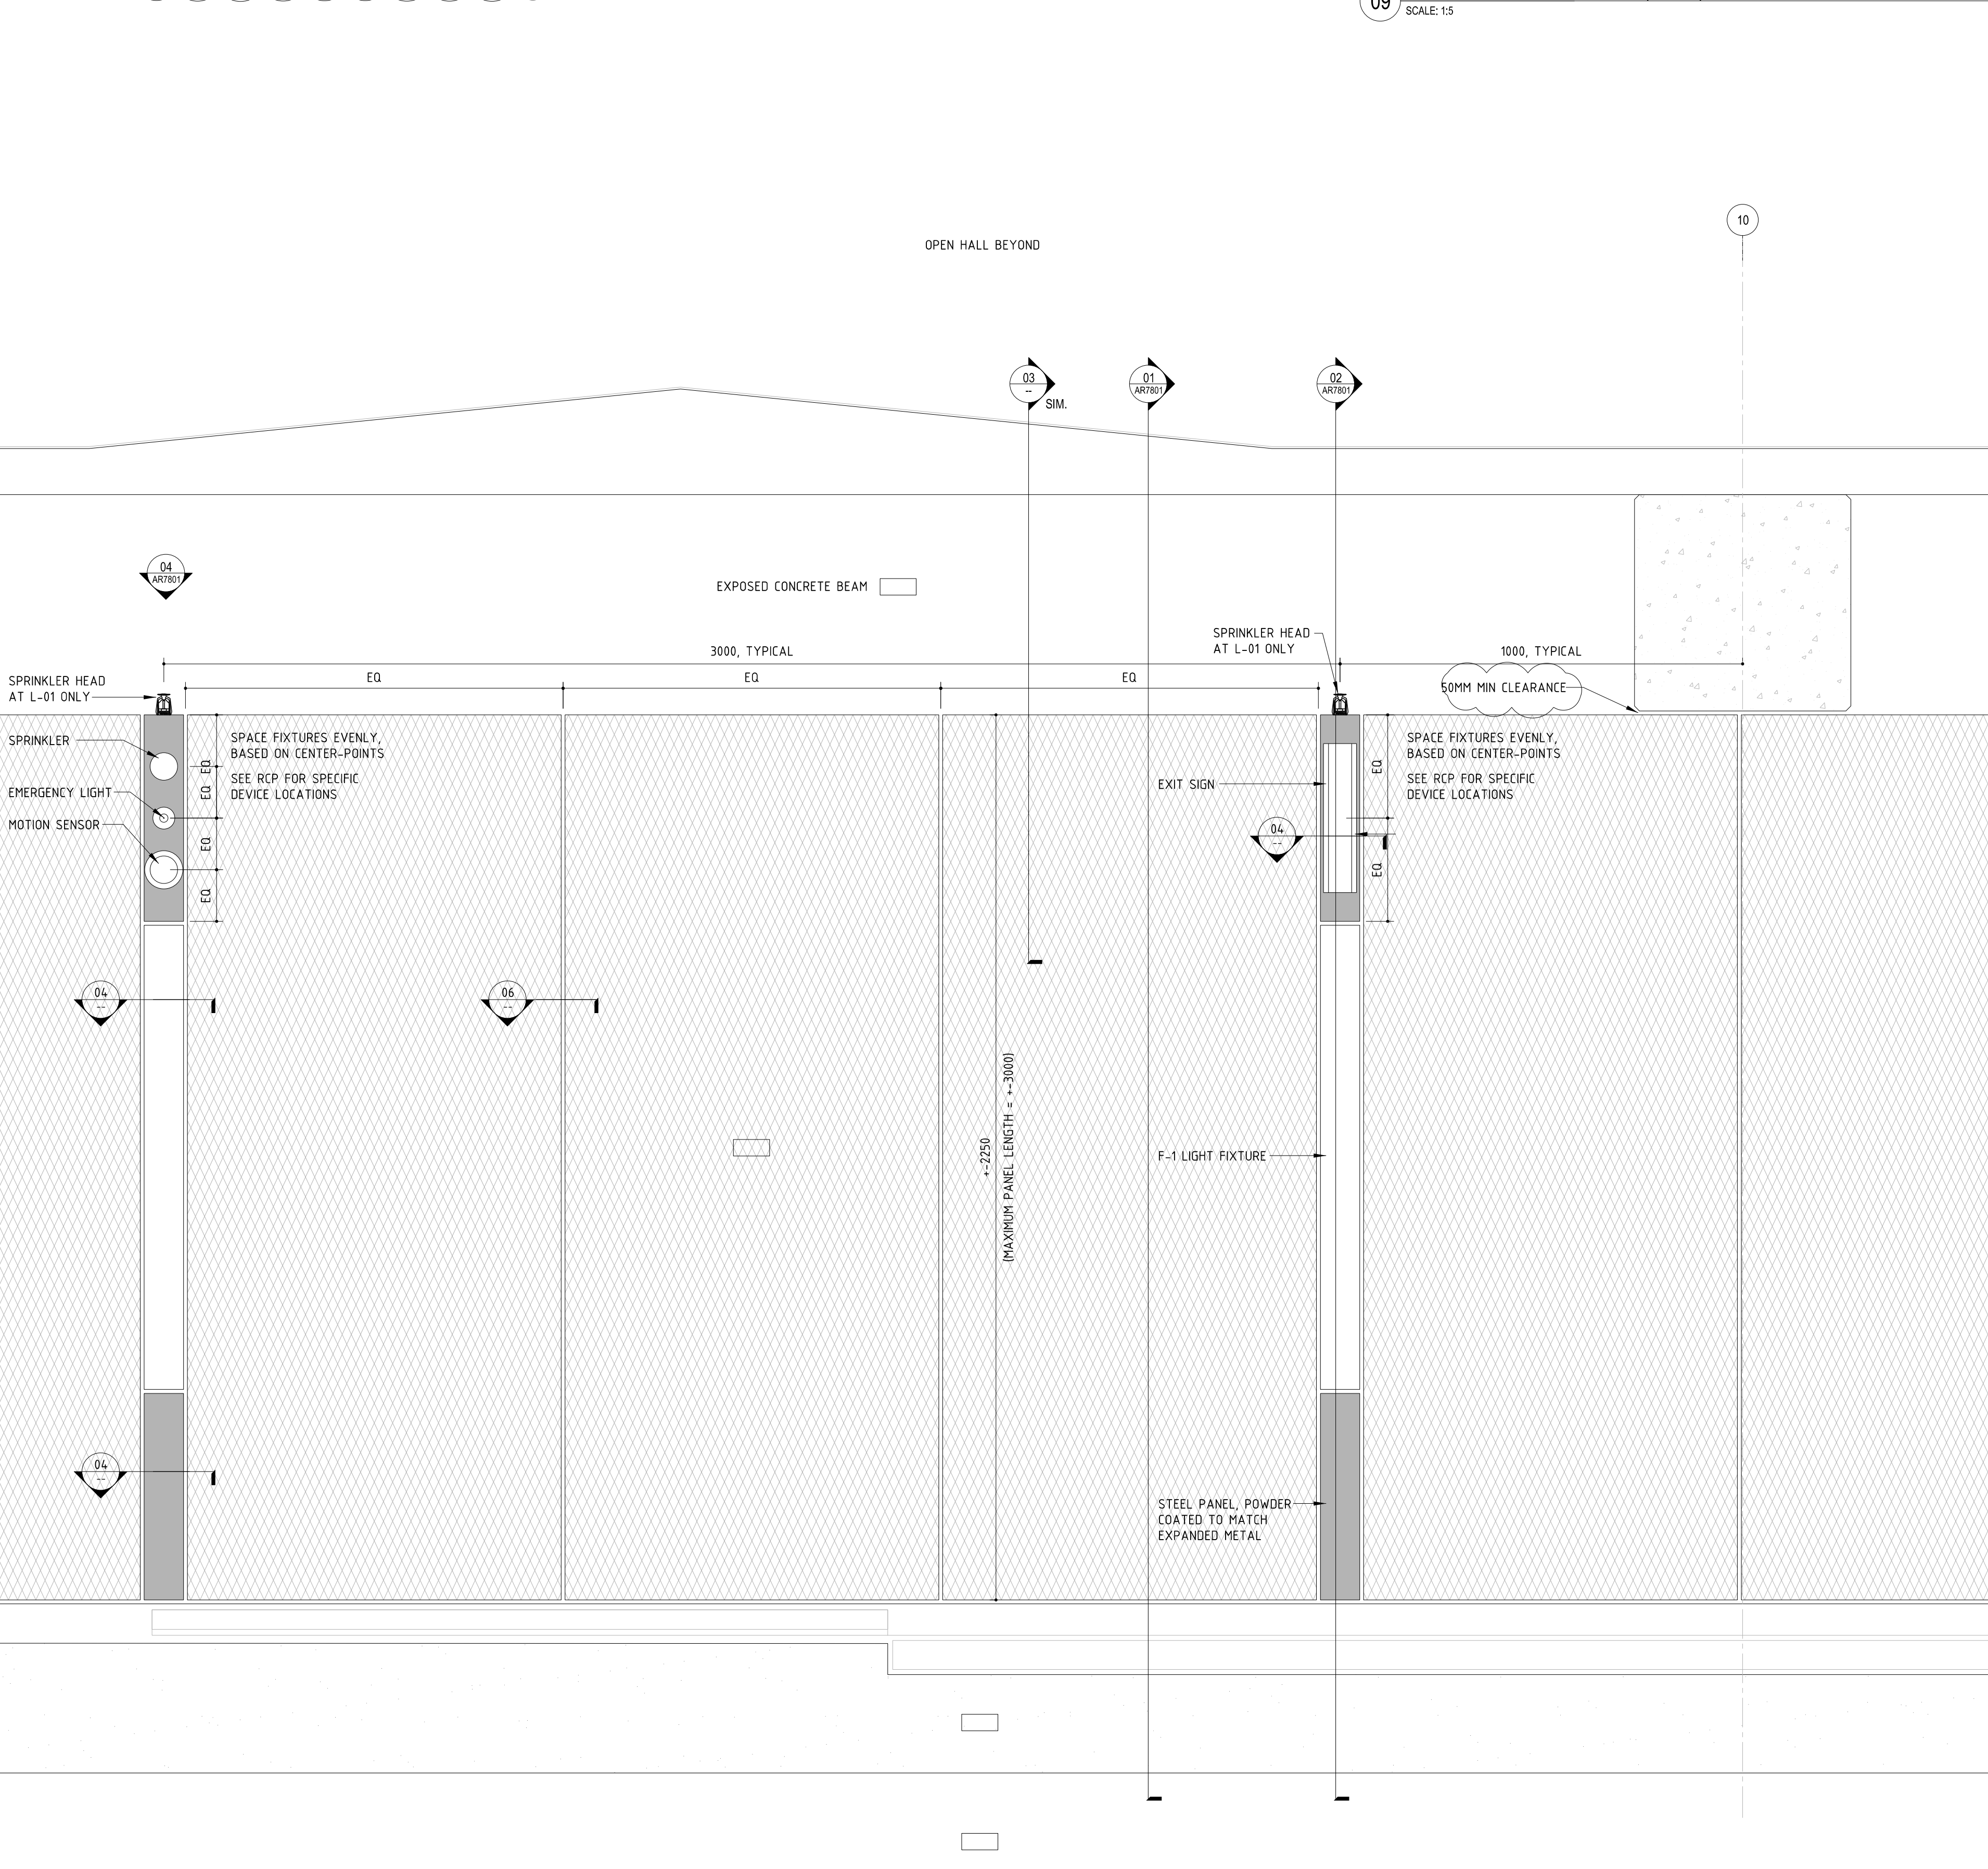


04 DETAIL CEILING DEVICE - WIFI ANTENNA SCALE: 1:5
 04 DETAIL CEILING DEVICE - LIGHT FITTING SCALE: 1:5
 04 DETAIL CEILING DEVICE - INFILL PANEL (TYP) SCALE: 1:5
 04 DETAIL CEILING DEVICE - EMERGENCY LIGHT SCALE: 1:5

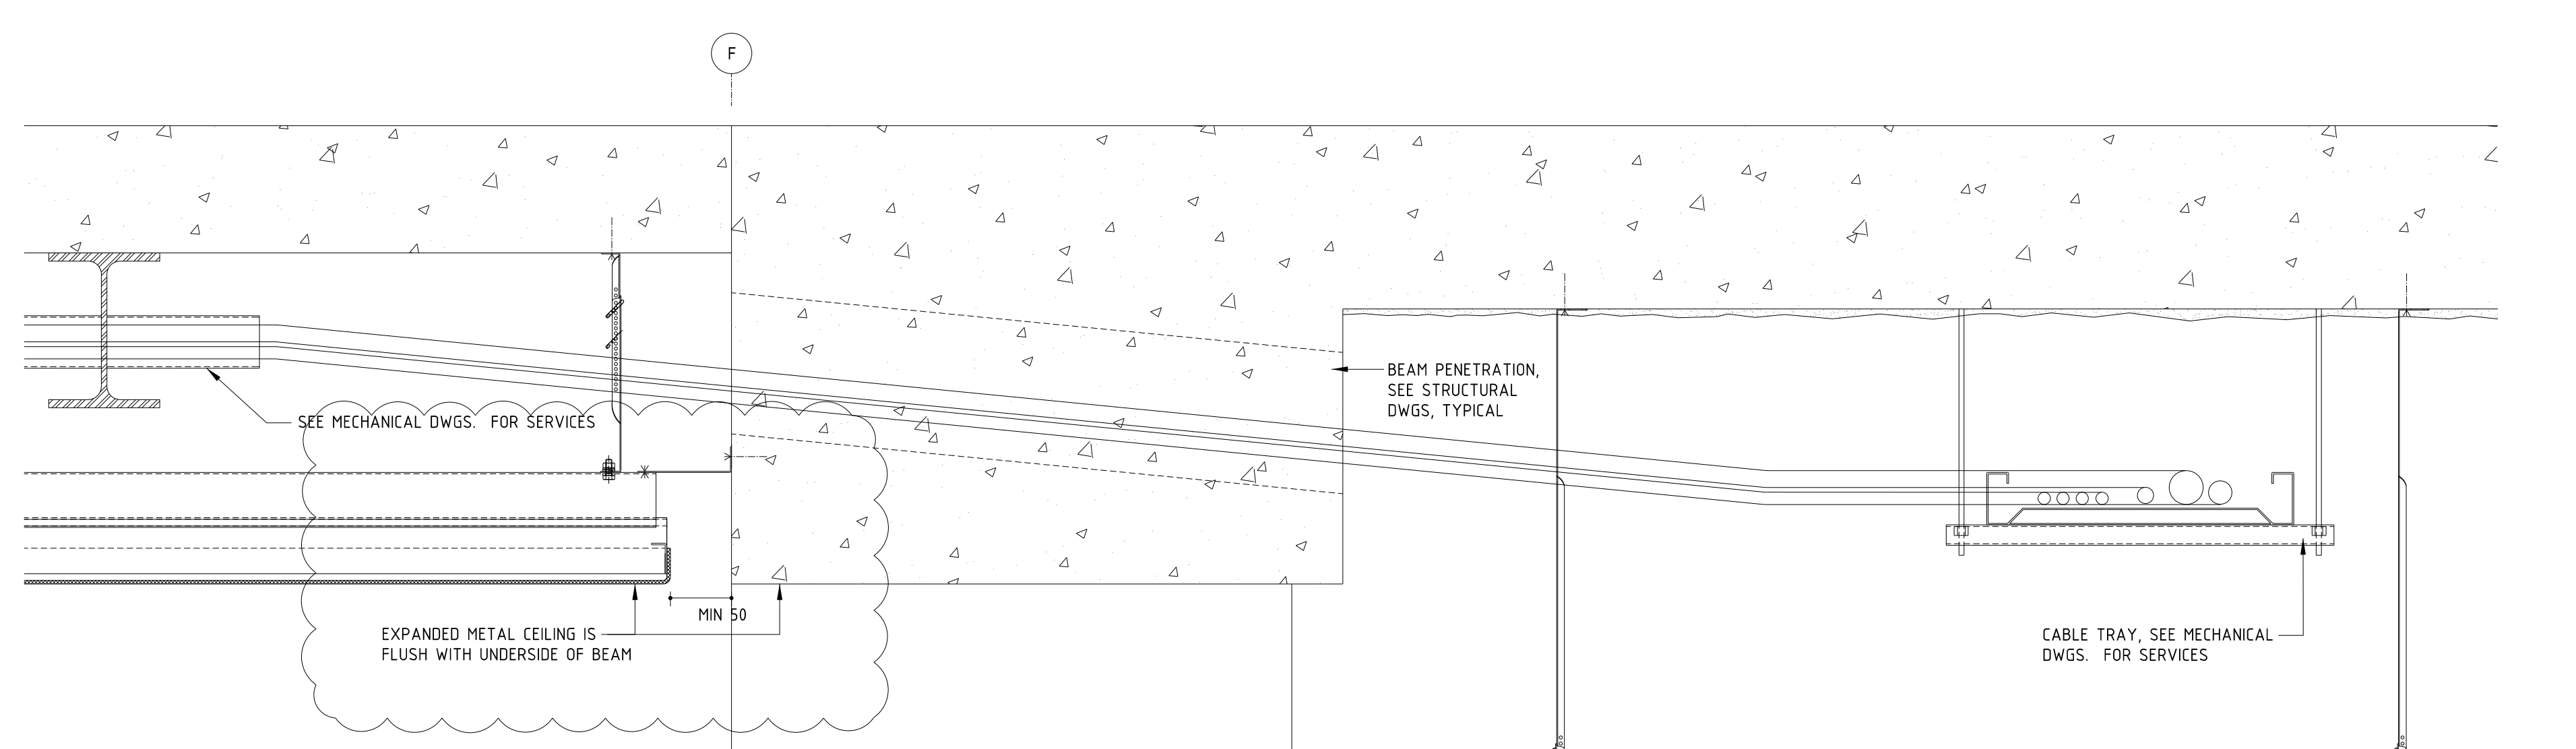

04 DETAIL CEILING DEVICE - EXIT SIGN (SIDE VIEW) SCALE: 1:5
 04 DETAIL CEILING DEVICE - EXIT SIGN SCALE: 1:5
 04 DETAIL CEILING DEVICE - MOTION SENSOR SCALE: 1:5
 04 DETAIL CEILING DEVICE - CAMERA SCALE: 1:5

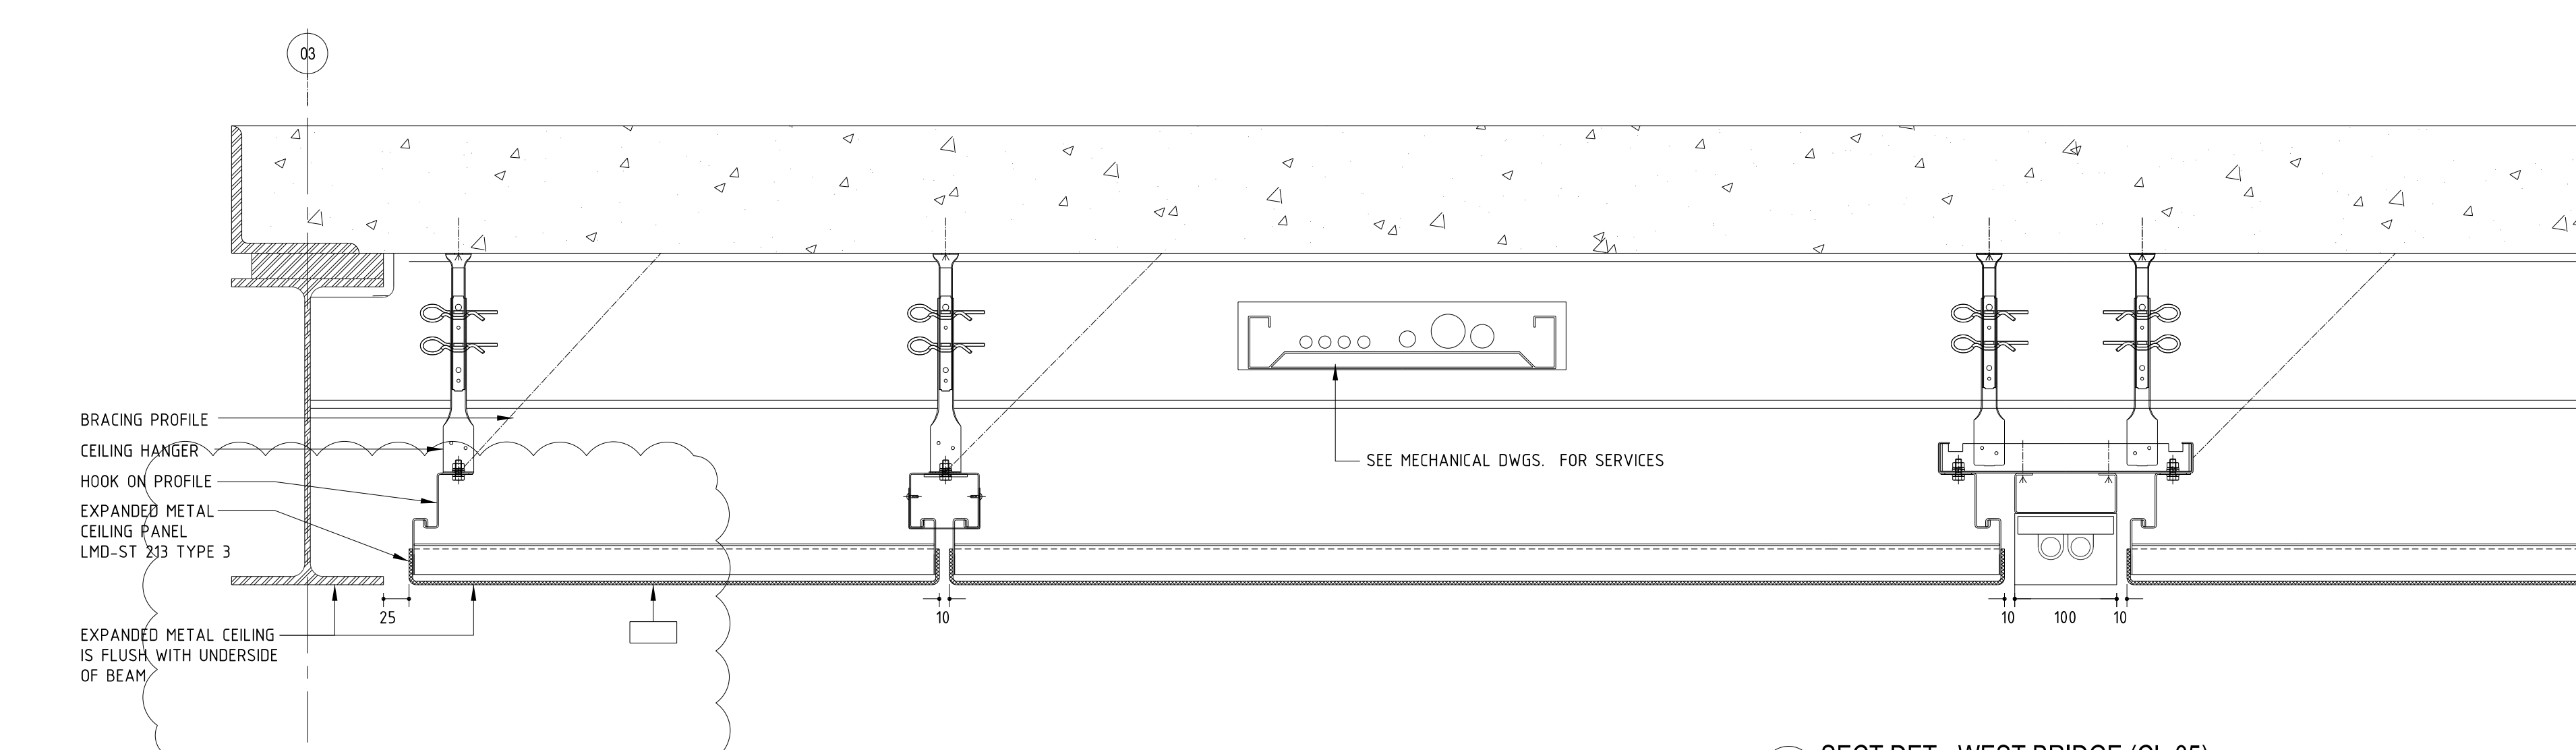


08 ENLARGED, TYPICAL EXPANDED METAL (CL-05) RCP SCALE: 1:10
 07 SECT DET - EAST BRIDGE (CL-05) SCALE: 1:5
 06 SECT DET - TYPICAL HOOK-ON PANEL JOINT SCALE: 1:5
 05 SECT DET - EAST BRIDGE THRU FIXTURES SCALE: 1:5
 02 SECT DET - CL-05, HOOK-ON EDGE AT WALL SCALE: 1:5
 01 SECT DET - CL-05, NON-HOOK-ON EDGE AT WALL SCALE: 1:5

THIS DRAWING IS AN UNCONTROLLED COPY UNLESS STAMPED OTHERWISE
 CONTRACTORS SHALL VERIFY DIMENSIONS BEFORE ANY JOB COMMENCES. ALL SHOP DRAWINGS SHALL BE SUBMITTED TO THE SUPERINTENDENT AND MANUFACTURE SHALL NOT COMMENCE PRIOR TO THE RETURN OF DIMANDED SHOP DRAWINGS REVIEWED BY THE CONSULTANT. FURTHER DIMENSIONS SHALL TAKE PRECEDENCE OVER SCALED. THIS DRAWING SHOULD BE READ IN CONJUNCTION WITH ALL RELEVANT CONTRACT SPECIFICATIONS AND DRAWINGS COPYRIGHT OF THIS DRAWING IS VESTED IN WARDLE.

General Notes
 SEE SERVICE ENGINEERING DRAWINGS FOR ALL FIXTURE SPECIFICATIONS

Rev	Issue	Revision Description	Amd	Date
C	SG	CONSTRUCTION ISSUE	-	24.01.14
B	SG	CONSTRUCTION ISSUE	-	19.12.13
A	SG	FOR CONSTRUCTION	-	12.10.13
03	JC	100% CD - TENDER ISSUE	-	07.09.12
02	JC	90% CD ISSUE	-	10.08.12
01	JC	75% CD ISSUE	-	13.07.12

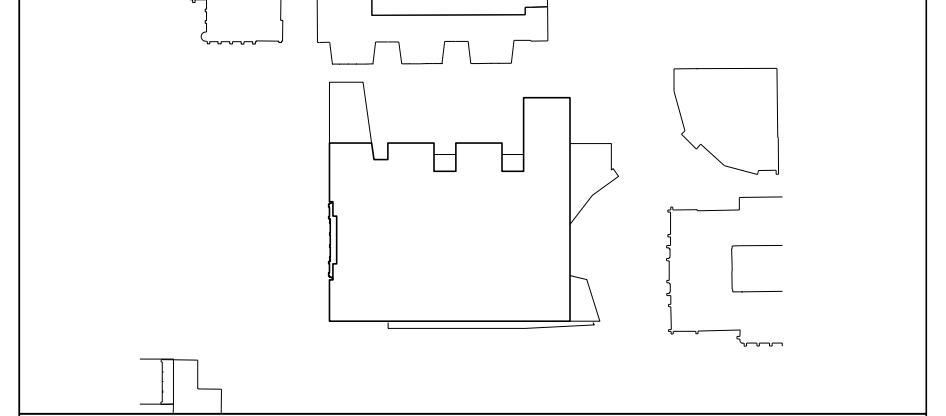

NADAAA
 NADAAA Telephone +1 617 442 6232
 1600 Washington Street No.2 Facsimile +1 688 442 1417
 Boston Massachusetts 02118 USA Email nad@nadaaa.com

John Wardle Architects
 © 2011 John Wardle Architects
 Level 10, 180 Russell Street, Melbourne Victoria 3000 Australia
 Tel : +613 9654 8700 www.johnwardlearchitects.com

Client **University of Melbourne Parkville Campus**
 Project **Faculty of Architecture Building and Planning**
 Title **TYPICAL CEILING FINISH DETAILS**

Project No.	0913	Scale	1:5
Drawing No.	AR7800	Revision	C
Date	JAN 2014	Dwn	-
Co-Ord	-	Chk	-

FOR CONSTRUCTION