



THIS DRAWING IS AN UNCONTROLLED COPY UNLESS STAMPED OTHERWISE

CONTRACTORS SHALL VERIFY JOB DIMENSIONS BEFORE ANY JOB COMMENCES. ALL SHOP DRAWINGS SHALL BE SUBMITTED TO THE SUPERINTENDENT AND MANUFACTURE SHALL NOT COMMENCE PRIOR TO THE RETURN OF DIMENSIONS SHOP DRAWINGS BEING BY THE CONSULTANT. FIGURED DIMENSIONS SHALL TAKE PRECEDENCE OVER SCALED. THIS DRAWING SHOULD BE READ IN CONJUNCTION WITH ALL RELEVANT CONTRACT SPECIFICATIONS AND DRAWINGS COPYRIGHT OF THIS DRAWING IS VESTED IN NADAAA


General Notes  
SEE SERVICE ENGINEERING DRAWINGS FOR ALL FIXTURE SPECIFICATIONS

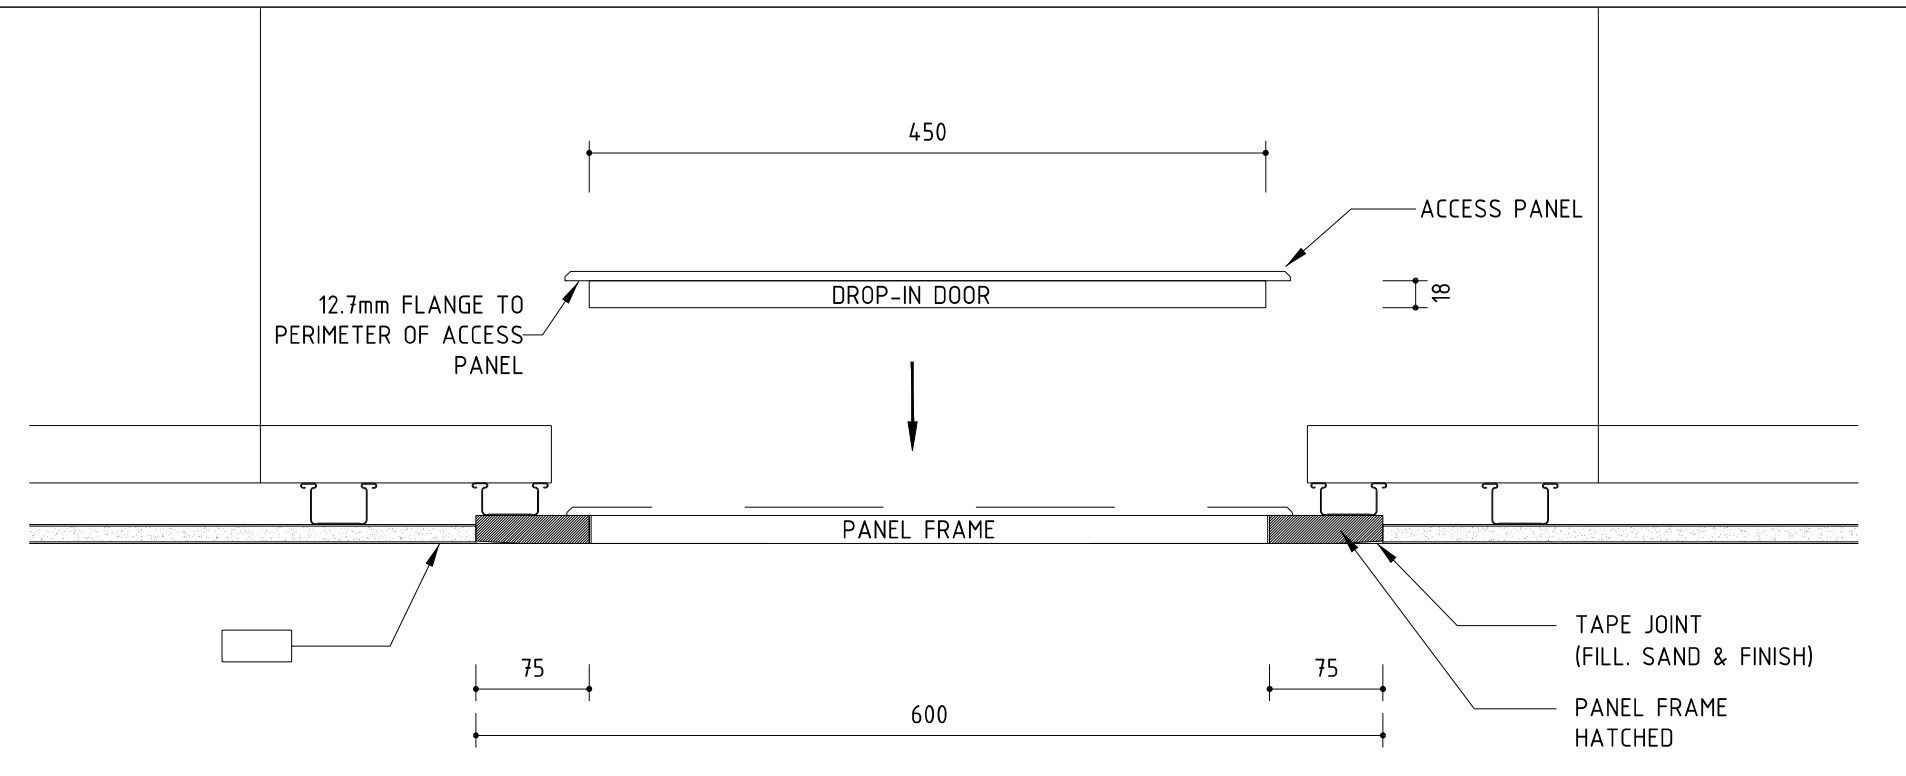


09 GFRG ACCESS PANEL - HANGING STUDIO L02 & L03 - SECTION DETAIL  
SCALE: 1:5

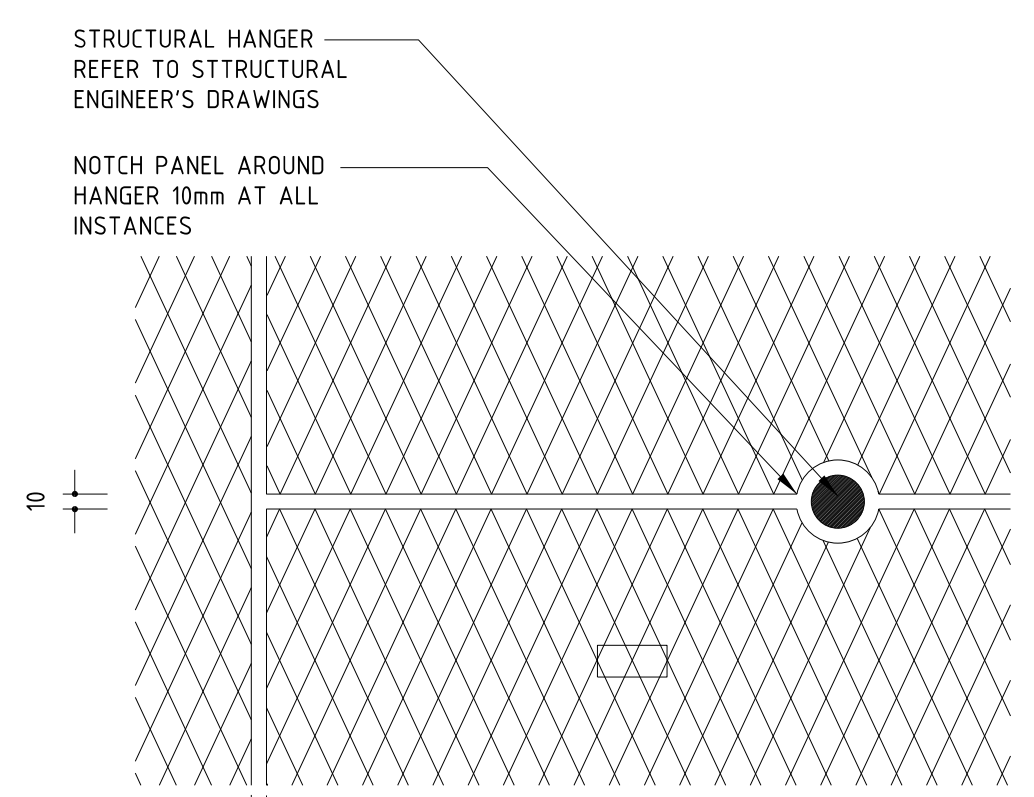


07 REFLECTED CEILING DETAIL @ STRUCTURAL HANGER  
SCALE: 1:5

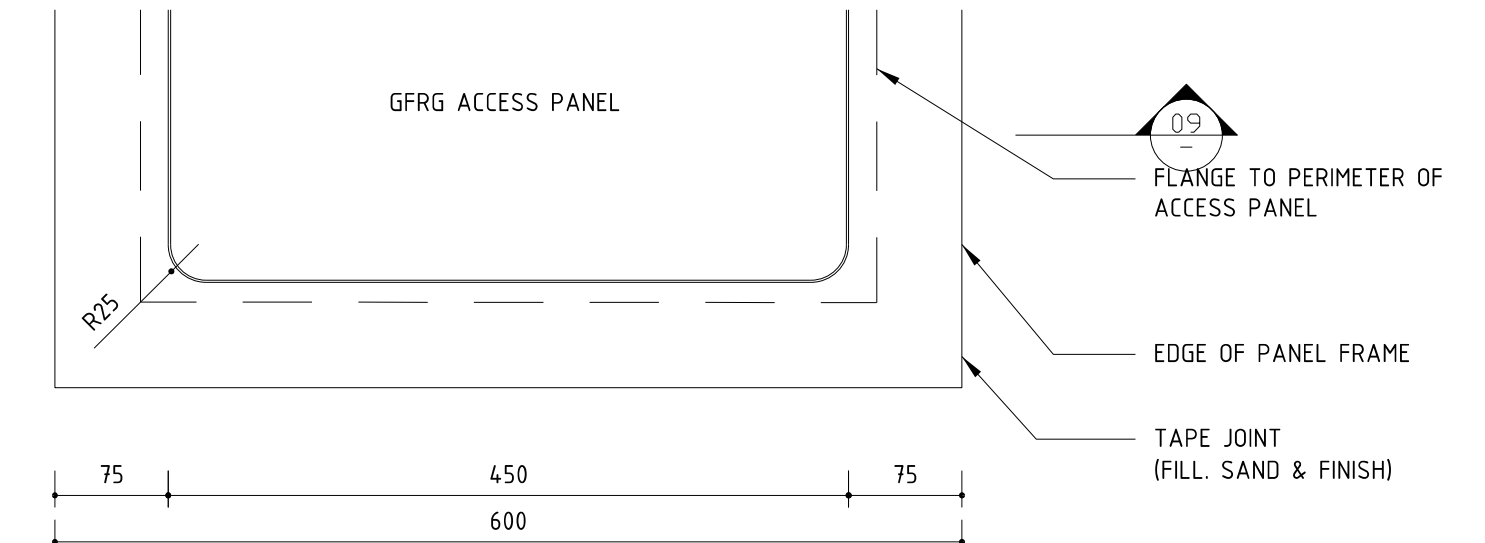


08 GFRG ACCESS PANEL - HANGING STUDIO L02 & L03 - RCP DETAIL  
SCALE: 1:5

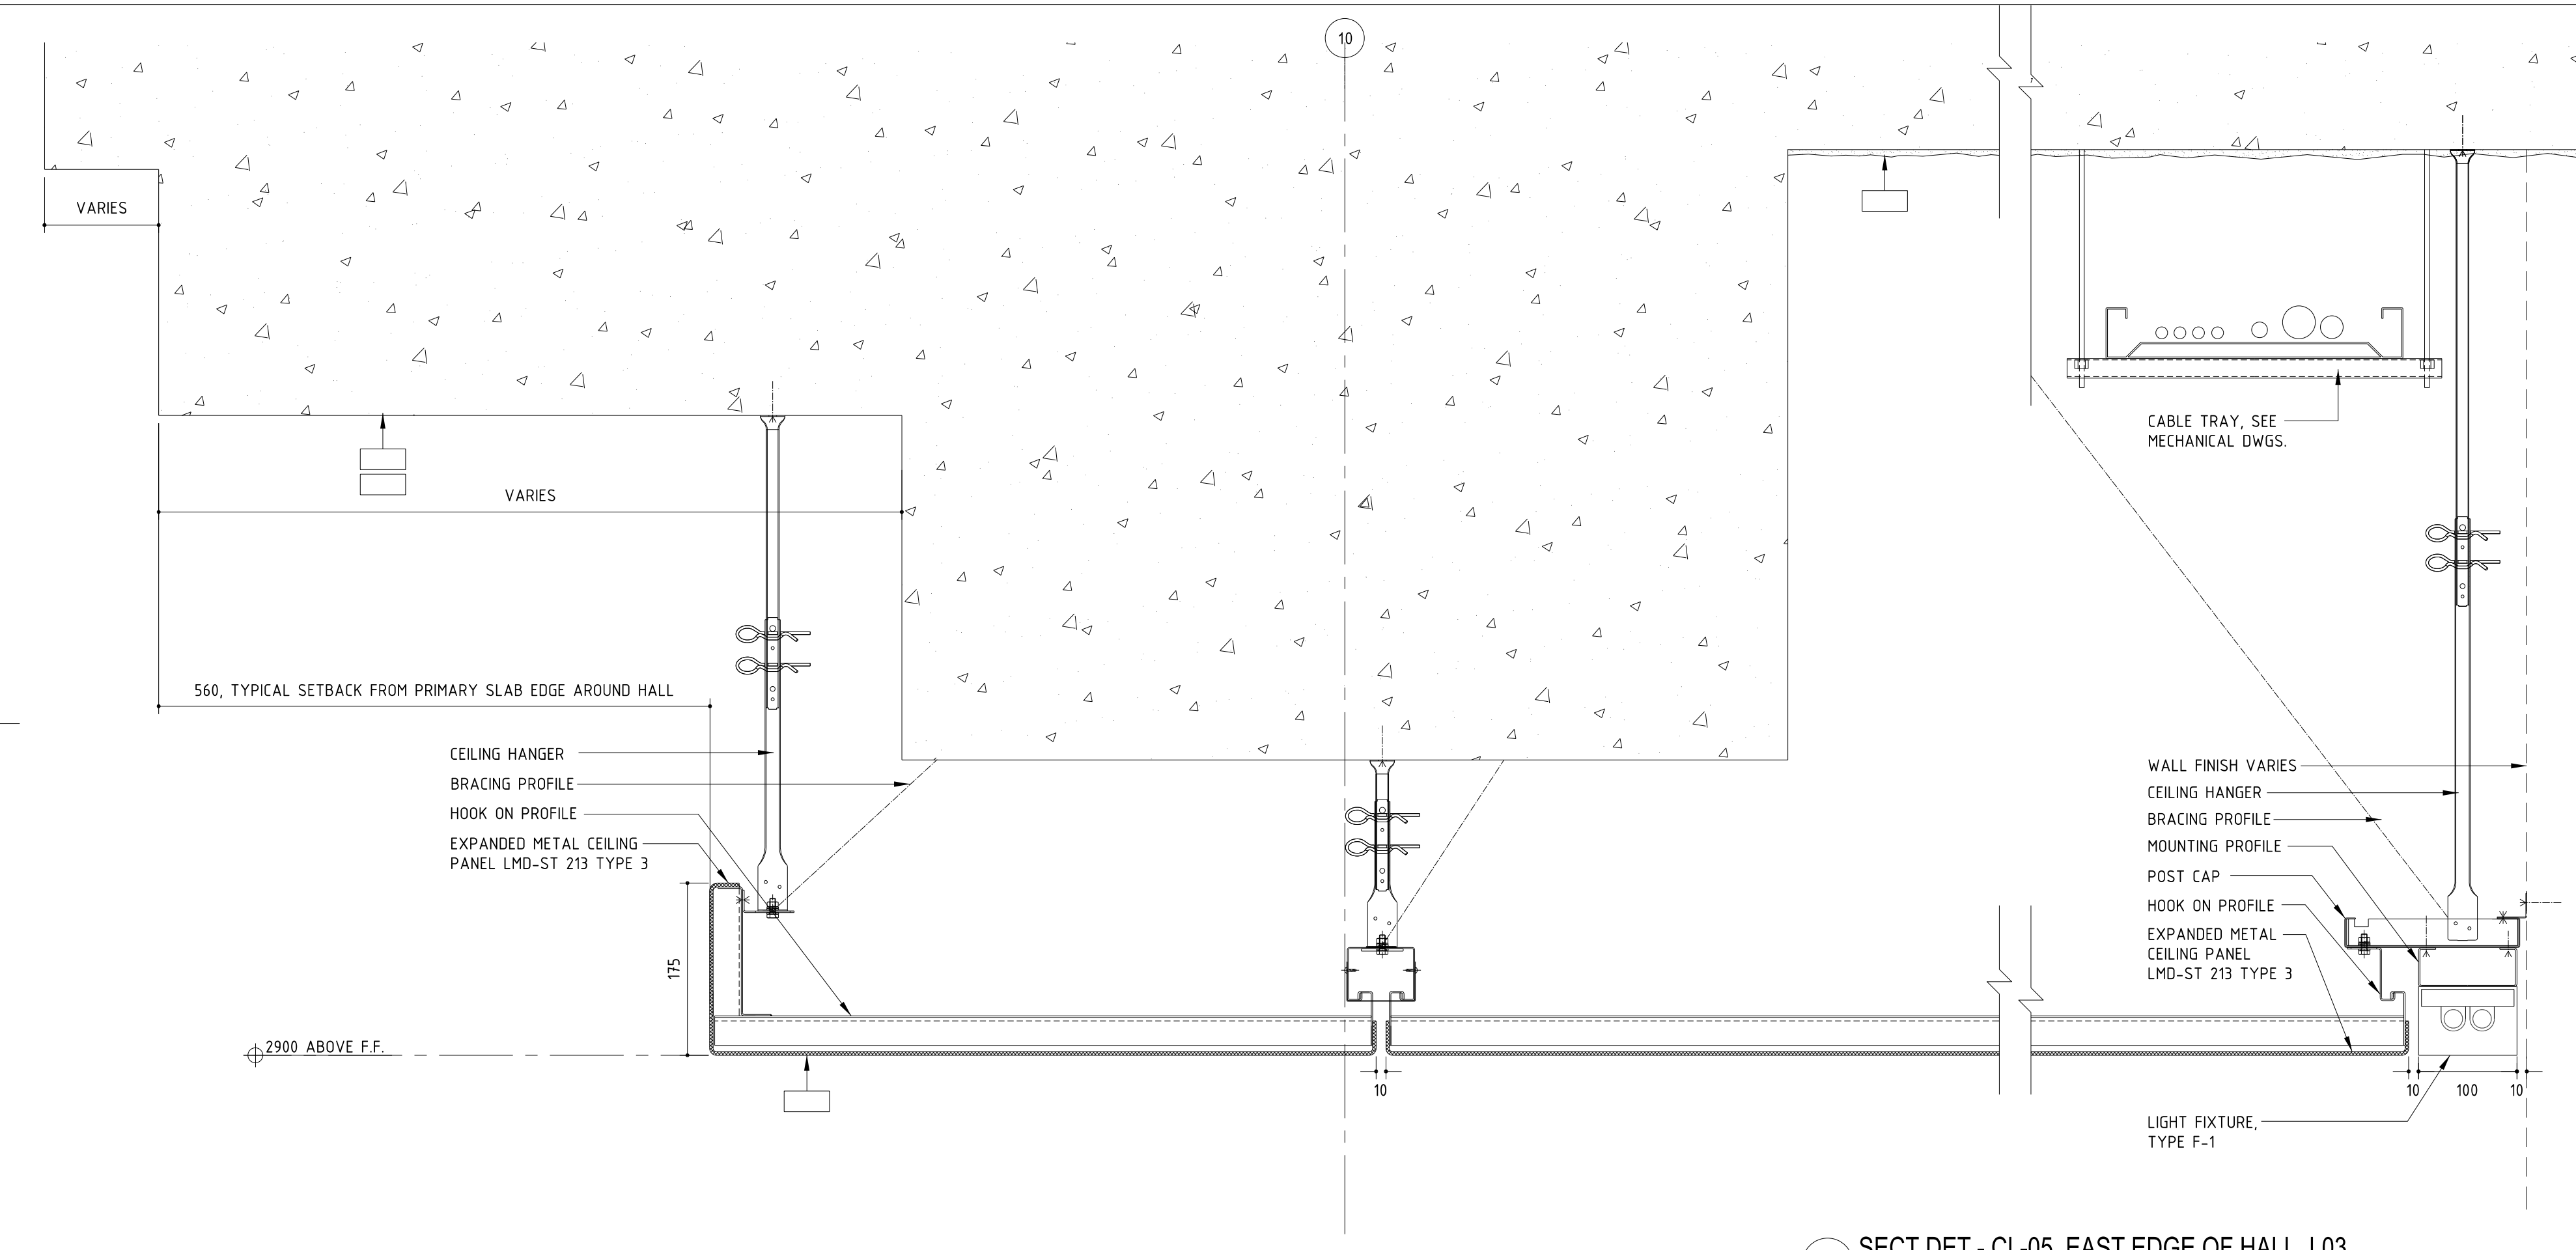


03 SECT DET - CL-05, EAST EDGE OF HALL, L03  
SCALE: 1:5

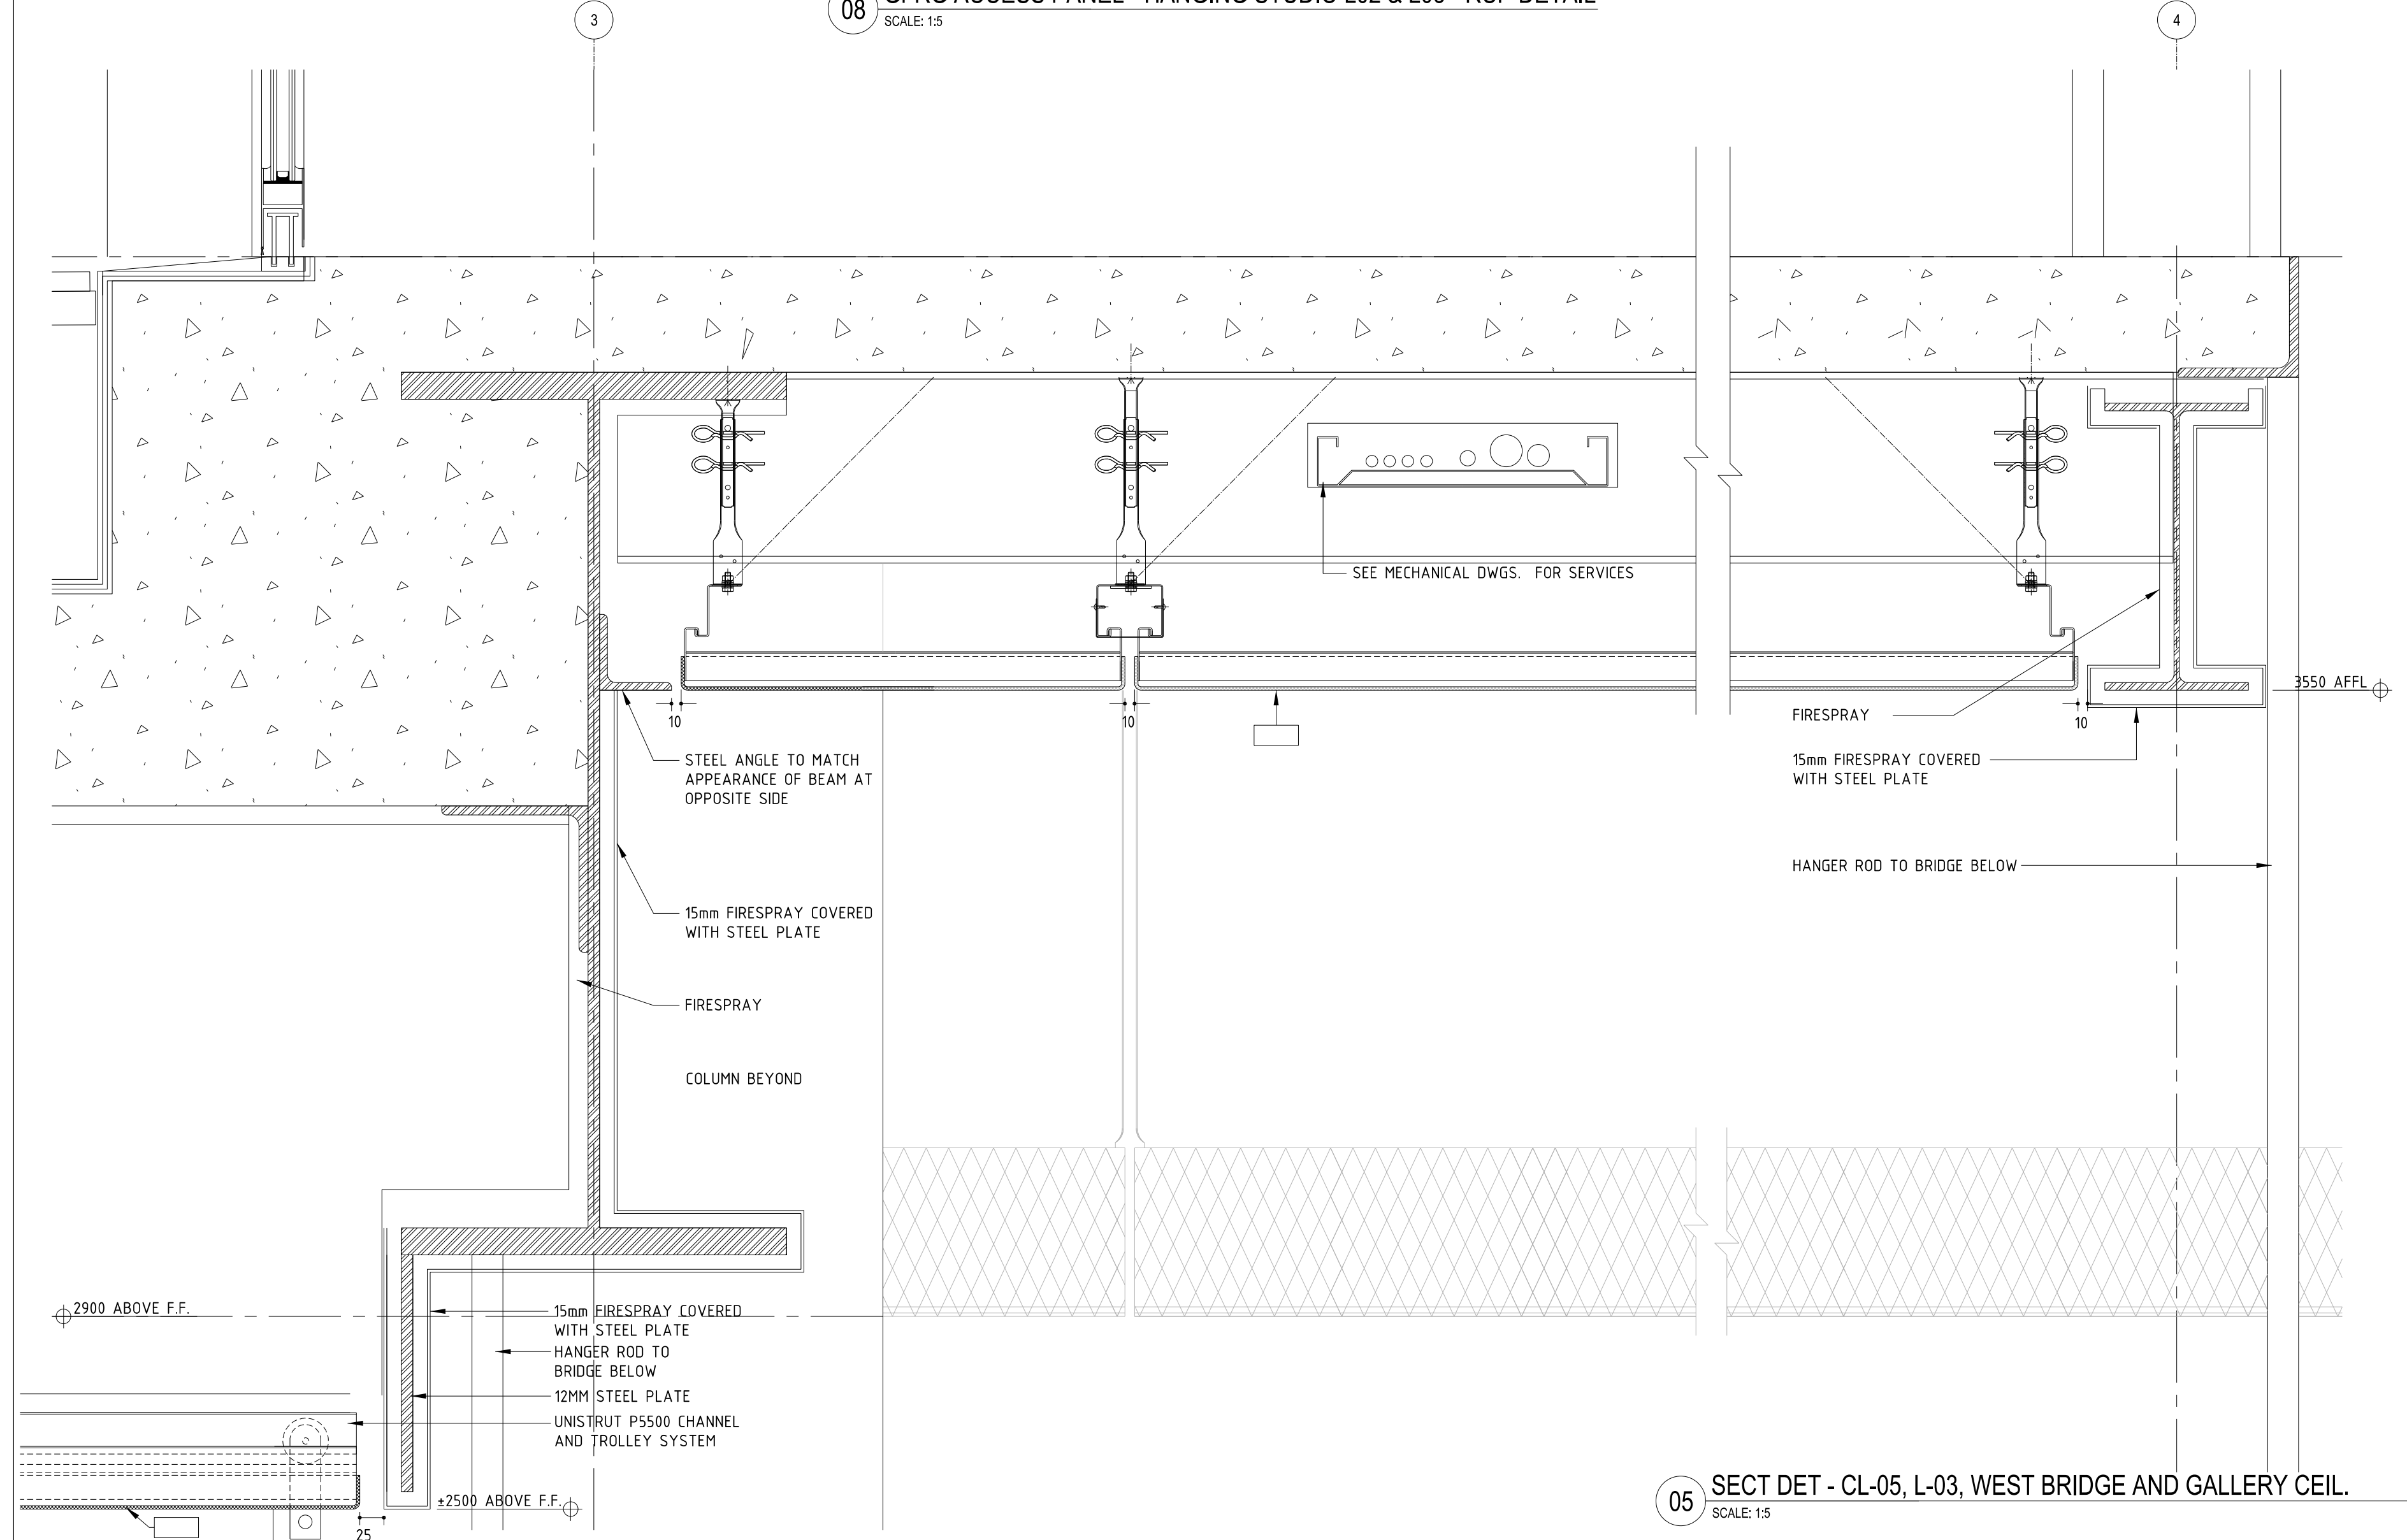


05 SECT DET - CL-05, L-03, WEST BRIDGE AND GALLERY CEIL.  
SCALE: 1:5

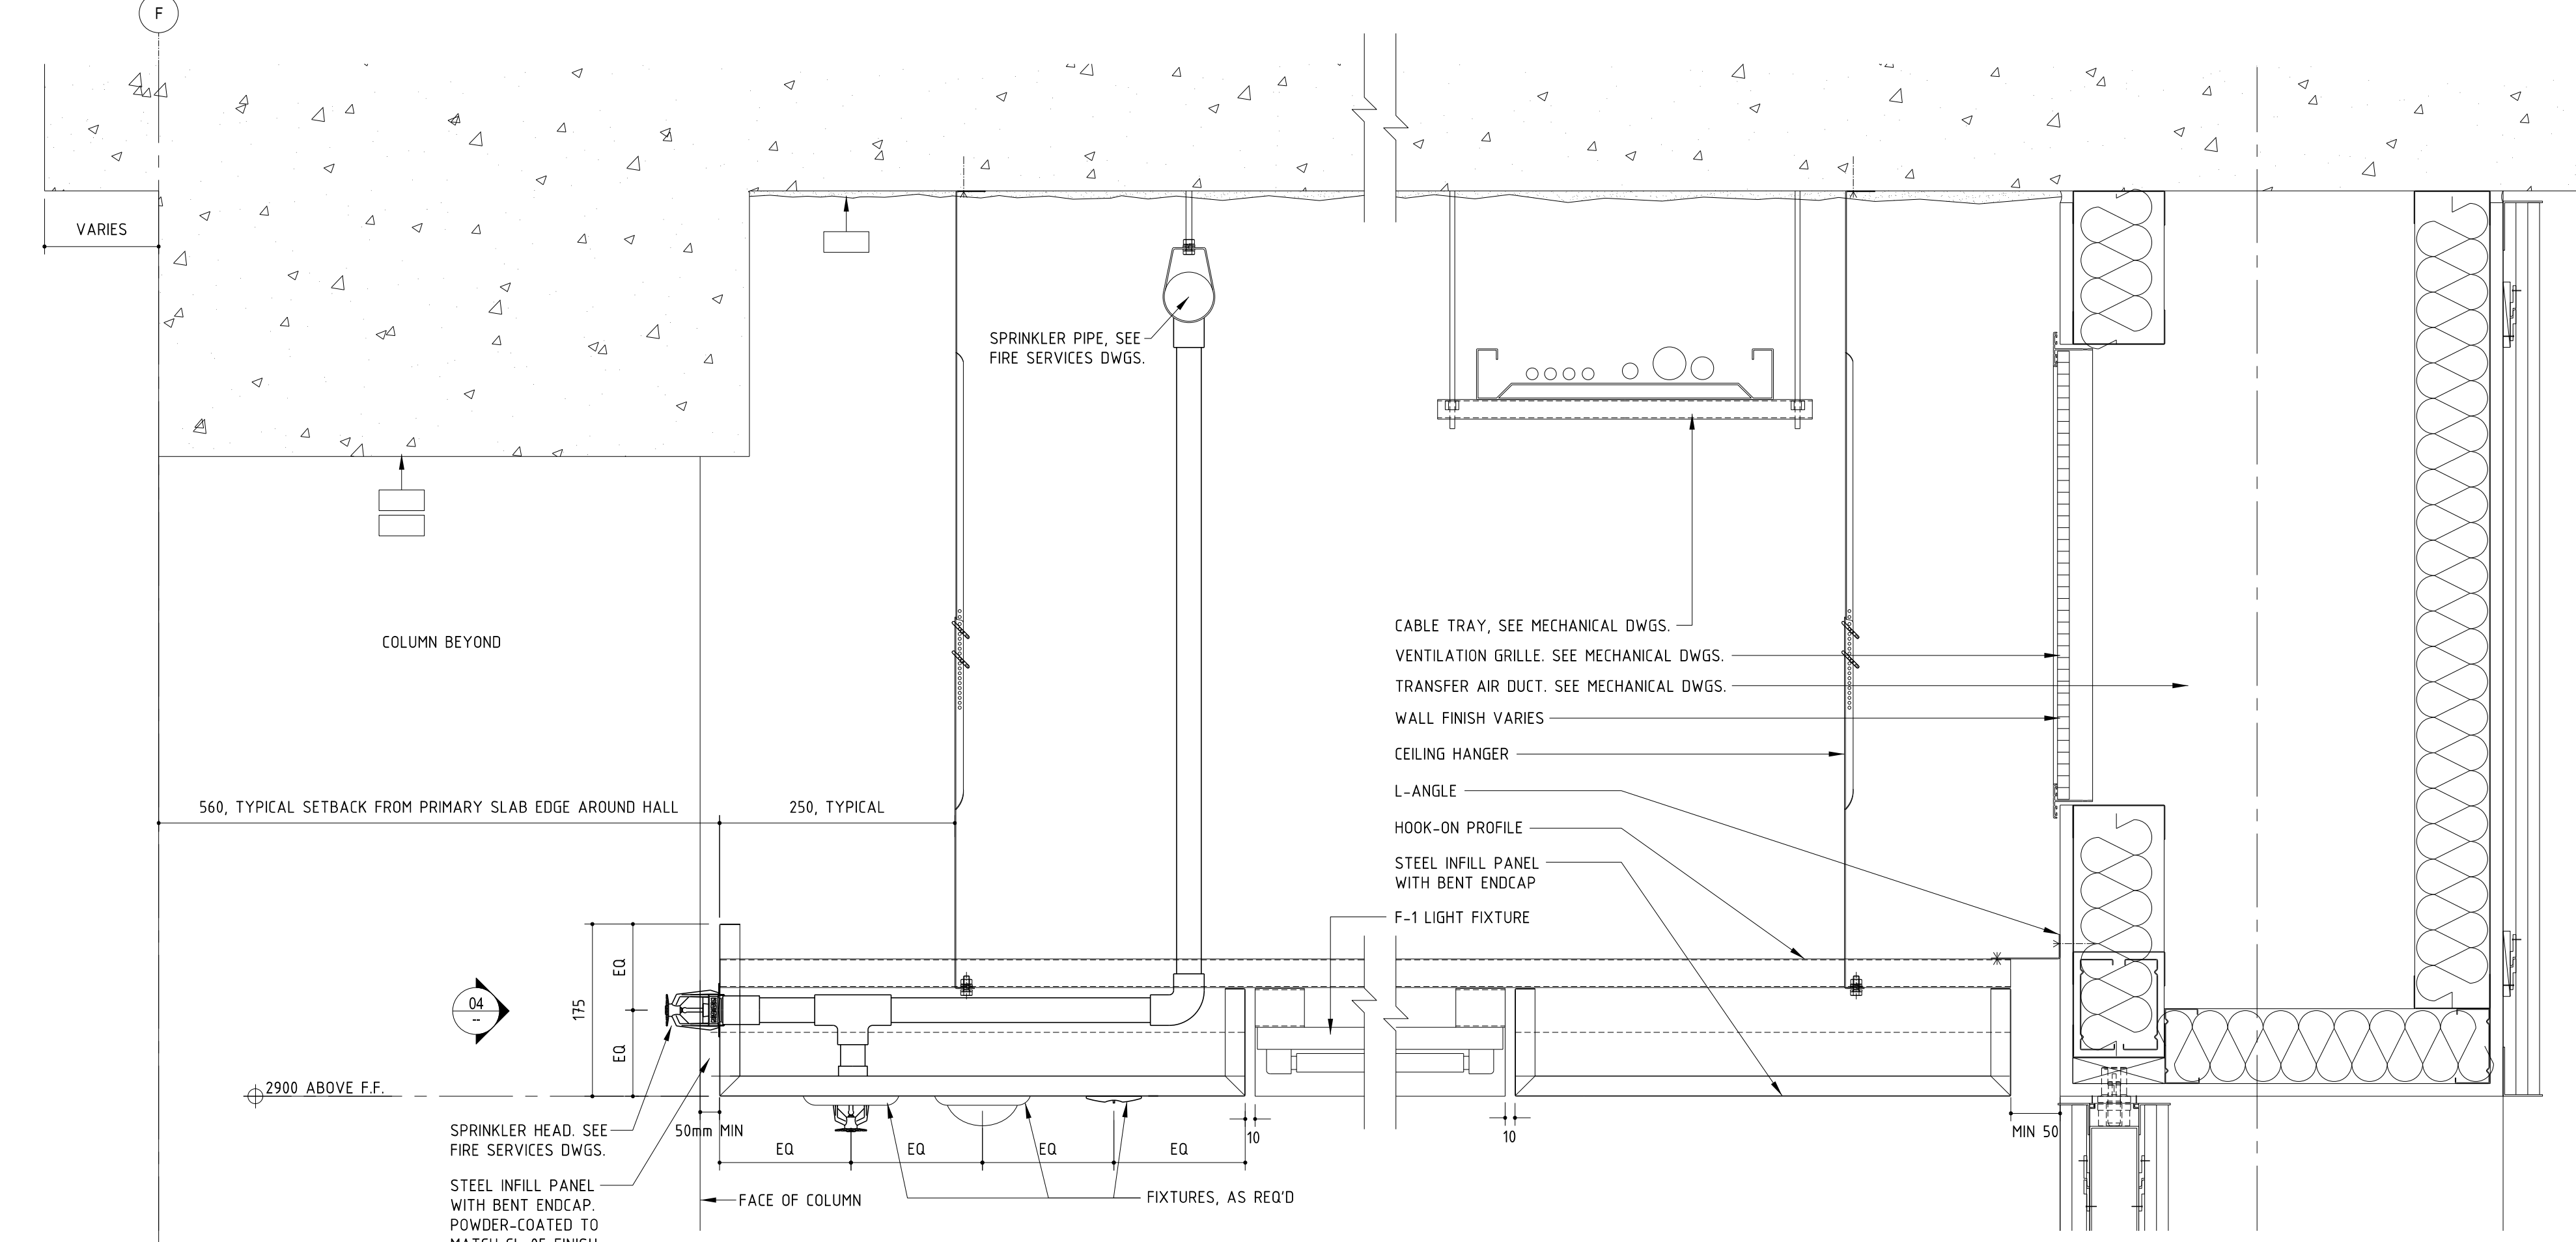


02 SECT DET - CL-05, THRU FIXTURES, SOUTH EDGE OF HALL, L01  
SCALE: 1:5

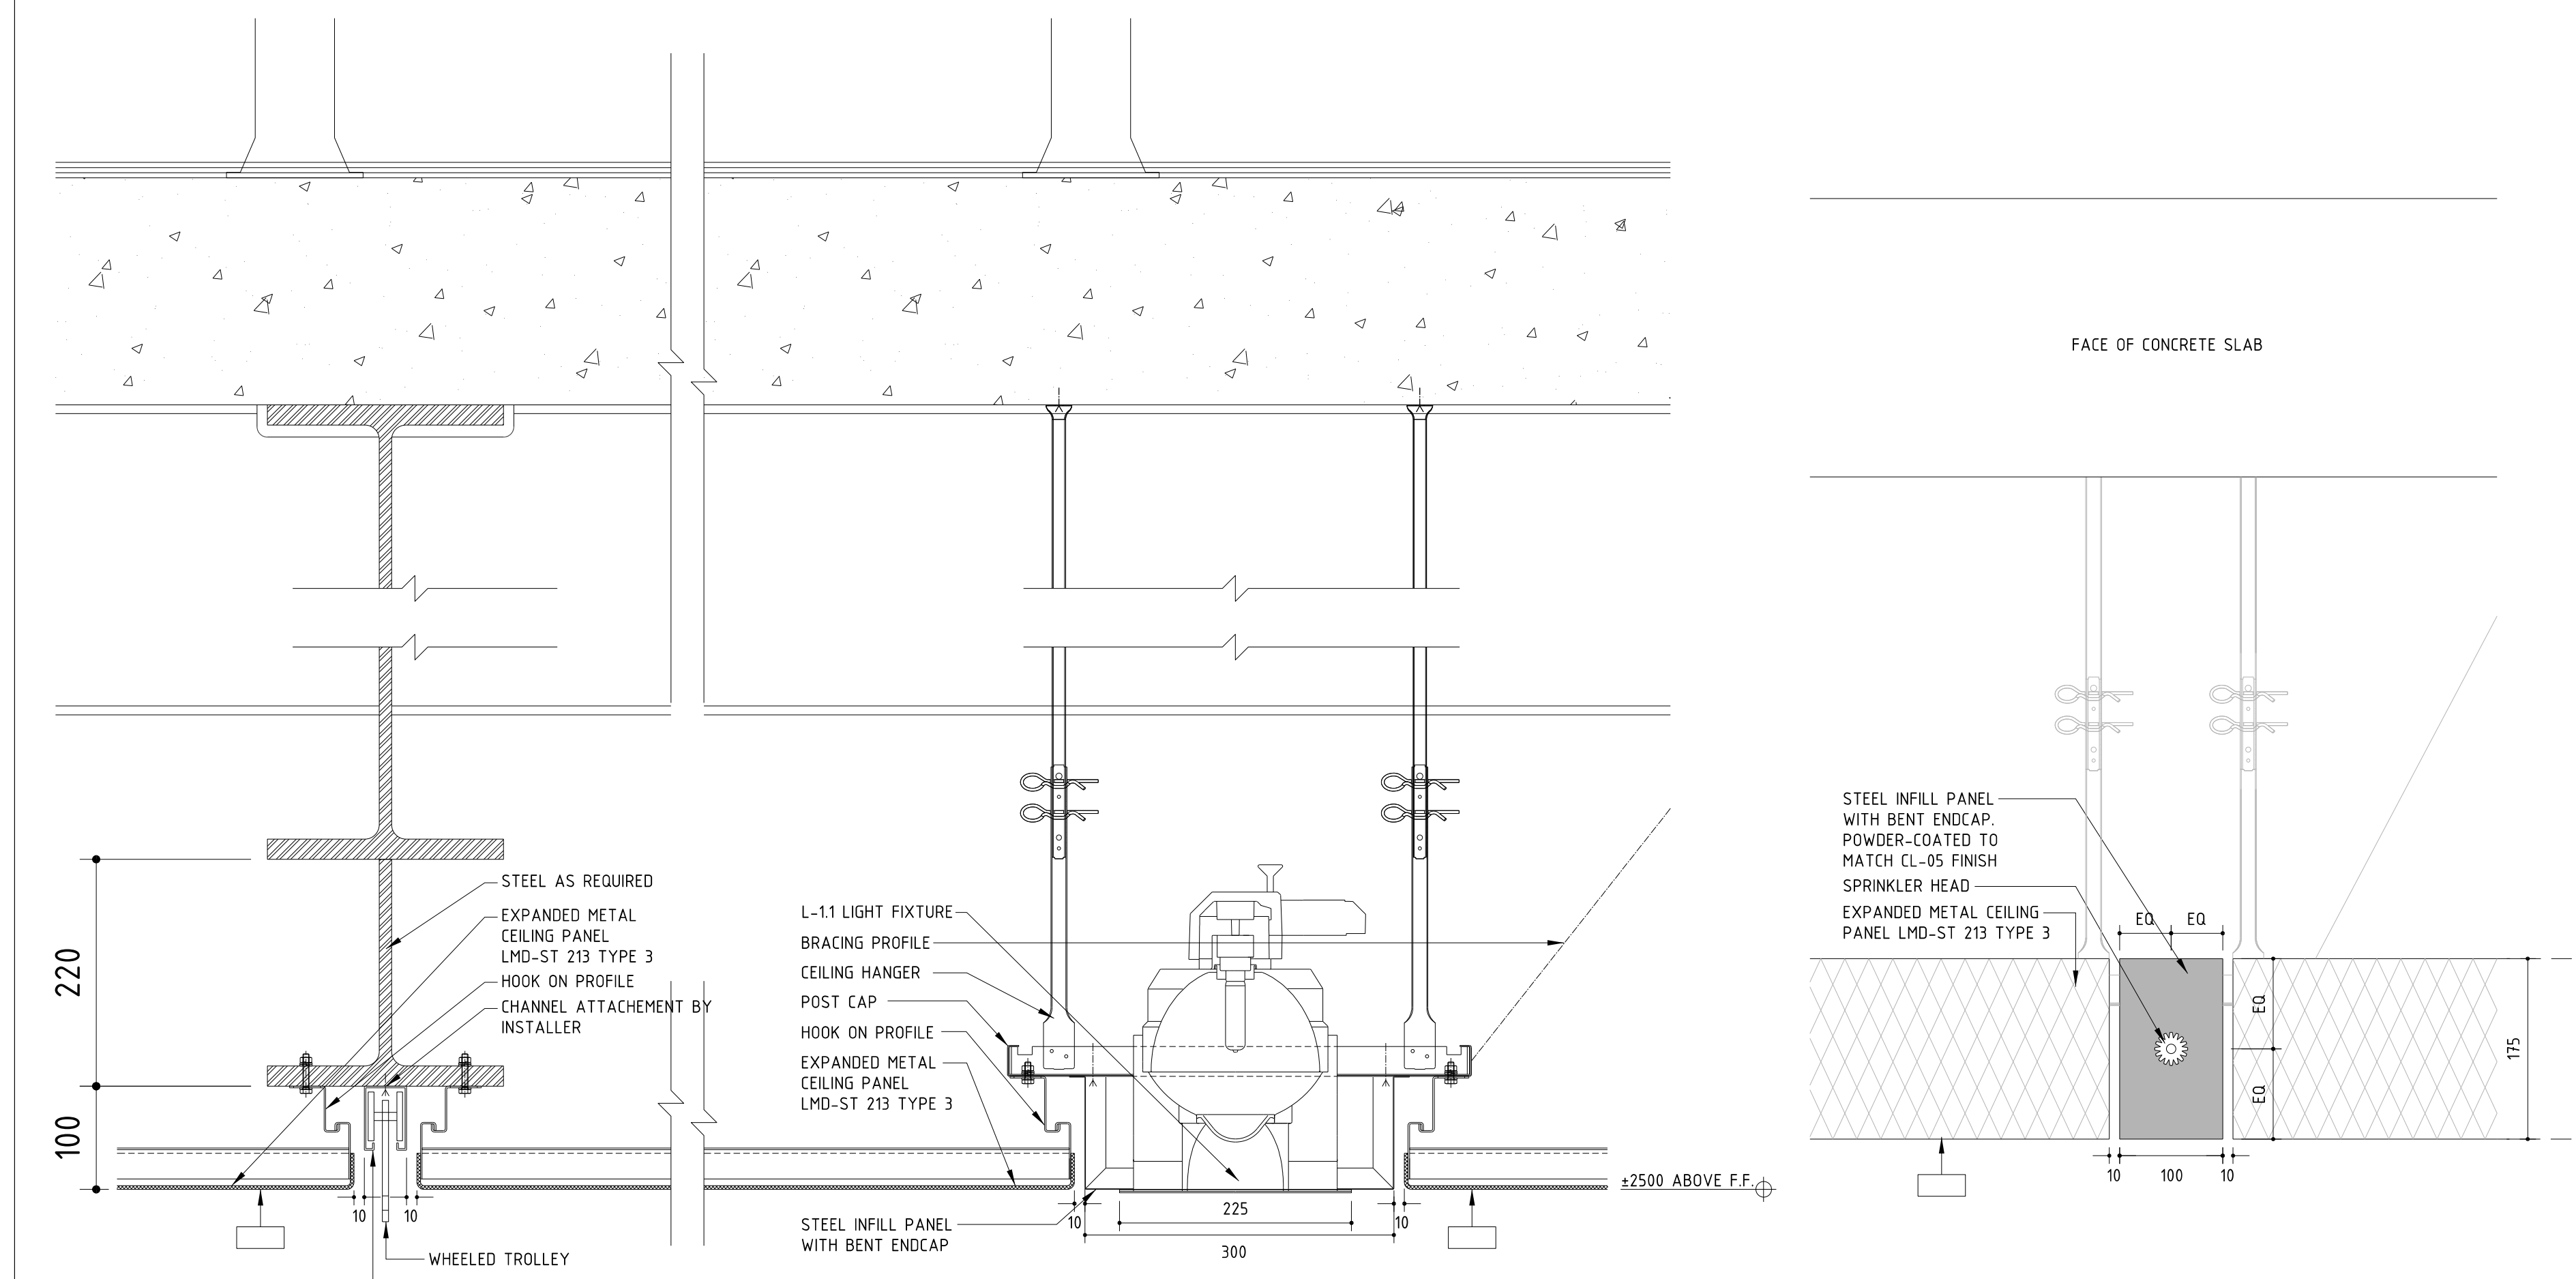

06 SECT DET - CL-05, JREED ATRIUM, L03  
SCALE: 1:5

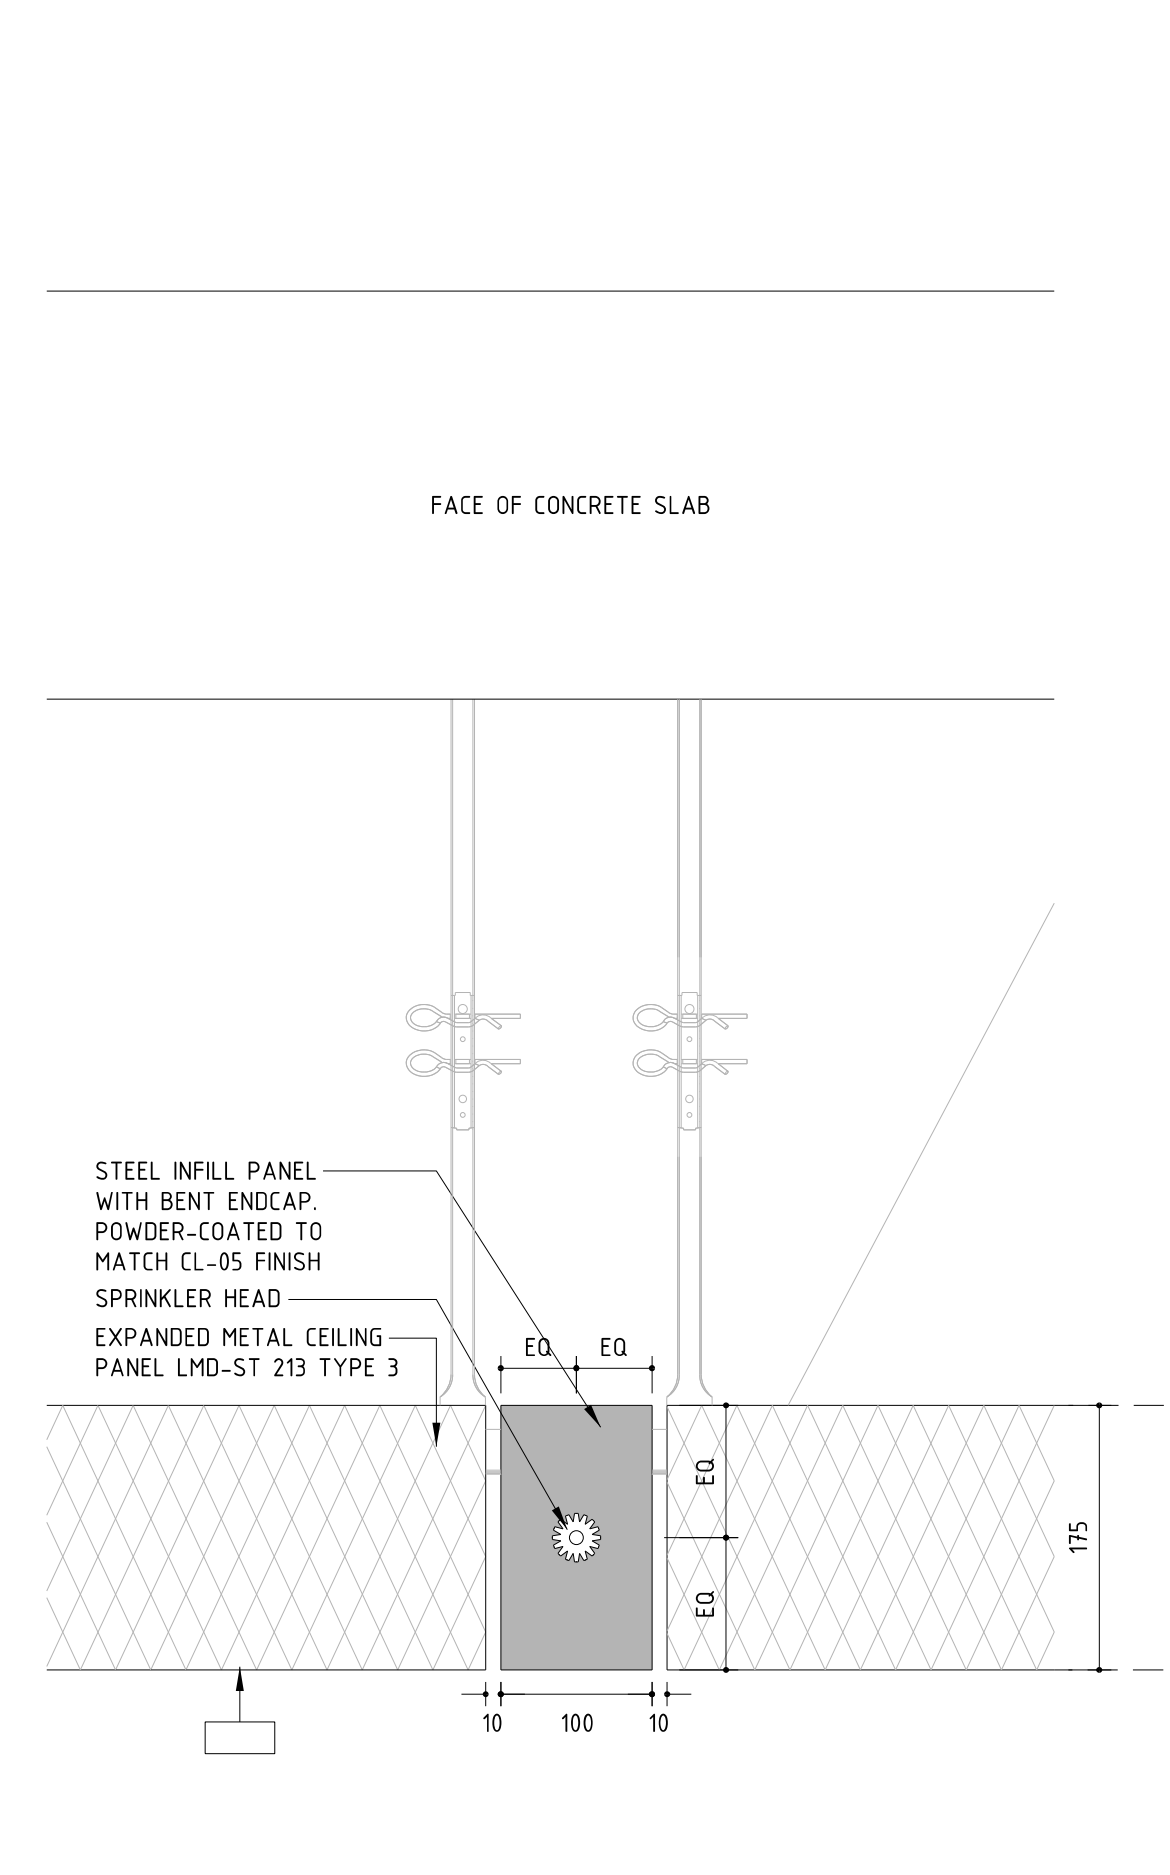


04 ELEV DET - CL-05, HALL EDGE, TYPICAL  
SCALE: 1:5

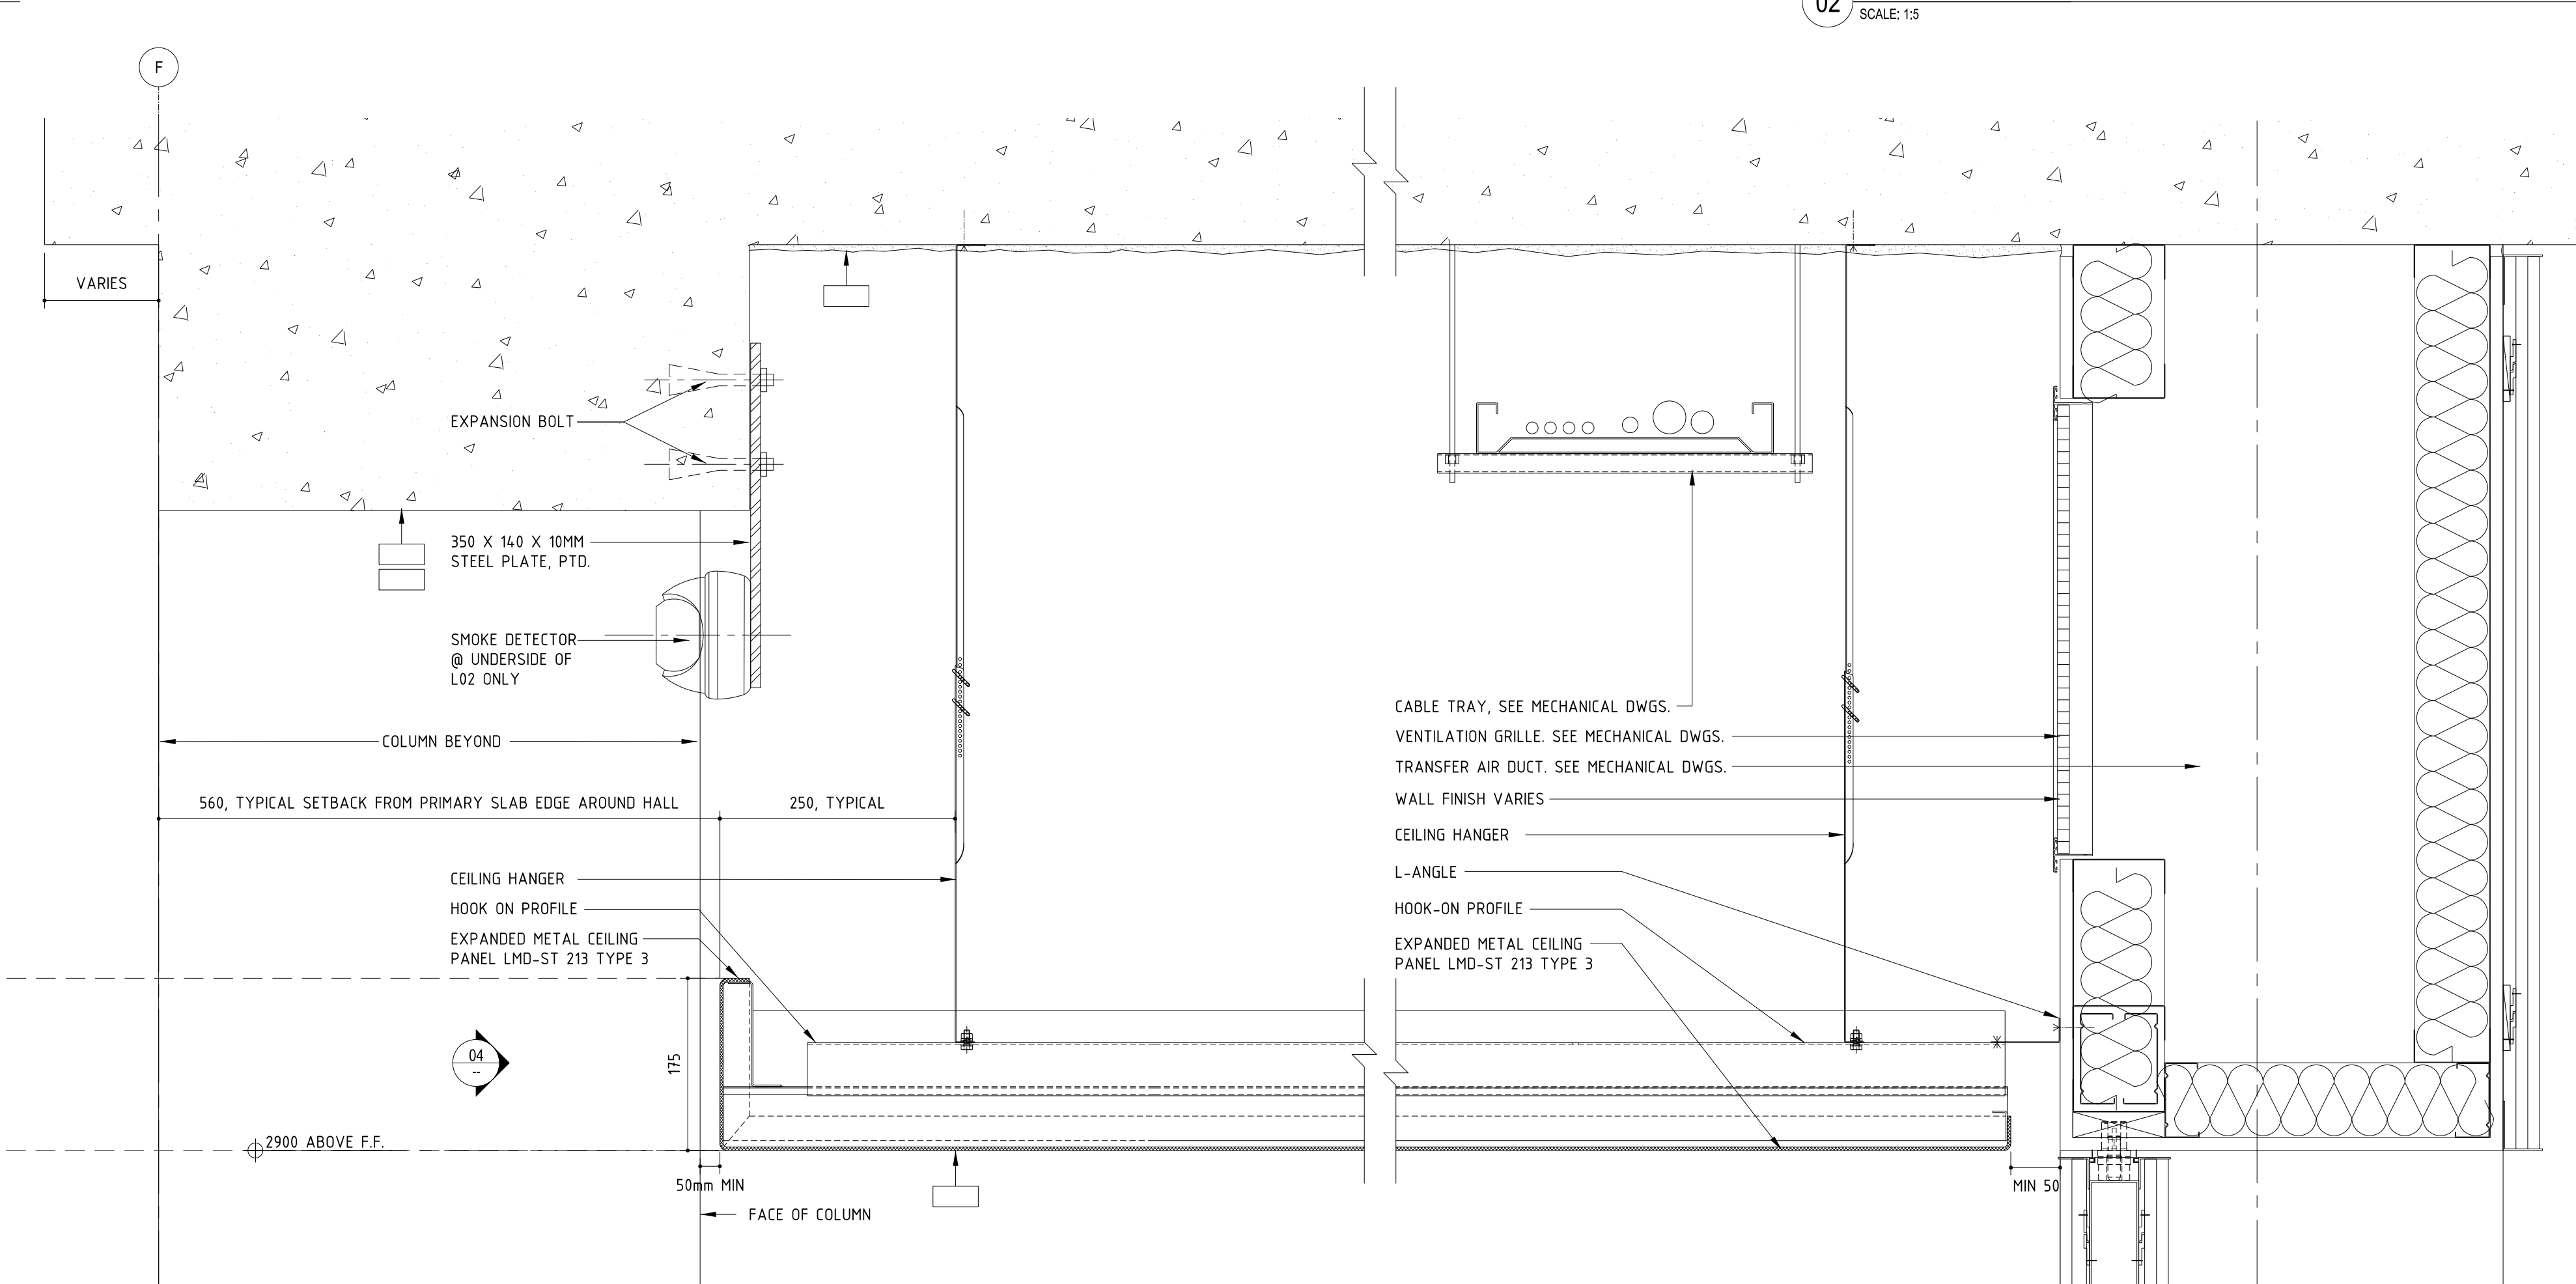

01 SECT DET - CL-05, SOUTH EDGE OF HALL, L01  
SCALE: 1:5

D	SG	CONSTRUCTION ISSUE	-	24.01.14
C	SG	CONSTRUCTION ISSUE	-	06.01.14
B	SG	CONSTRUCTION ISSUE	-	18.12.13
A	SG	FOR CONSTRUCTION	-	12.10.13
02	JC	100% CD - TENDER ISSUE	-	07.08.12
01	JC	90% CD ISSUE	-	10.08.12

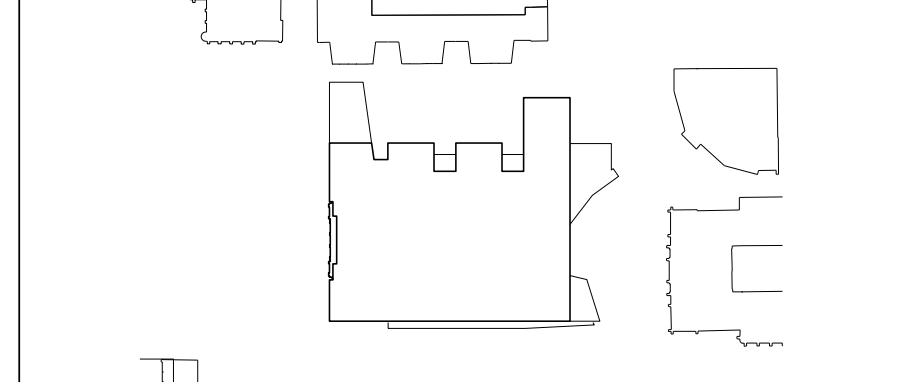

**NADAAA**  
NADAAA Telephone +1 517 442 6232  
1600 Washington Street No.2 Facsimile +1 508 442 1417  
Boston Massachusetts Email nad@nadaaa.com  
02118 USA

**John Wardle Architects**  
© 2011 John Wardle Architects  
Level 10, 180 Russell Street, Melbourne Victoria 3000 Australia  
Tel : +613 9654 0700 www.johnwardlearchitects.com

Client **University of Melbourne Parkville Campus**  
Project **Faculty of Architecture Building and Planning**  
Title **TYPICAL CEILING FINISH DETAILS**

Project No.	<b>0913</b>	Scale	1:5
Drawing No.	<b>AR7801</b>	Revision	<b>D</b>
Date	JAN 2014	Drawn	-
FILENAME	#####	Co-Ord	-
		Check	-

**FOR CONSTRUCTION**