
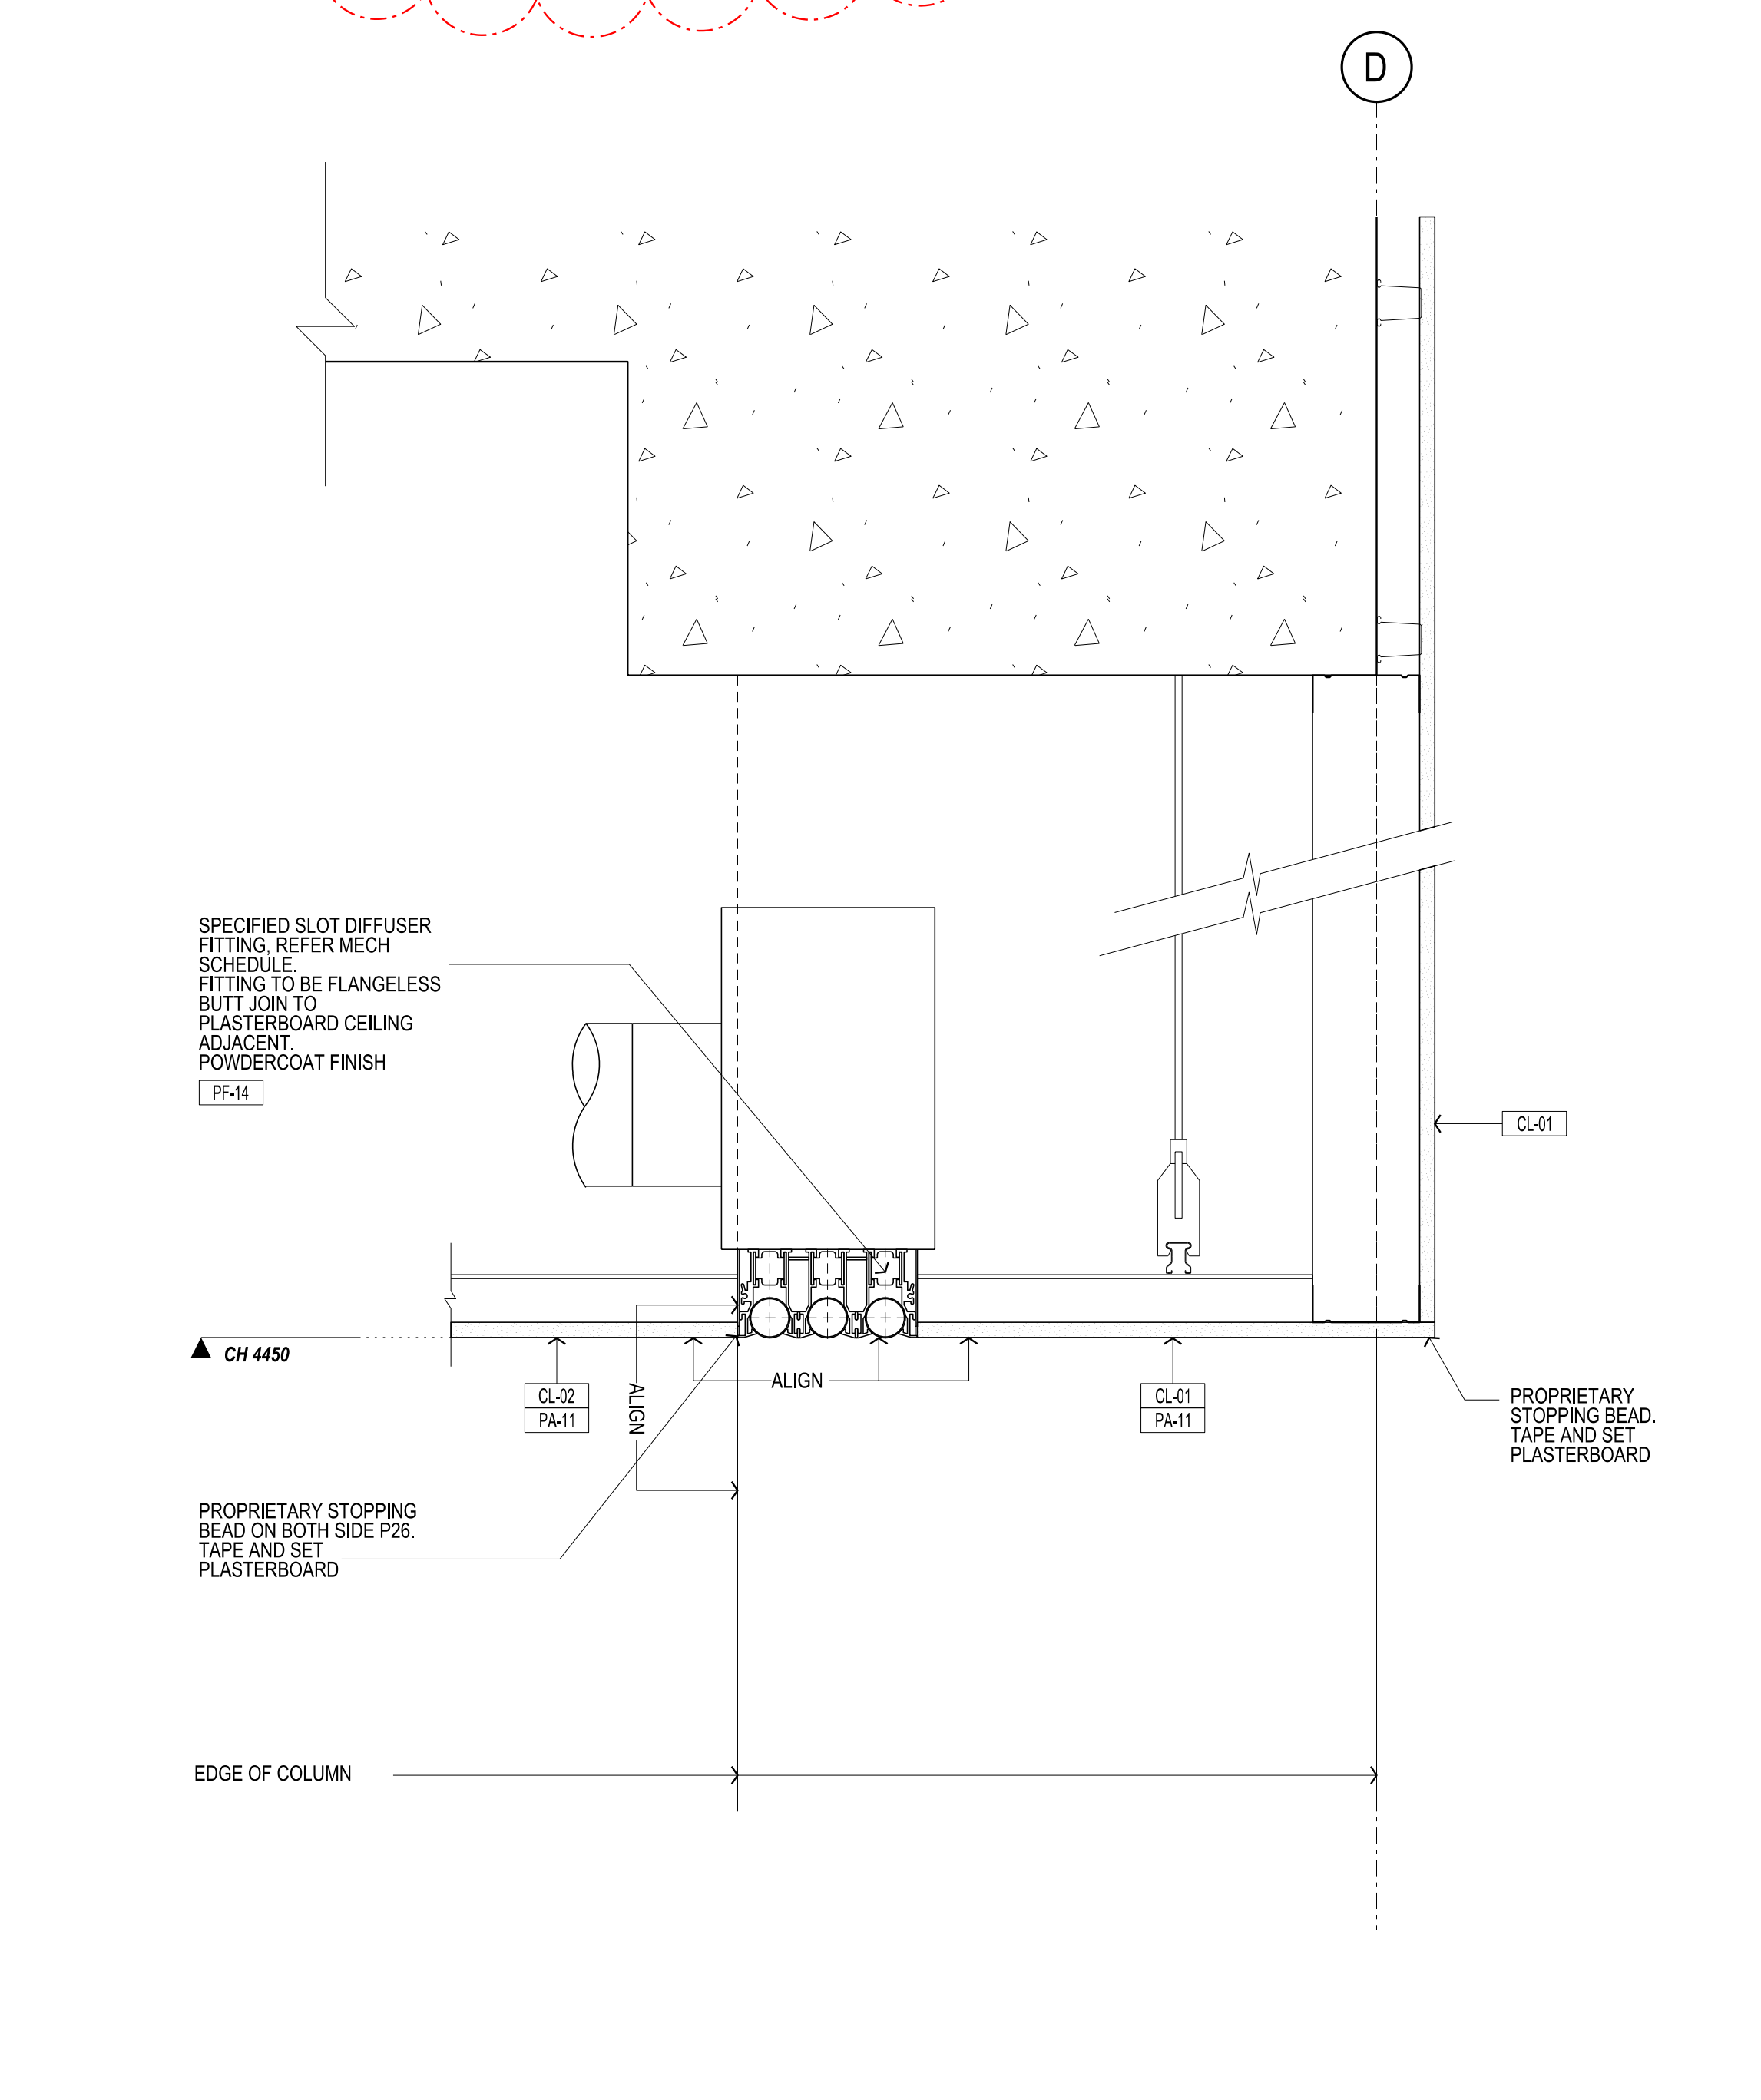
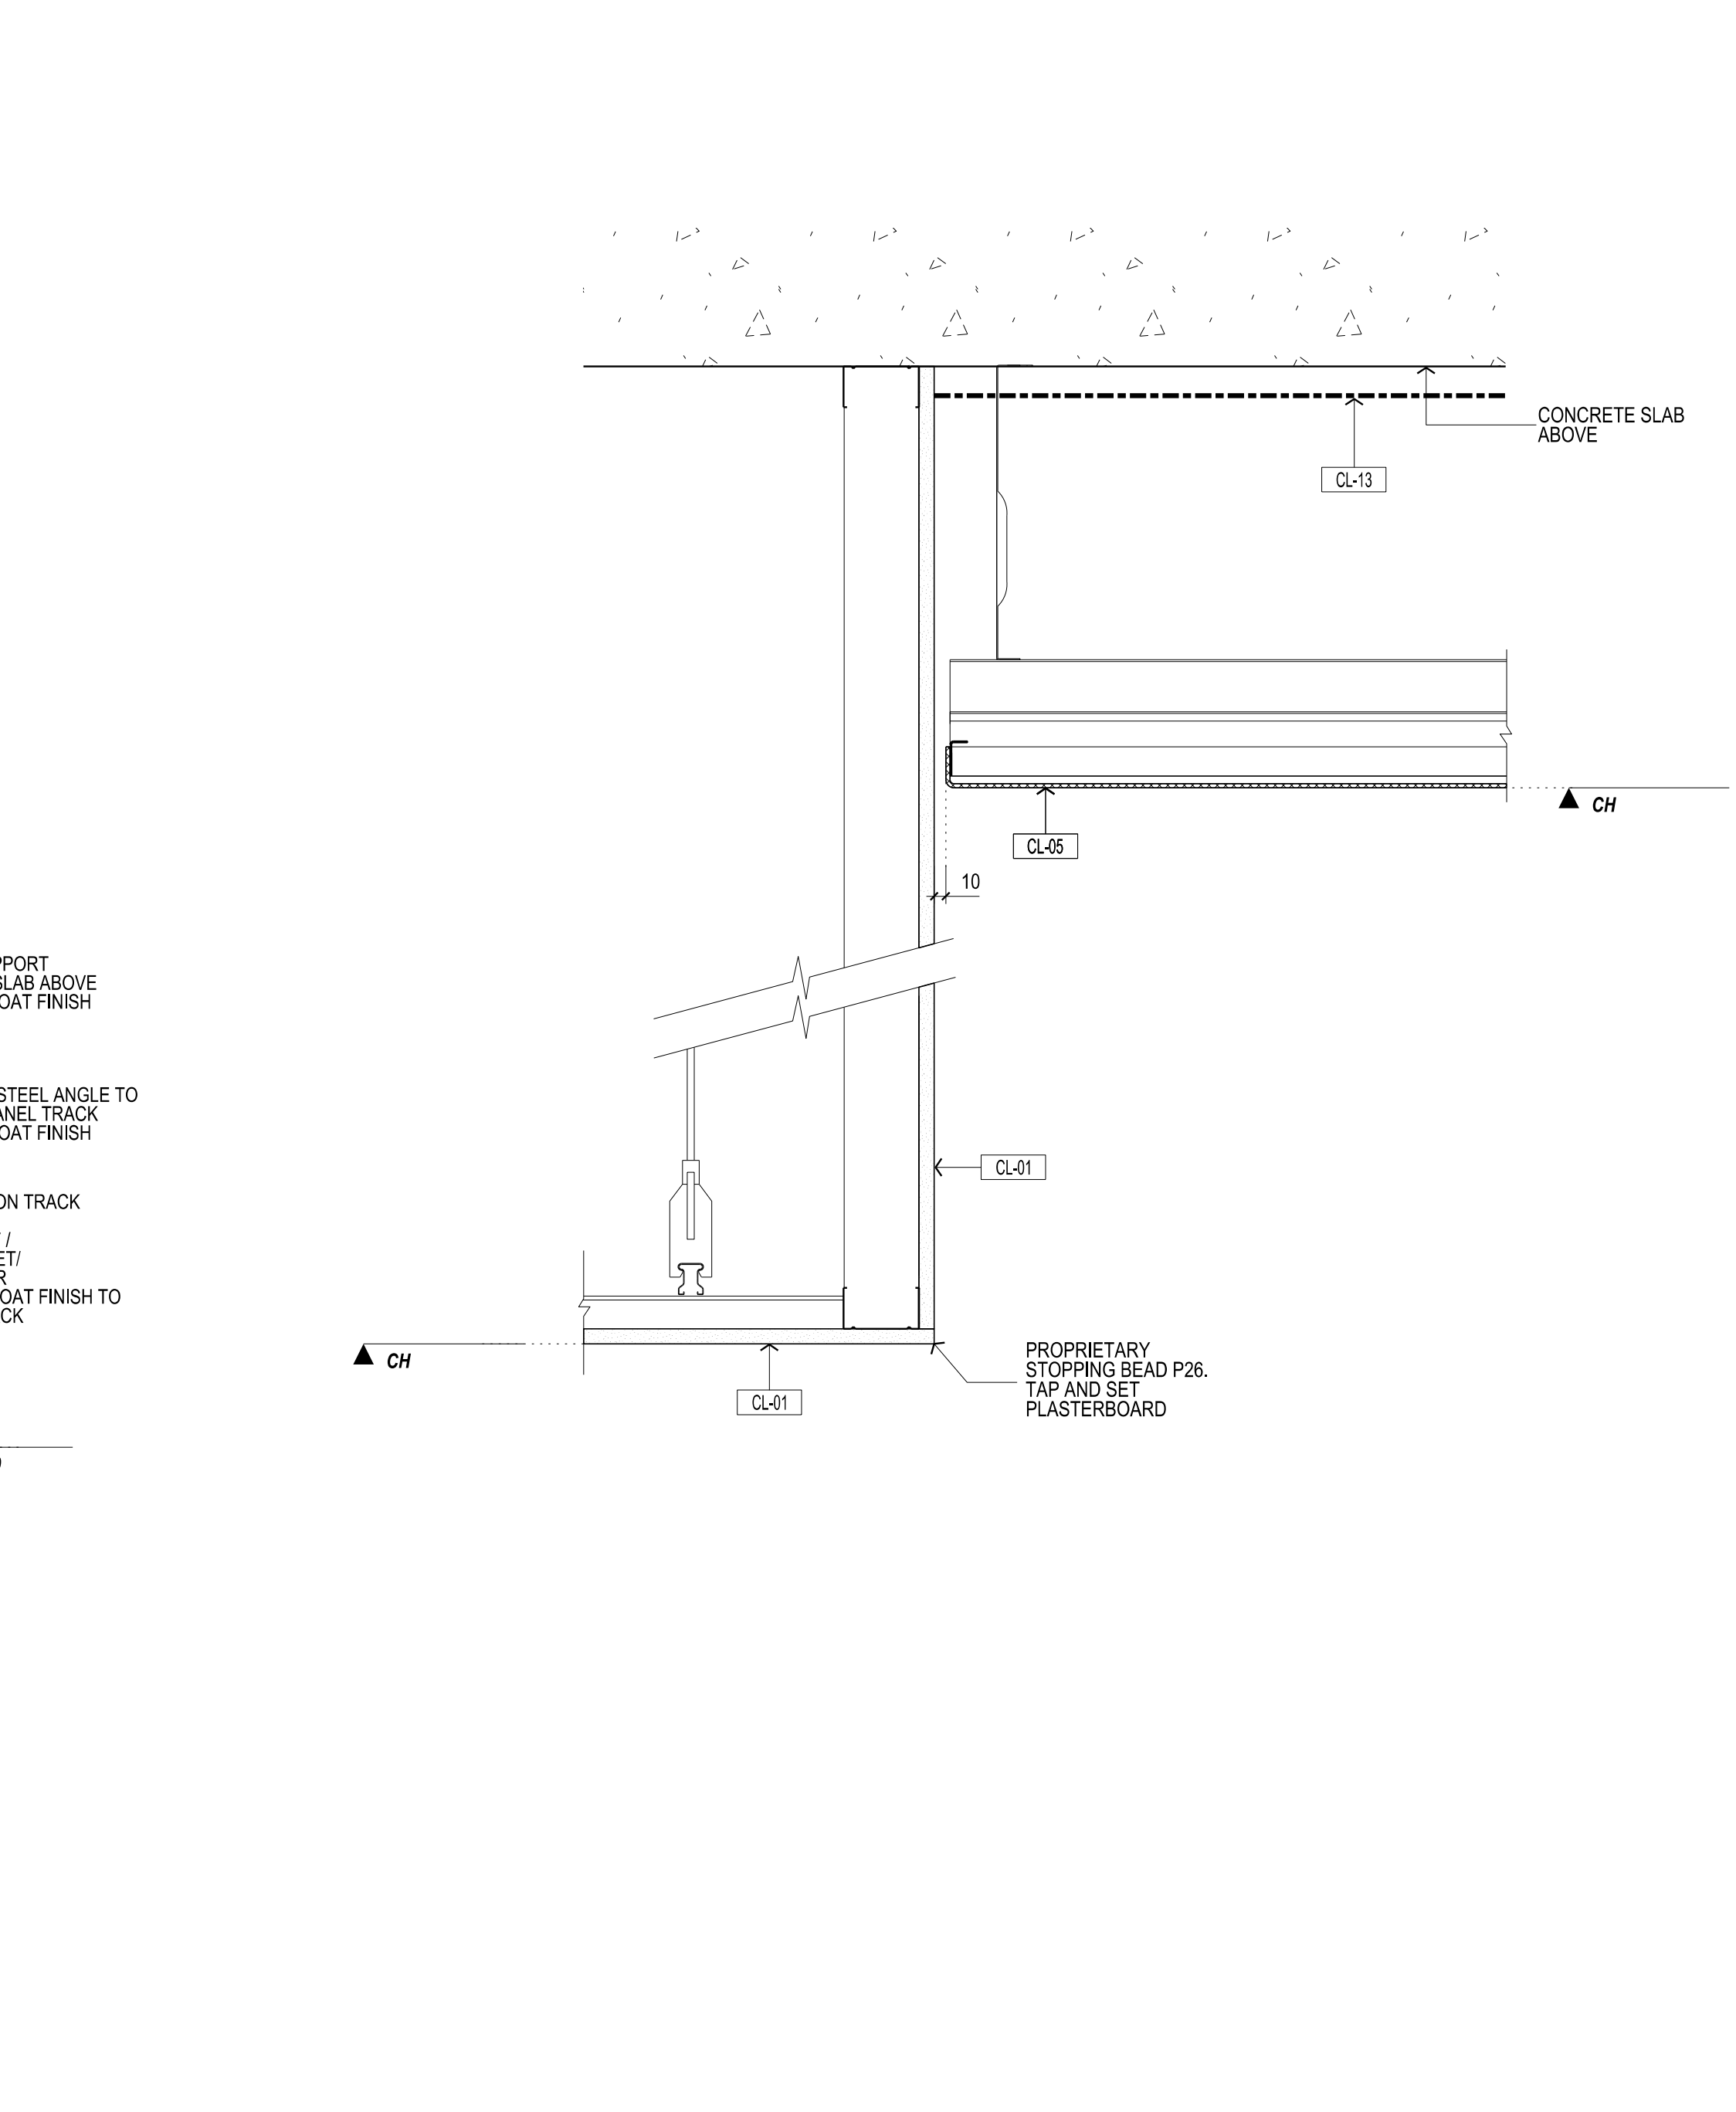
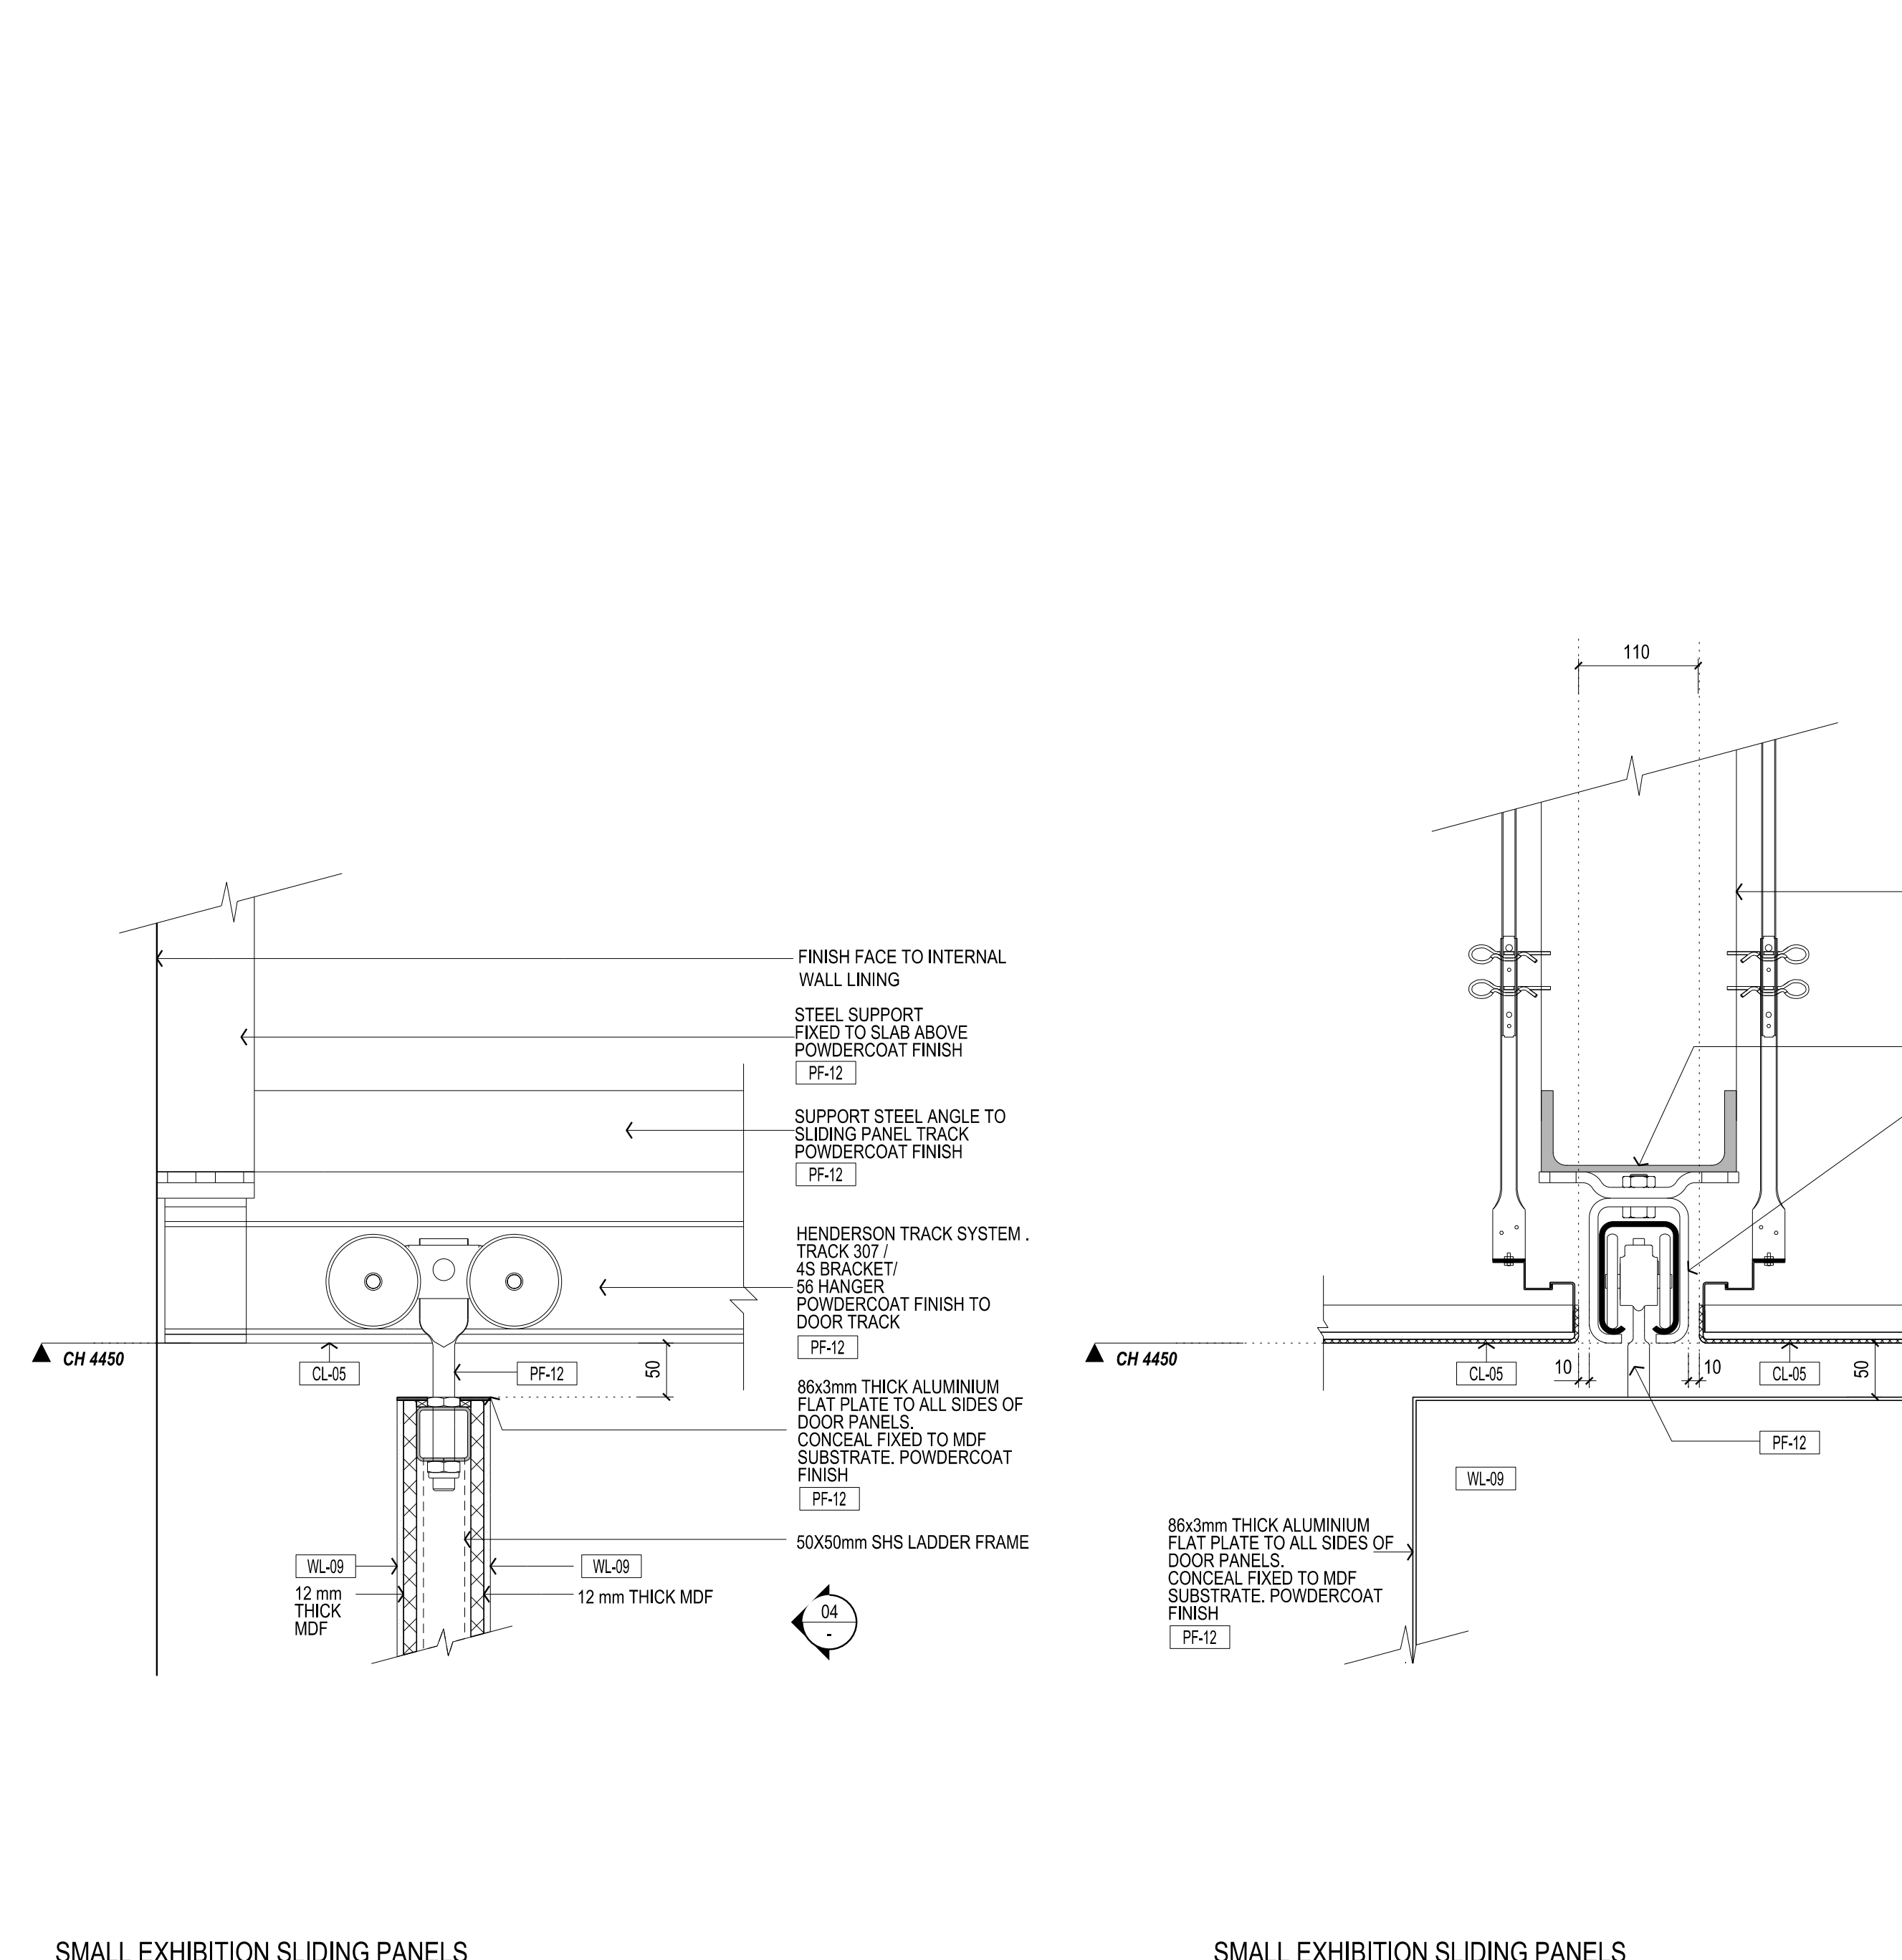
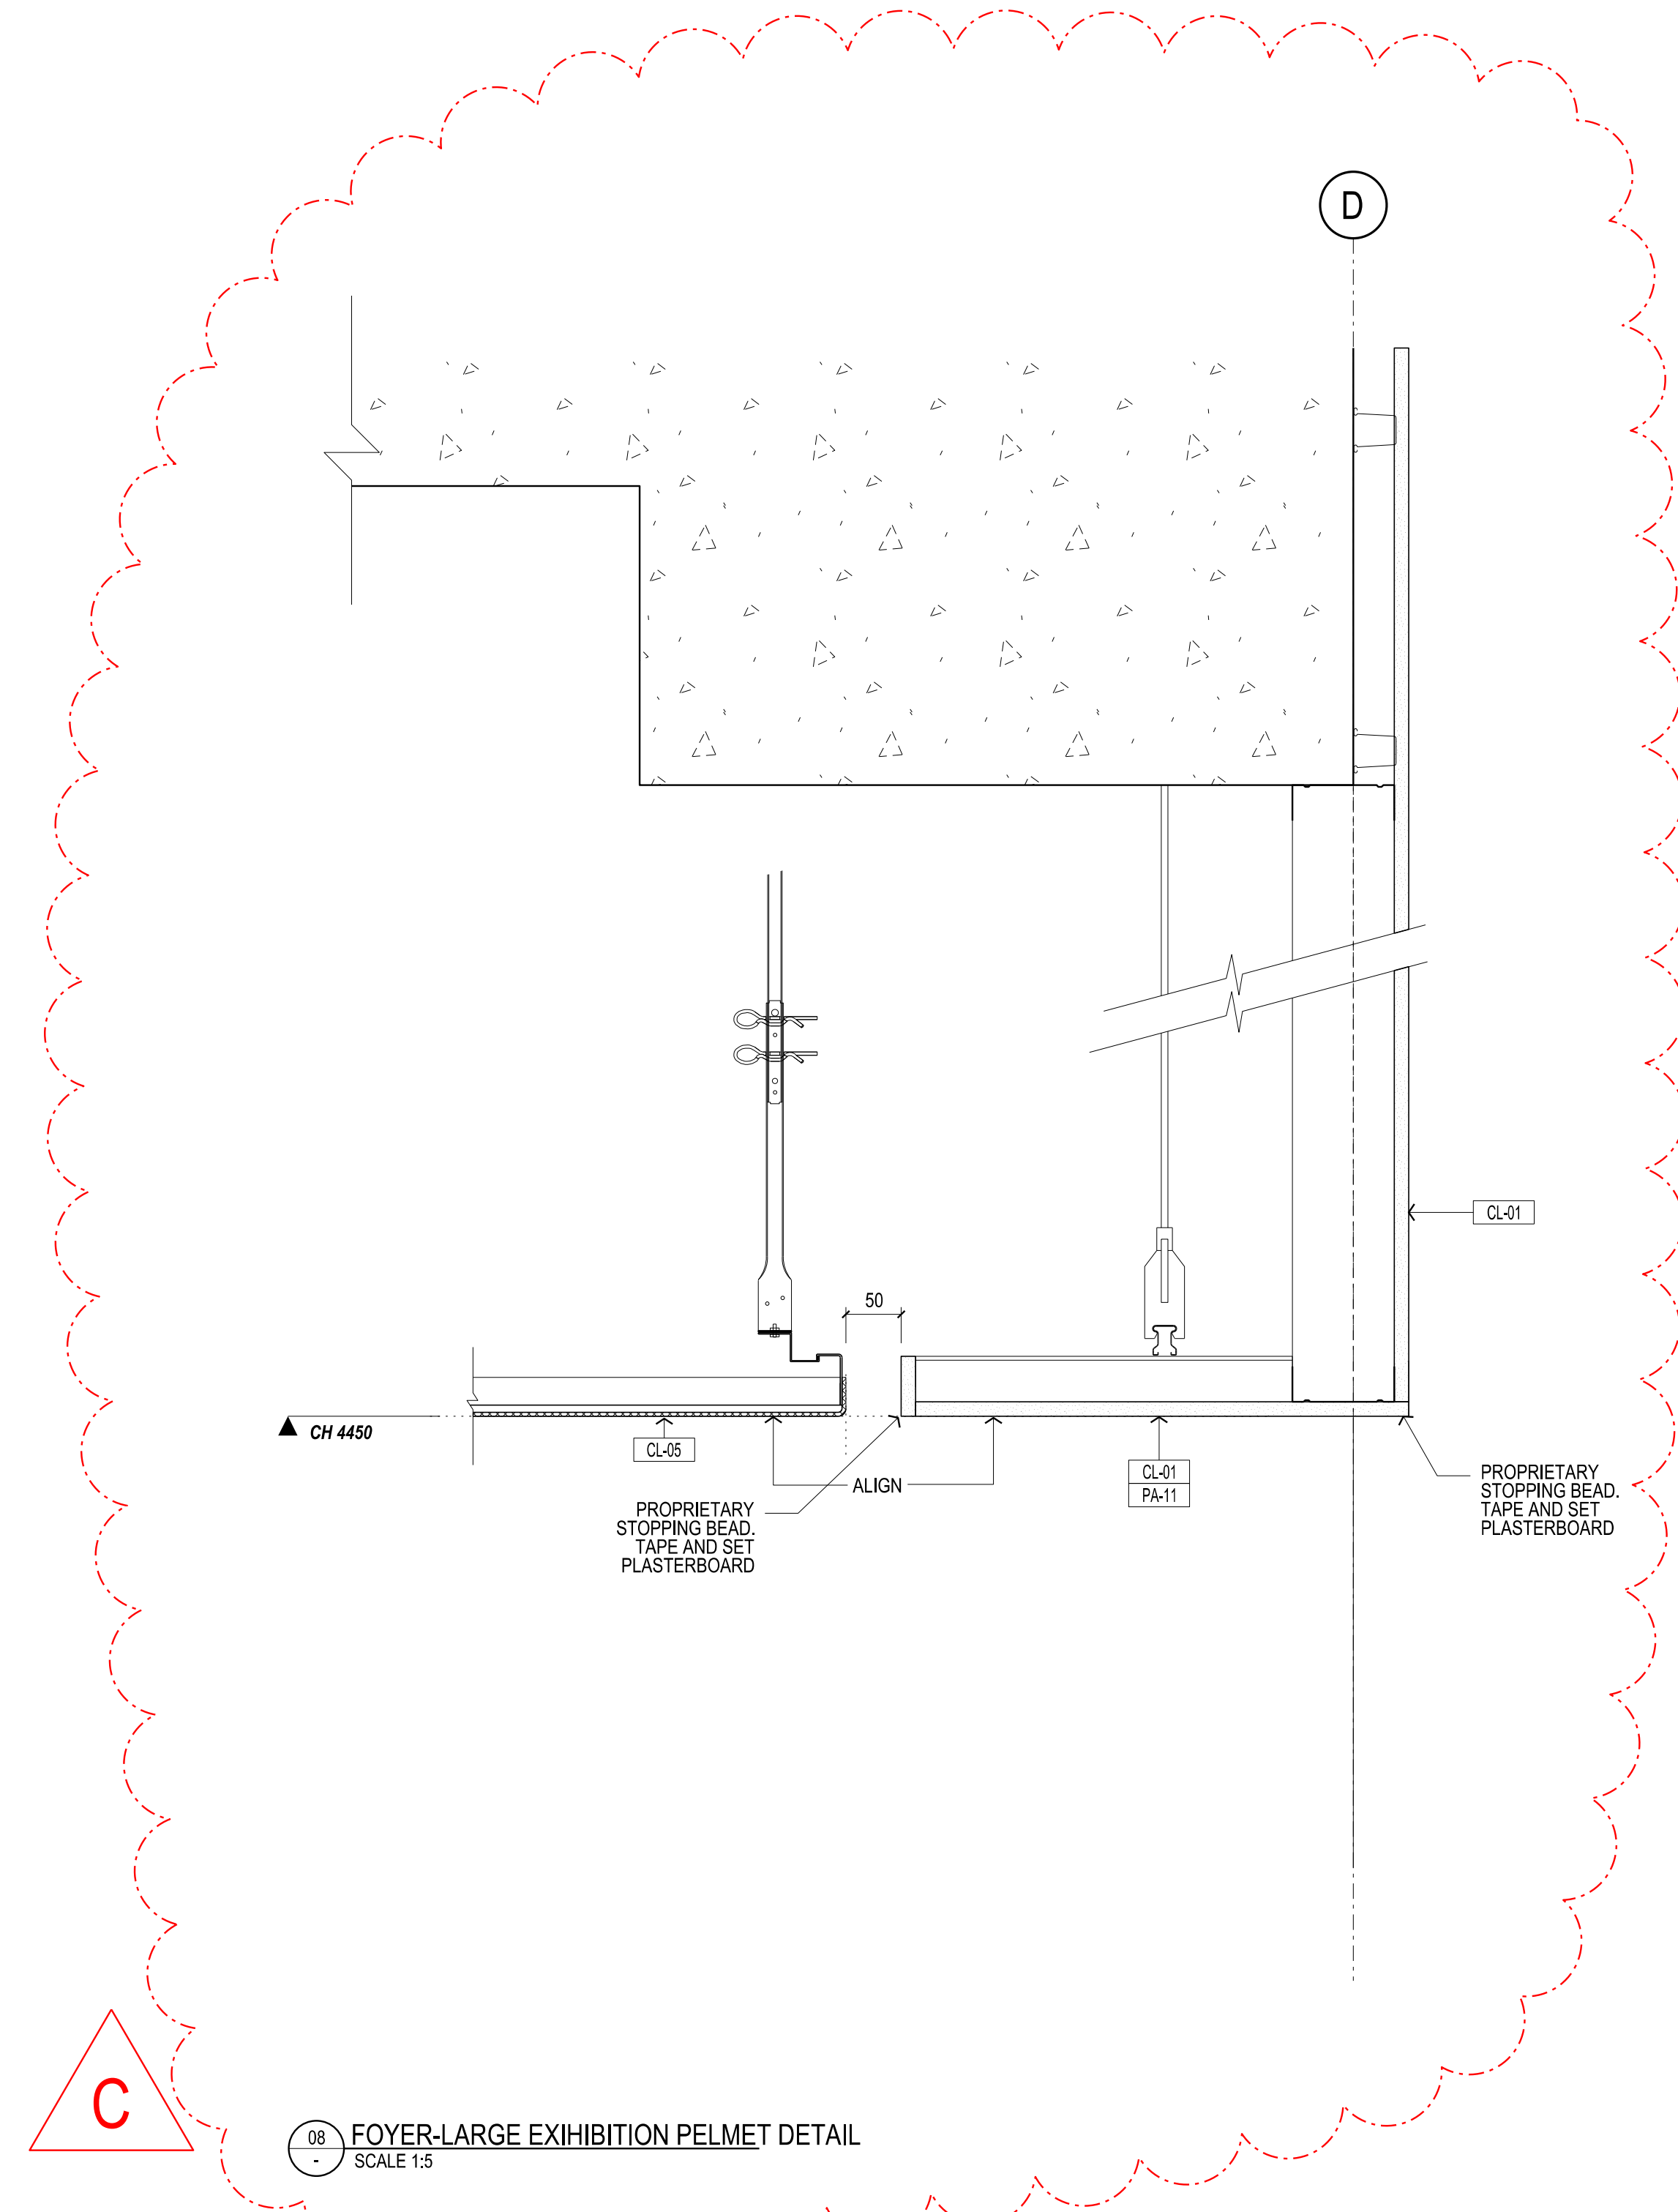
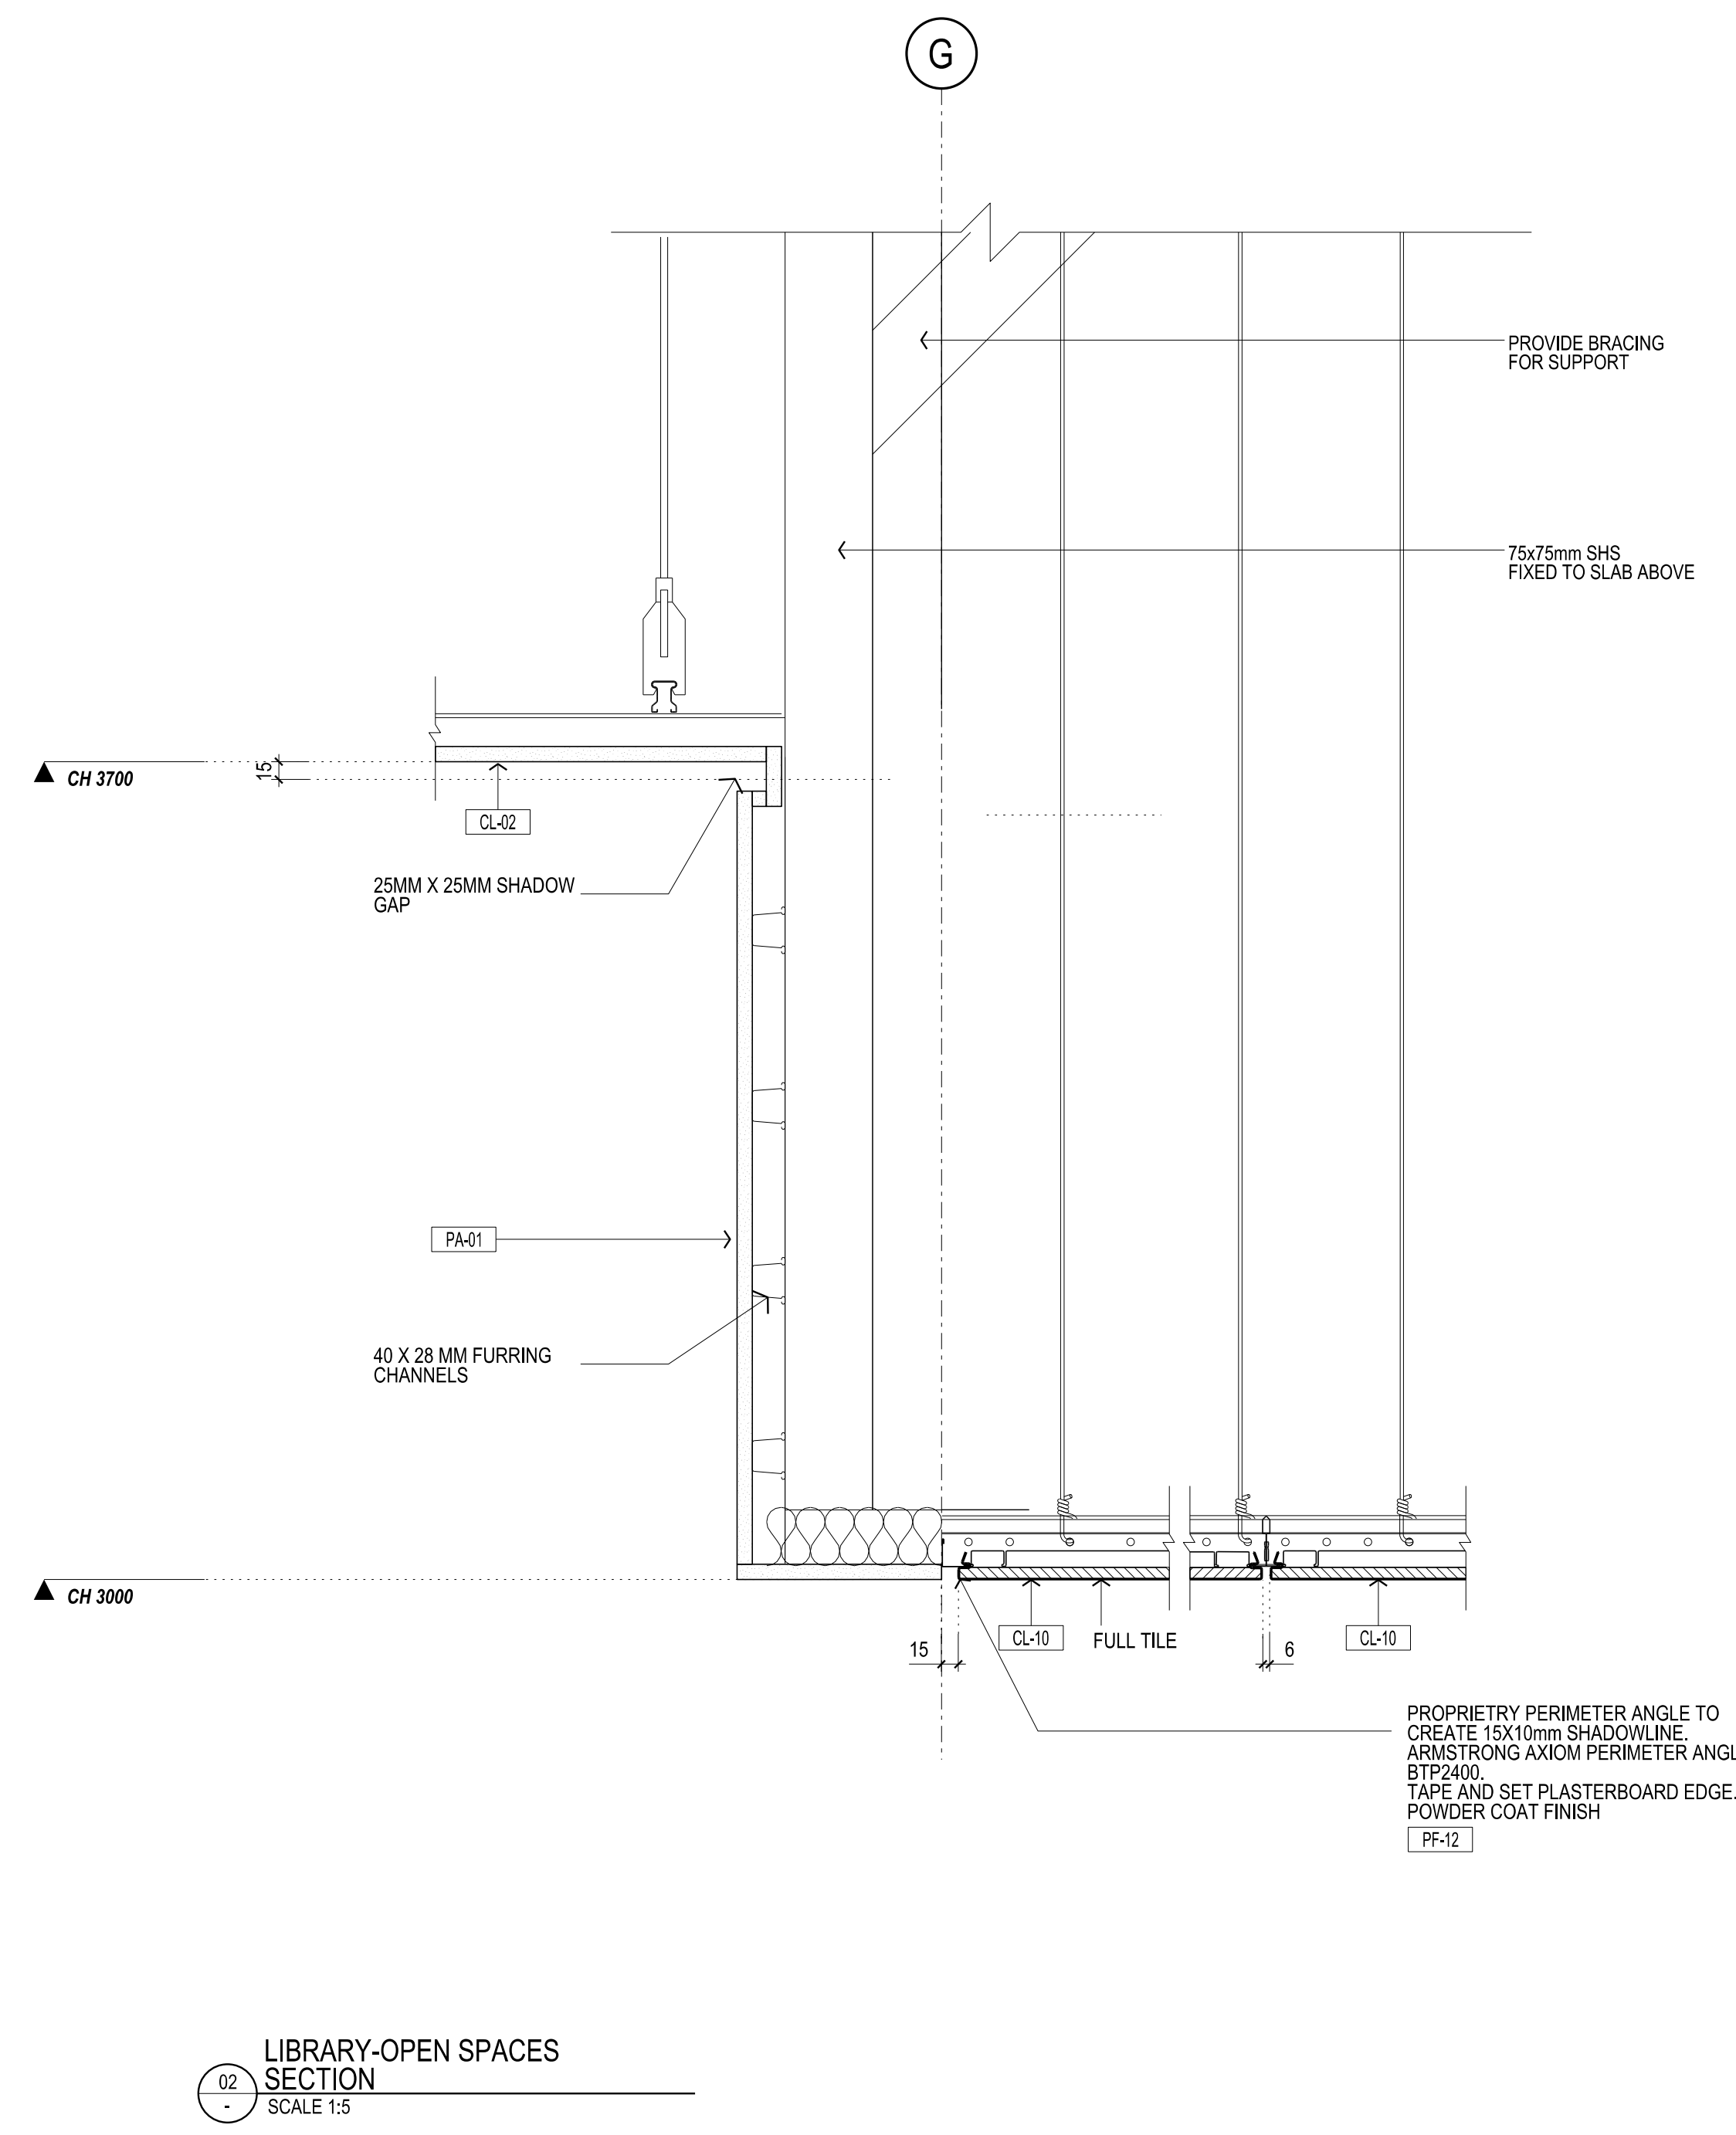


THIS DRAWING IS AN UNCONTROLLED COPY UNLESS STAMPED OTHERWISE

CONTRACTORS SHALL VERIFY JOB DIMENSIONS BEFORE ANY JOB COMMENCES. ALL SHOP DRAWINGS SHALL BE SUBMITTED TO THE SUPERINTENDENT AND MANUFACTURER SHALL NOT COMMENCE FROM THE RETURN OF DRAWINGS SHOWN BY THE CONSULTANT. DIMENSIONS SHALL TAKE PRECEDENCE OVER SCALES. THIS DRAWING SHOULD BE READ IN CONJUNCTION WITH ALL RELEVANT CONTRACT SPECIFICATIONS AND DRAWINGS COPYRIGHT OF THIS DRAWING IS VESTED IN WARDLE.

- General Notes
- CL-XX CEILING SYSTEM. REFER TO MATERIALS SCHEDULE
 - CH CEILING HEIGHT
 - FF-XX POWDERCOAT FINISH. REFER TO MATERIALS SCHEDULE
 - PA-XX PAINT FINISH. REFER TO MATERIALS SCHEDULE

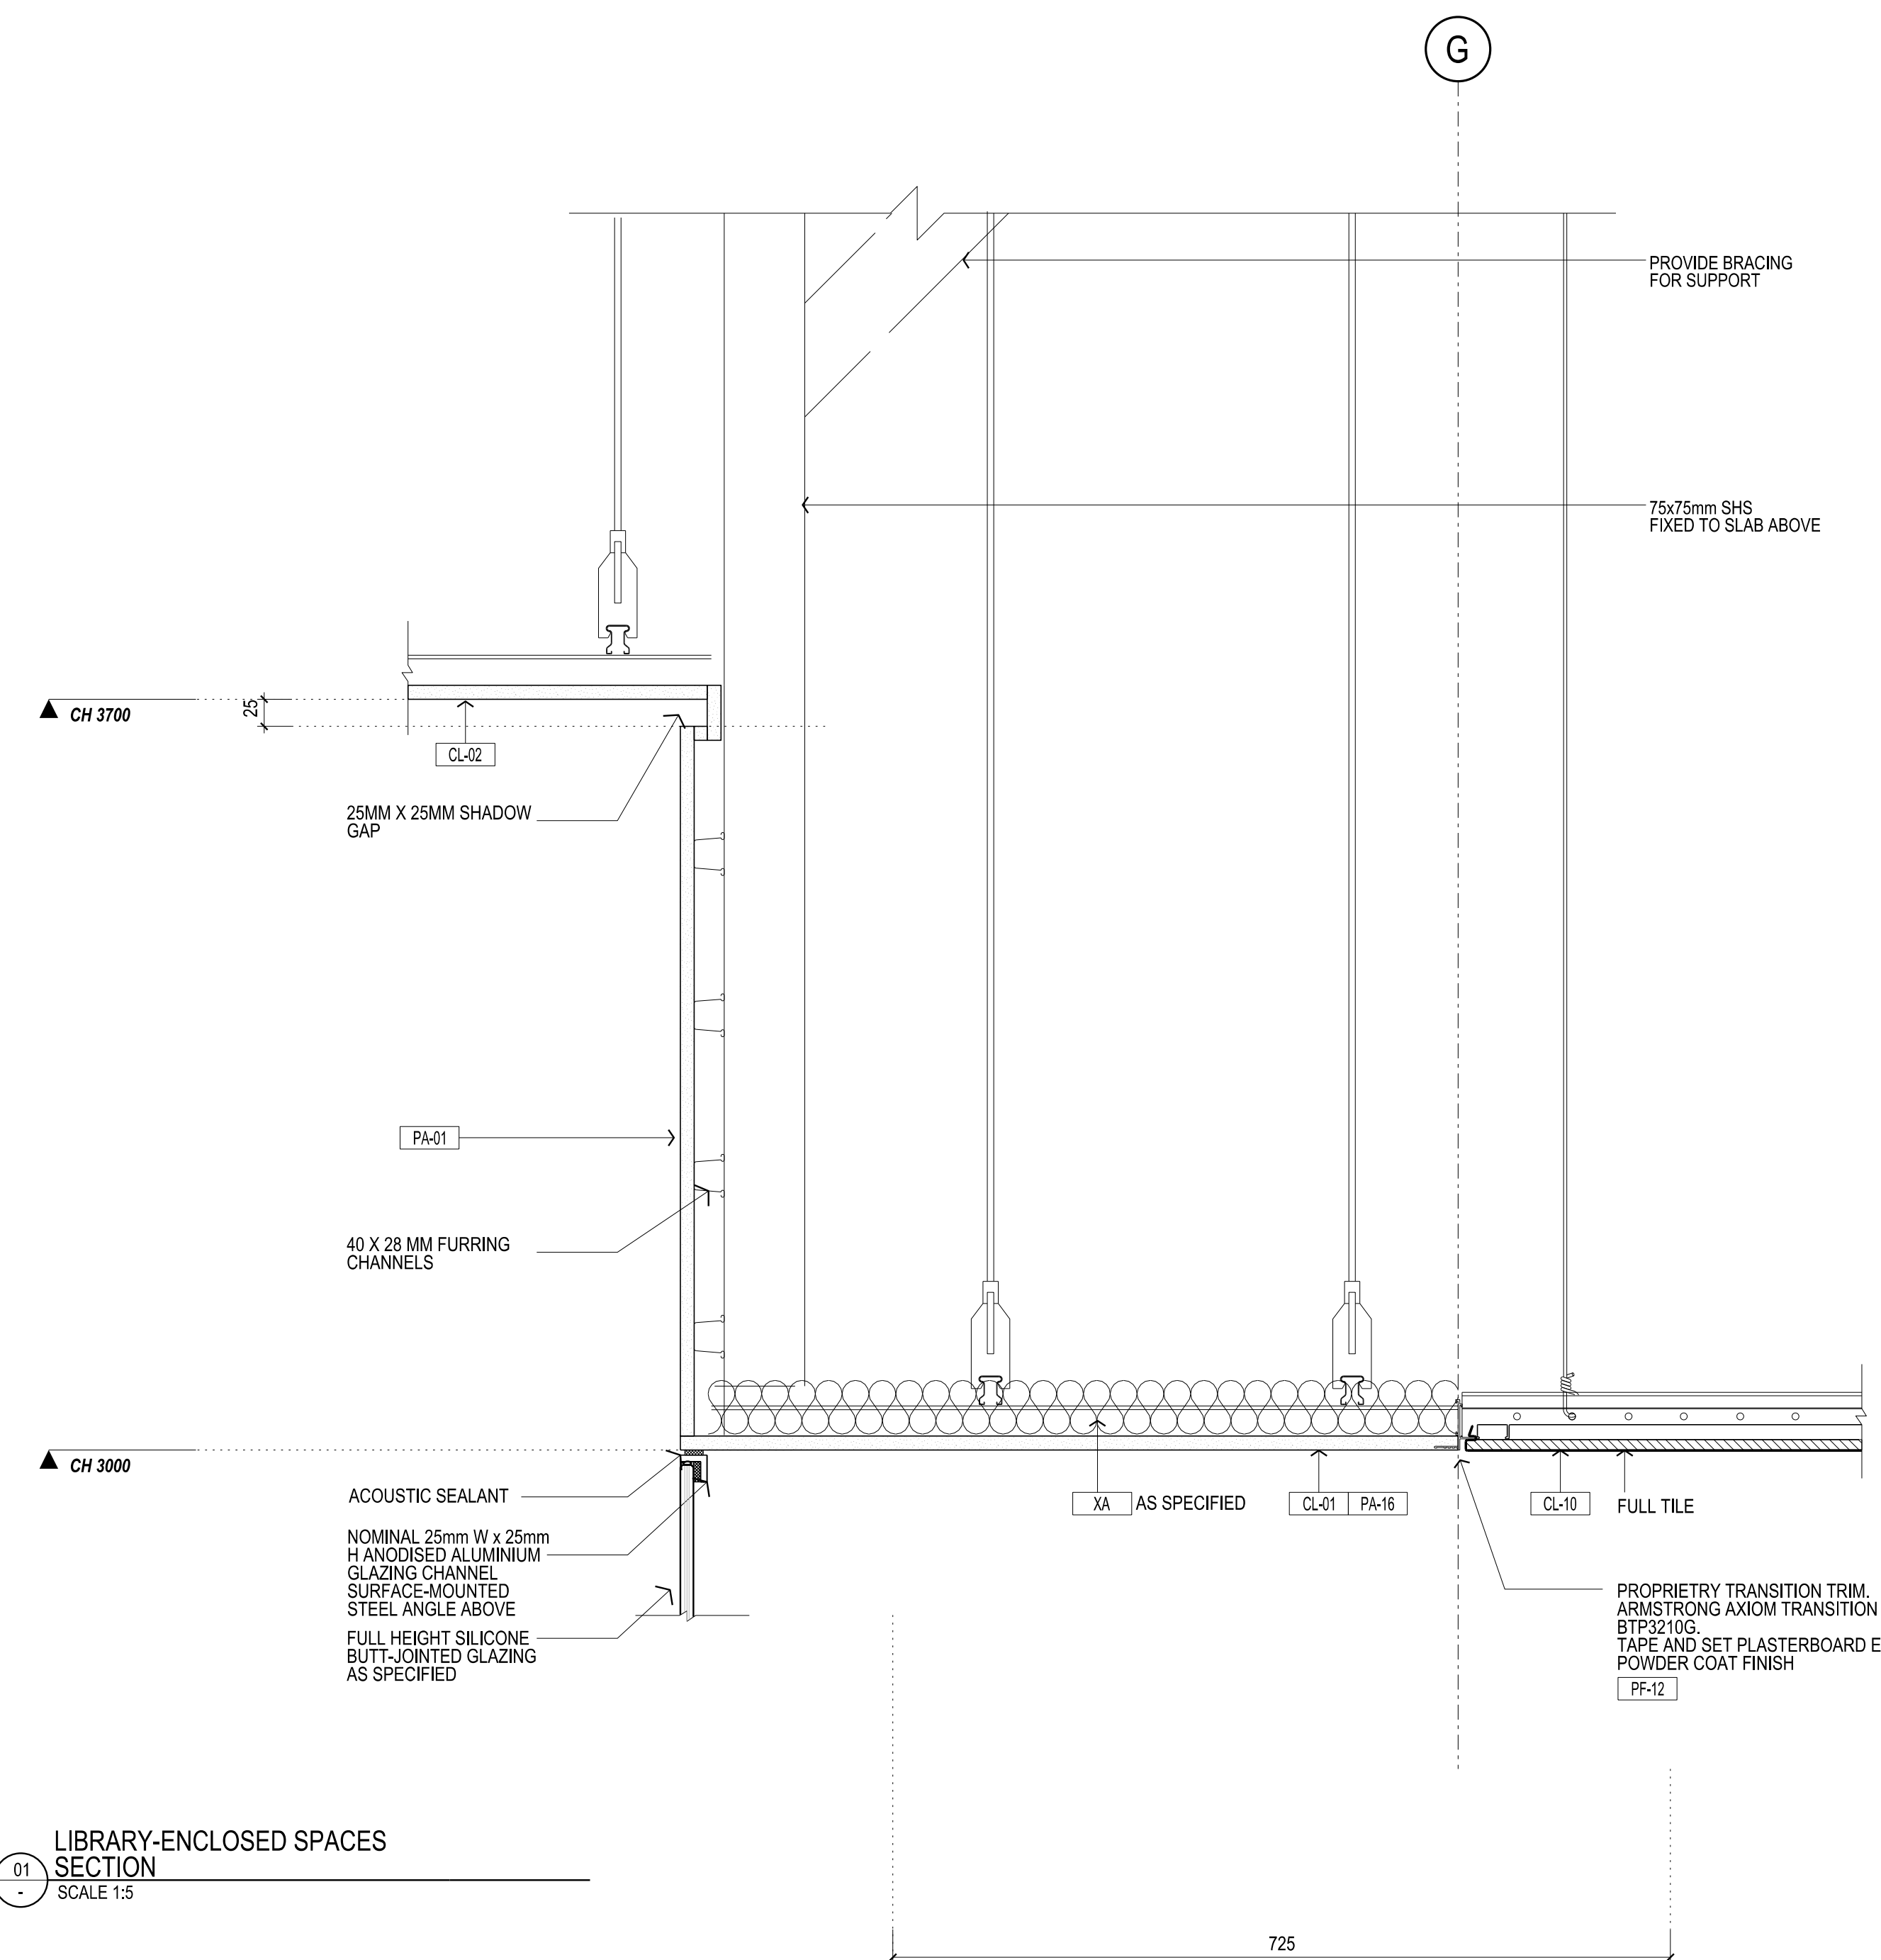

- NOTES
1. REFER TO 2000 SERIES DWGS FOR CEILING FINISHES & SETOUT
 2. REFER TO SERVICES CONSULTANTS DOCUMENTATION FOR SPECIFICATION OF FIXTURES & FITTINGS BELOW
 3. ENSURE ALL EMERGENCY LIGHT SMOKE DETECTOR LIGHT FITTING WIRES ARE RETICULATED TO SLAB. ALL WIRING TO BE SPRAYED OR PRECOLOURED TO MATCH ADJACENT CEILING. REFER TO MATERIALS SCHEDULE FOR DETAILS.
 4. ALL SERVICES TO BE POWDERCOATED OR PAINTED ON SITE TO MATCH CEILING COLOUR. REFER TO MATERIALS SCHEDULE FOR EXACT SPECIFICATION.
 5. TO BE READ IN CONJUNCTION WITH AR2000 CEILING PLANS AND WITH AR500 PACKAGE DETAILS AND AR500 WALL TYPES DRAWINGS

Rev	Issue	Revision Description	And	Date
C	SG	DETAIL ADDED	-	24.01.14
B	SG	RETURN AIR SLOT REMOVED	-	23.01.14
A	SG	UPDATES TO DETAILS AS CLOUDED	-	17.09.13
03	SG	UPDATES TO MATERIAL CODES	-	23.08.13
02	SG	100% CD ISSUE	-	07.09.12
01	SG	90% CD ISSUE	-	10.08.12



NADAAA
 NADAAA
 1520 Washington Street No. 2 Boston Massachusetts 02118 USA
 Telephone: +1 817 442 8232
 Facsimile: +1 888 442 1417
 Email: nad@nadaaa.com

John Wardle Architects
 25 Rokeby Street, Collingwood, Victoria 3066 Australia
 Tel: +61 3 8662 0400 www.johnwardlearchitects.com
 © 2014 John Wardle Architects ABN 83 006 814 268

Client: University of Melbourne Parkville Campus

Project: Faculty of Architecture Building and Planning

Title: CEILING JUNCTION DETAILS

Project No.	0913	Scale	1:5 @ A0 1:10 @ A2
Drawing No.	AR 7855	Revision	C

Date: Dec 2011 Drawn: Co-Ord: Check:

FILENAME - SFILES

FOR CONSTRUCTION