



03

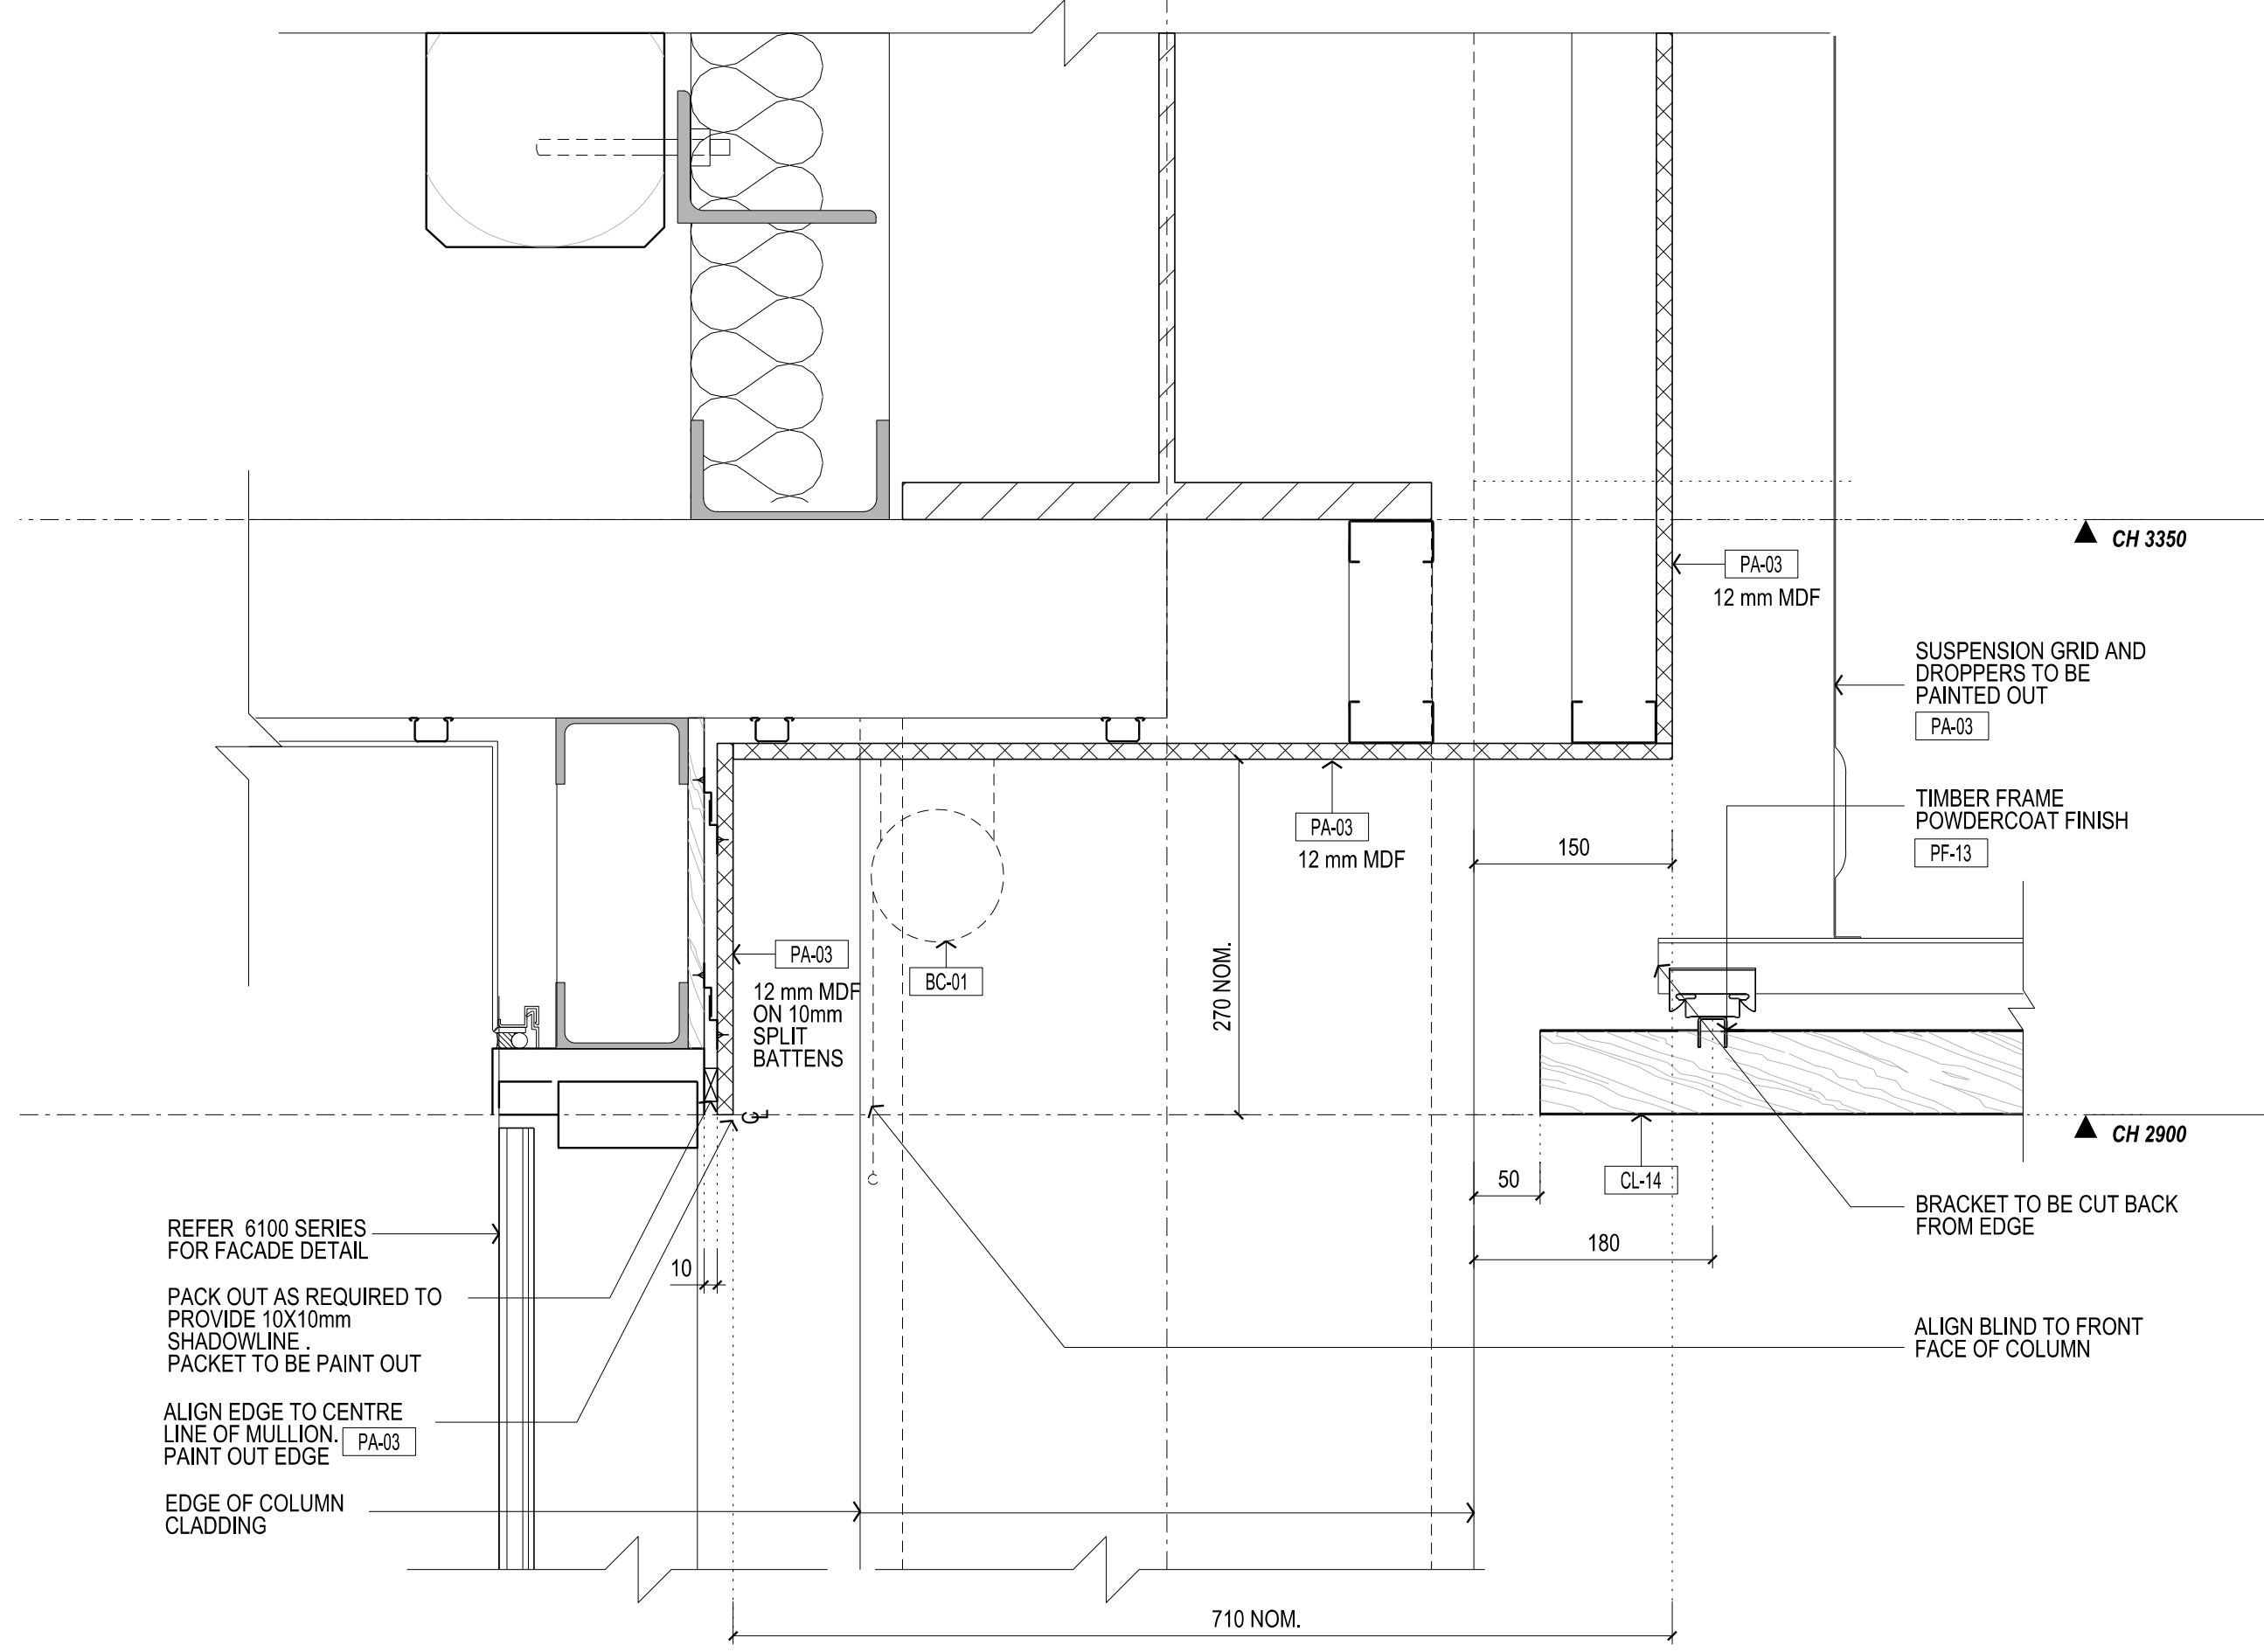


03 LEVEL 4-CORRIDOR- PELMET DETAIL-TYPICAL SECTION SCALE 1:5

03

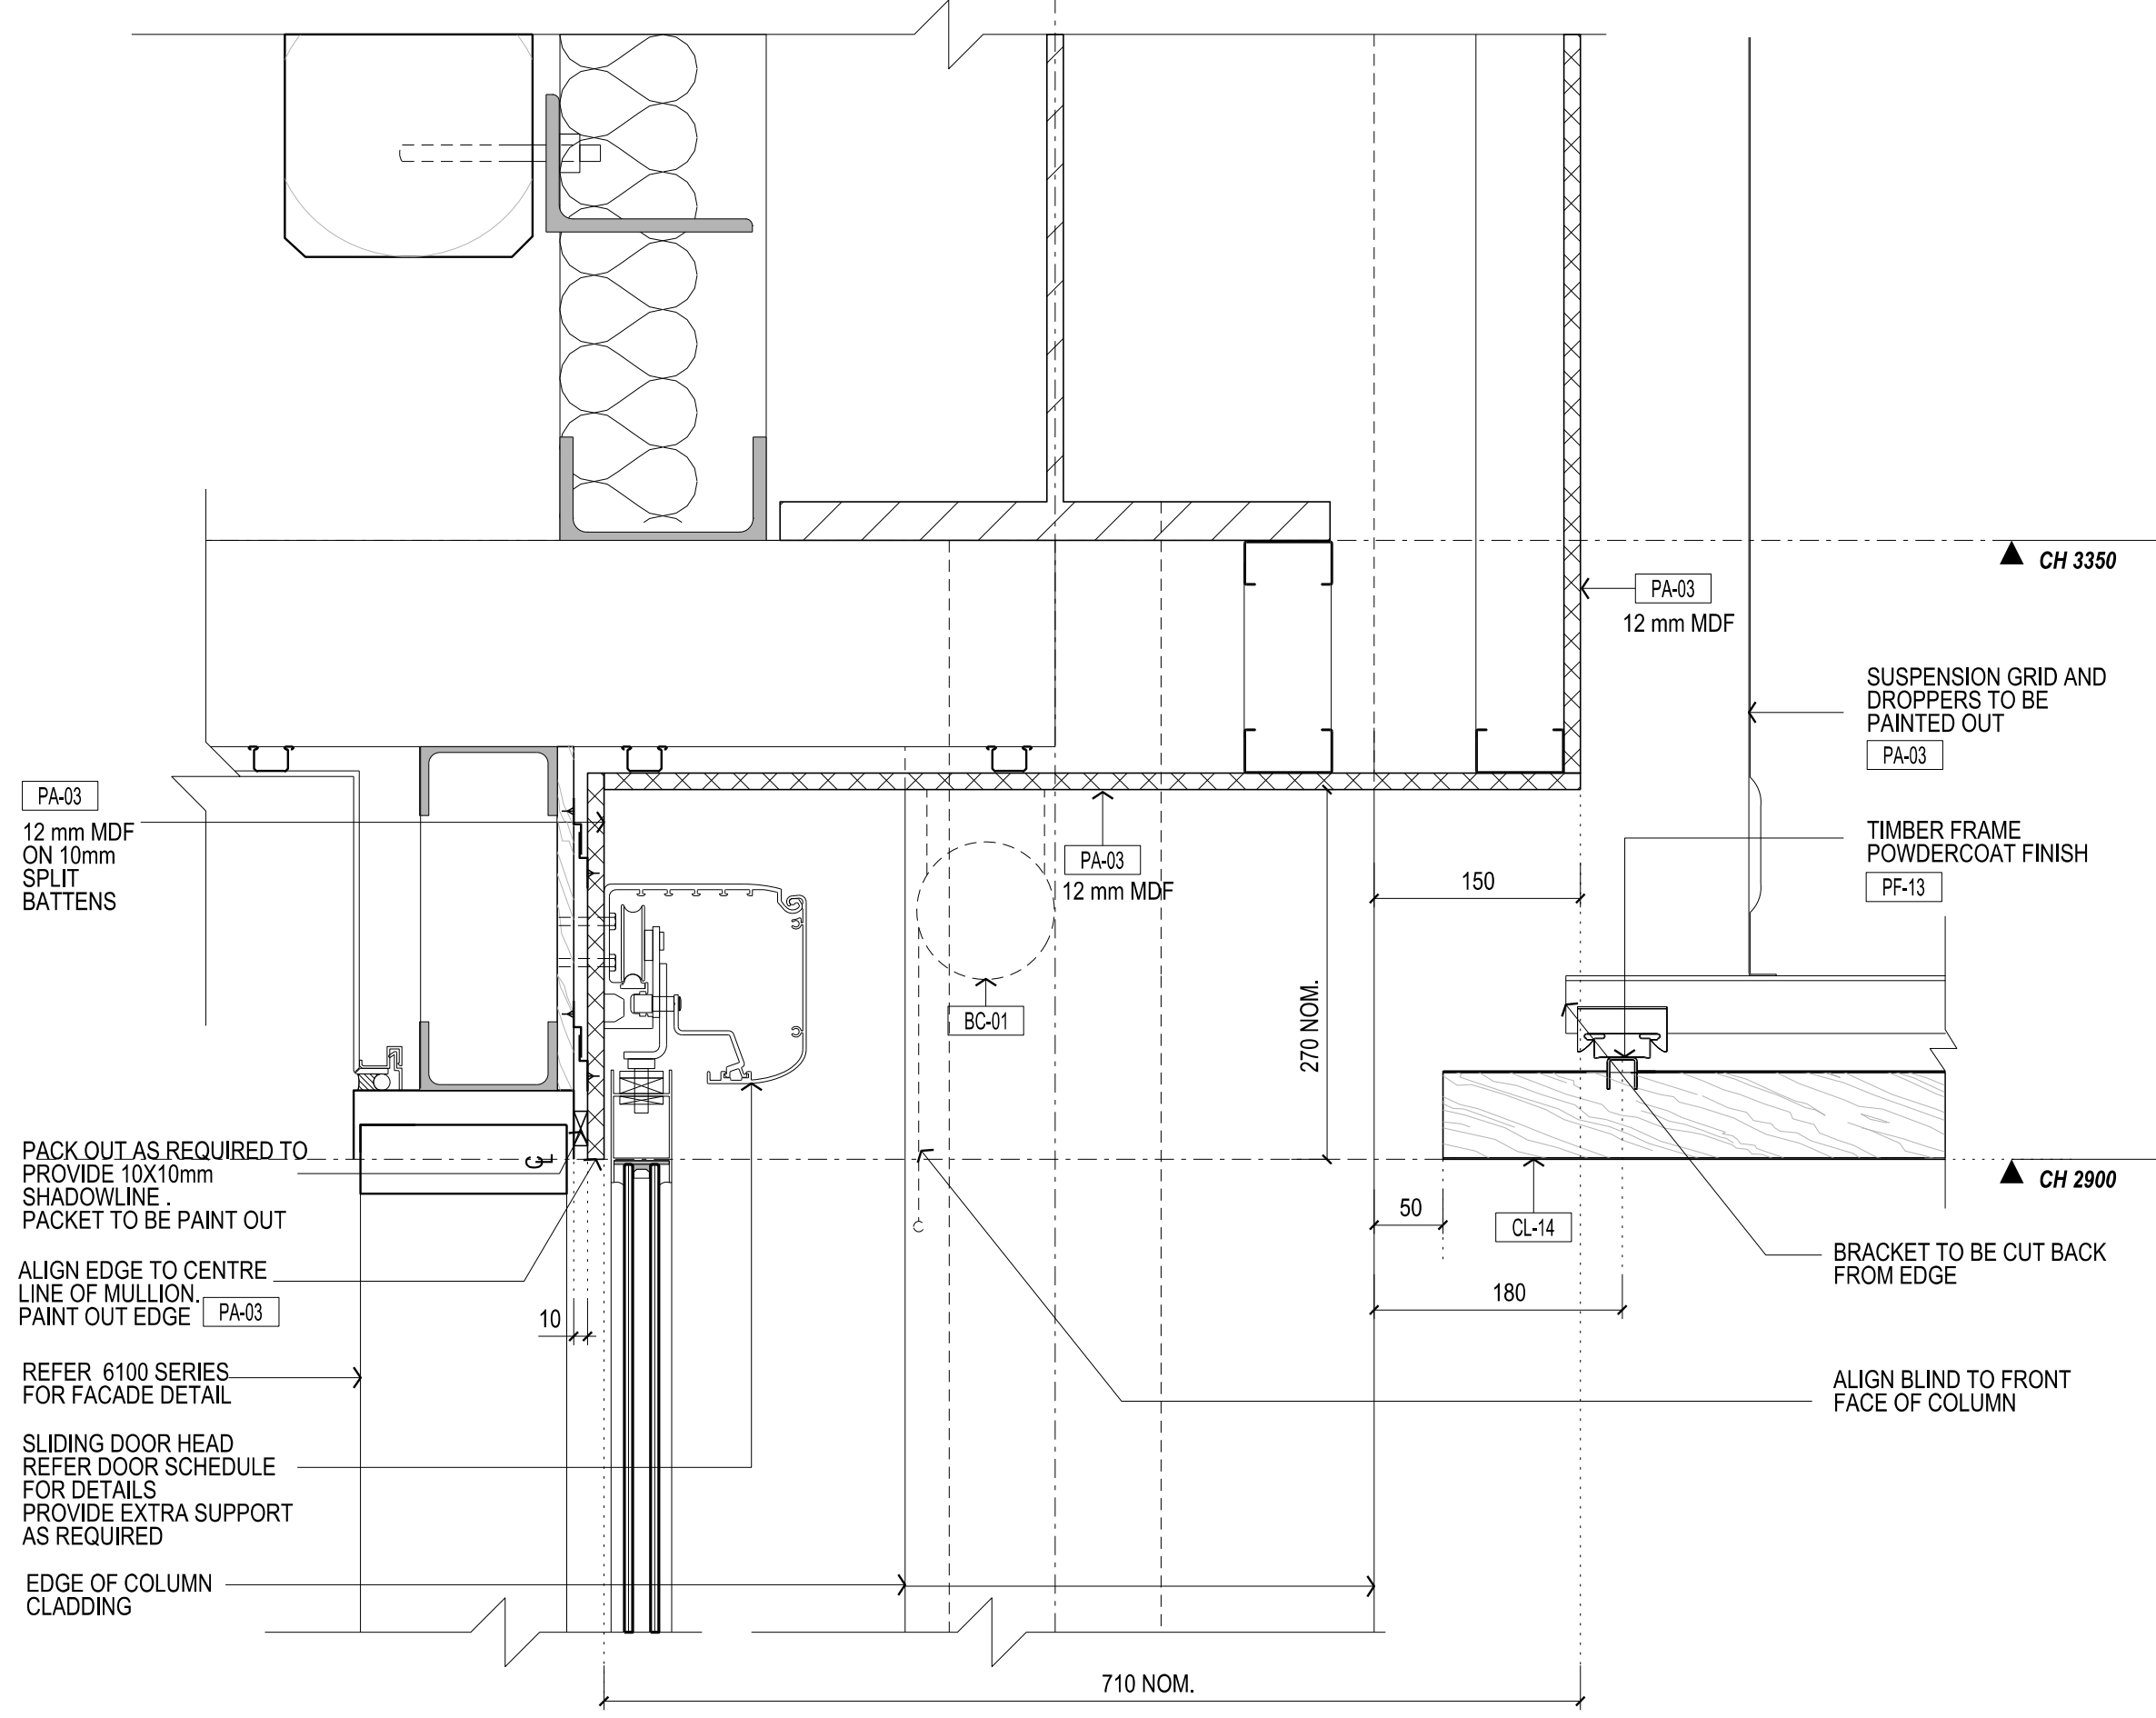

03 LEVEL 4-CORRIDOR- SLIDING DOOR PELMET DETAIL SECTION SCALE 1:5

04

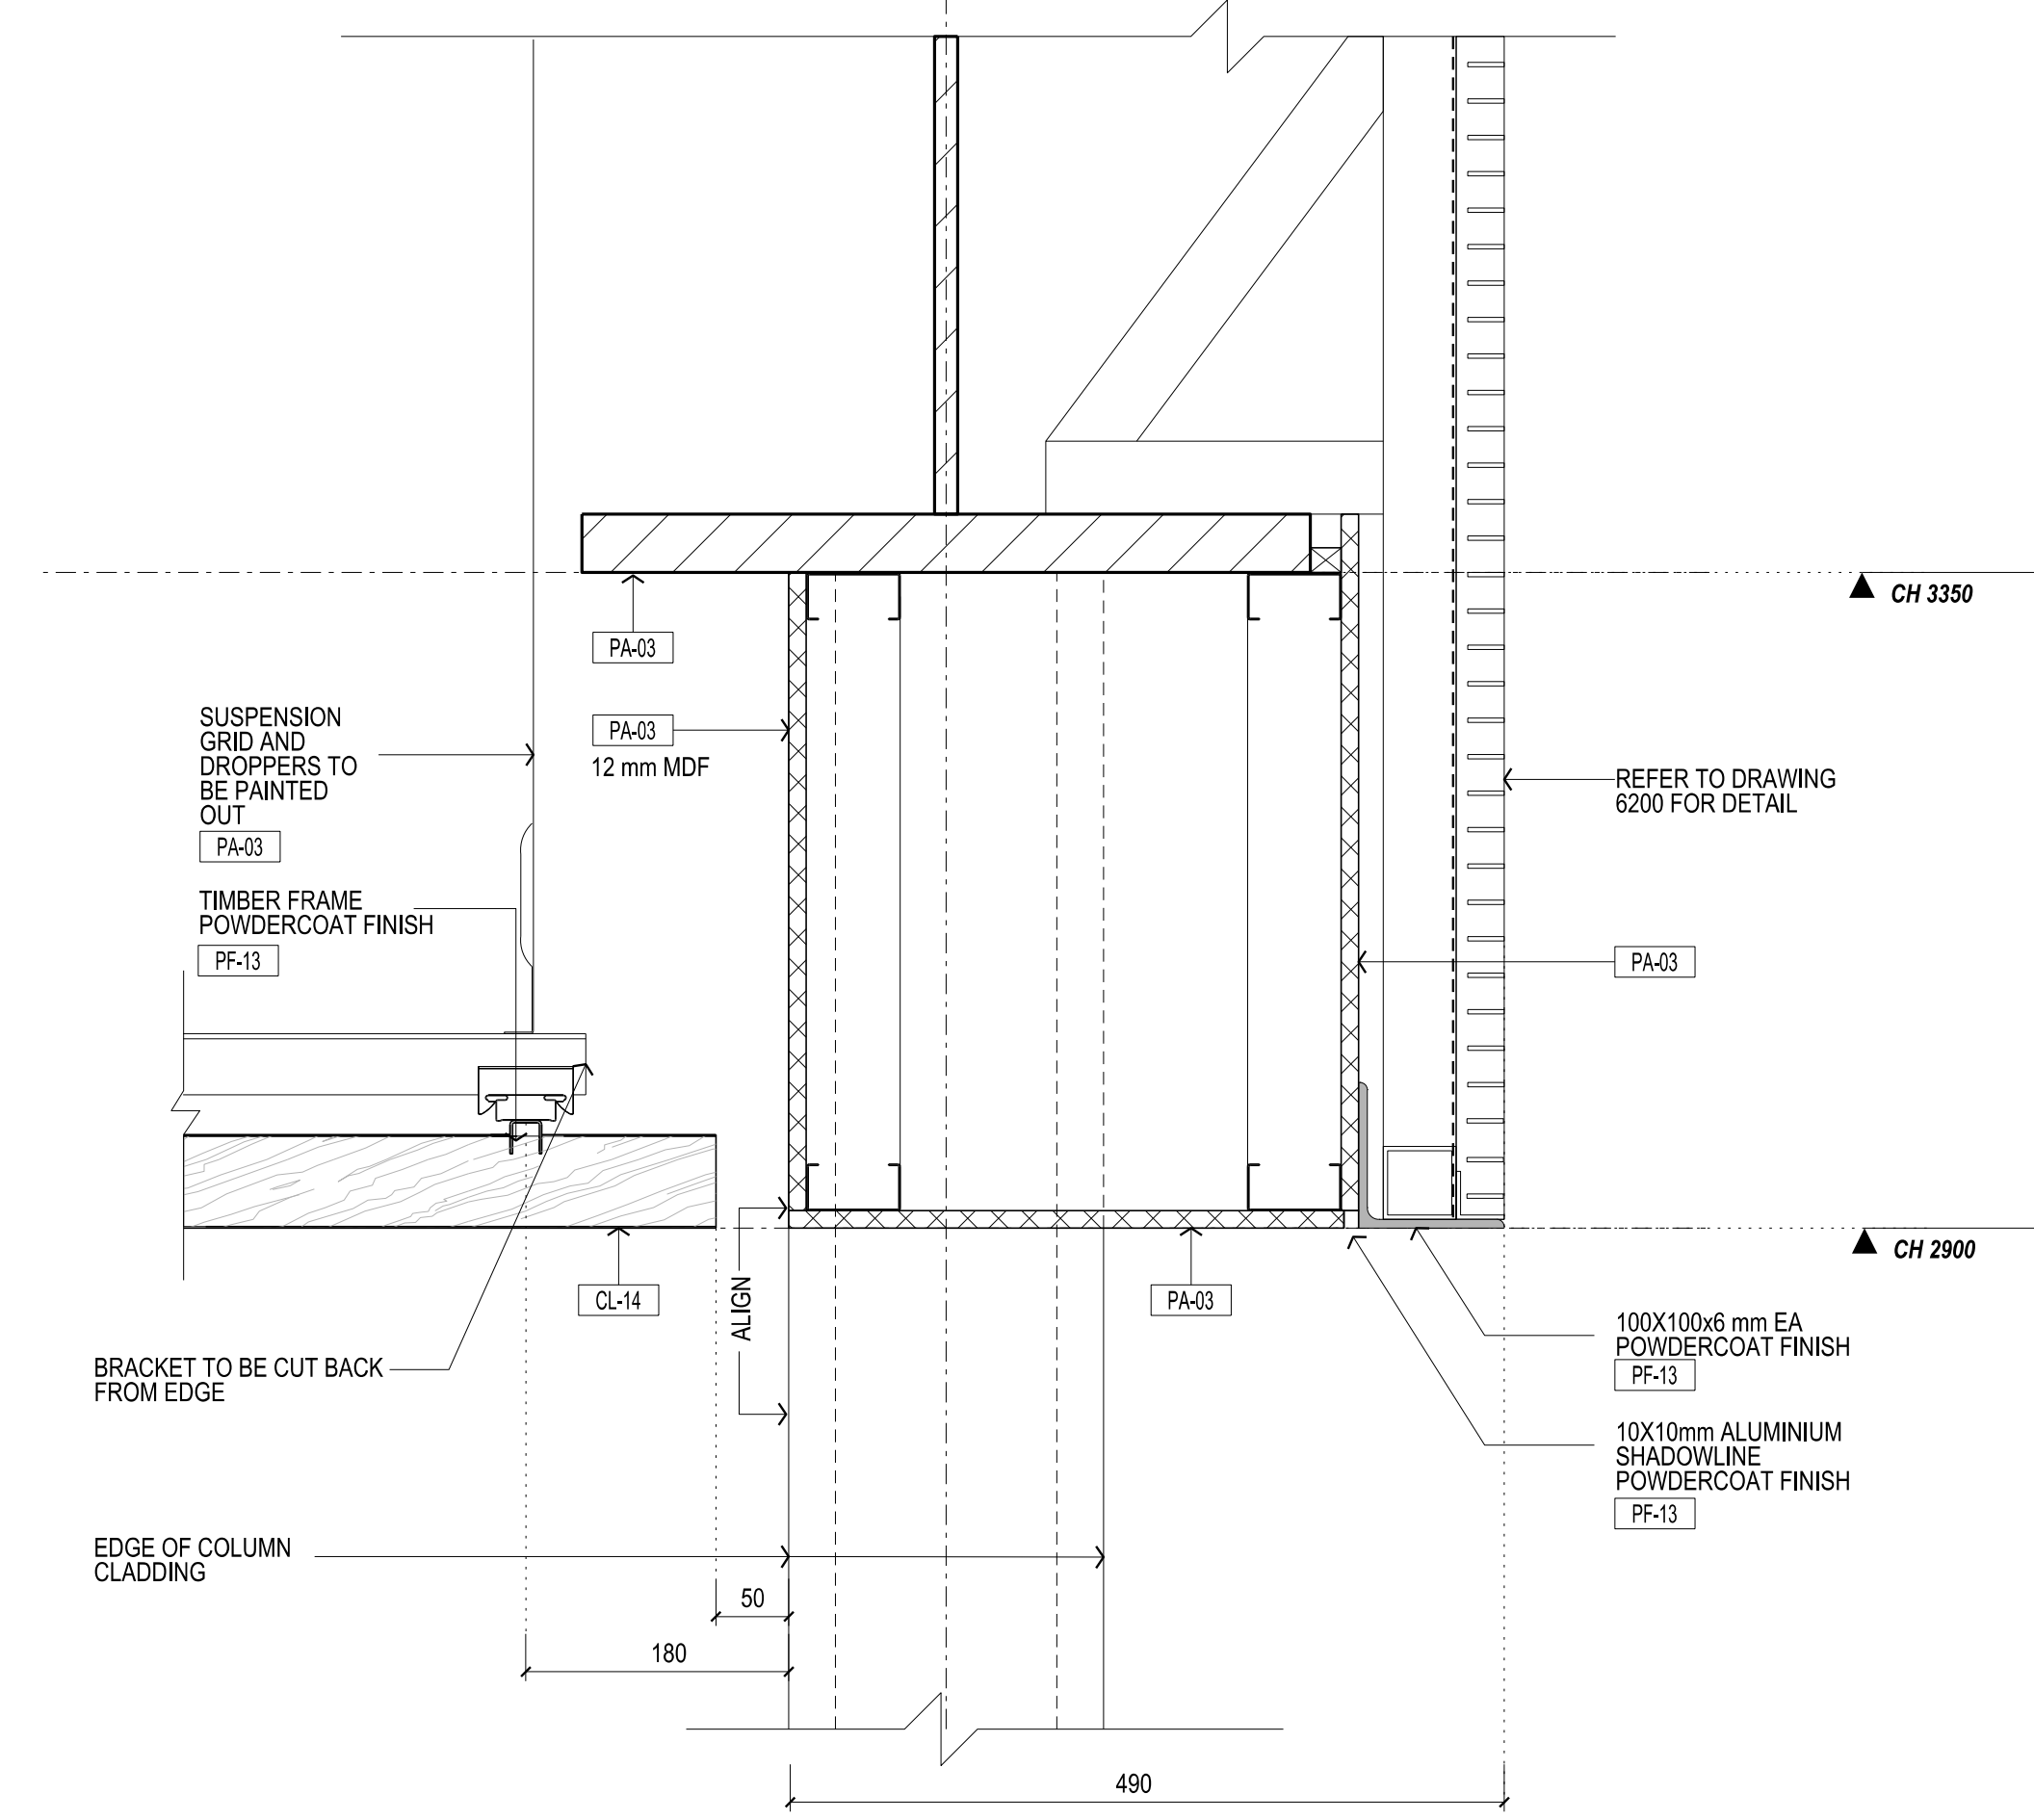

04 LEVEL 4-CORRIDOR- PELMET DETAIL - TYPICAL SECTION SCALE 1:5

THIS DRAWING IS AN UNCONTROLLED COPY UNLESS STAMPED OTHERWISE

CONTRACTORS SHALL VERIFY JOB DIMENSIONS BEFORE ANY JOB COMMENCES. ALL SHOP DRAWINGS SHALL BE SUBMITTED TO THE SUPERINTENDENT AND MANUFACTURER SHALL NOT COMMENCE FROM THE RETURN OF DRAWINGS UNLESS APPROVED BY THE CONSULTANT. DIMENSIONS SHALL TAKE PRECEDENCE OVER SCALES. THIS DRAWING SHALL BE READ IN CONJUNCTION WITH ALL RELEVANT CONTRACT SPECIFICATIONS AND DRAWINGS COPYRIGHT OF THIS DRAWING IS VESTED IN WARDLE.


General Notes

- CL-XX CEILING SYSTEM. REFER TO MATERIALS SCHEDULE
- CH CEILING HEIGHT
- FF-XX POWDERCOAT FINISH. REFER TO MATERIALS SCHEDULE
- PA-XX PAINT FINISH. REFER TO MATERIALS SCHEDULE


NOTES

- REFER TO 2000 SERIES DWGS FOR CEILING FINISHES & SETOUT
- REFER TO SERVICES CONSULTANTS DOCUMENTATION FOR SPECIFICATION OF FIXTURES & FITTINGS BELOW
- ENSURE ALL EMERGENCY LIGHT SMOKE DETECTOR LIGHT FITTING WIRES ARE RETICULATED TO SLAB. ALL WIRING TO BE SPREAD OR PRE-COLOURED TO MATCH ADJACENT CEILING. REFER TO MATERIALS SCHEDULE FOR DETAILS.
- ALL SERVICES TO BE POWDERCOATED OR PAINTED ON SITE TO MATCH CEILING COLOUR. REFER TO MATERIALS SCHEDULE FOR EXACT SPECIFICATION.
- TO BE READ IN CONJUNCTION WITH AR2000 CEILING PLANS AND WITH AR6100 FACADE DETAILS AND AR5100 WALL TYPES DRAWINGS


Rev	Issue	Revision Description	And	Date
B	SG	UPDATES AS CLOUDED	-	21.01.14
A	SG	ISSUED FOR CONSTRUCTION	-	10.01.14
02	SG	100% CD - TENDER ISSUE - UPDATE	-	12.09.12
01	SG	100% CD - TENDER ISSUE	-	07.09.12

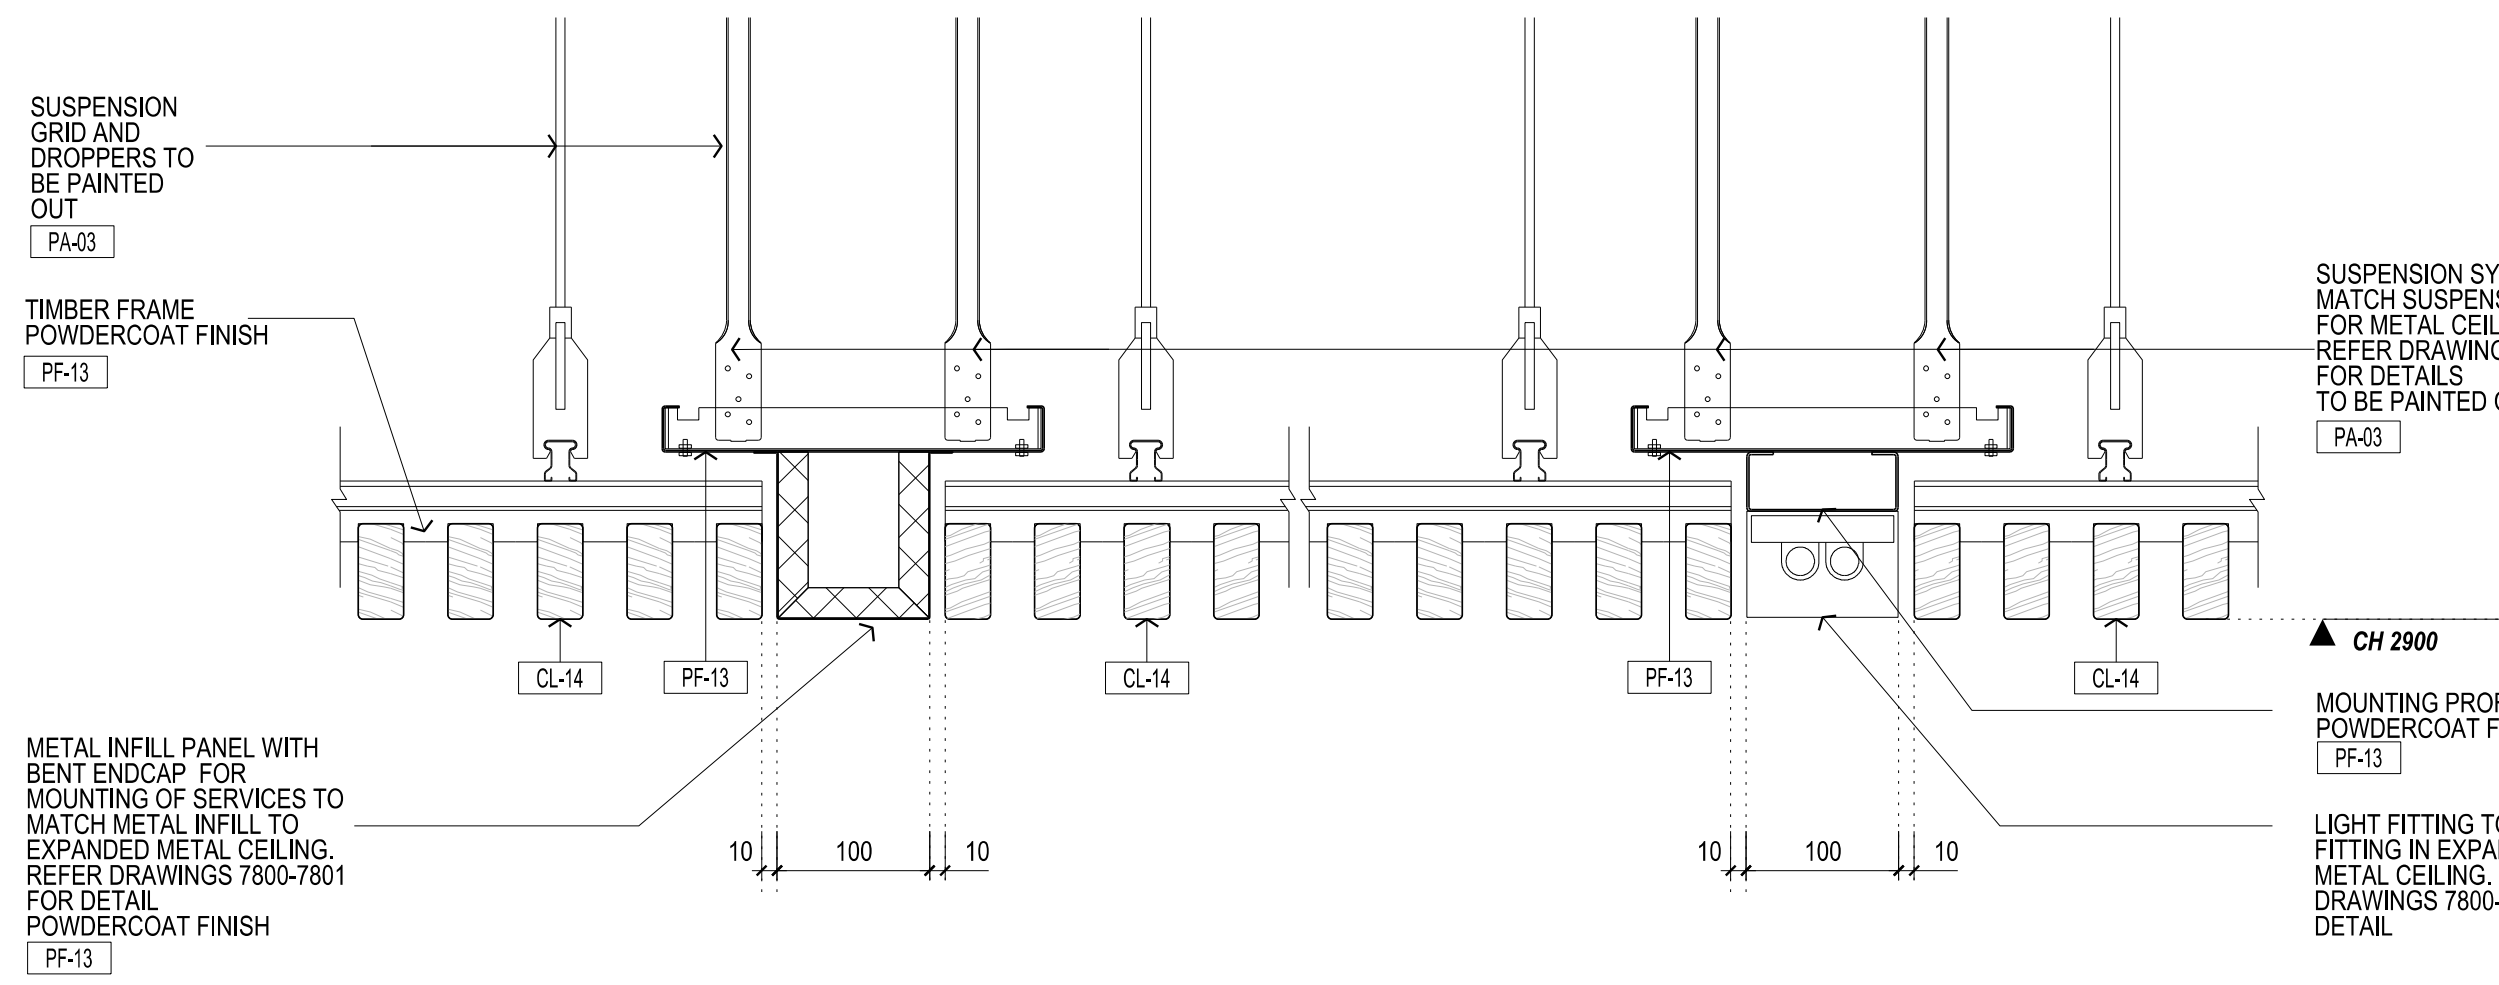


04 TIMBER CEILING - SERVICES DETAIL SECTION SCALE 1:5

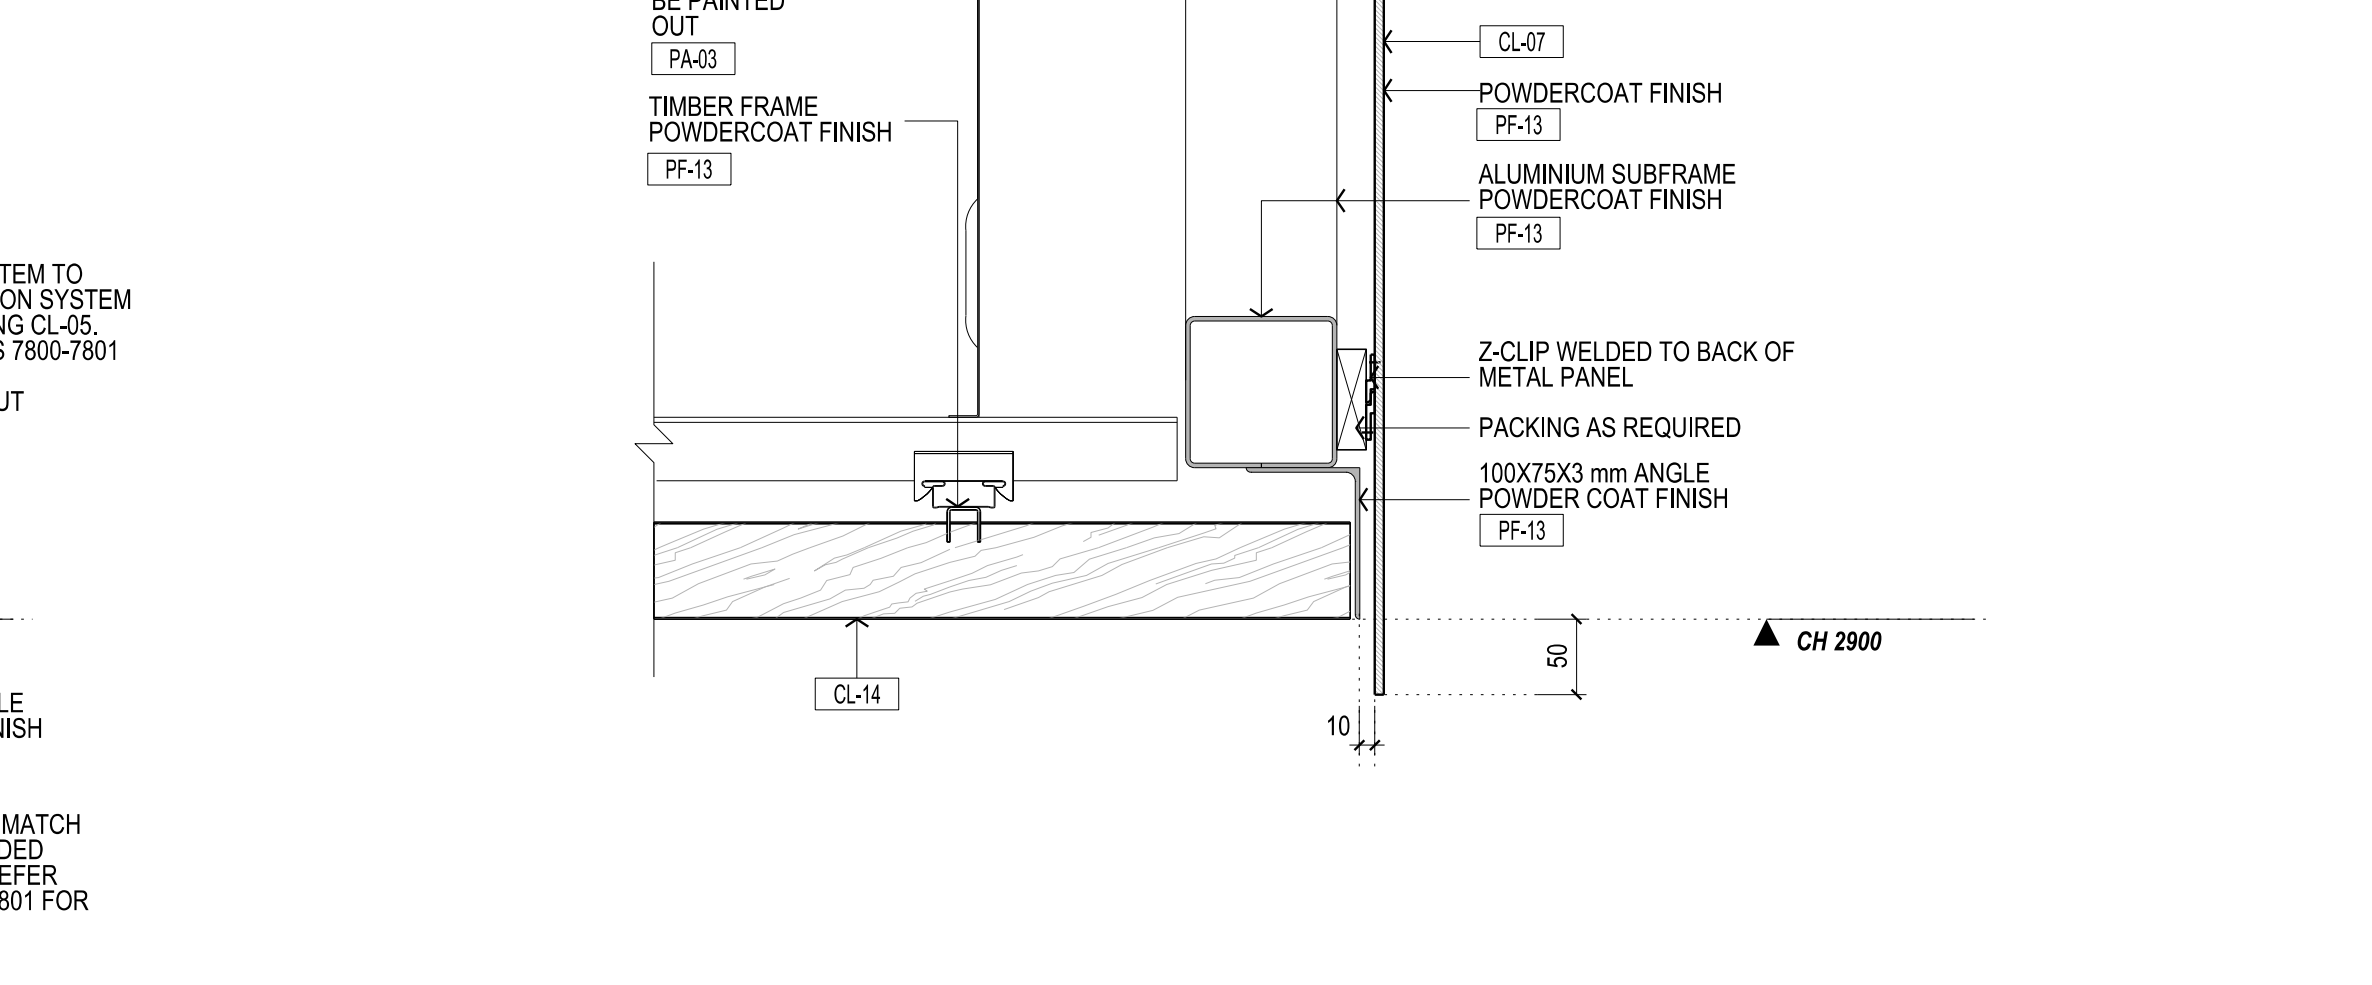


05 TIMBER CEILING CL-14 TO ALUMINIUM PANEL CL-07 SECTION SCALE 1:5

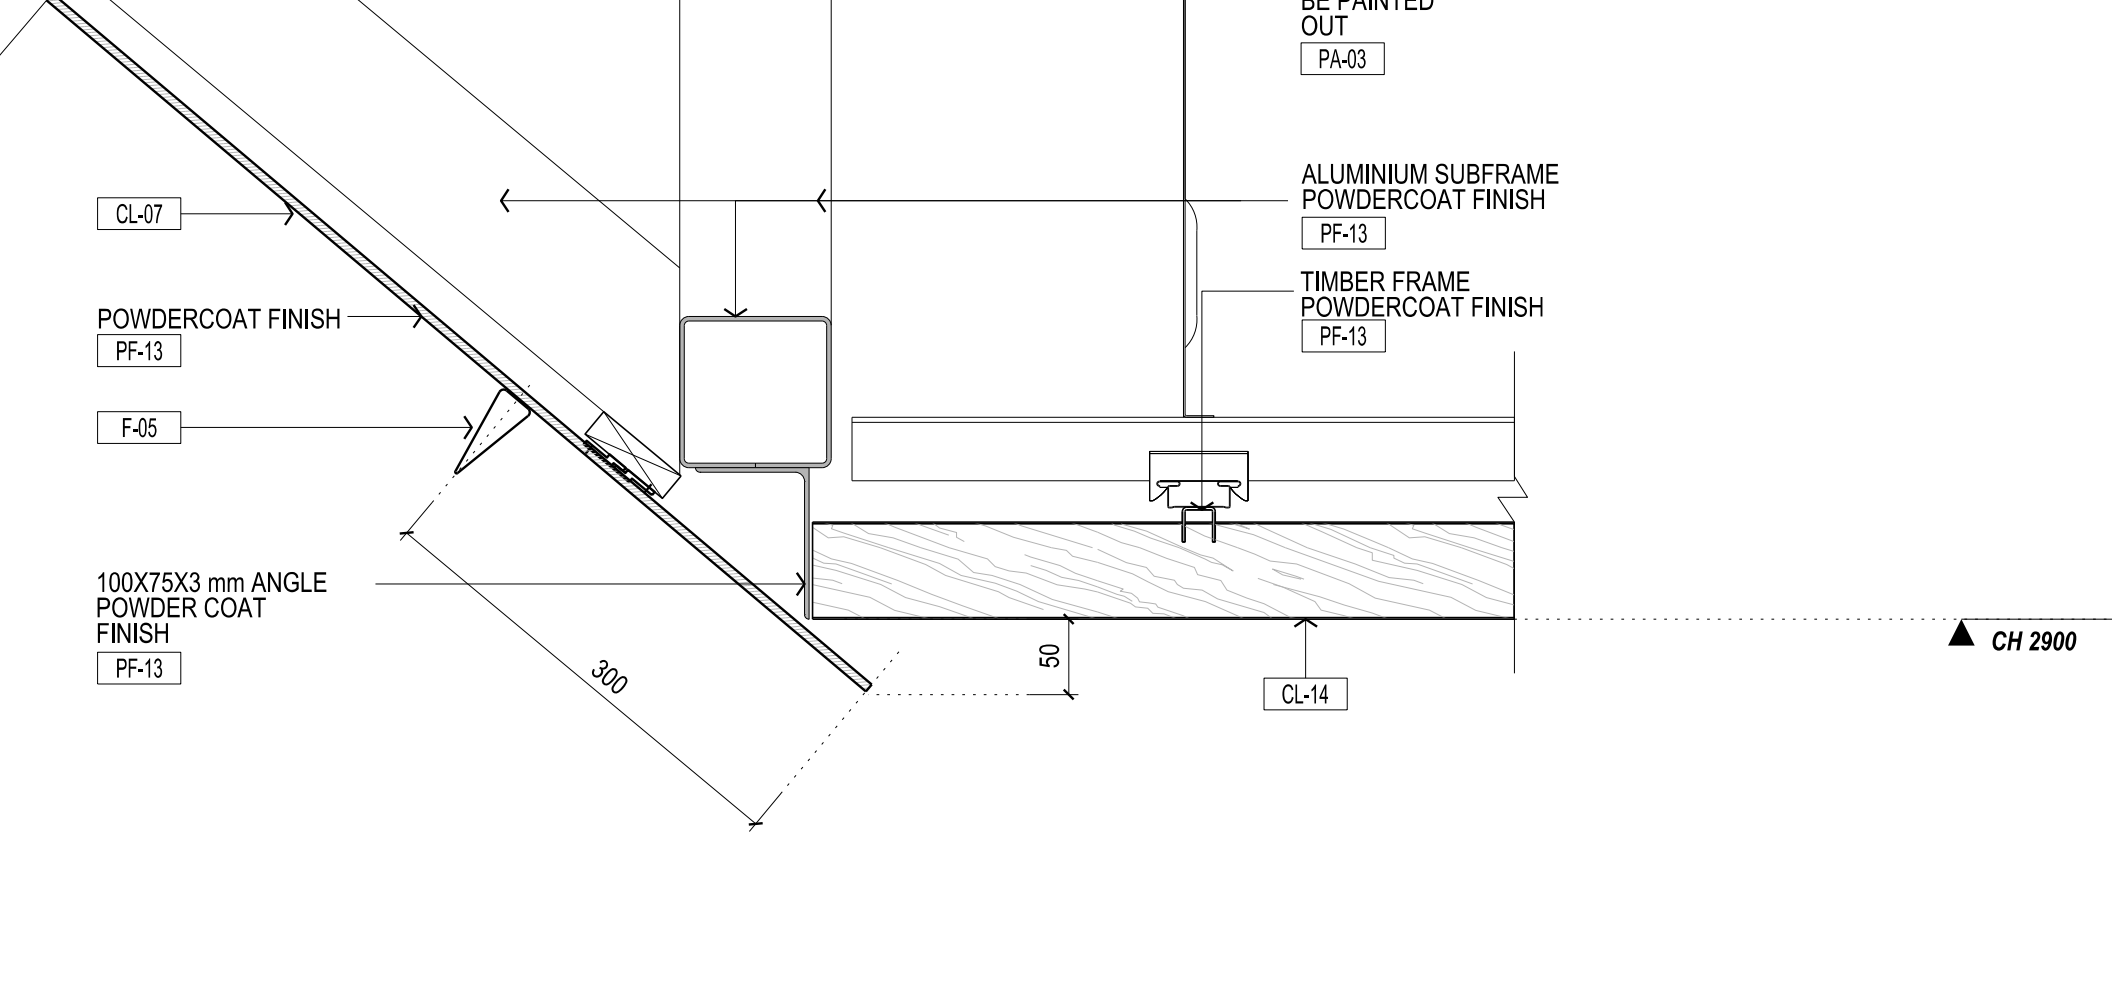


06 TIMBER CEILING CL-14 TO ALUMINIUM PANEL CL-07 SECTION SCALE 1:5

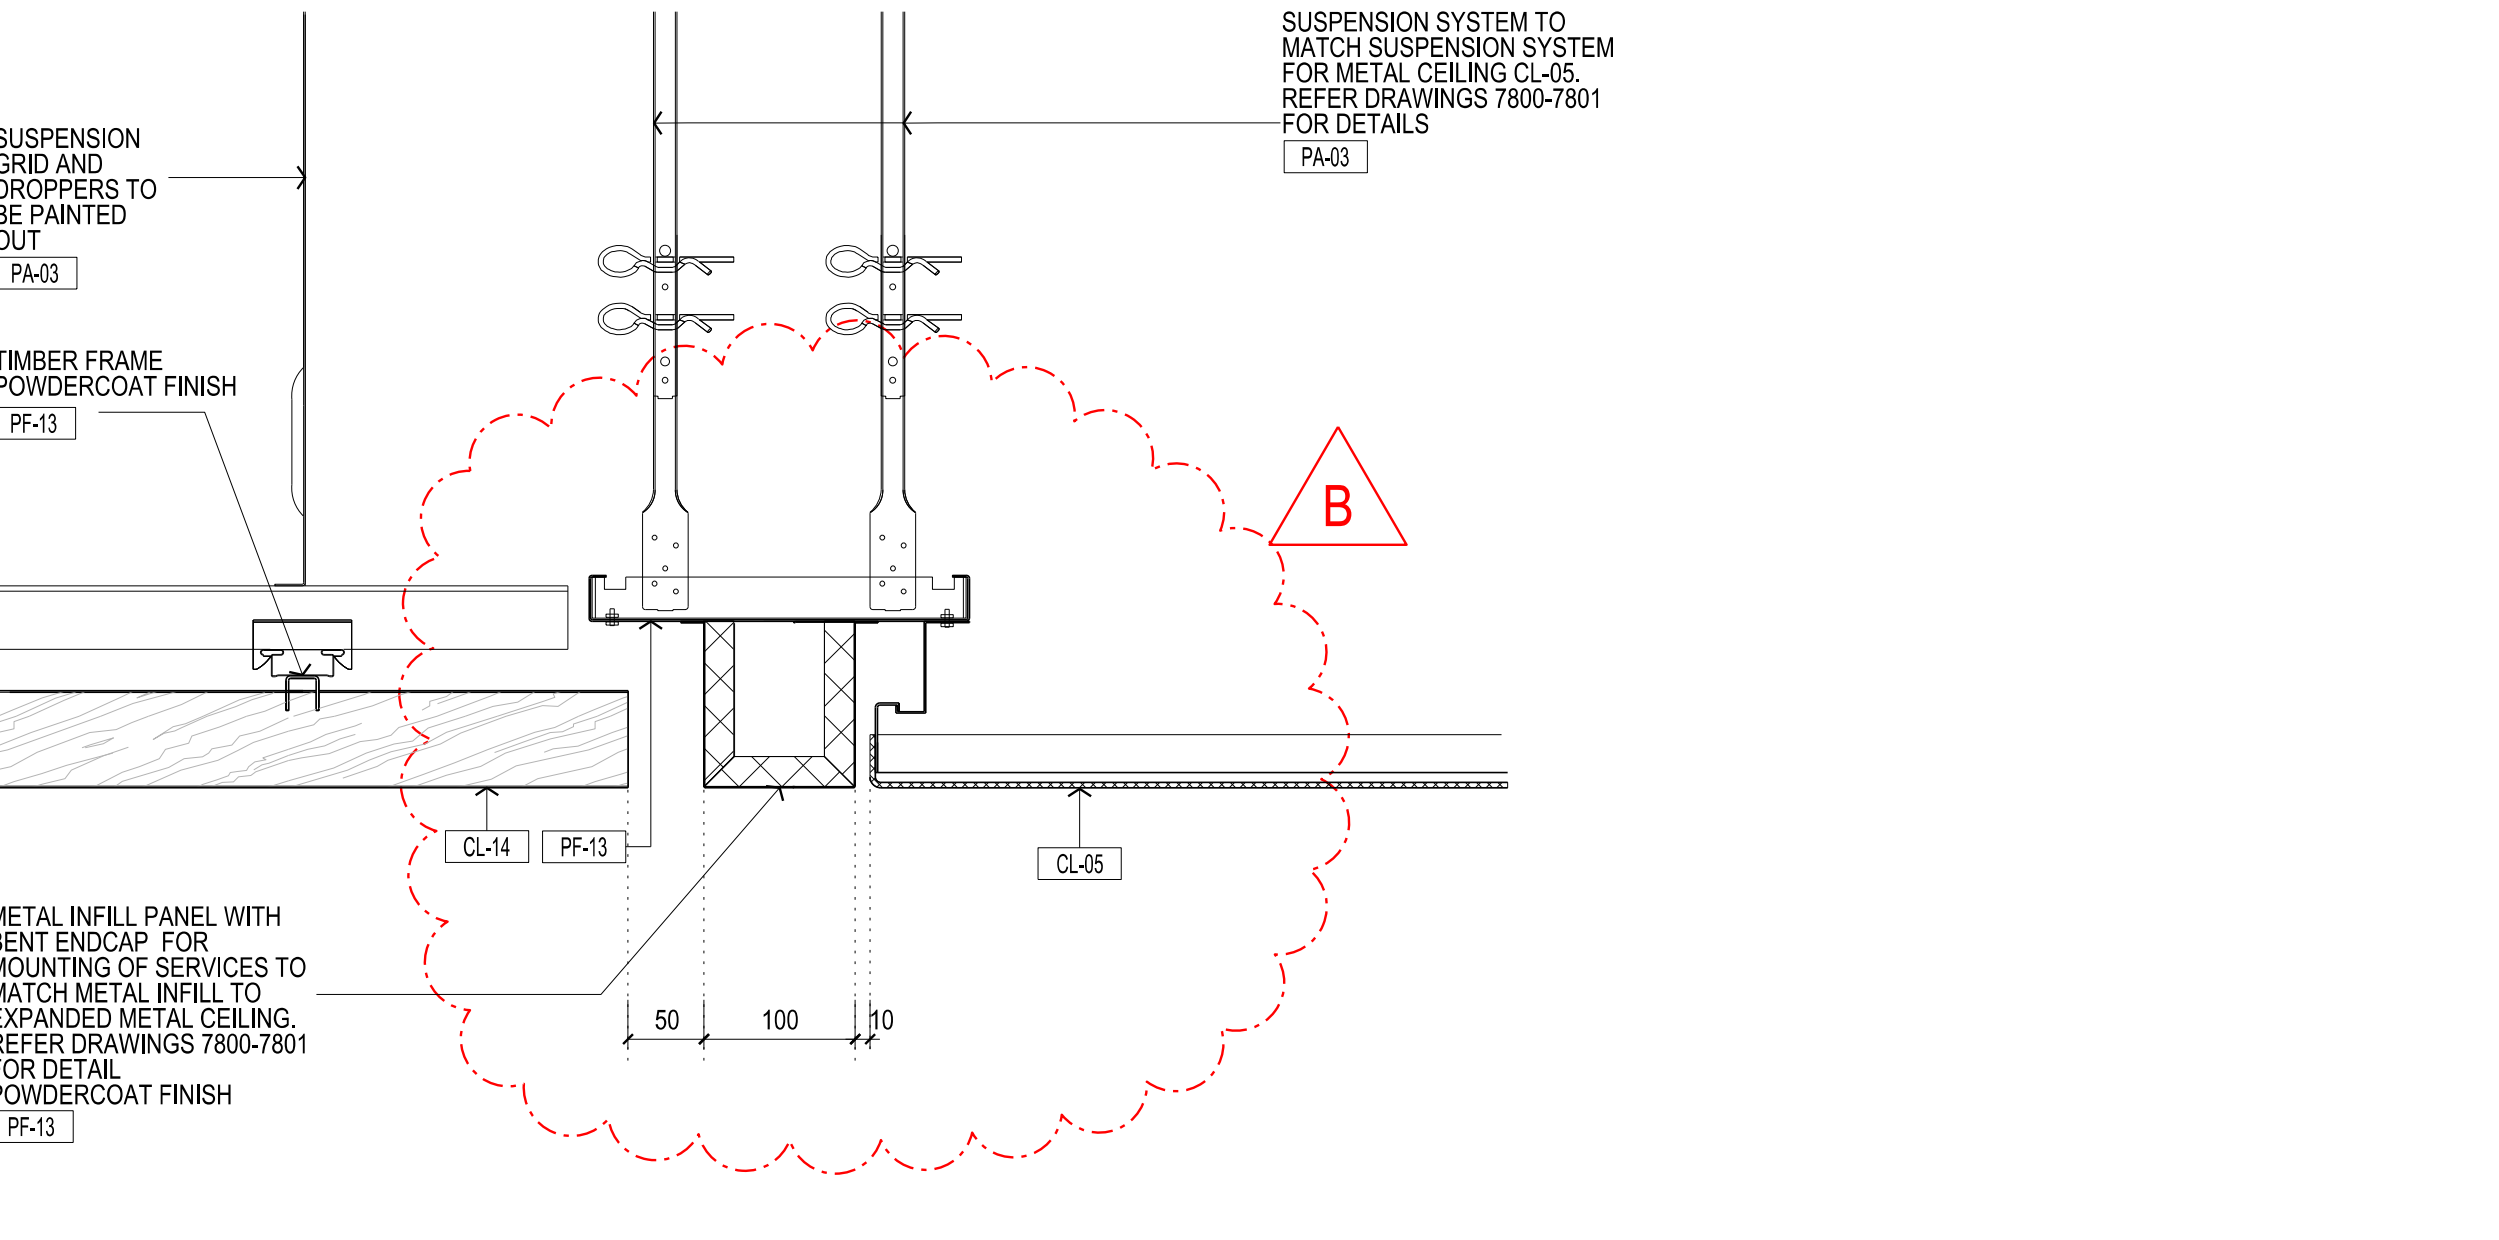

07 TIMBER CEILING CL-14 TO METAL CEILING CL-05- INFILL PANEL JUNCTION SECTION SCALE 1:5

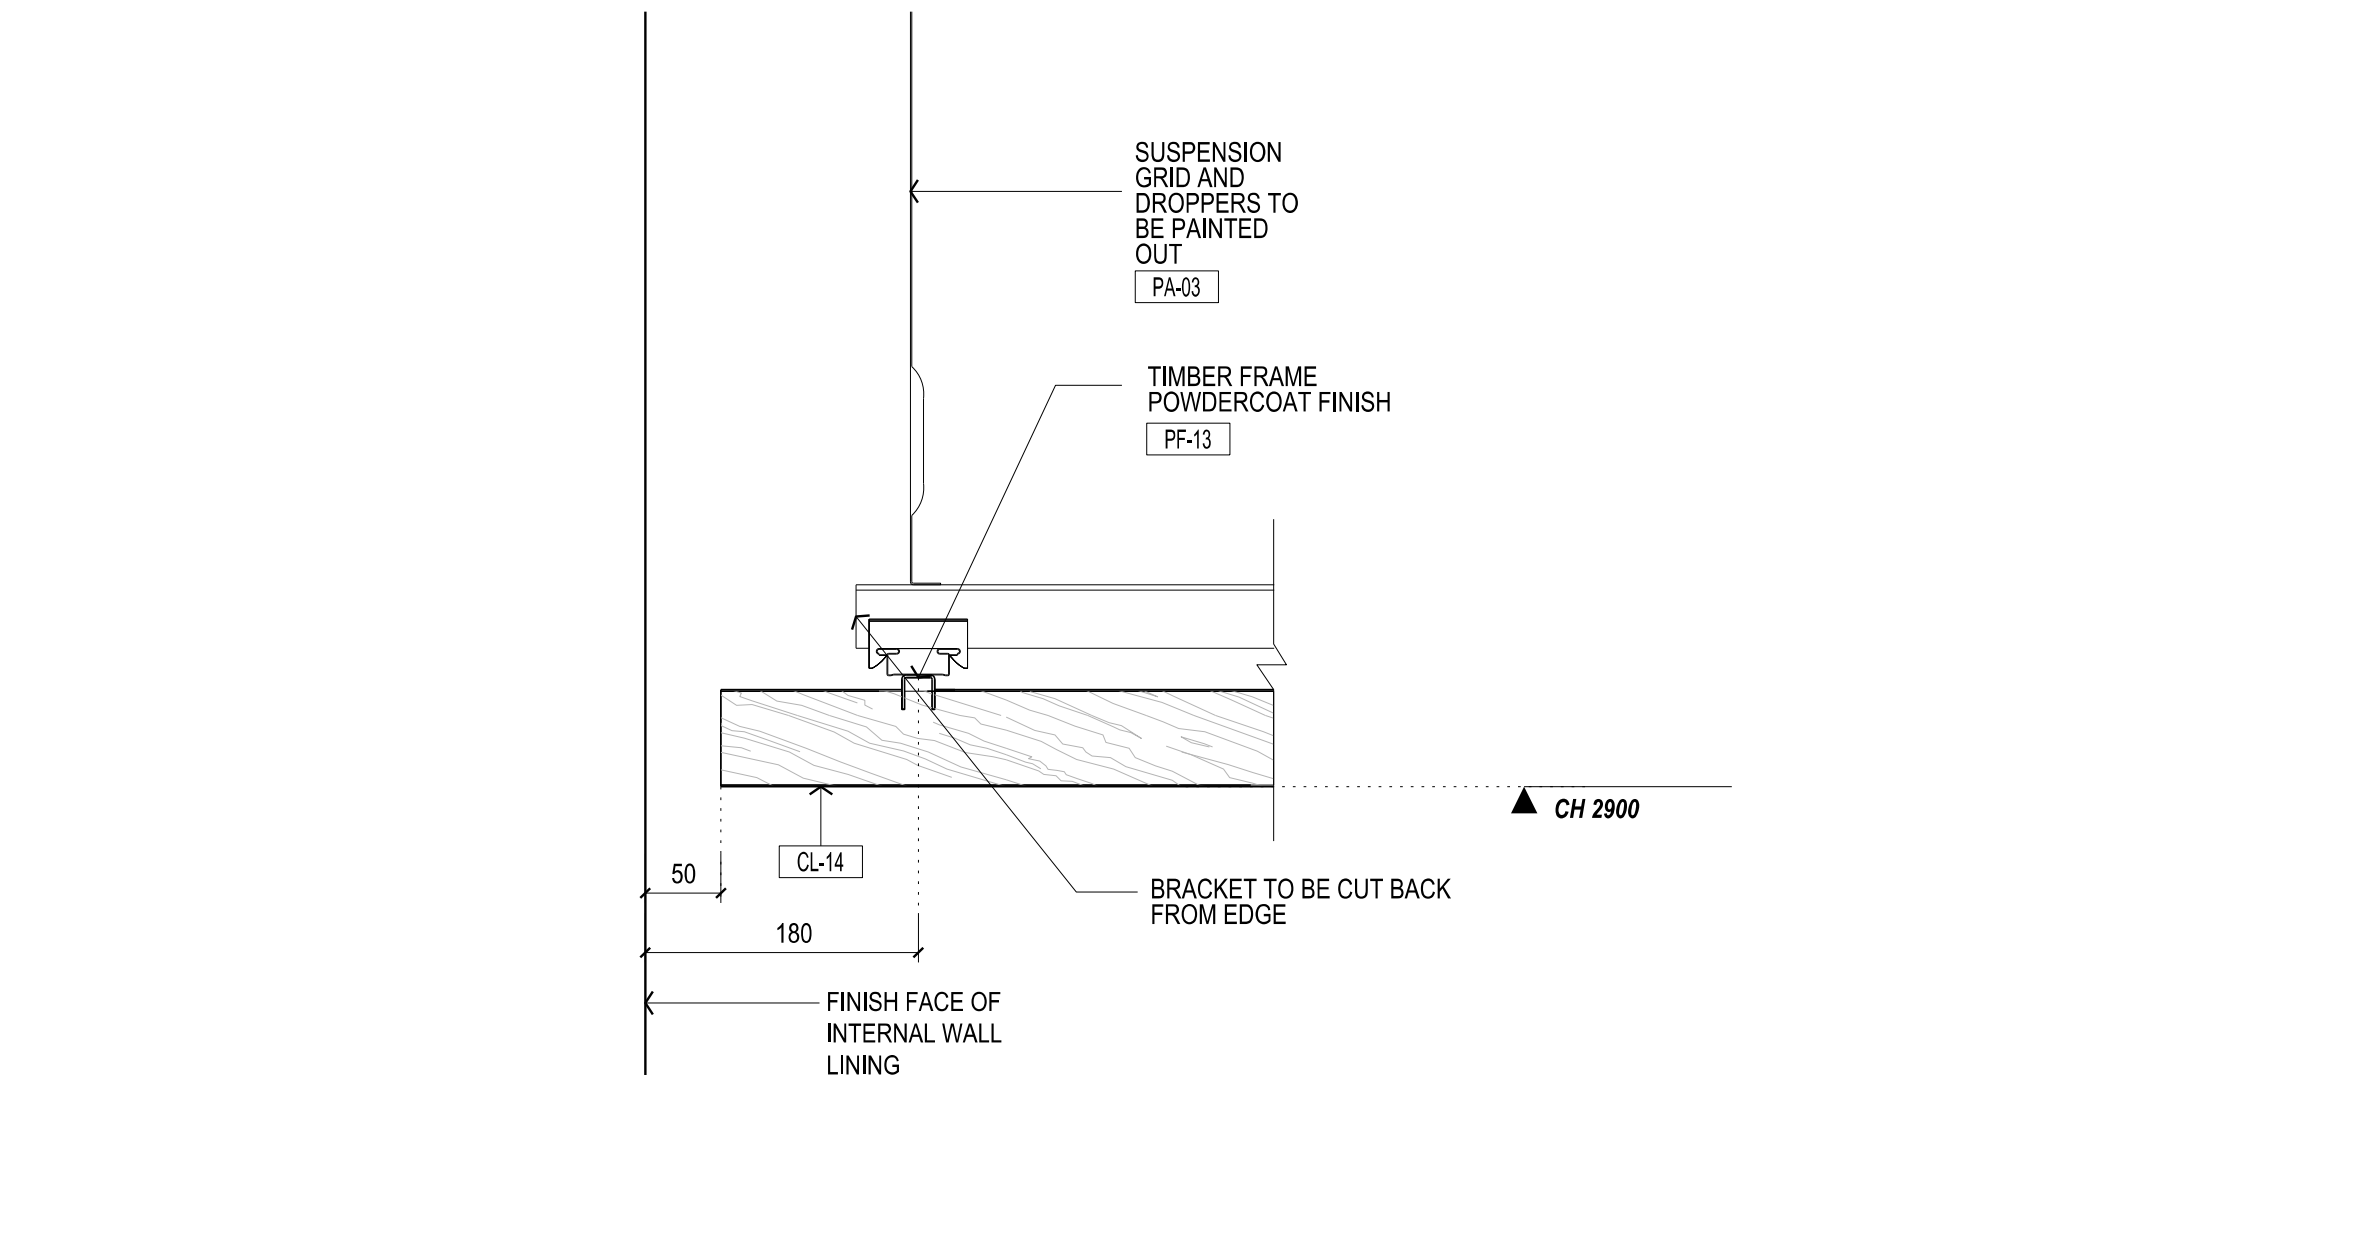

08 TIMBER CEILING - WALL JUNCTION-TYPICAL SECTION SCALE 1:5

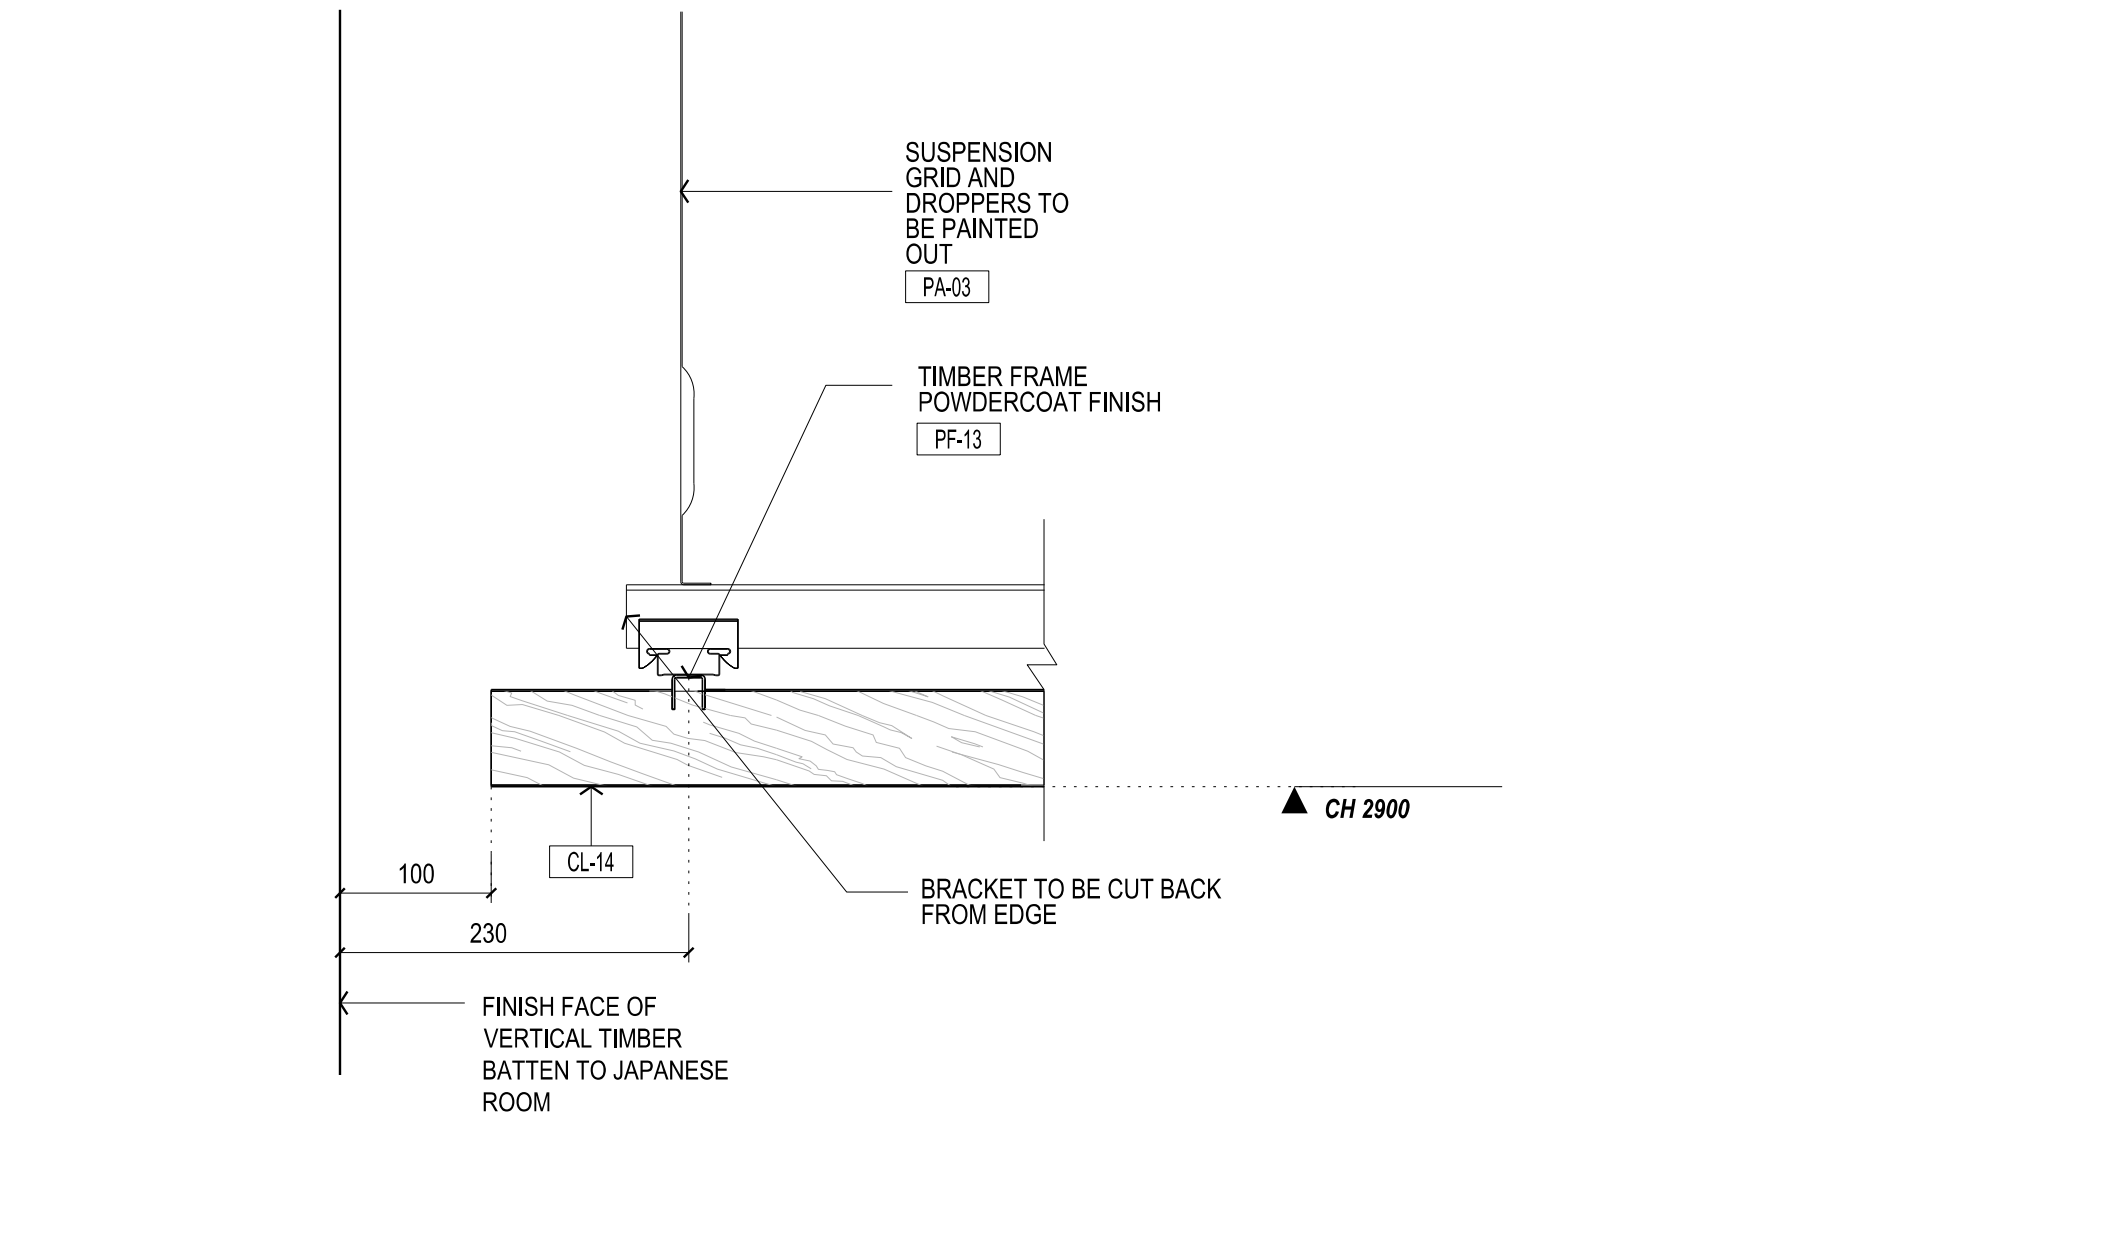

09 TIMBER CEILING TO VERTICAL TIMBER BATTENS TO JAPANESE ROOM SECTION SCALE 1:5



NADAAA
 NADAAA
 1920 Washington Street No.2 Boston Massachusetts 02115 USA
 Telephone +1 617 442 8232 Facsimile +1 617 442 1417 Email nadaaa@nadaaa.com

John Wardle Architects
 25 Rokeby Street, Collingwood, Victoria 3066 Australia
 Tel: +61 3 8662 0400 www.johnwardlearchitects.com
 © 2014 John Wardle Architects ABN 83 006 814 268

Client **University of Melbourne Parkville Campus**
 Project **Faculty of Architecture Building and Planning**
 Title **CEILING JUNCTION DETAILS**

Project No.	0913	Scale	1:5 @ A0 1:10 @ A2
Drawing No.	AR 7856	Revision	B
Date	Dec 2011	Drawn	Co-Ord
FILENAME - SFILES		Check	

FOR CONSTRUCTION