

CONTRACTORS SHALL VERIFY JOB DIMENSIONS BEFORE ANY JOB COMMENCES. ALL SHOP DRAWINGS SHALL BE SUBMITTED TO THE SUPERINTENDENT AND MANUFACTURERS SHALL NOT COMMENCE FROM THE RETURN OF AWARDED SHOP DRAWINGS BOUND BY THE CONTRACTOR. DIMENSIONS SHALL TAKE PRECEDENCE OVER SCALES. THIS DRAWING SHALL BE READ IN CONJUNCTION WITH ALL RELEVANT CONTRACT SPECIFICATIONS AND DRAWINGS COPYRIGHT OF THIS DRAWING IS VESTED IN NADAAA.

General Notes

ALL NON EXPOSED CARCASS TO BE MATCHING LAMINATE UNLESS OTHERWISE NOTED.

ALL NON EXPOSED CARCASS TO BE BLACK LAMINATE TO JOINERY RECEIVING TIMBER VENEER FINISH. REFER MATERIALS SCHEDULE [ PL-05 ]

ALL NON EXPOSED CARCASS TO BE WHITE LAMINATE TO JOINERY RECEIVING STAINLESS STEEL CLADDING. REFER MATERIALS SCHEDULE [ PL-01 ]

ALL EXPOSED EDGES TO TIMBER VENEER PANELS TO RECEIVE 3mm THK MATCHING SOLID EDGES UNLESS OTHERWISE NOTED.

SPLIT BATTENS TO BE 12mm UNLESS OTHERWISE NOTED.

APPLY MATCHING LAMINATE ABS EDGING TO LAMINATED BENCHTOPS UNLESS OTHERWISE NOTED.

REFER TO '1300 - MATERIALS SCHEDULE' FOR A DESCRIPTION OF THE MATERIAL CODES AS SHOWN ON THIS DRAWING. [ TV-00 ]

REFER TO '1400 - FIXTURES, FITTINGS & EQUIPMENT SCHEDULE' FOR A DESCRIPTION OF THE FF&E CODES AS SHOWN ON THIS DRAWING. [ J2400 ]

ALL JOINERY LOCKS TO BE [ JH-2 ] UNLESS OTHERWISE NOTED.

REFER TO DRAWING AR7300 FOR MOUNTING HEIGHTS FOR ALL SERVICES FIXTURES UNLESS OTHERWISE DIMENSIONED ON THE JOINERY ELEVATIONS.

ALL CORNER JUNCTIONS TO BE MITRED UNLESS OTHERWISE NOTED.

ALL UPHOLSTERY STITCHING TO MATCH FABRIC COLOUR UNLESS OTHERWISE NOTED.

DRAWINGS TO BE READ IN CONJUNCTION WITH AR1200 SERIES INTERNAL ARRANGEMENT PLANS TO COORDINATE FIXINGS INTO PARTITIONS WHERE NECESSARY.

FS = FIXED SHELF

AS = ADJUSTABLE SHELF

FP = FIXED PANEL

PJ = PANEL JOIN MAXIMUM WIDTH 2mm

C.O.S = CHECK ON SITE - DIMENSIONS MUST BE VERIFIED ON SITE BY CONTRACTOR PRIOR TO COMMENCEMENT OF CONSTRUCTION.

NOM = NOMINAL

TYP = TYPICAL

SM = SIMILAR

MIRR = MIRROR

FCL = FINISHED CEILING LEVEL

FFL = FINISHED FLOOR LEVEL

SSL = STRUCTURAL SLAB LEVEL

C = CENTRELINE

↻ = DIRECTION OF GRAIN / FINISH

Rev	Issue	Revision Description	And	Date
A	SG	ISSUE FOR CONSTRUCTION	-	20.12.13
03	SG	100% CD - TENDER ISSUE	-	07.09.12
02	SG	50% CD ISSUE	-	01.06.12
01	SG	25% CD ISSUE	-	20.04.12

Rev	Issue	Revision Description	And	Date
A	SG	ISSUE FOR CONSTRUCTION	-	20.12.13
03	SG	100% CD - TENDER ISSUE	-	07.09.12
02	SG	50% CD ISSUE	-	01.06.12
01	SG	25% CD ISSUE	-	20.04.12



25 Rokeby Street, Collingwood, Victoria 3066 Australia  
Tel: +61 3 8662 0400 www.johnwardlearchitects.com  
© 2012 John Wardle Architects ABN 83 006 814 268

Client University of Melbourne  
Parkville Campus

Project Faculty of Architecture  
Building and Planning


Title LOOSE FURNITURE & WORKSTATION  
DETAILS - SHEET 02

Project No.	0913	Scale	1:20 @ A0 1:40 @ A2
Drawing No.	AR8051	Revision	A


Date: Dec 2011 Dwn SC Co-Ord SG Chk JA

FILENAME - SFRLES


FOR CONSTRUCTION

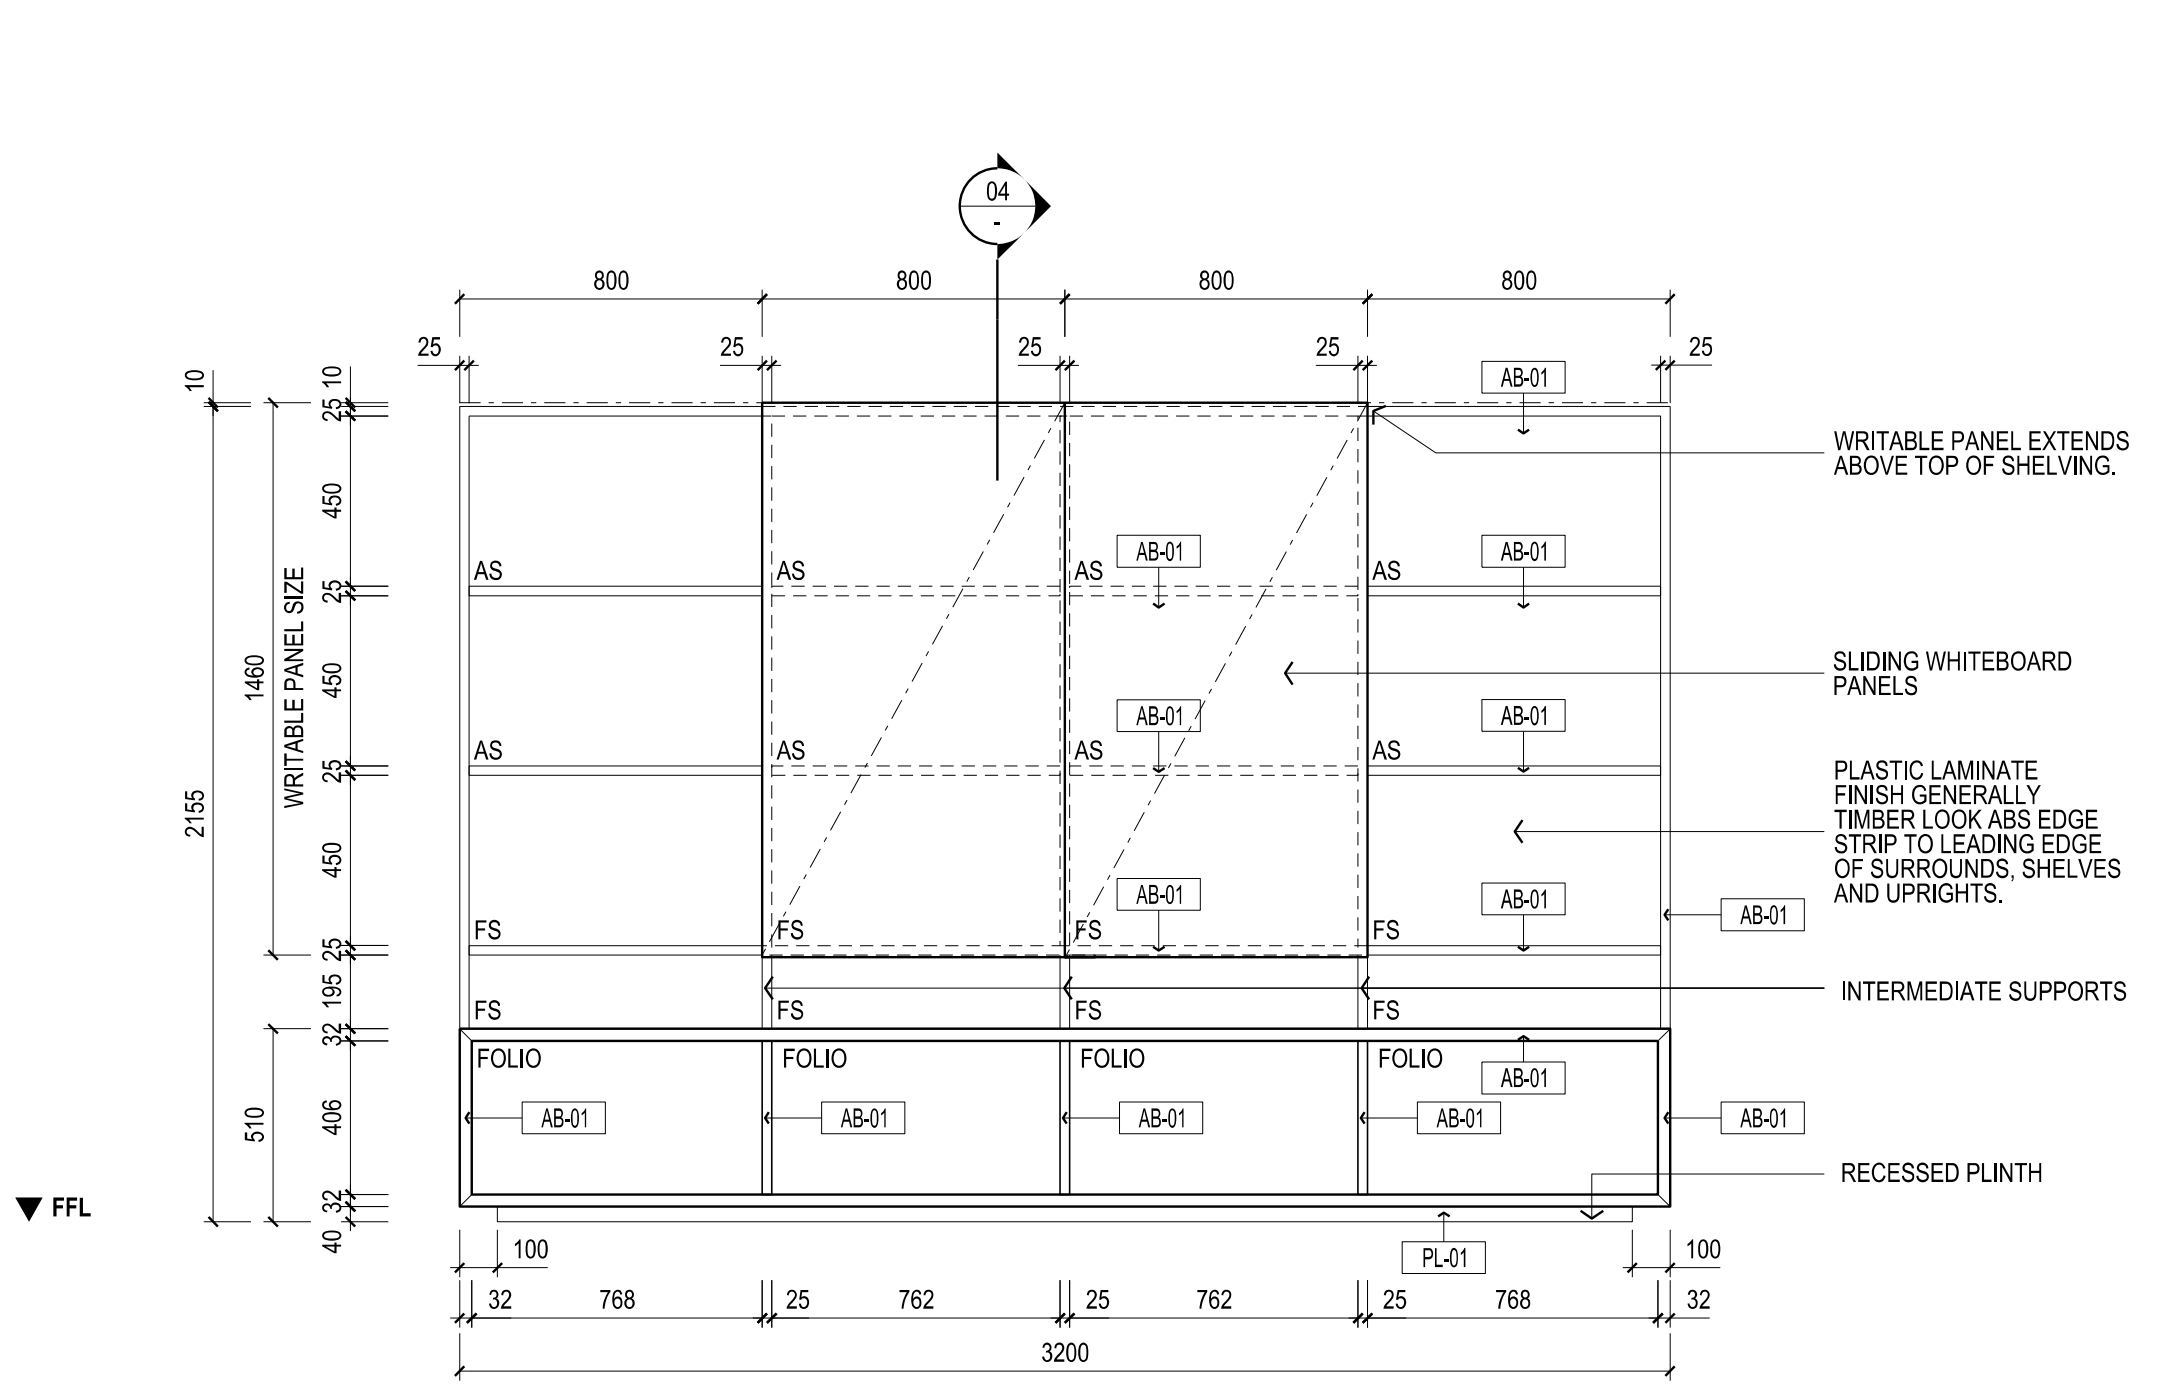


01 ELEVATION SCALE 1:20

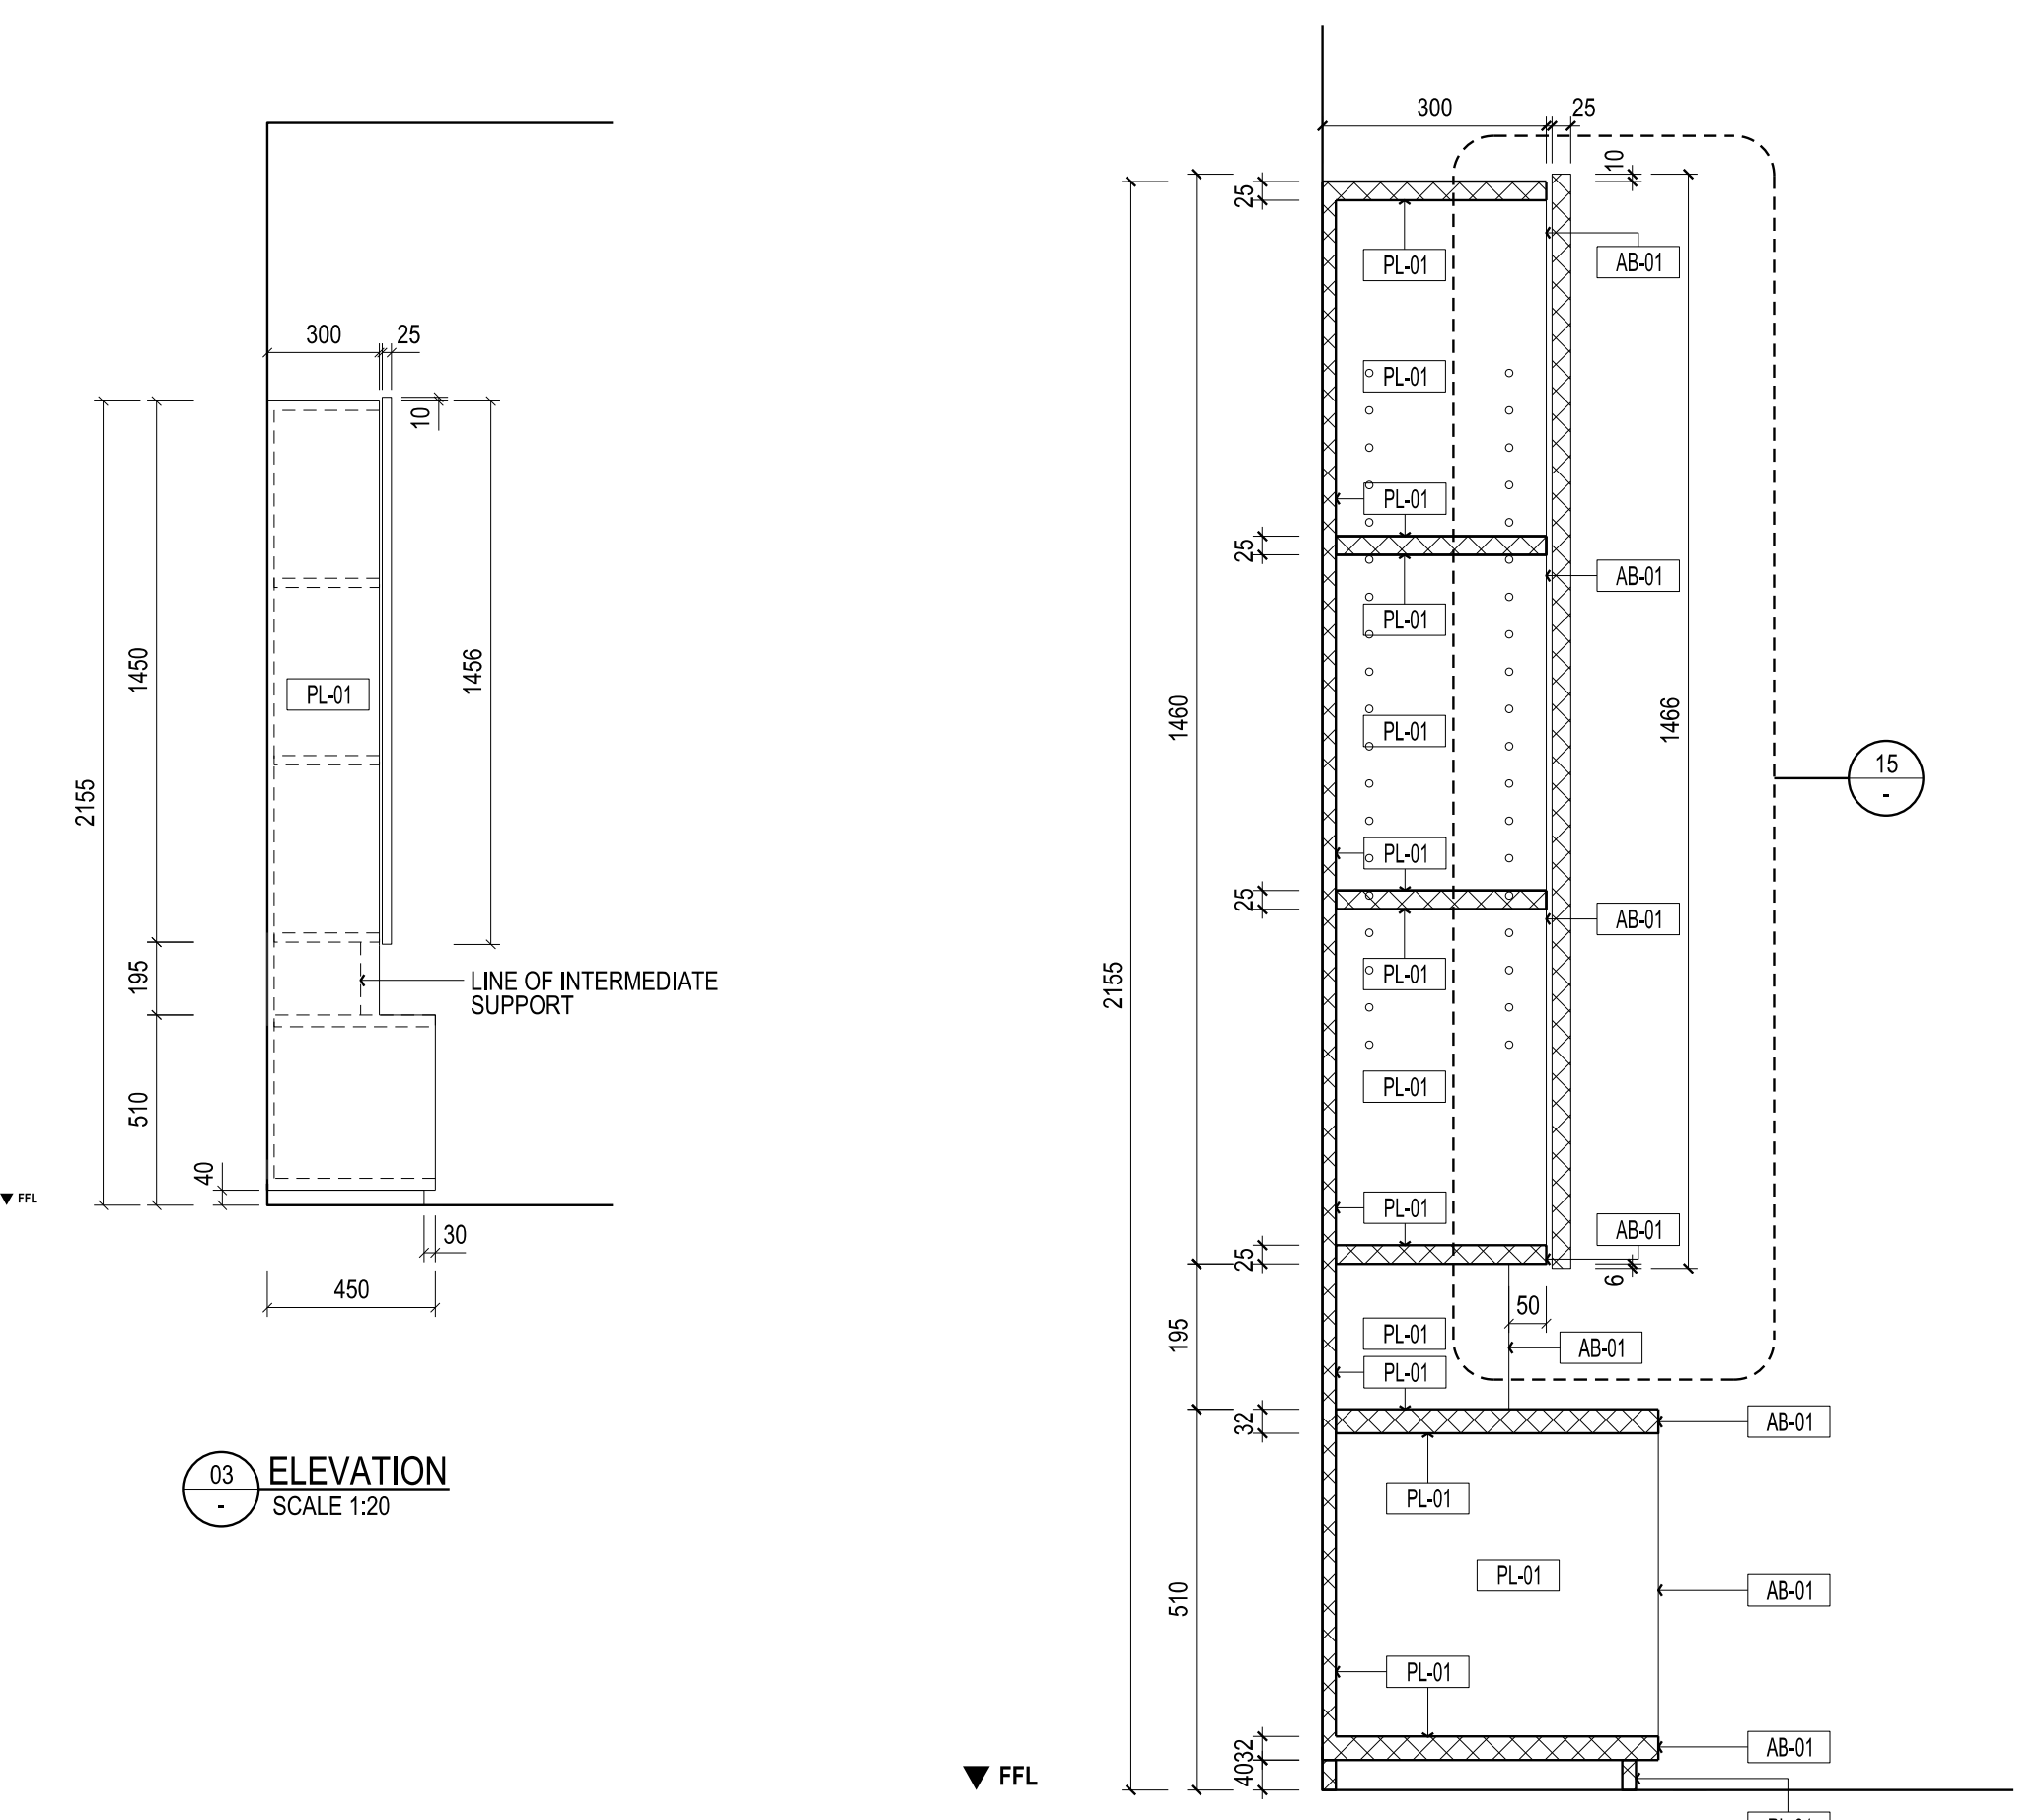


02 ELEVATION SCALE 1:20

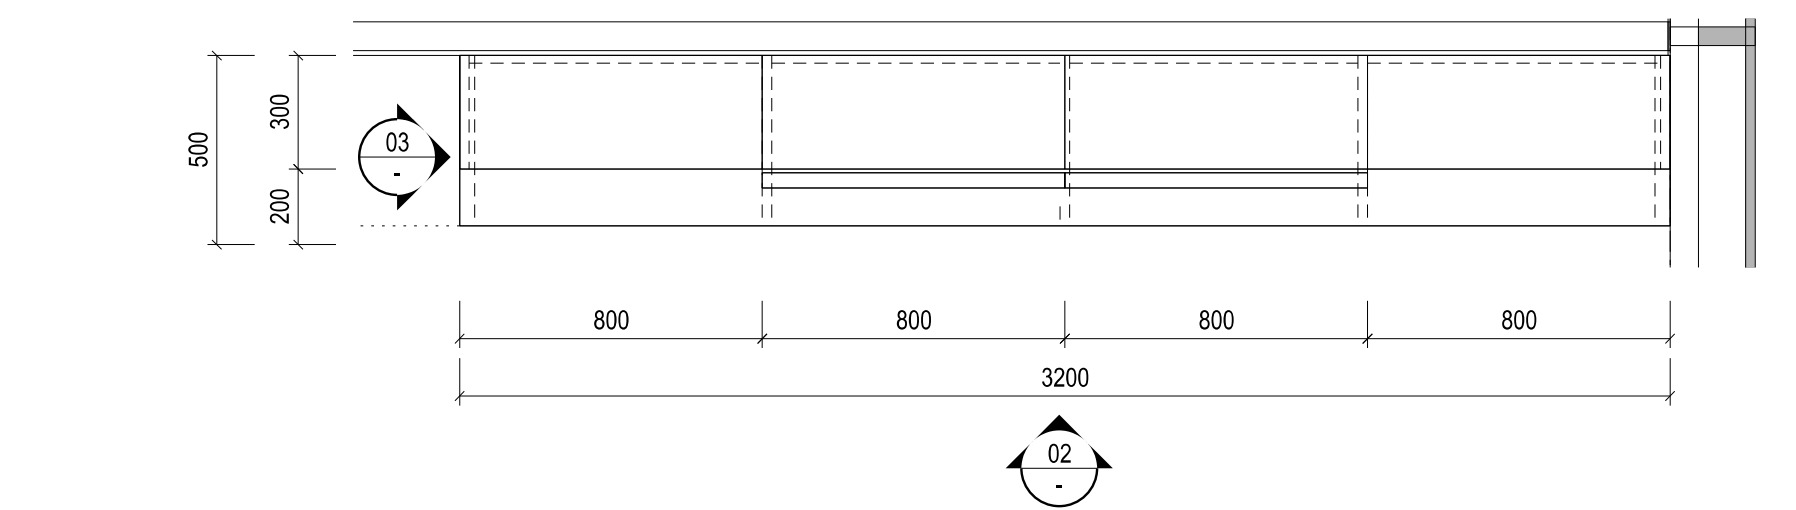


01 PLAN - WKS-18A - OFFICE STORAGE SCALE 1:20

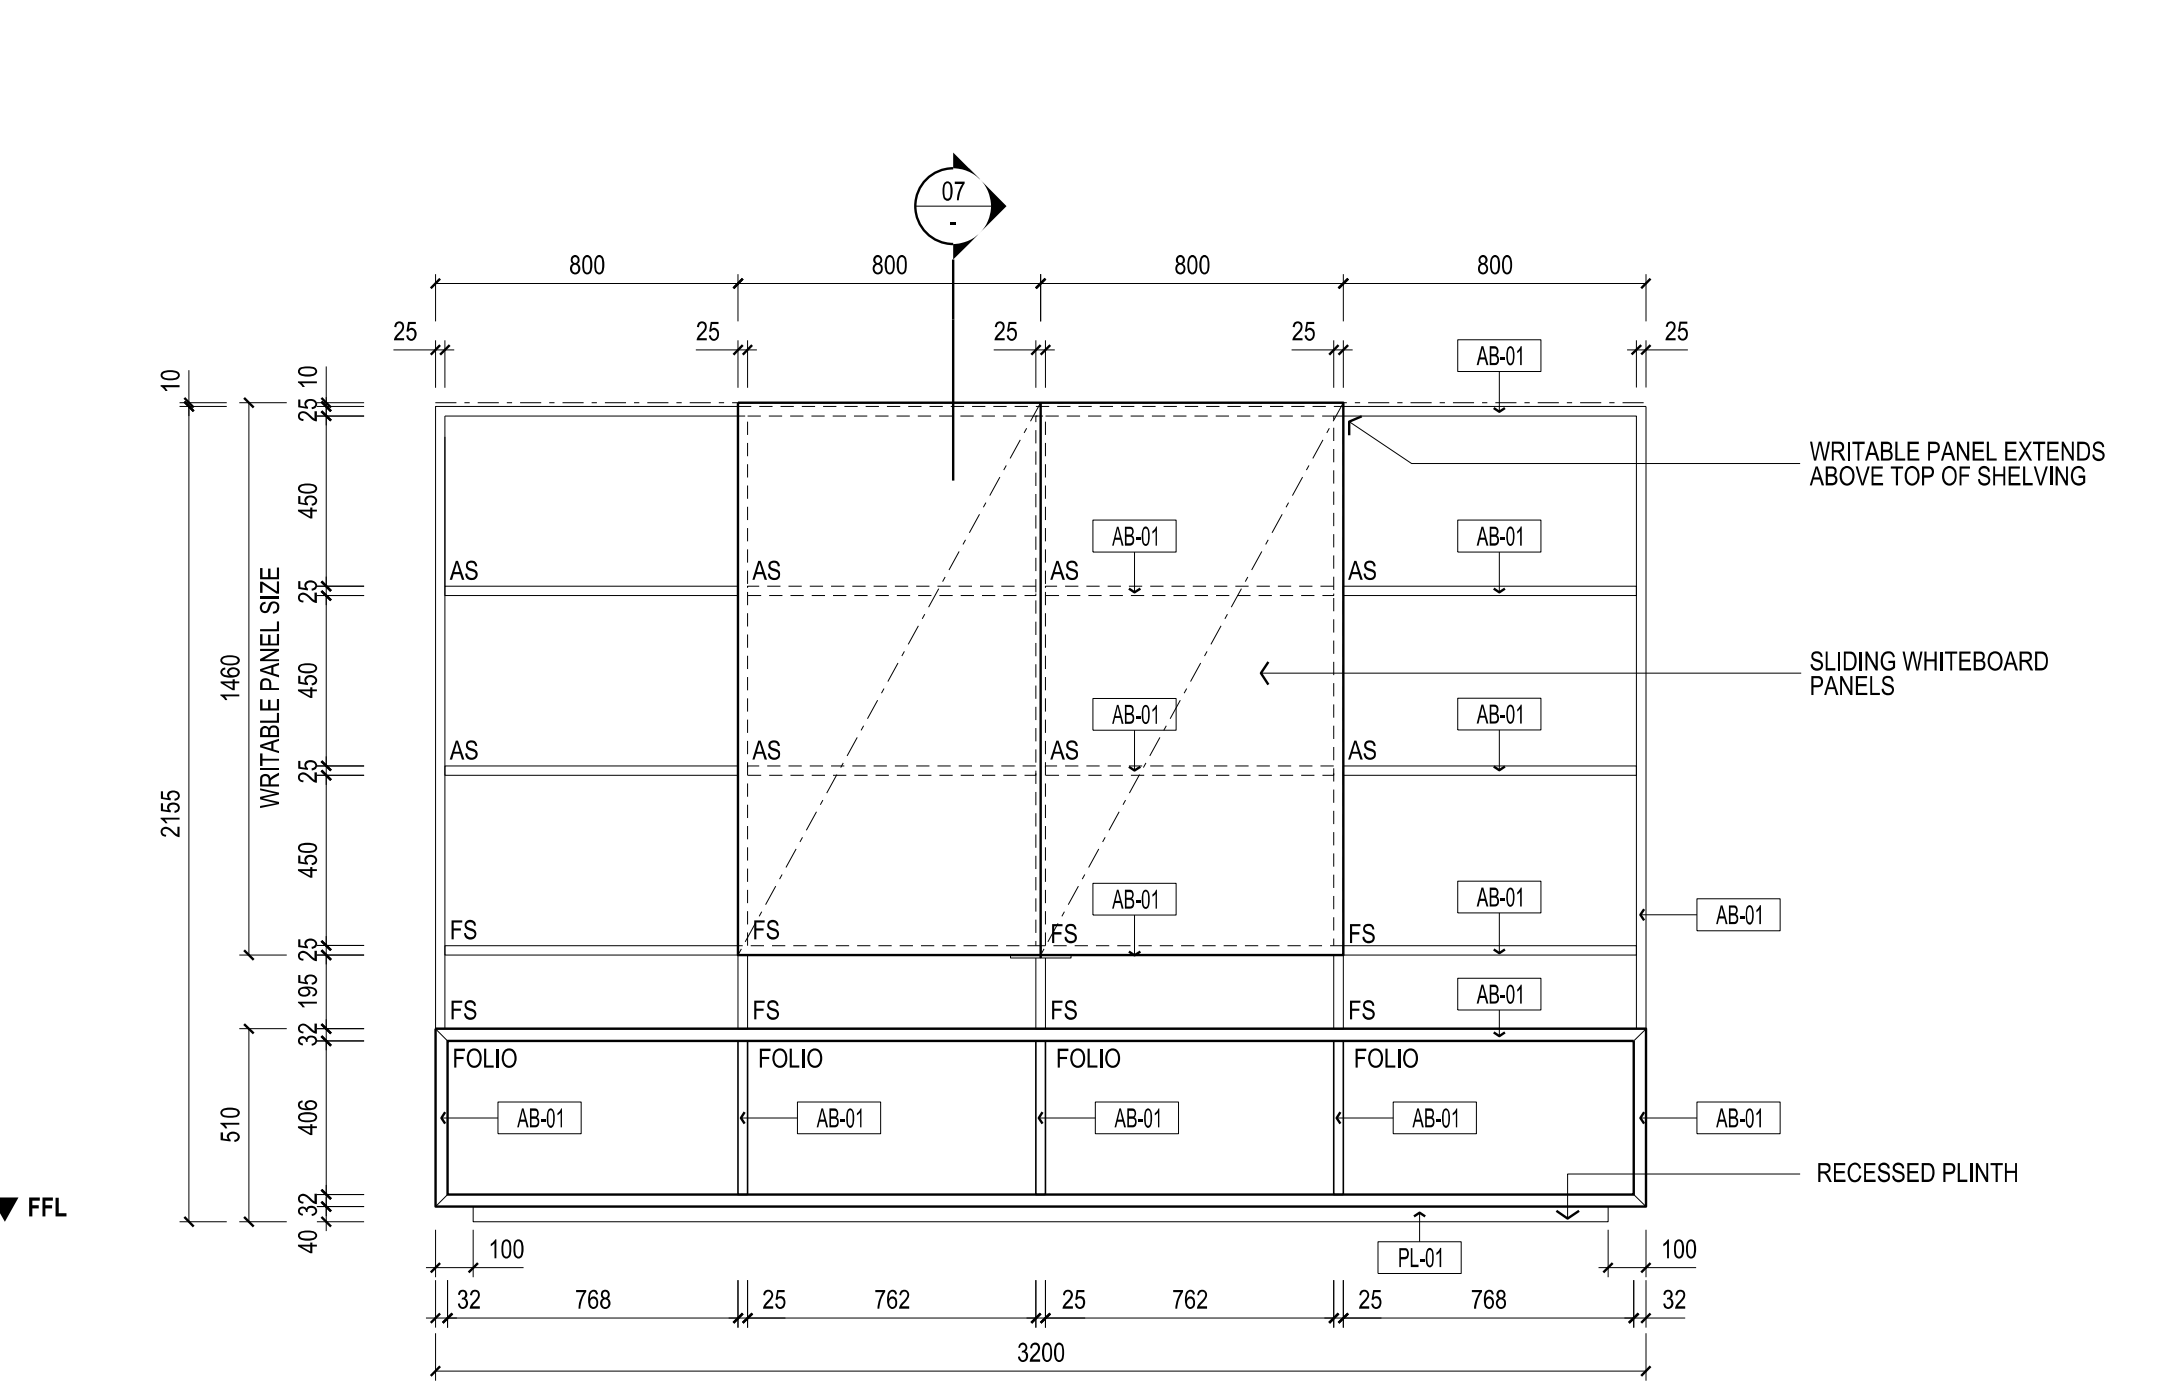


03 ELEVATION SCALE 1:20

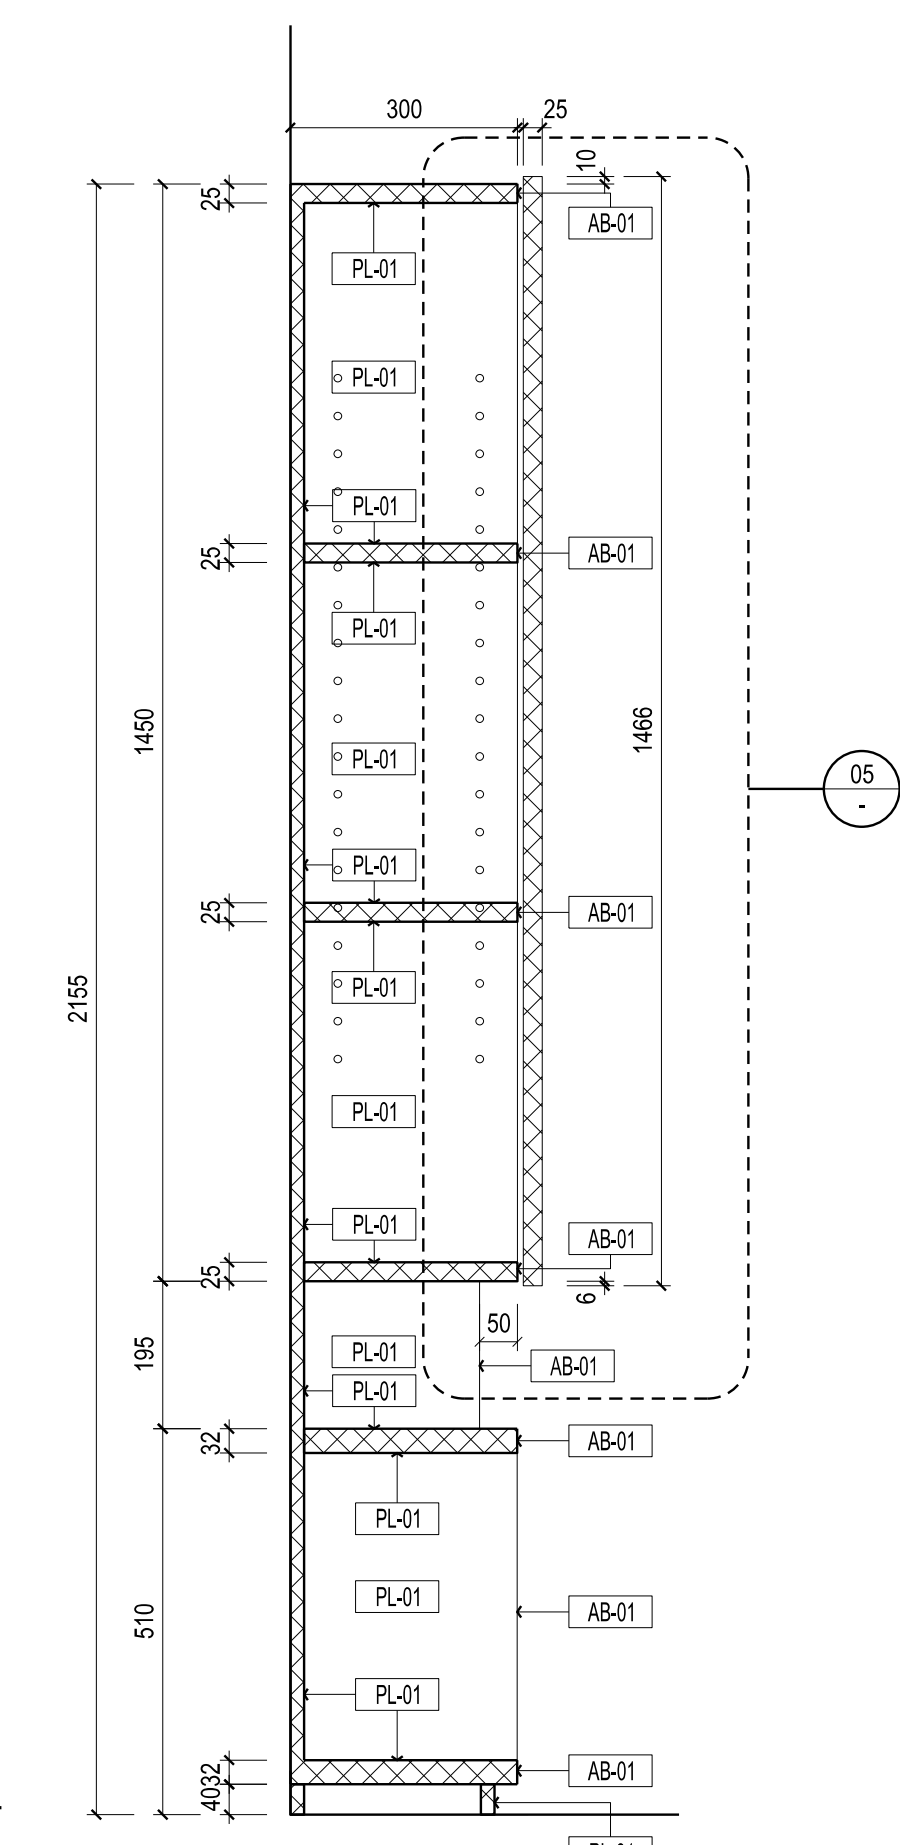


04 ELEVATION SCALE 1:20

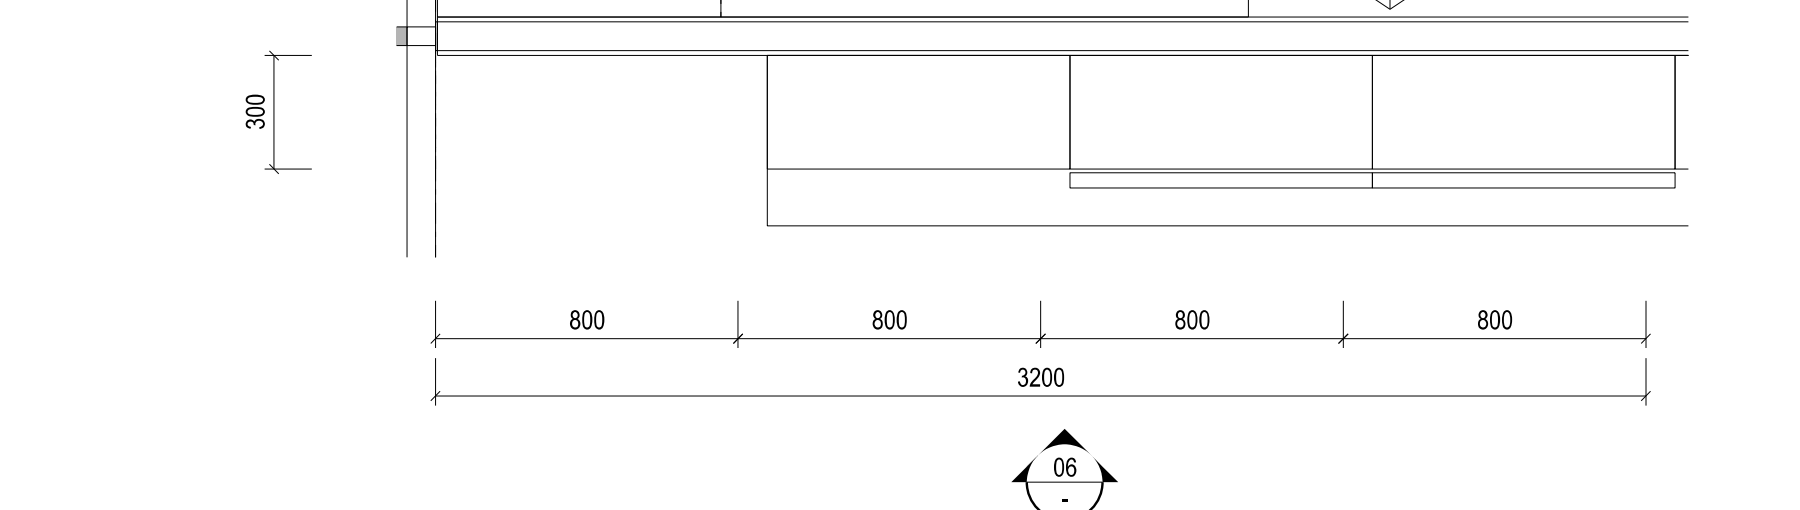


02 PLAN - WKS-18B - OFFICE STORAGE SCALE 1:20

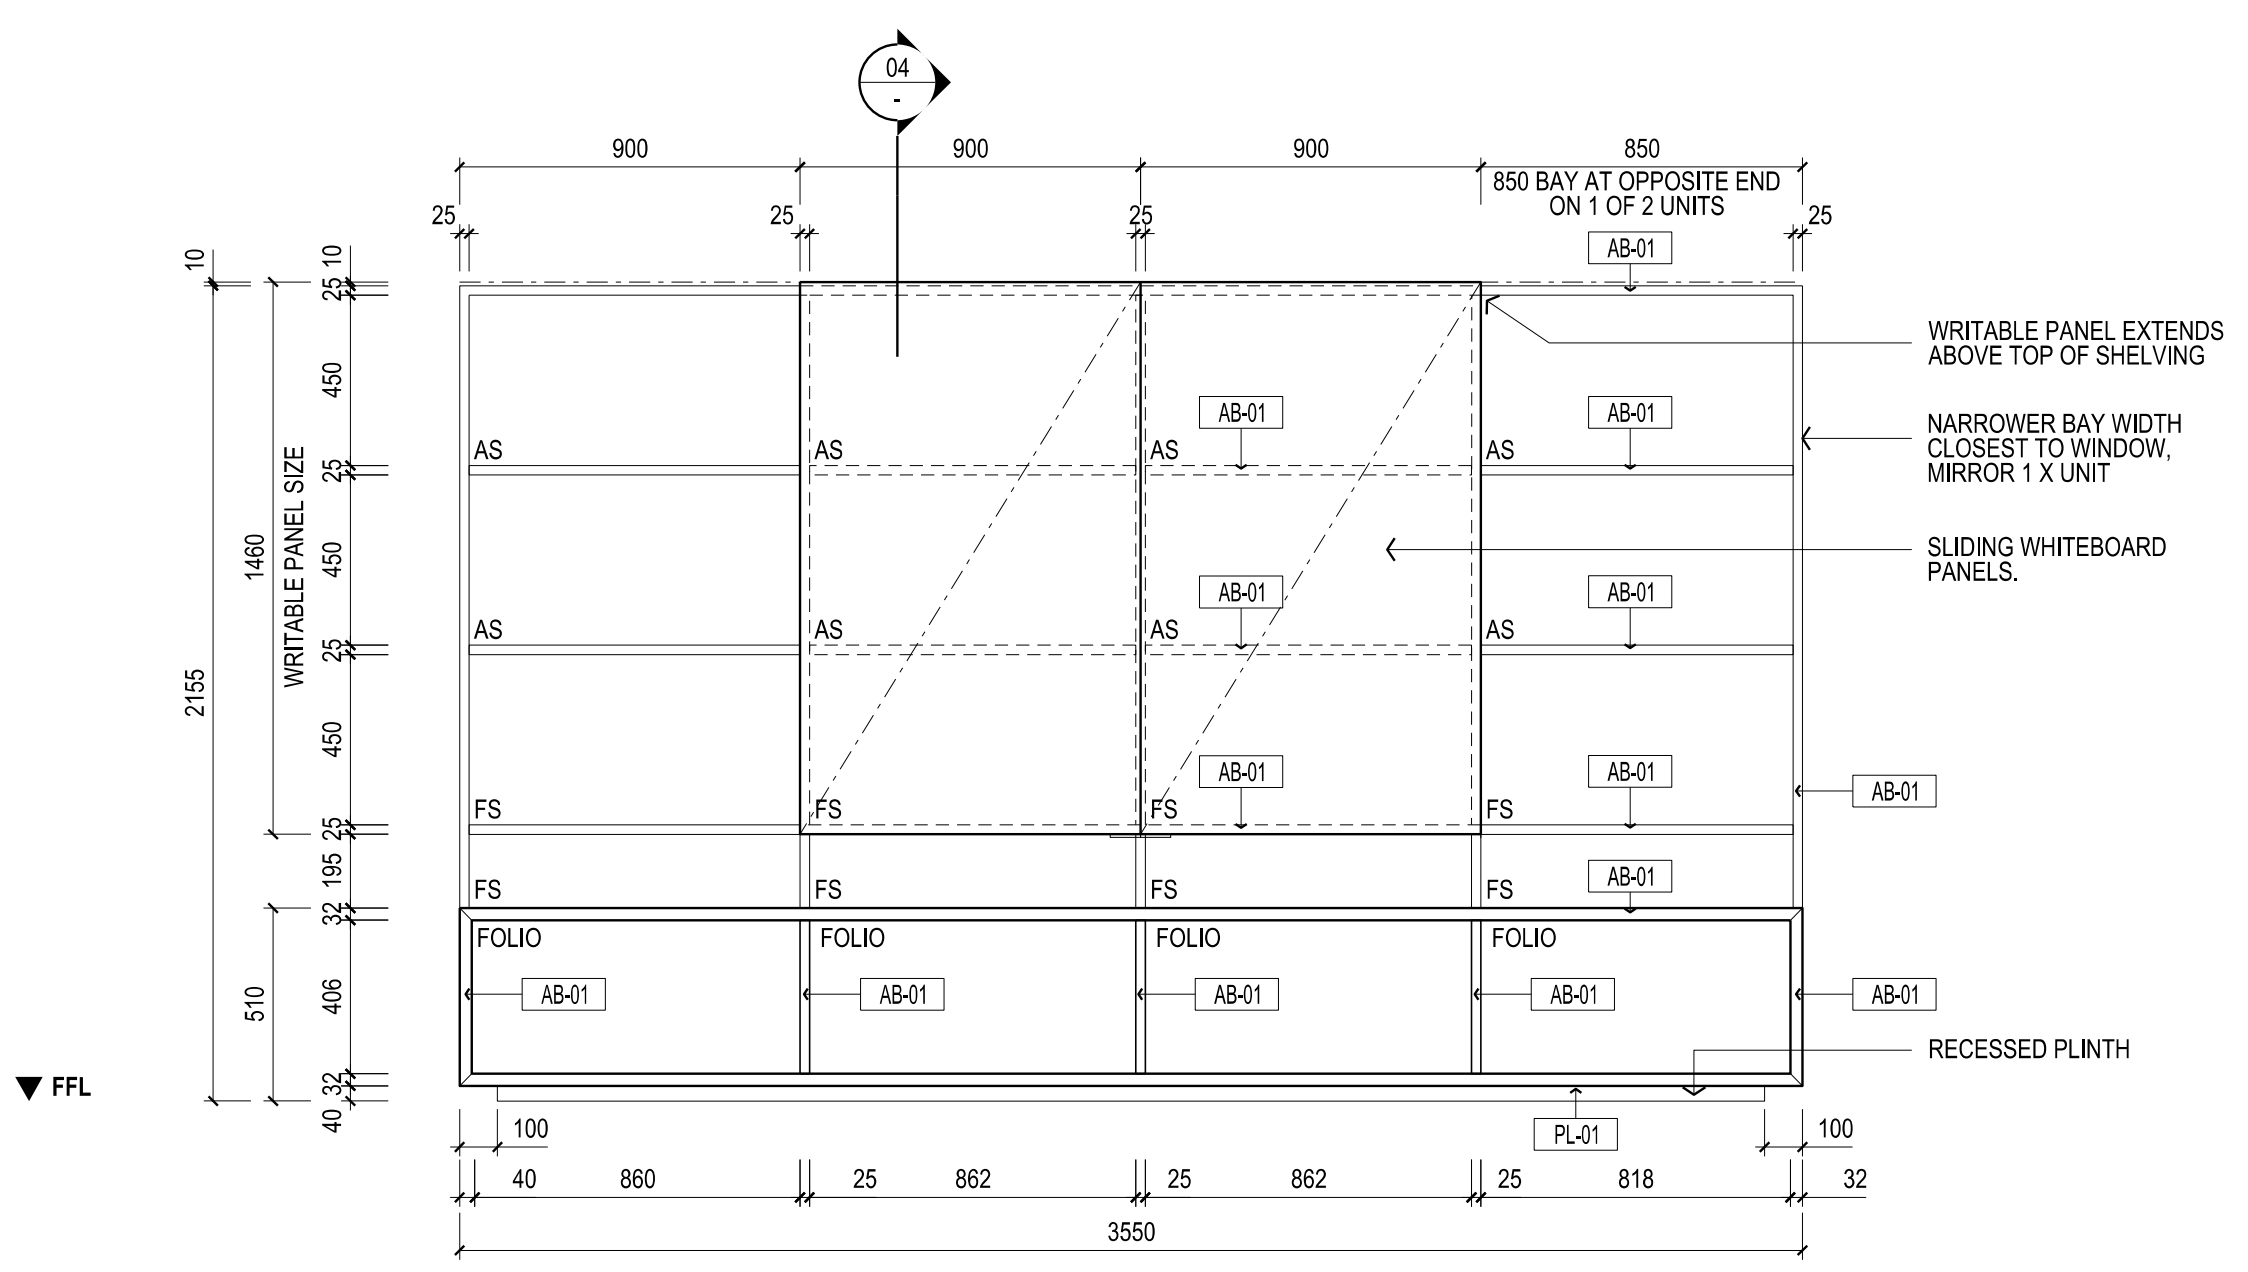


05 ELEVATION SCALE 1:20

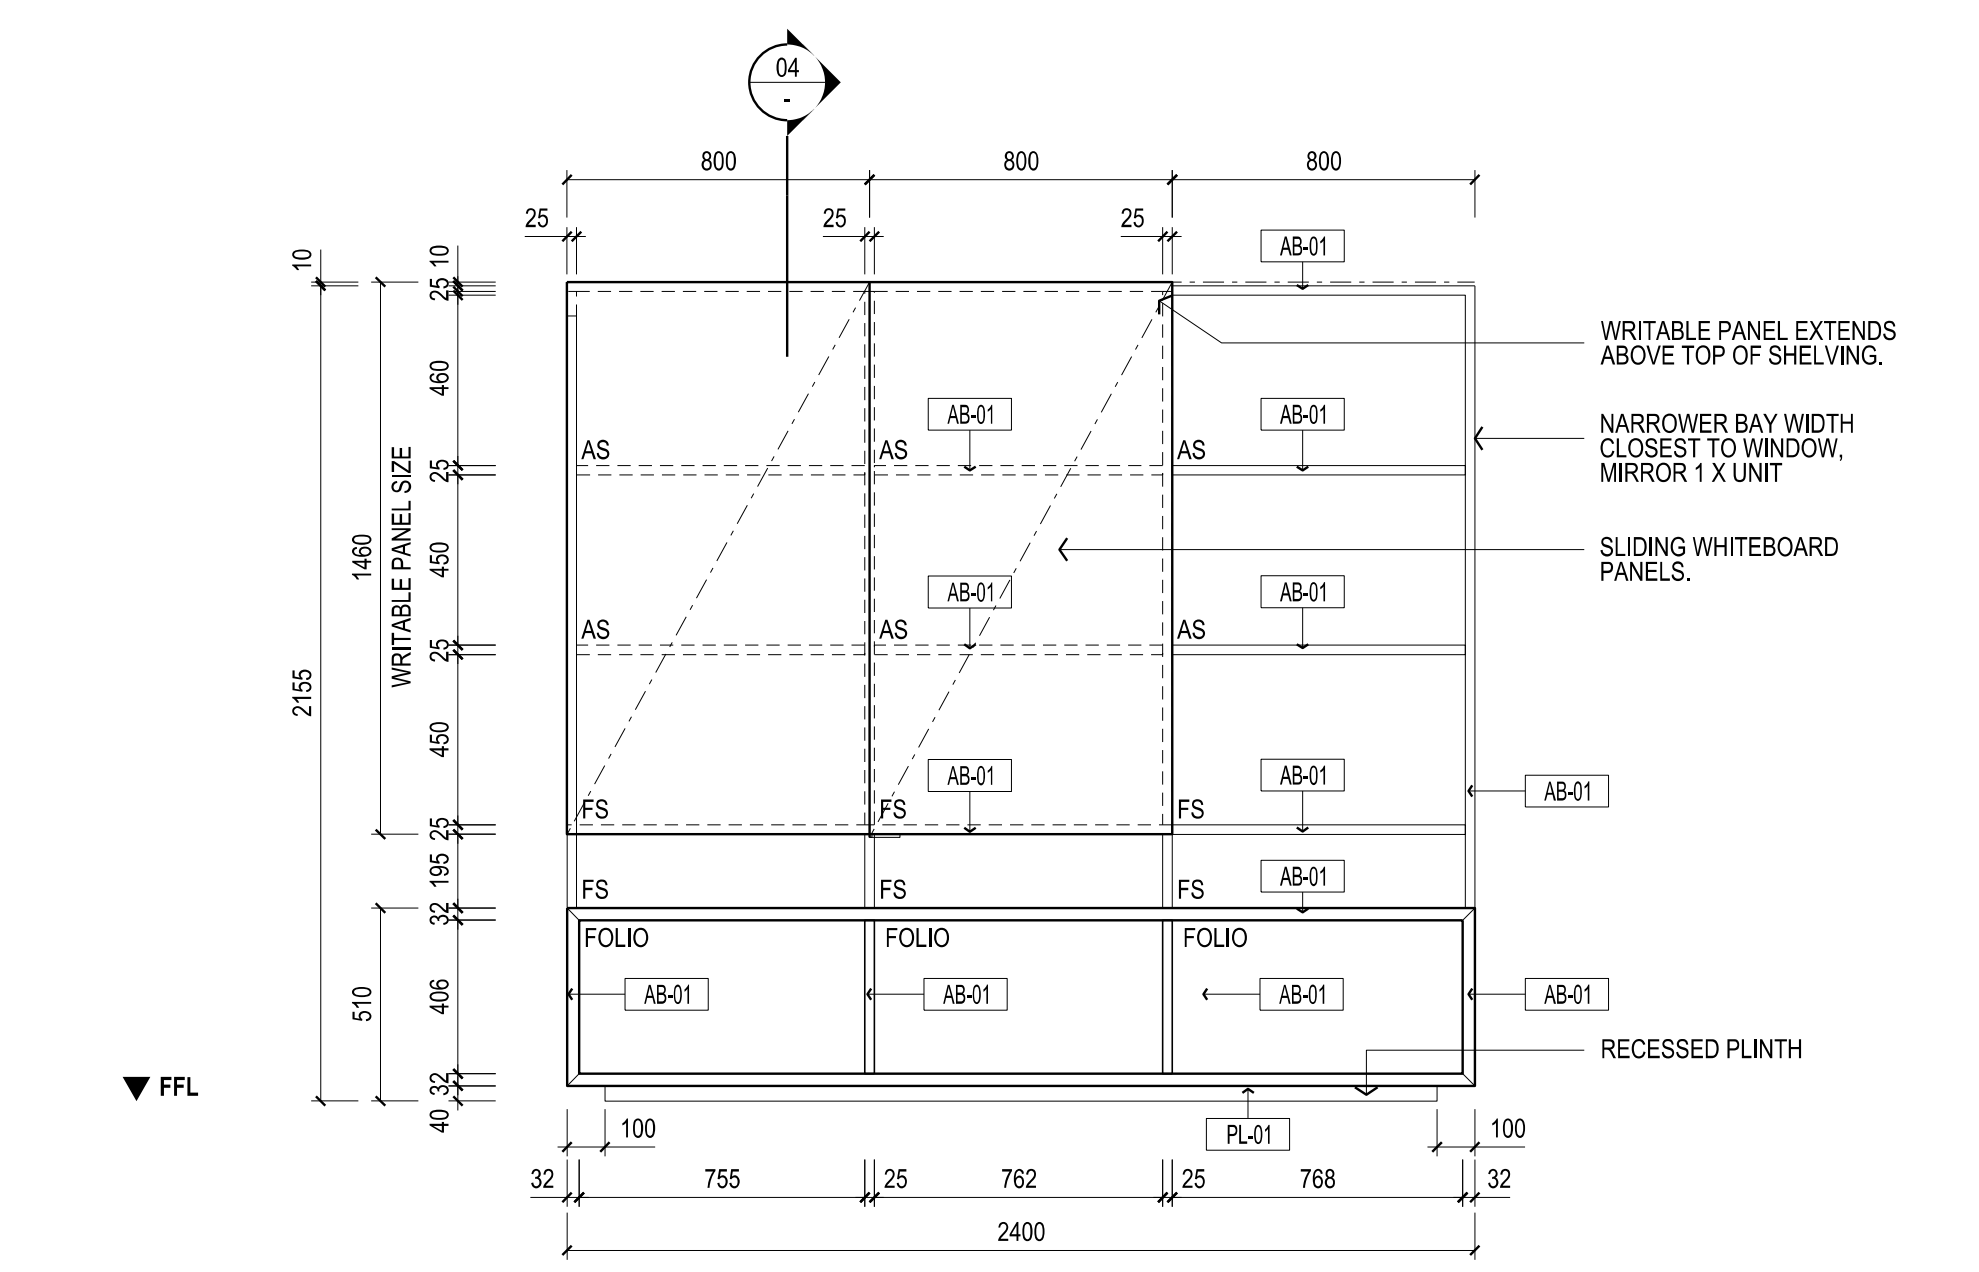


06 ELEVATION SCALE 1:20

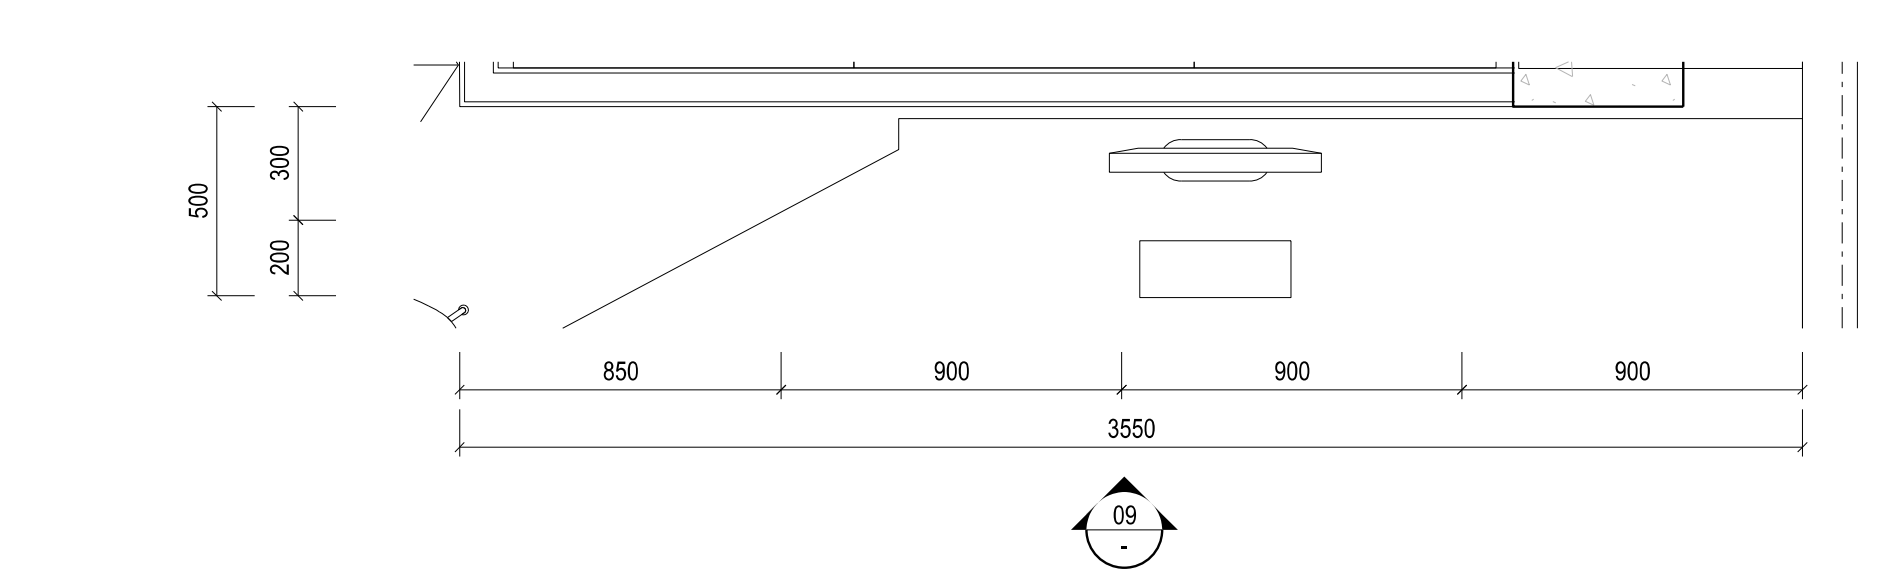


03 PLAN - WKS-18C - OFFICE STORAGE SCALE 1:20

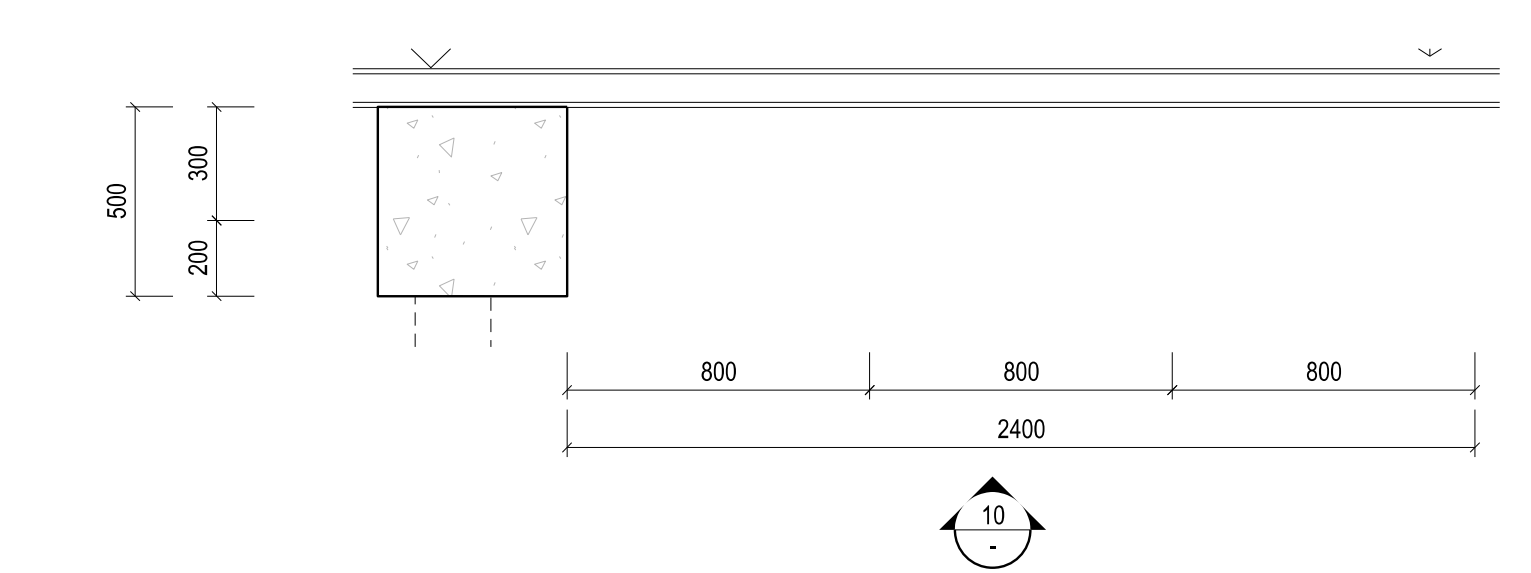


04 PLAN - WKS-18D - OFFICE STORAGE SCALE 1:20

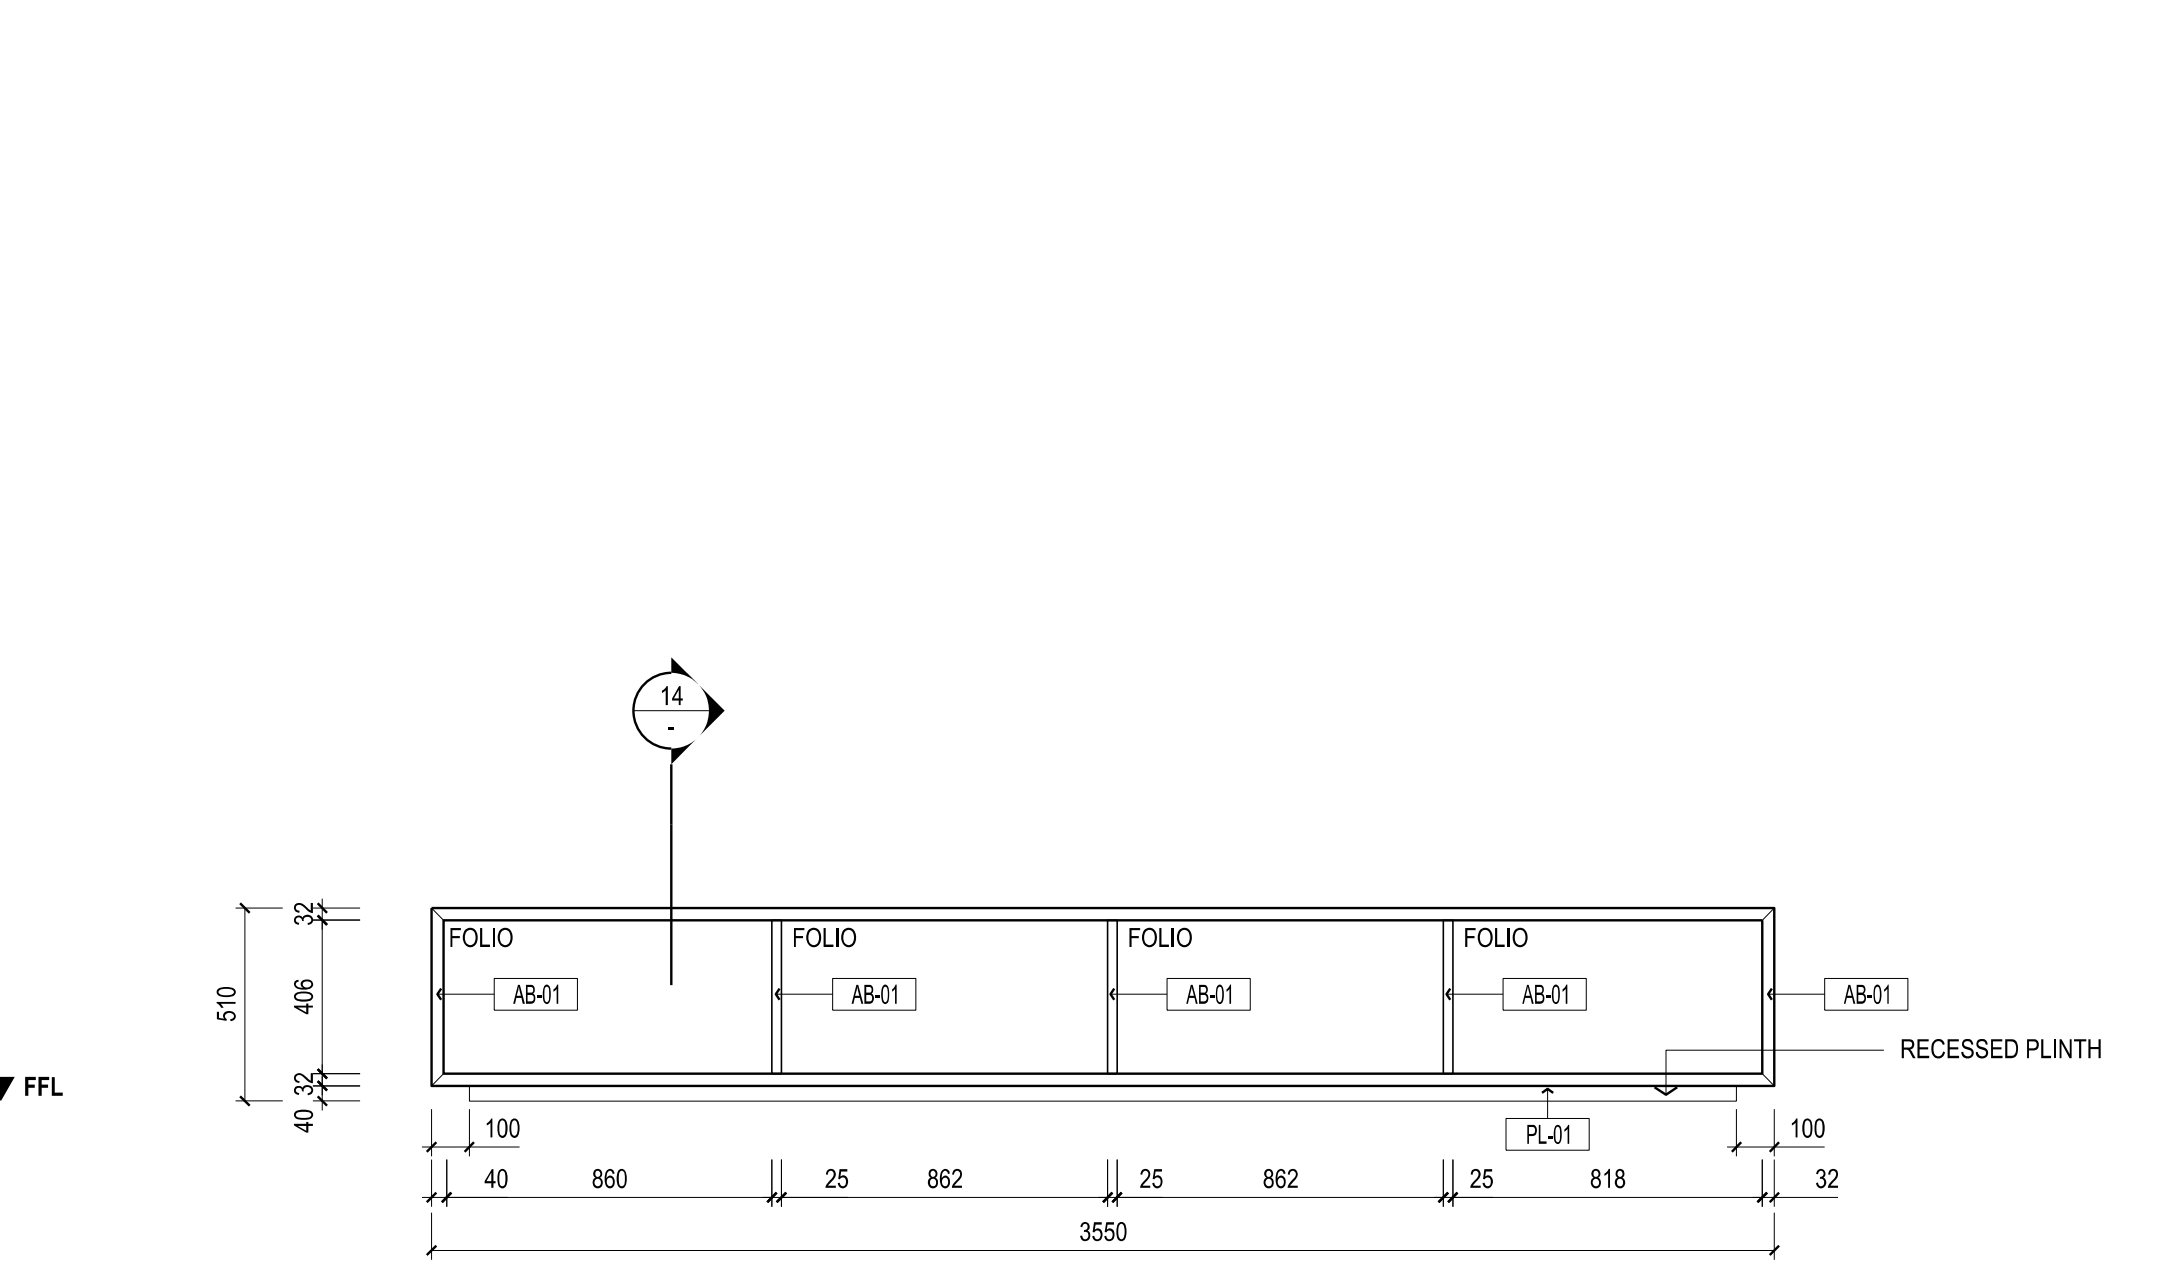


07 ELEVATION SCALE 1:20

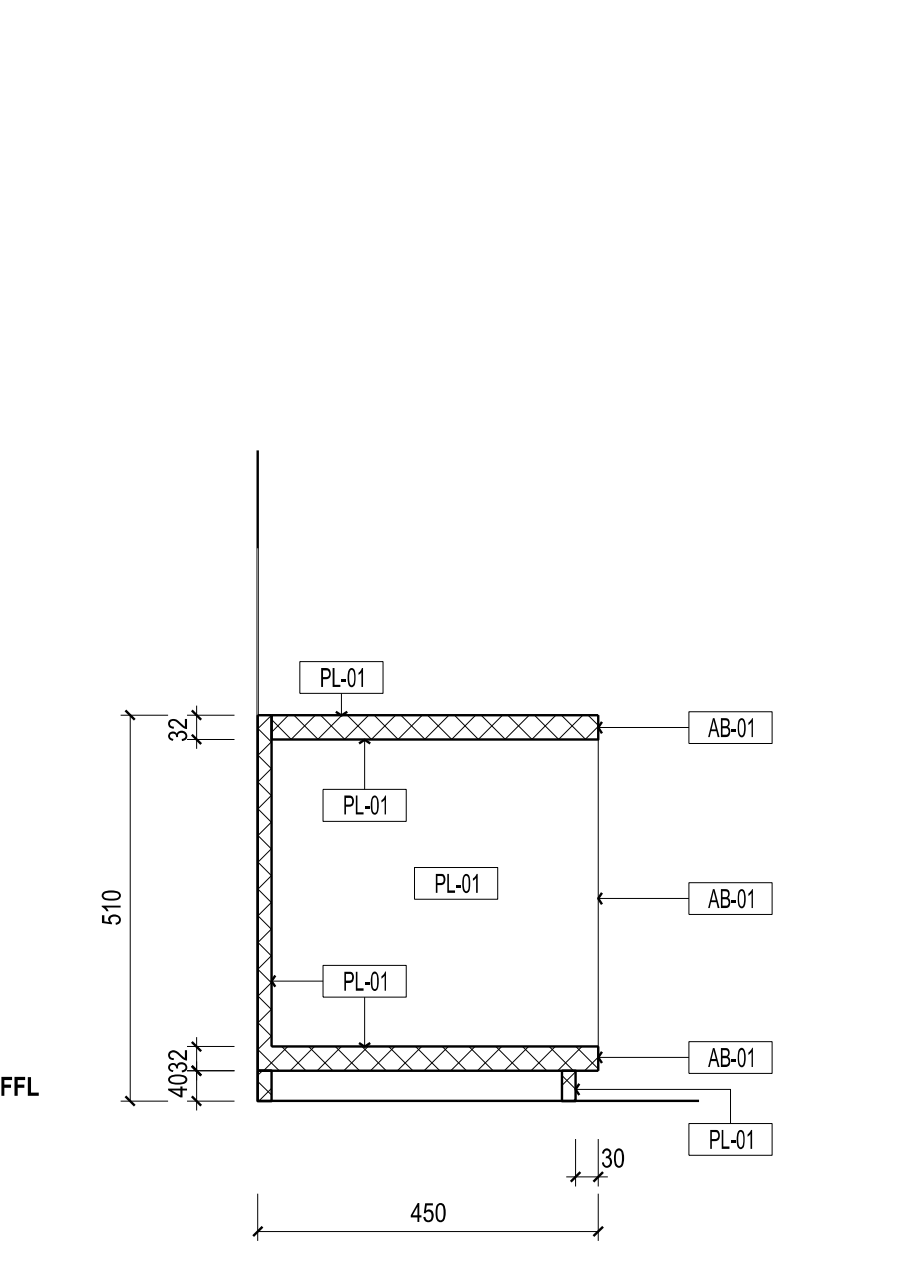

08 ELEVATION SCALE 1:10

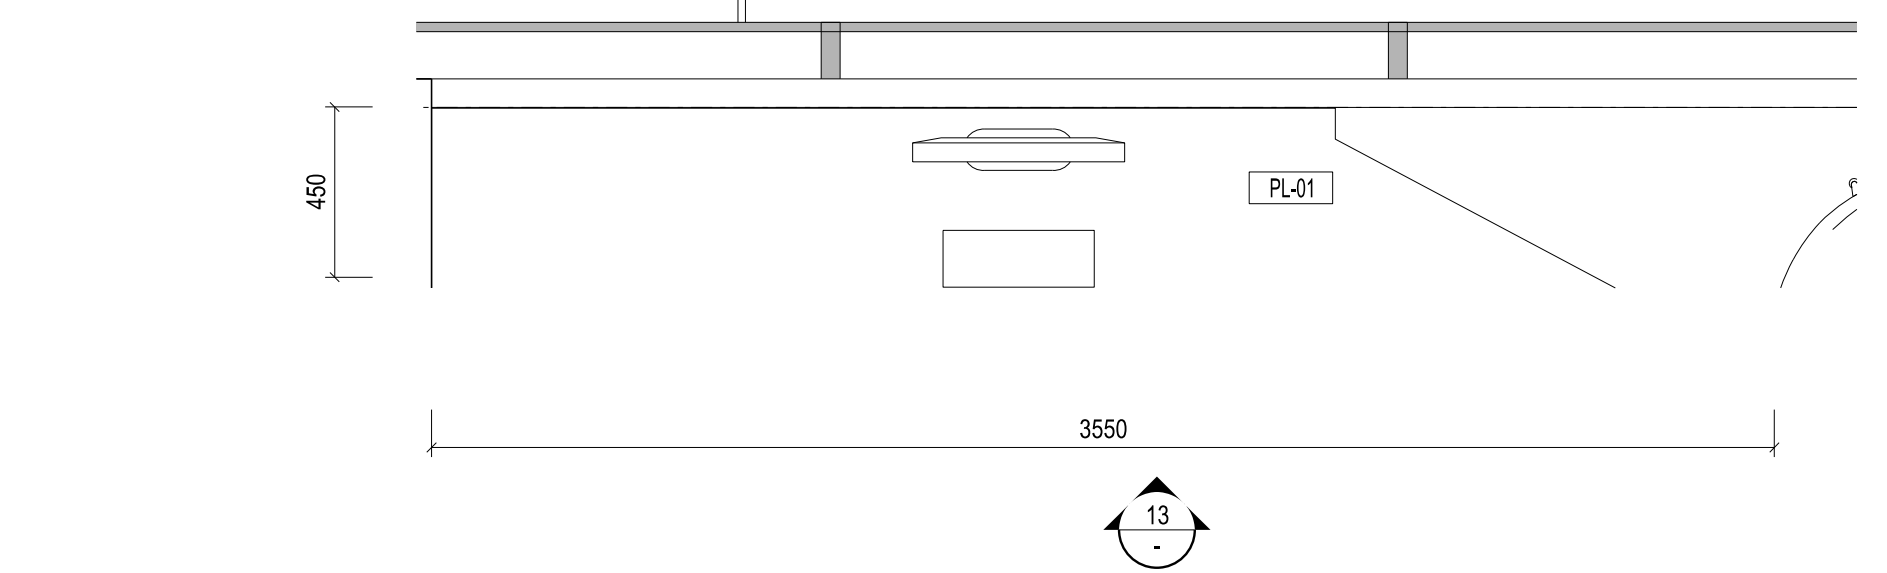

05 PLAN - WKS-18E - OFFICE STORAGE SCALE 1:20

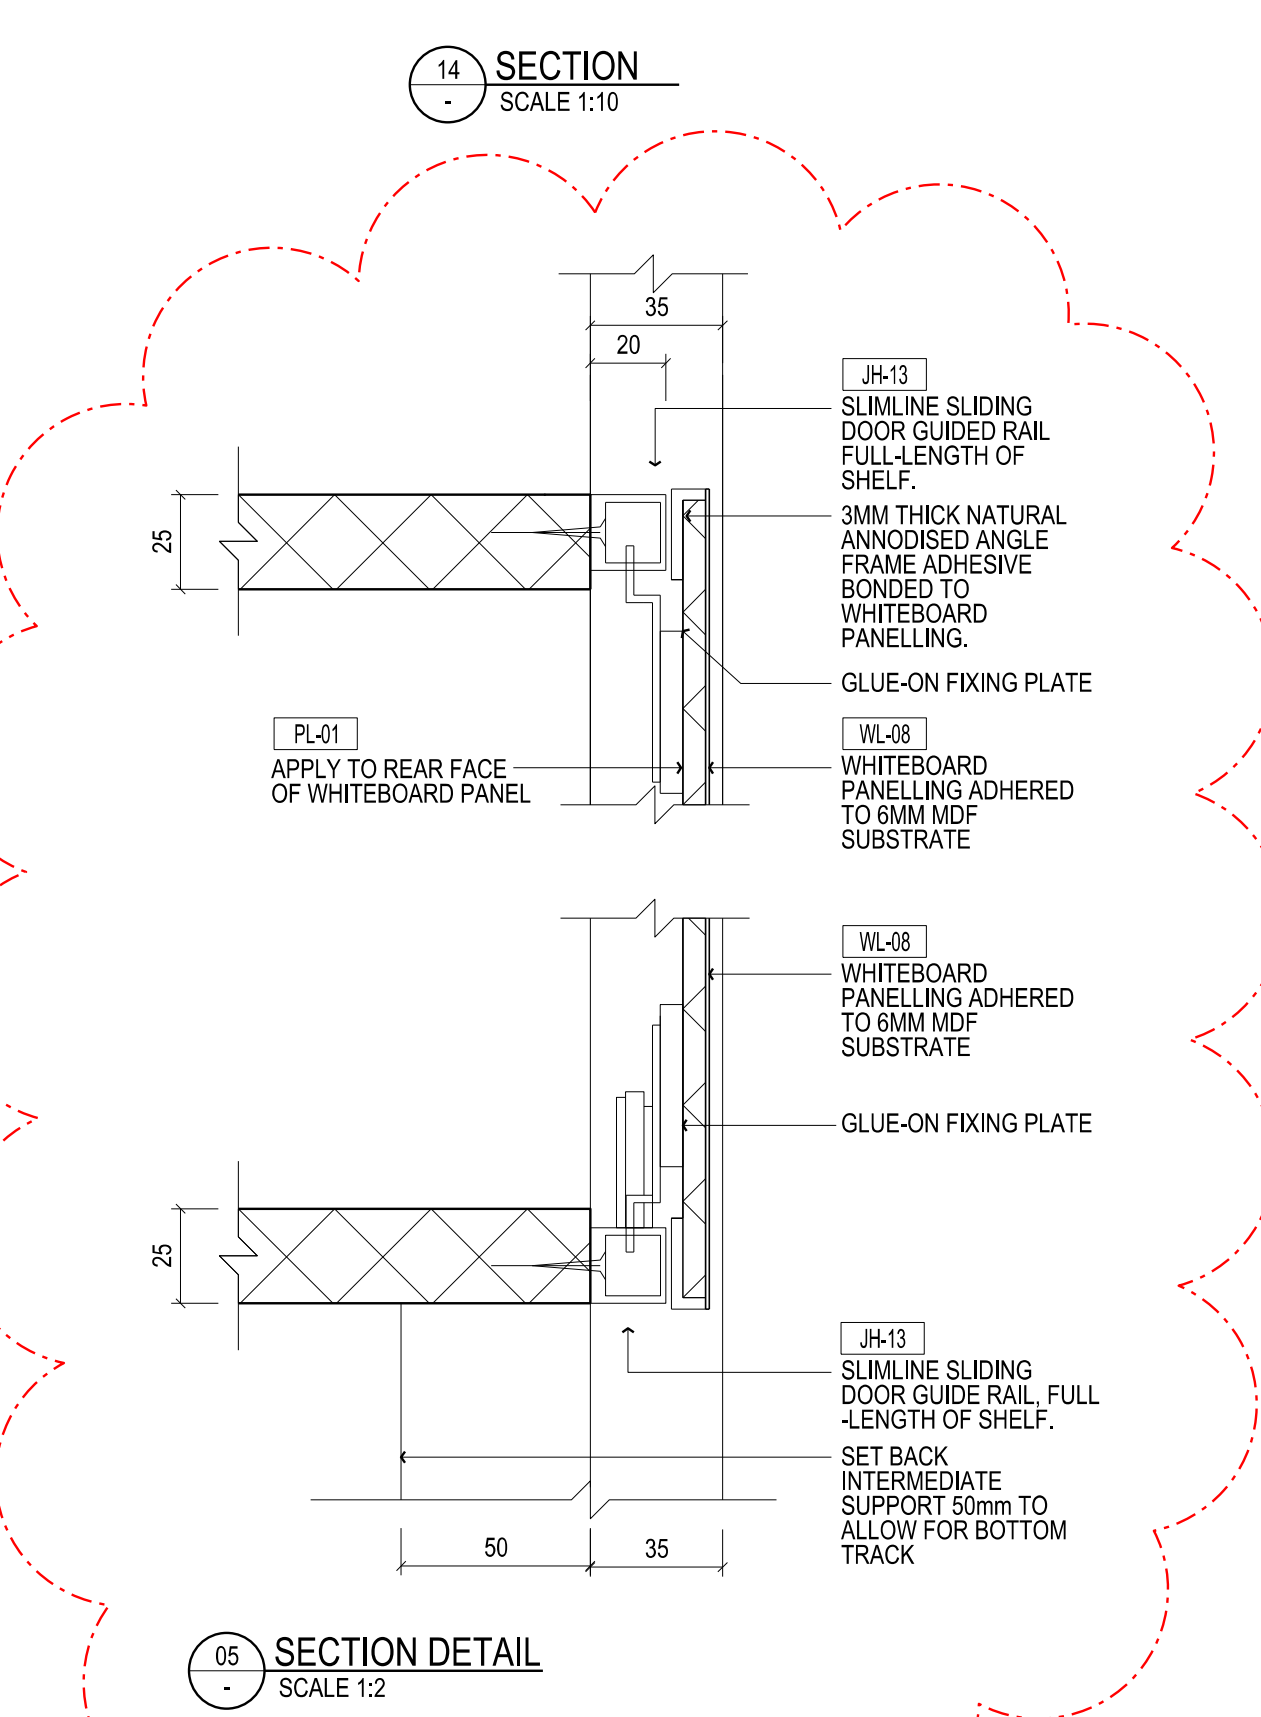

09 SECTION DETAIL SCALE 1:2

