


THIS DRAWING IS AN UNCONTROLLED COPY UNLESS STAMPED OTHERWISE


CONTRACTORS SHALL VERIFY JOB DIMENSIONS BEFORE ANY JOB COMMENCES. ALL SHOP DRAWINGS SHALL BE SUBMITTED TO THE SUPERINTENDENT AND MANUFACTURE SHALL NOT COMMENCE PRIOR TO THE RETURN OF DIMENSIONED SHOP DRAWINGS SIGNED BY THE CONSULTANT. DIMENSIONS SHALL TAKE PRECEDENCE OVER SCALES. THIS DRAWING SHOULD BE READ IN CONJUNCTION WITH ALL RELEVANT CONTRACT SPECIFICATIONS AND DRAWINGS COPYRIGHT OF THIS DRAWING IS VESTED IN WARDLE

General Notes ALL JOINERY TO REFER TO INTERIOR ELEVATIONS (AR7100 SERIES)

- 18mm E1 MDF CARCASS THROUGHOUT UNLESS OTHERWISE NOTED.
- ALL NON EXPOSED CARCASS TO BE MATCHING LAMINATE UNLESS OTHERWISE NOTED.
- ALL NON EXPOSED CARCASS TO BE BLACK LAMINATE TO JOINERY RECEIVING TIMBER VENEER FINISH. REFER MATERIALS SCHEDULE [PL05]
- ALL NON EXPOSED CARCASS TO BE WHITE LAMINATE TO JOINERY RECEIVING STAINLESS STEEL CLADDING. REFER MATERIALS SCHEDULE [PL01]
- ALL EXPOSED EDGES TO TIMBER VENEER PANELS TO RECEIVE 3mm THK MATCHING SOLID EDGES UNLESS OTHERWISE NOTED.
- SPLIT BATTENS TO BE 12mm UNLESS OTHERWISE NOTED.
- APPLY MATCHING LAMINATE ABS EDGING TO LAMINATED BENCHTOPS, UNLESS OTHERWISE NOTED
- REFER TO '1300 - MATERIALS SCHEDULE' FOR A DESCRIPTION OF THE MATERIAL CODES AS SHOWN ON THIS DRAWING. [TV02]
- REFER TO '1400 - FIXTURES, FITTINGS & EQUIPMENT SCHEDULE' FOR A DESCRIPTION OF THE FF&E CODES AS SHOWN ON THIS DRAWING. [E000]
- ALL JOINERY LOOKS TO BE [PL02] UNLESS OTHERWISE NOTED.
- REFER TO DRAWING AR7300 FOR MOUNTING HEIGHTS FOR ALL SERVICES FIXTURES, UNLESS OTHERWISE DIMENSIONED ON THE JOINERY ELEVATIONS.
- ALL CORNER JUNCTIONS TO BE MITRED UNLESS OTHERWISE NOTED.
- ALL UPHOLSTERY STITCHING TOO MATCH FABRIC COLOUR UNLESS OTHERWISE NOTED
- DRAWINGS TO BE READ IN CONJUNCTION WITH AR1200 SERIES INTERNAL ARRANGEMENT PLANS TO COORDINATE FIXINGS INTO PARTITIONS WHERE NECESSARY
- FS = FIXED SHELF
- AS = ADJUSTABLE SHELF
- FP = FIXED PANEL
- PJ = PANEL JOIN, MAXIMUM WIDTH 2mm
- C.O.S = CHECK ON SITE - DIMENSIONS MUST BE VERIFIED ON SITE BY CONTRACTOR PRIOR TO COMMENCEMENT OF CONSTRUCTION.
- NOM. = NOMINAL
- TYP. = TYPICAL
- SIM. = SIMILAR
- MIRR. = MIRROR
- FCL = FINISHED CEILING LEVEL
- FFL = FINISHED FLOOR LEVEL
- SLL = STRUCTURAL SLAB LEVEL
- C = CENTRELINE
- DIRECTION OF GRAIN / LINISH

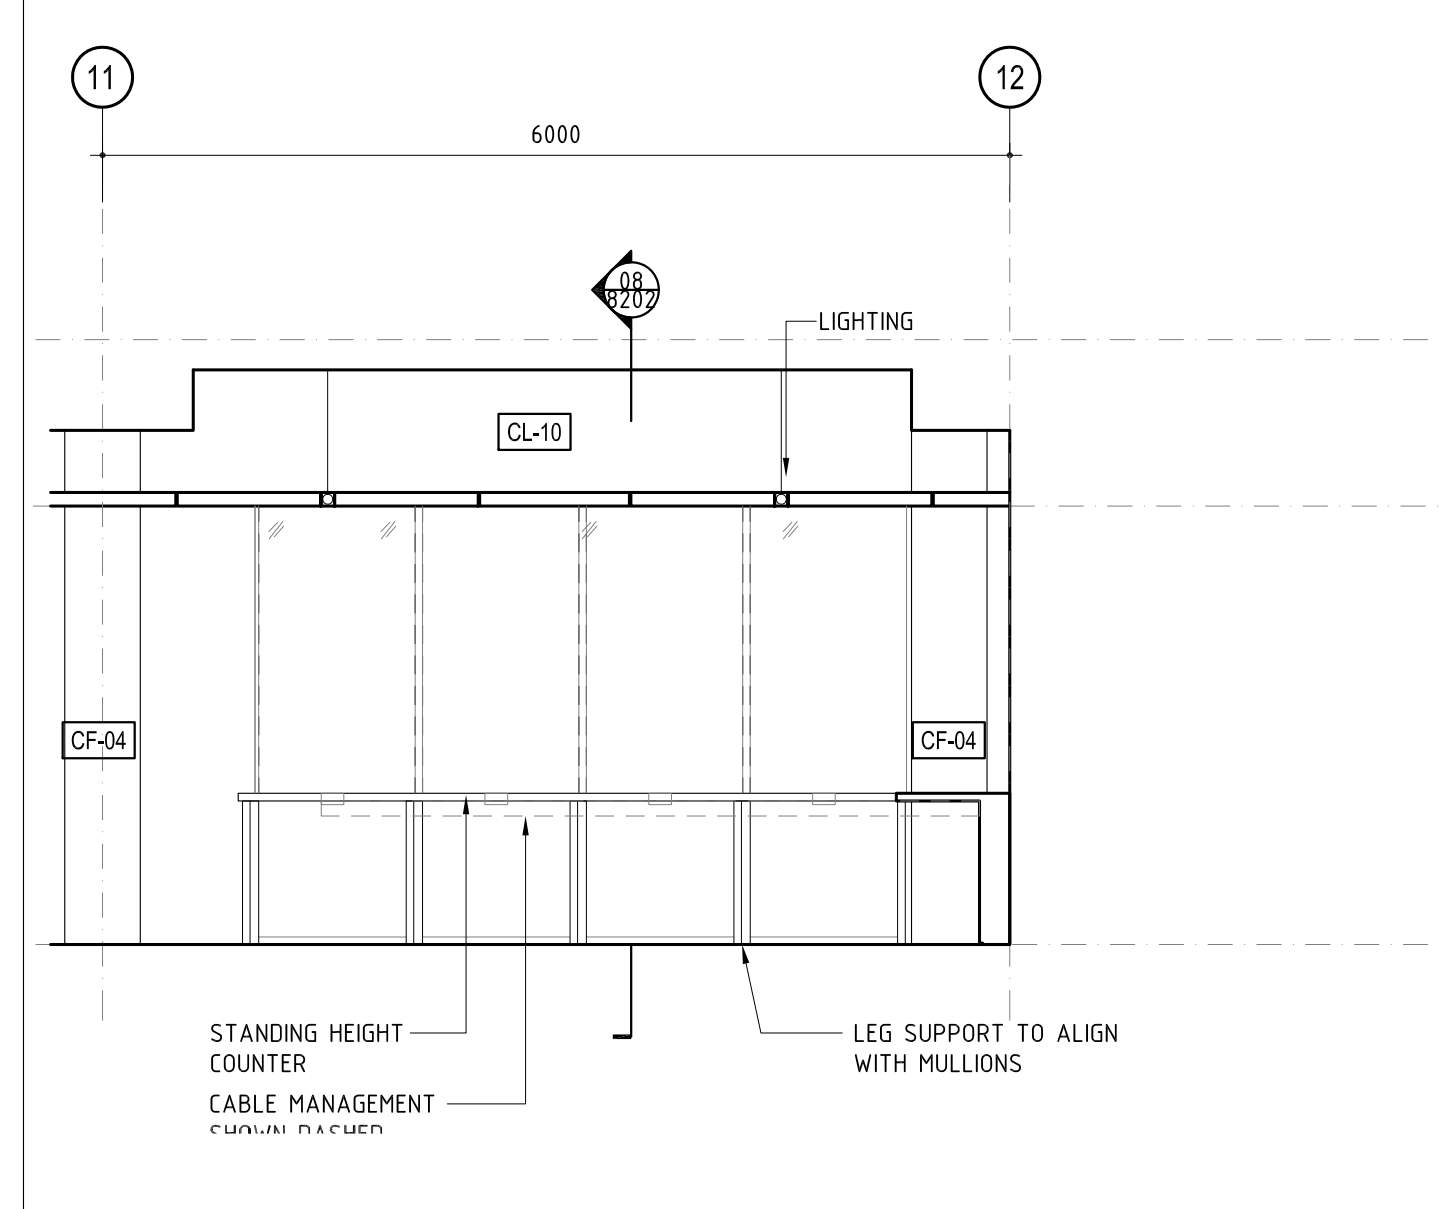


18 J02-22, J02-23 - MSD LOUNGE - JOINERY ELEVATION SCALE 1:50

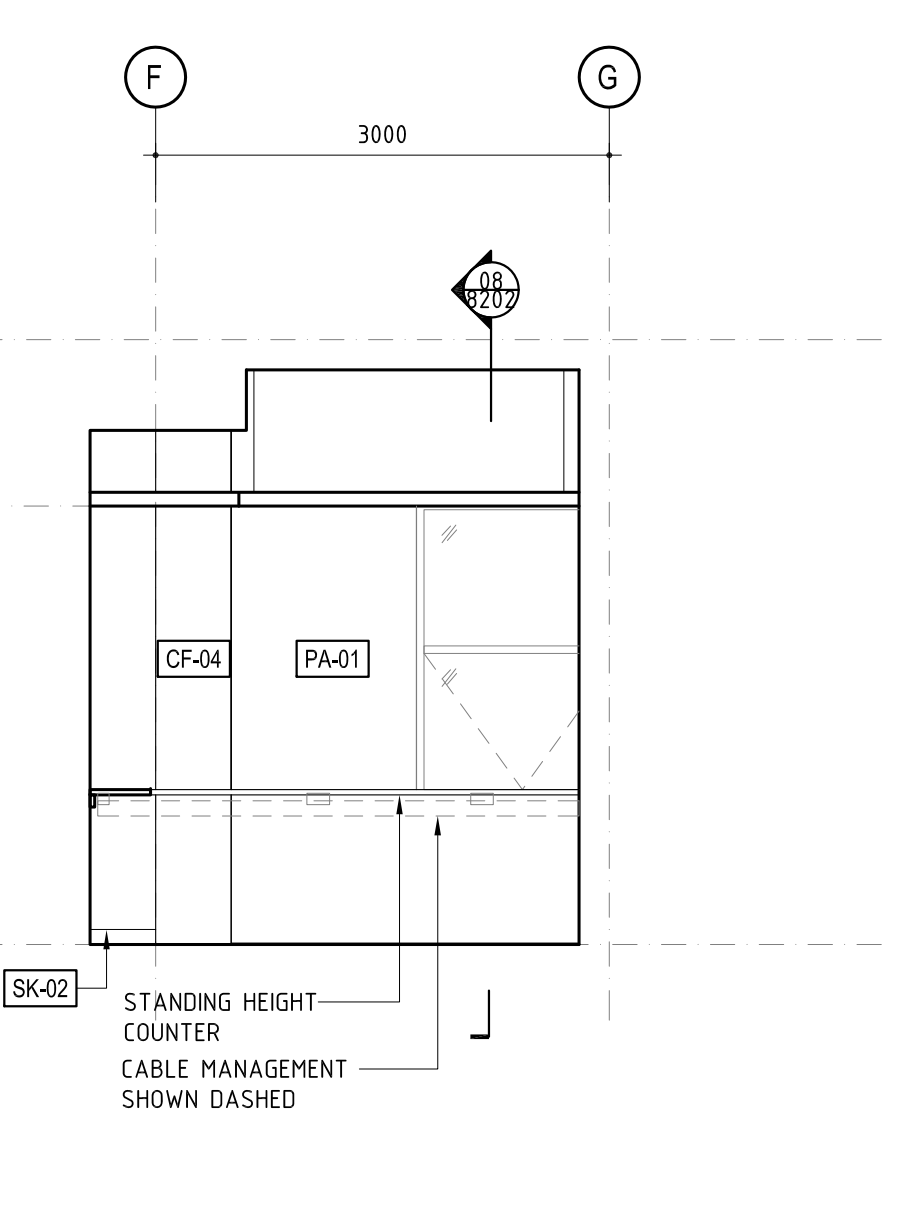


15 J02-22 - MSD LOUNGE - JOINERY ELEVATION SCALE 1:50


14 NOT USED

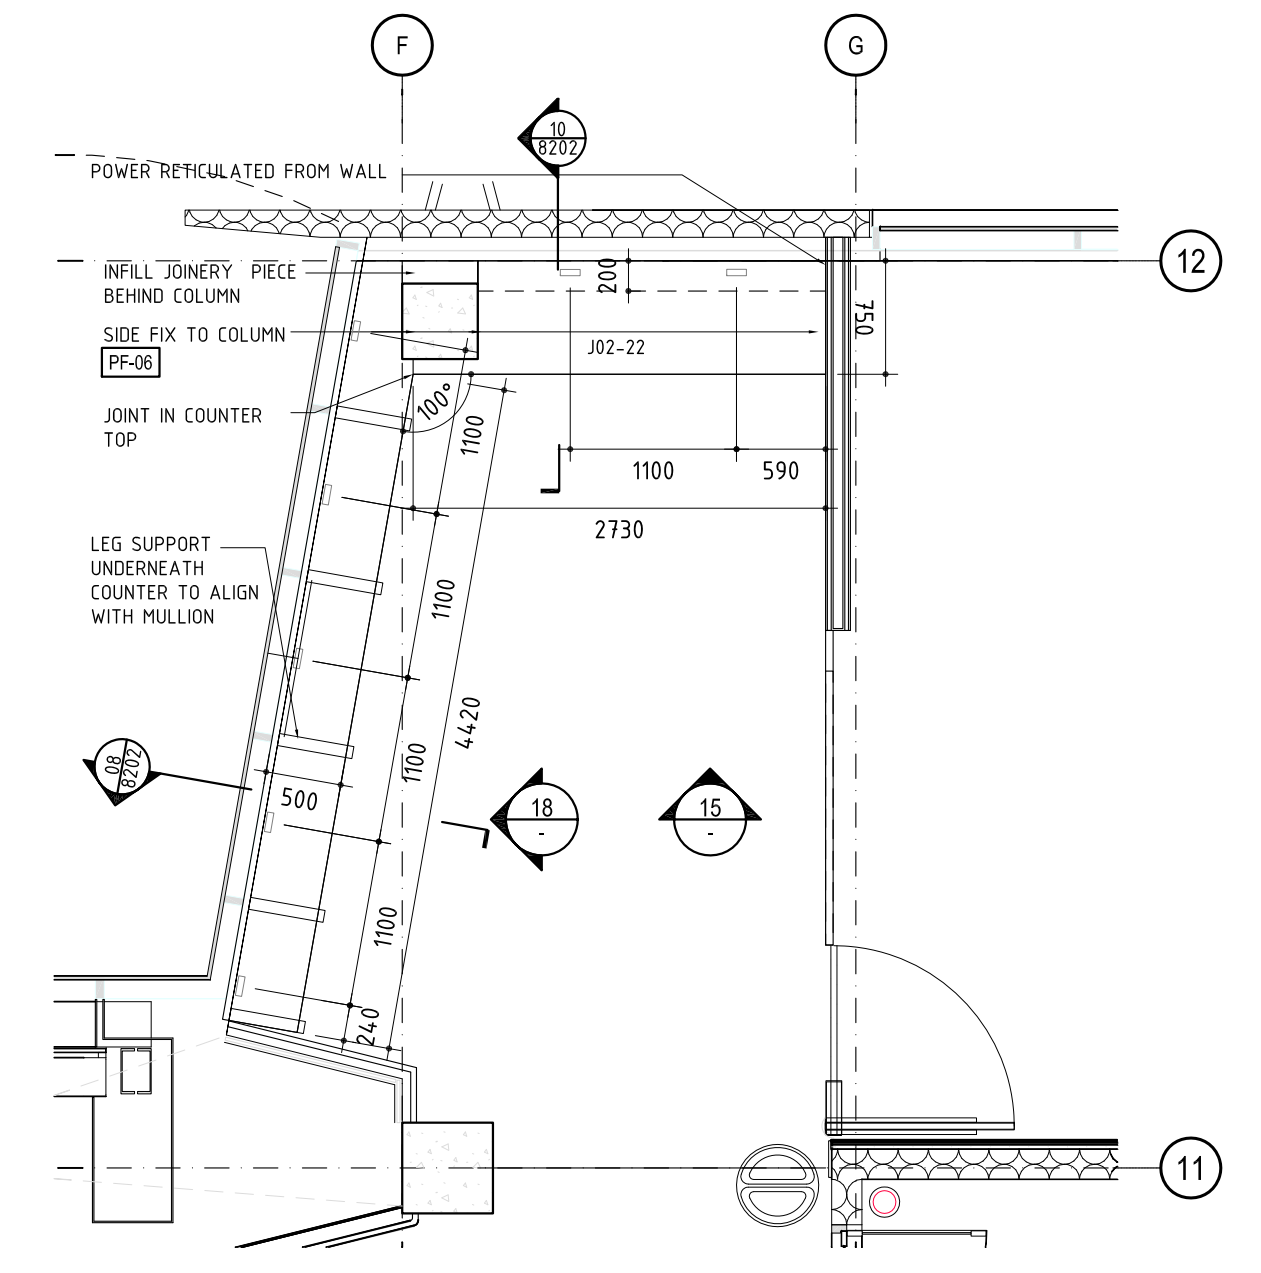


13 J02-22 - INFORMAL STUDY AREA - JOINERY PLAN SCALE 1:50

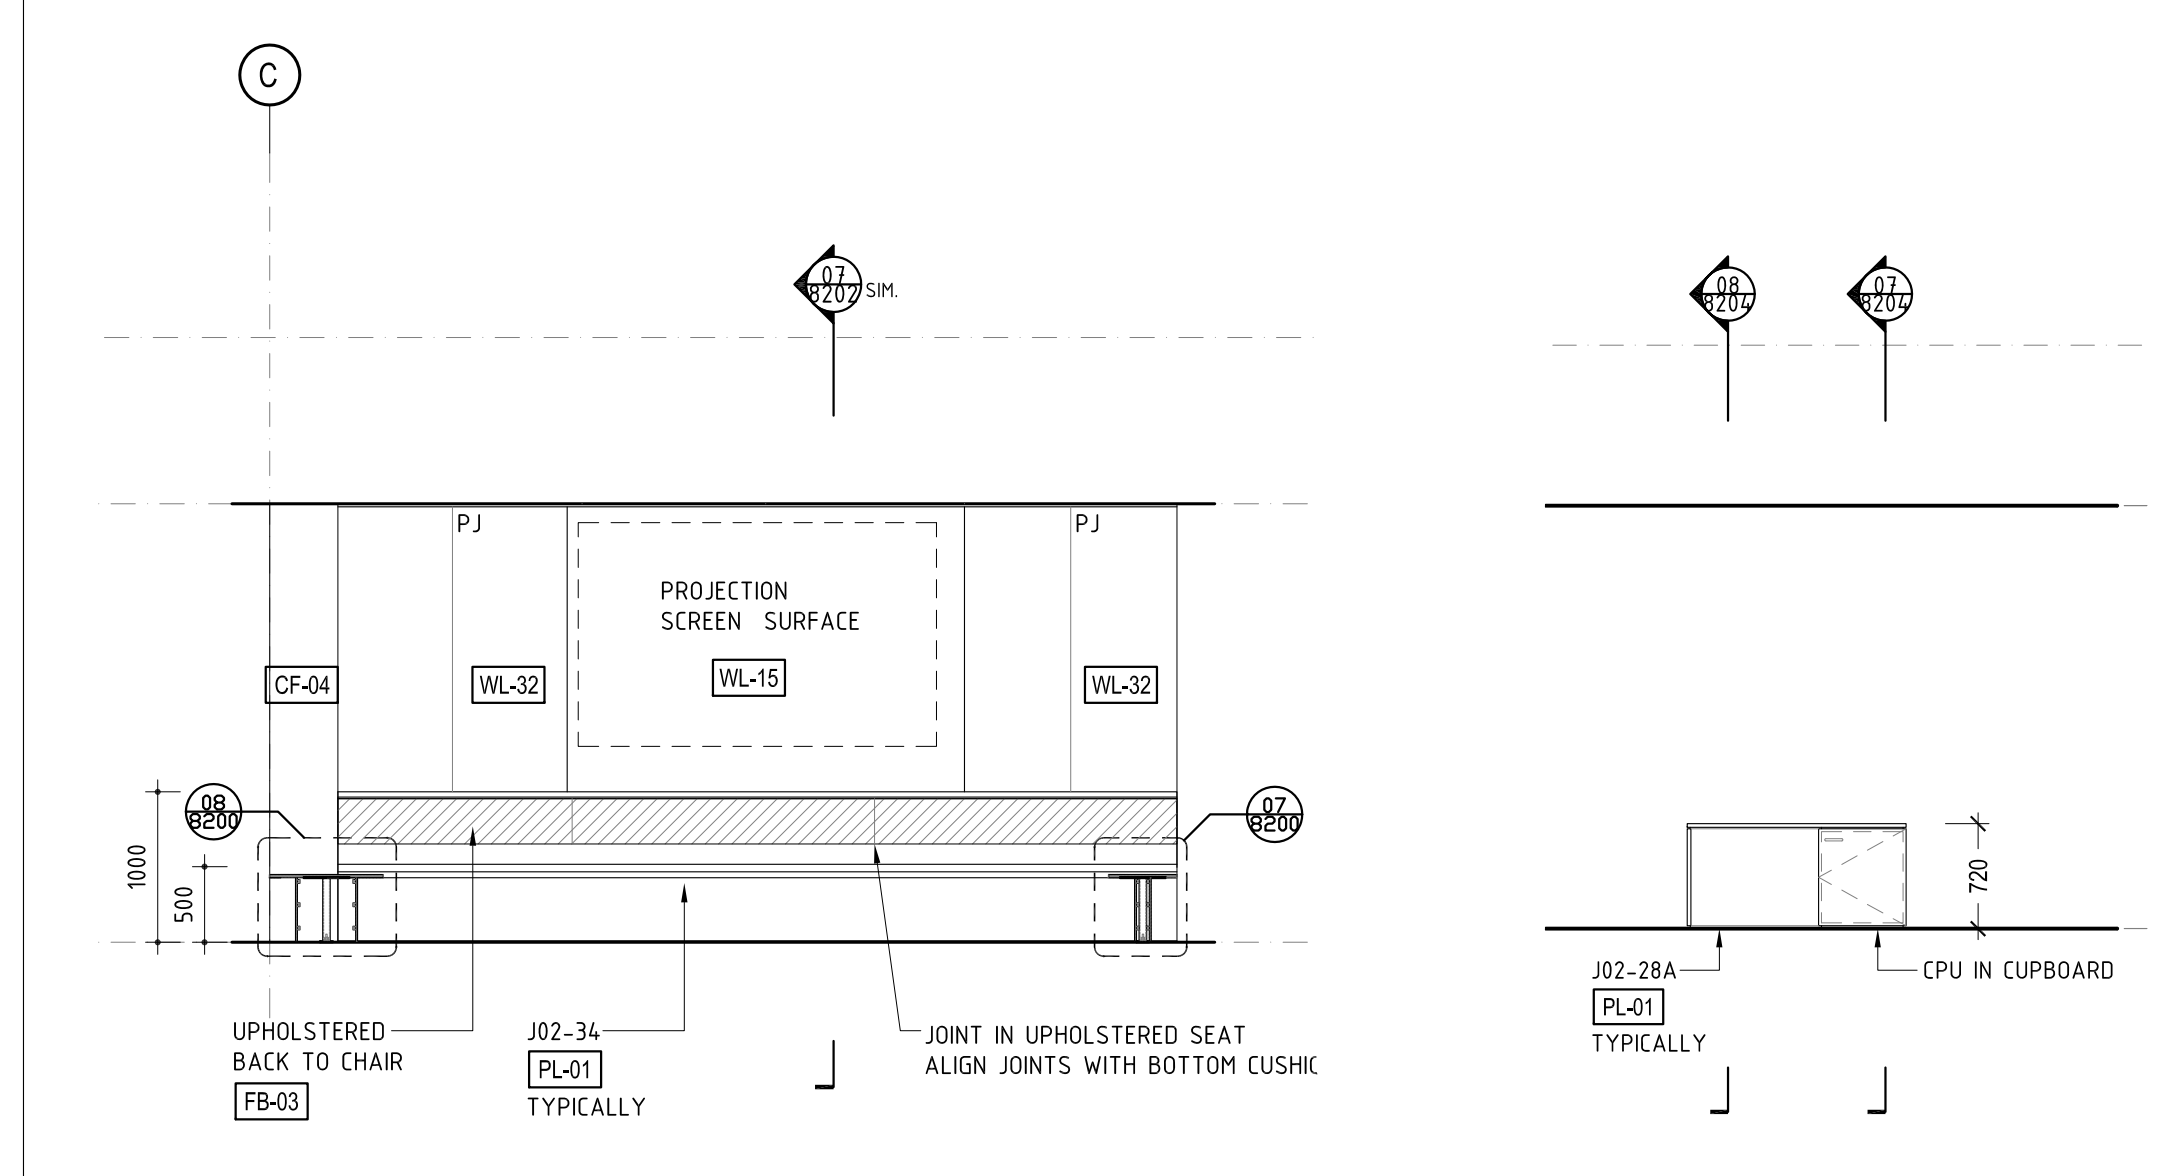


12 J02-34 - JOINERY ELEVATION SCALE 1:50

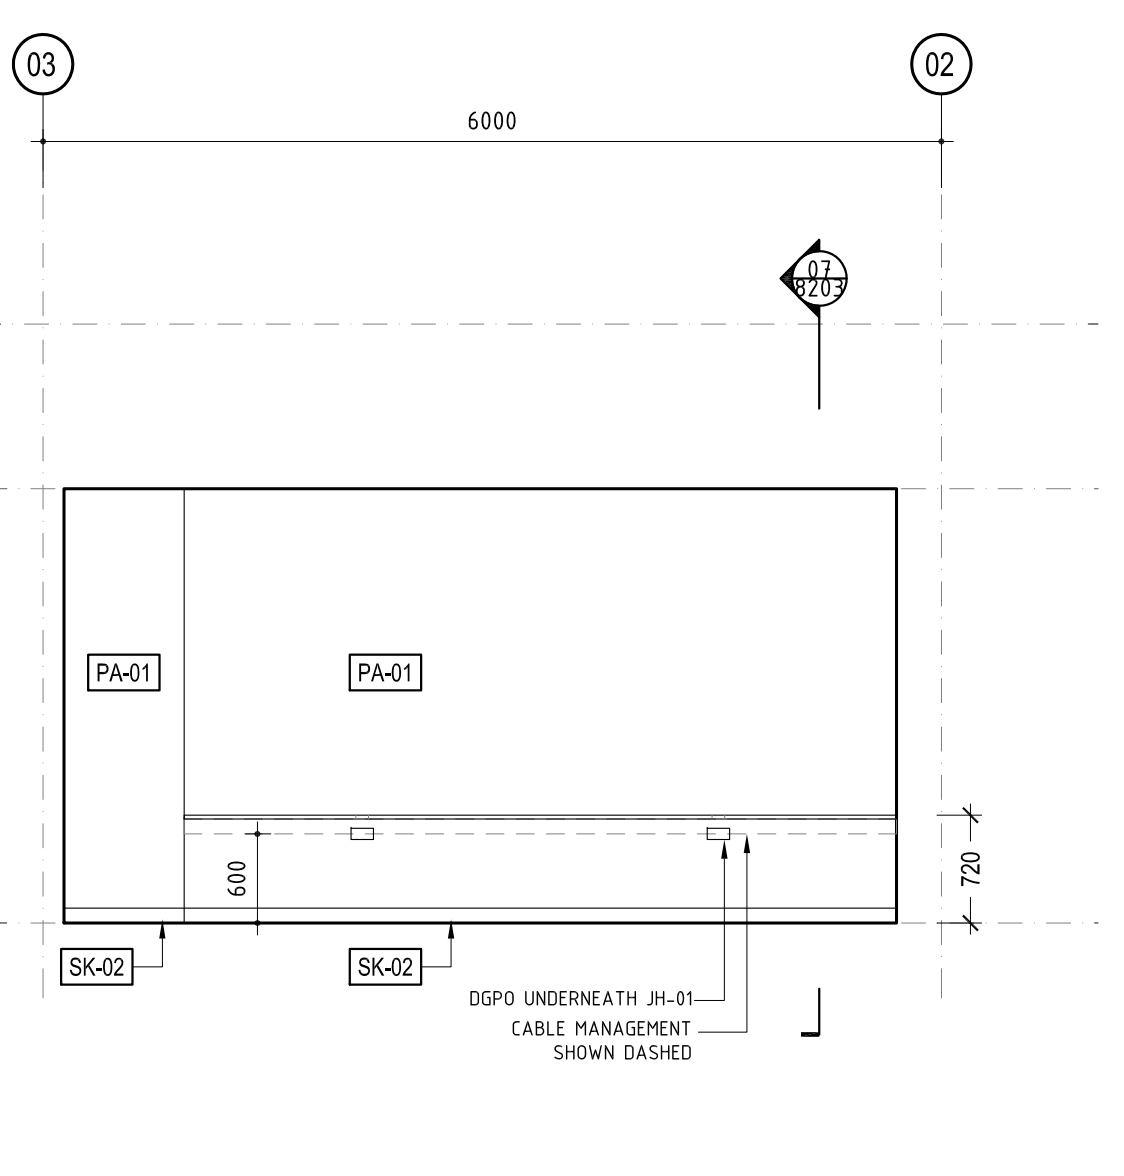


11 J02-28A - JOINERY ELEVATION SCALE 1:50

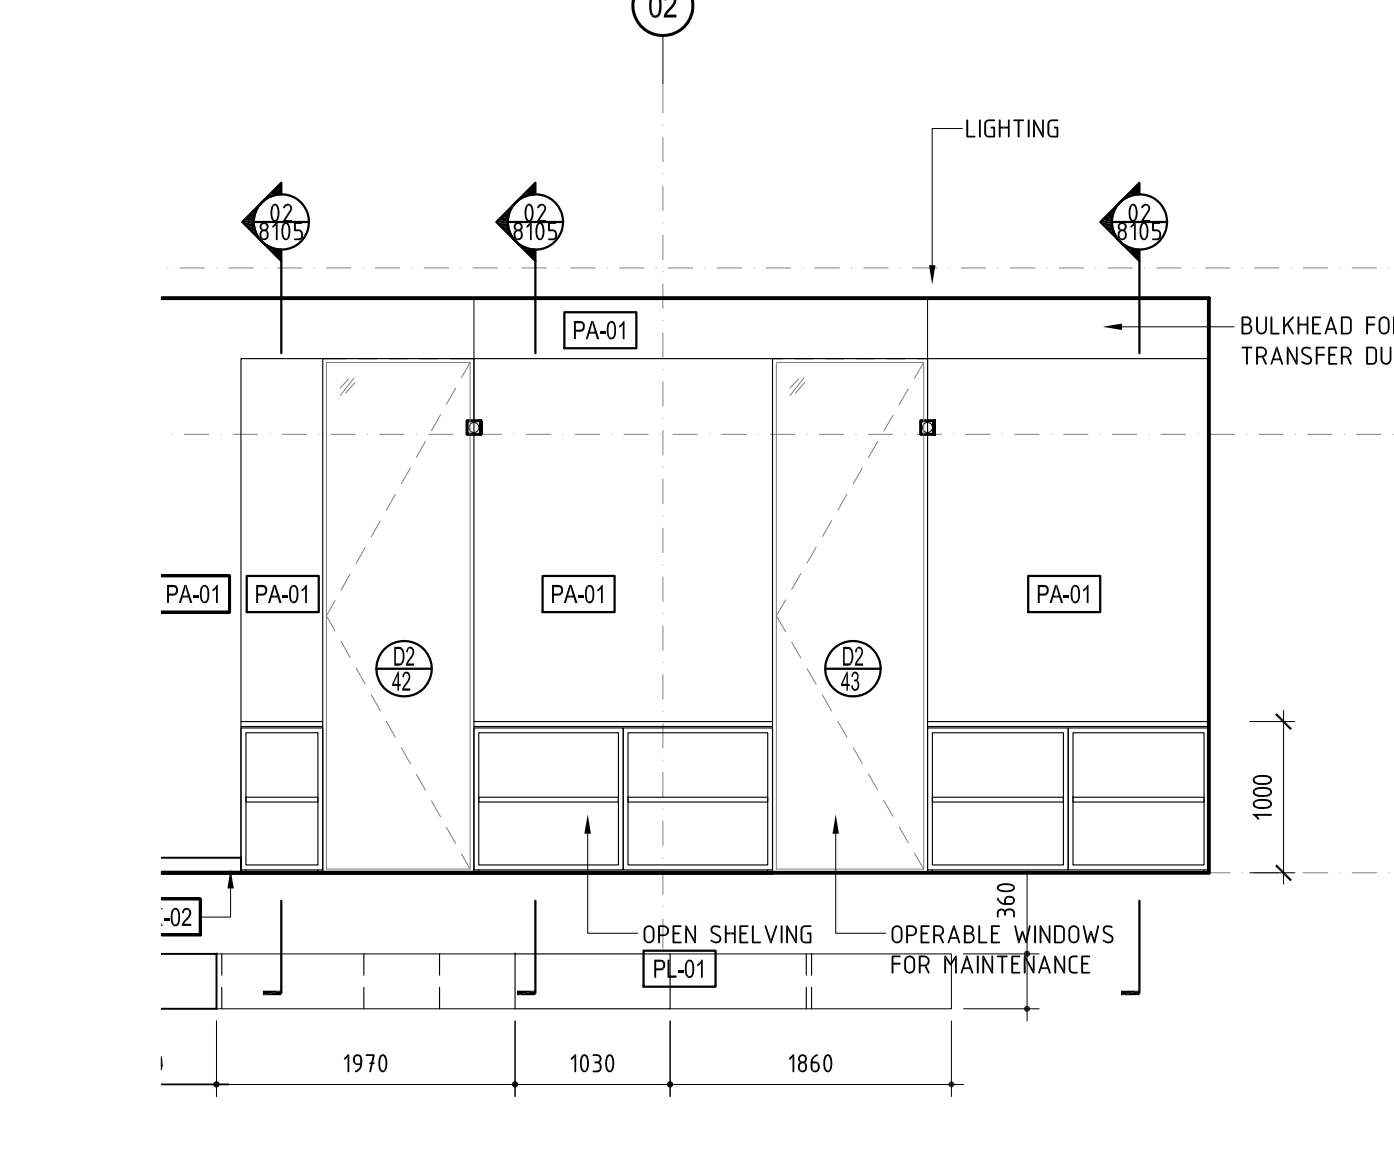


09 J02-28B - JOINERY ELEVATION SCALE 1:50

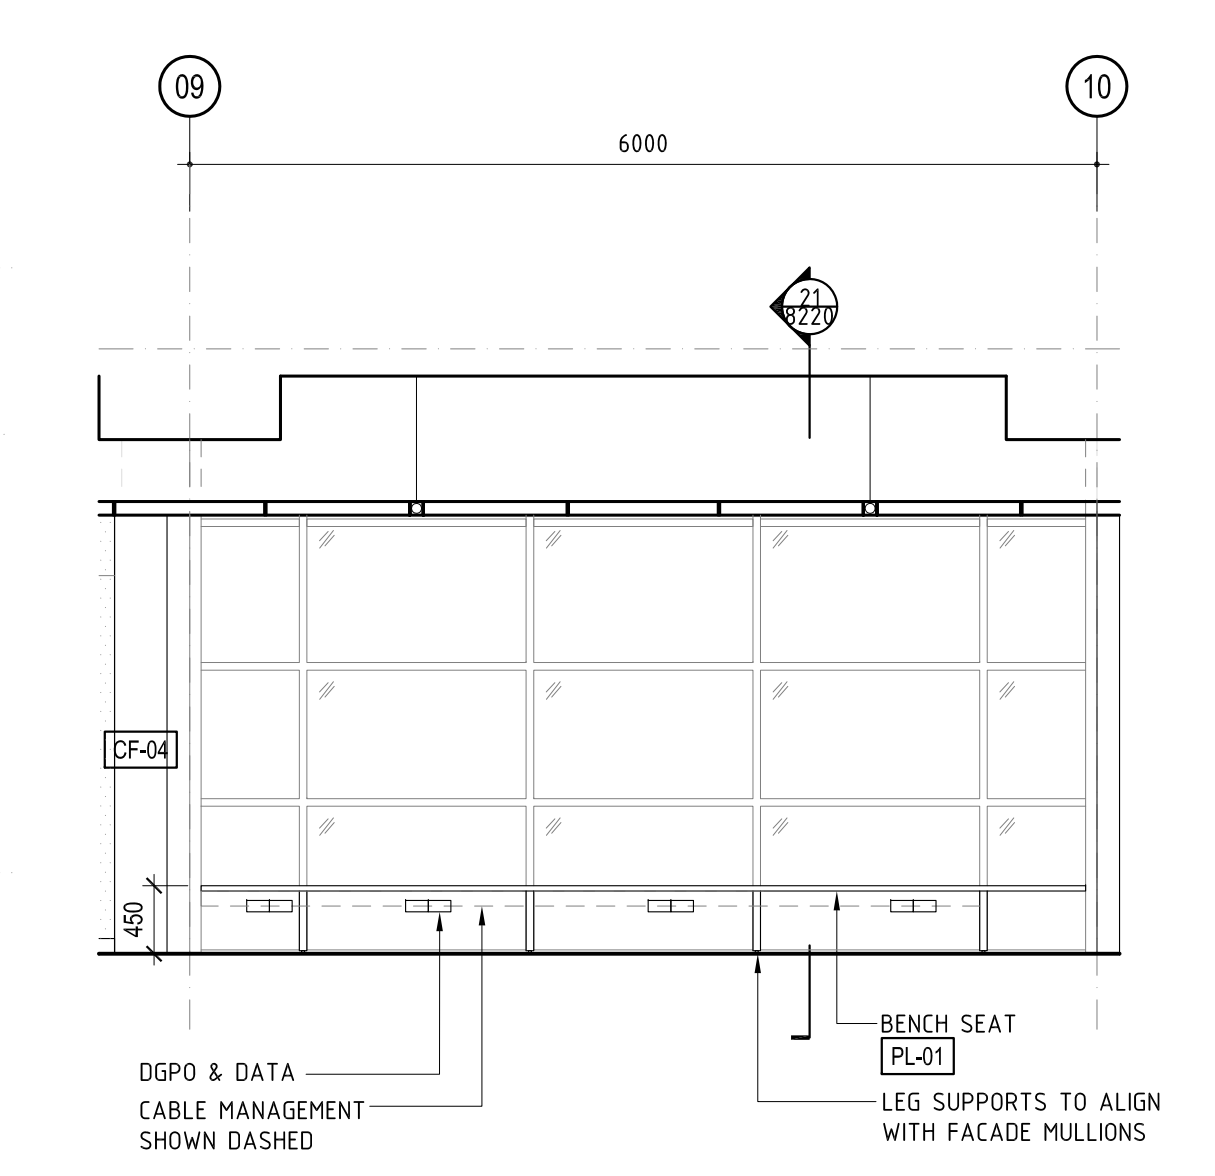


08 J02-20 - JOINERY ELEVATION SCALE 1:50

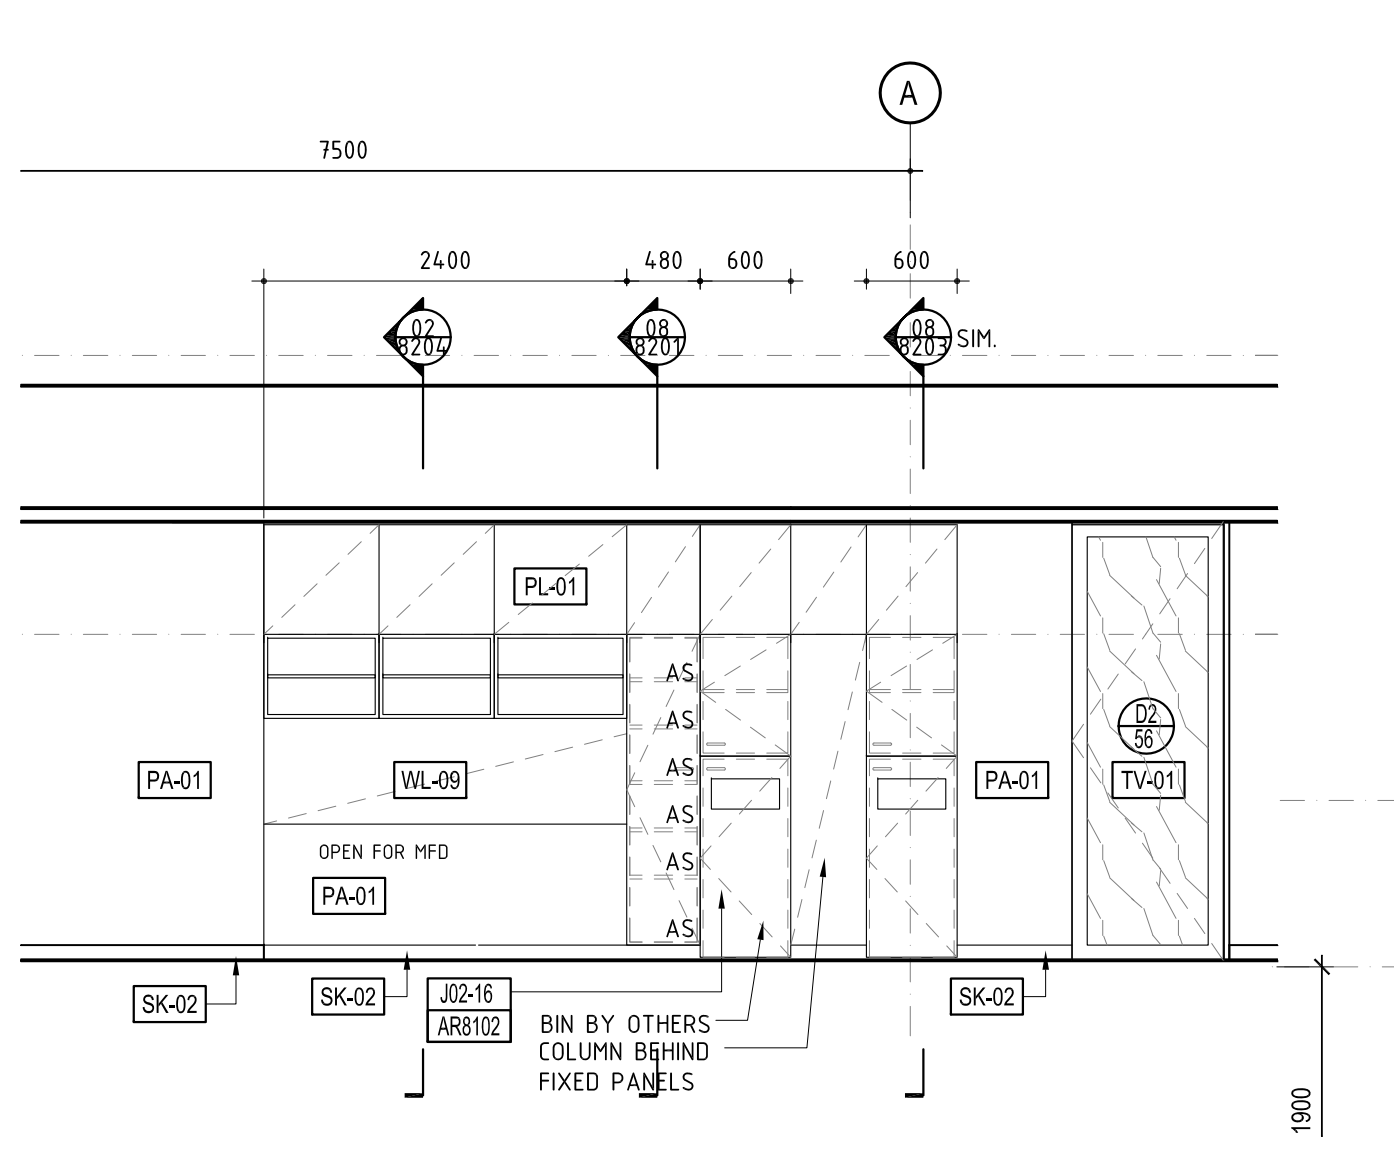


07 J02-16 - JOINERY ELEVATION SCALE 1:50

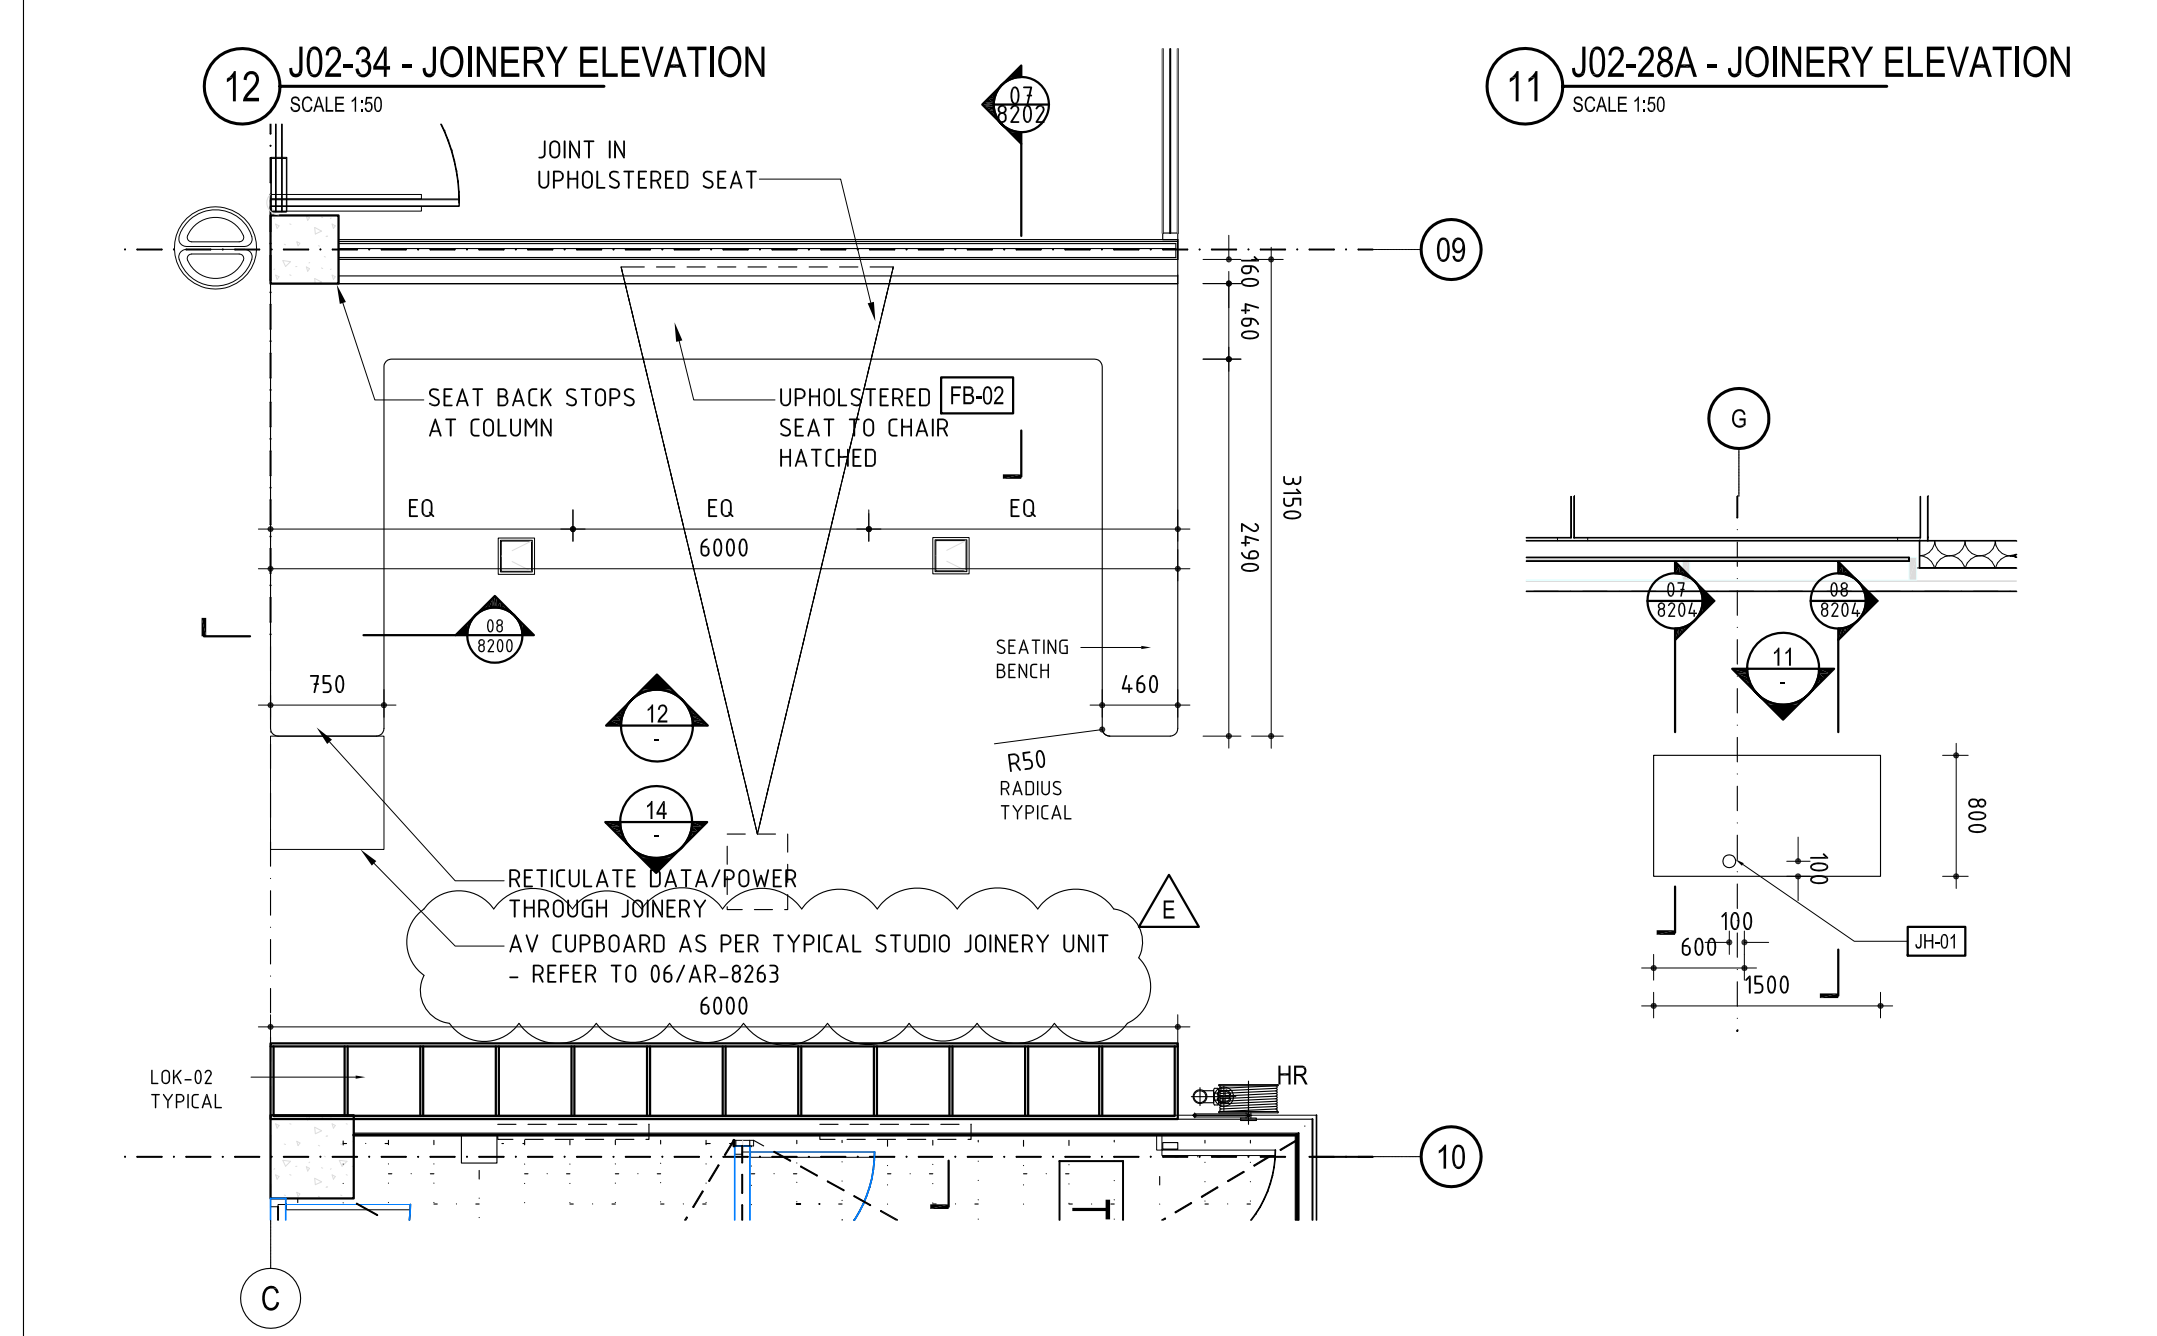


06 J02-34 - JOINERY PLAN SCALE 1:50

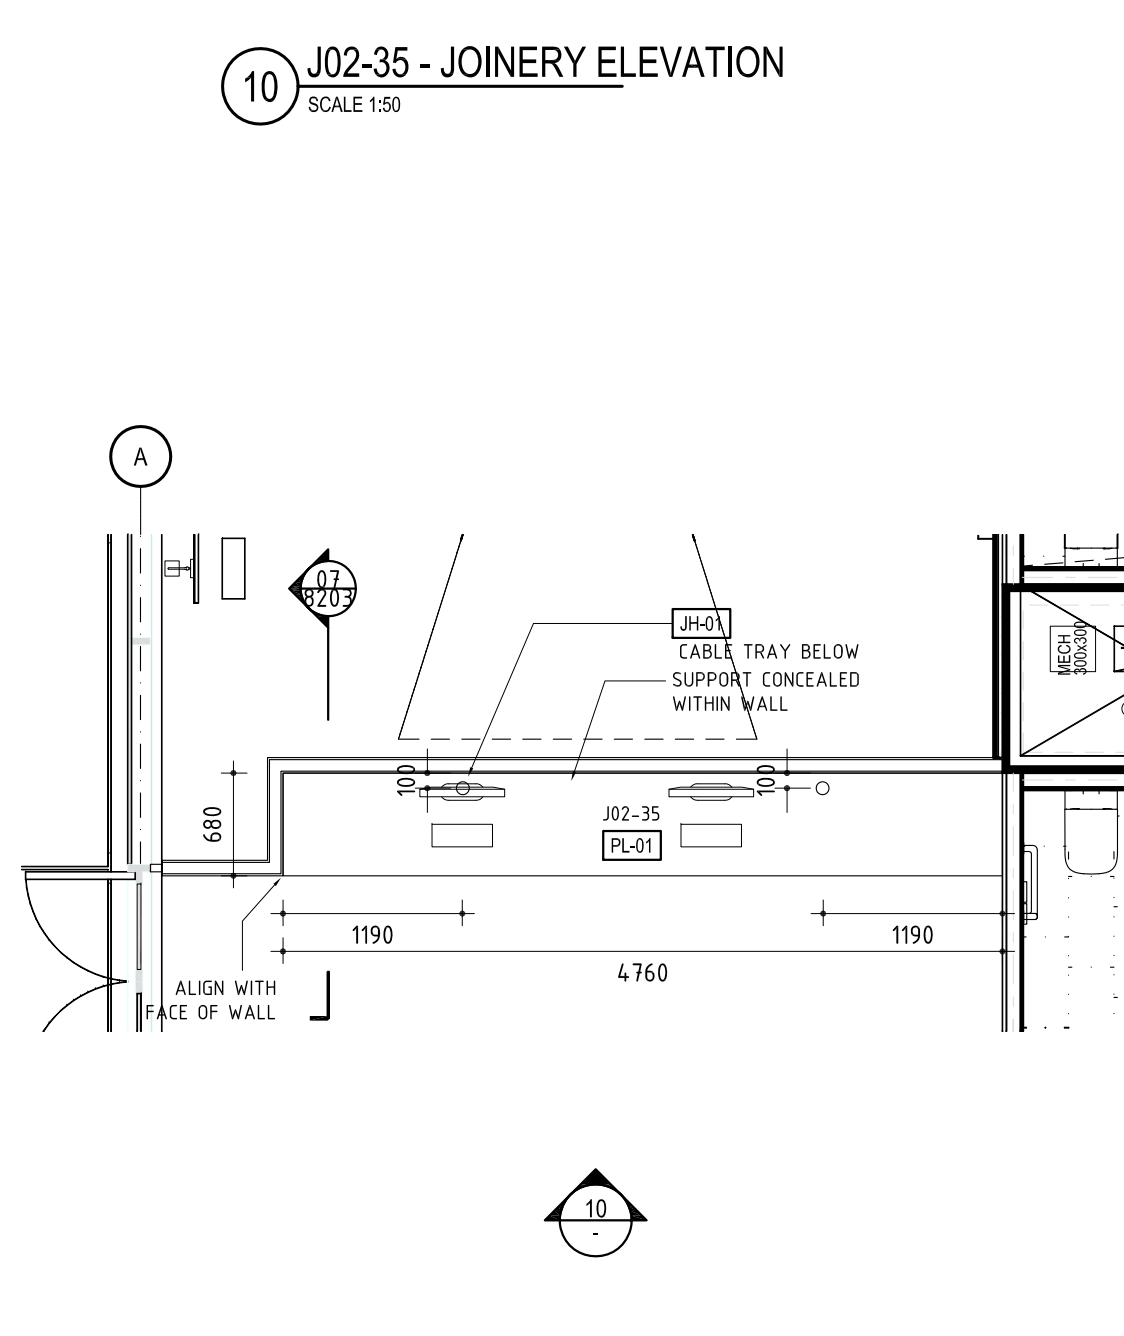


05 J02-28A - JOINERY PLAN SCALE 1:50

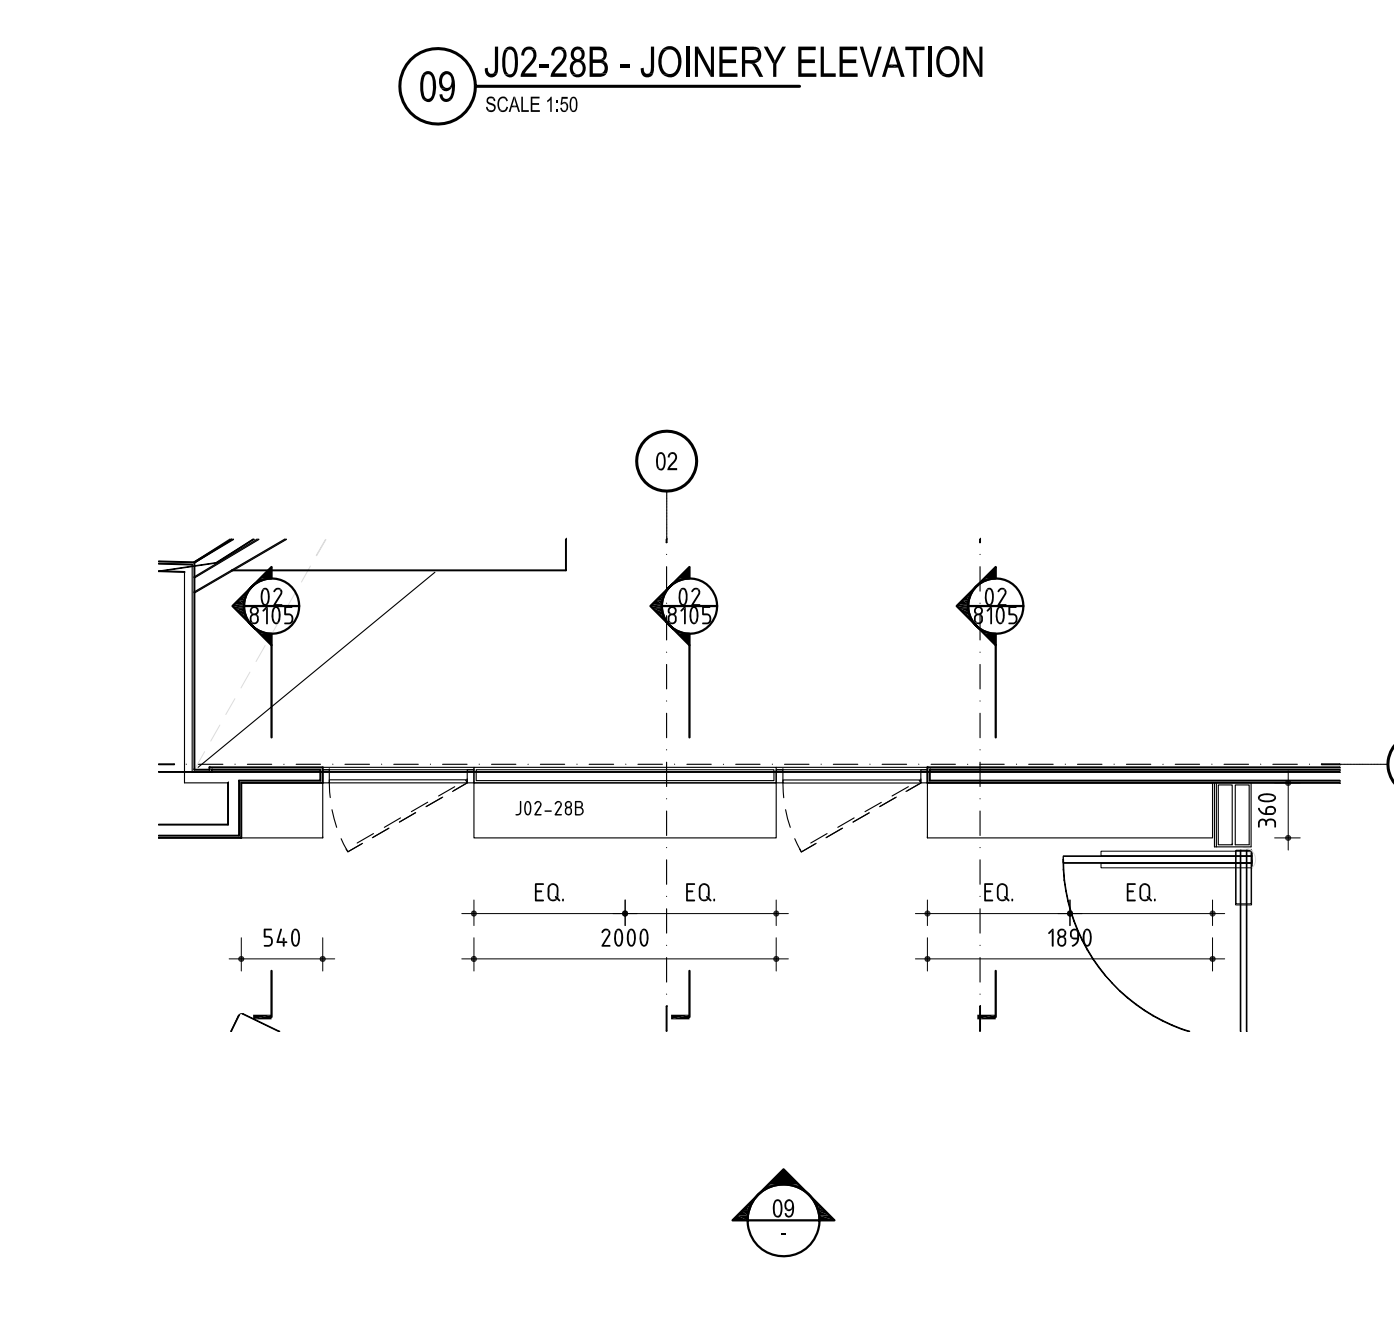

04 J02-28B - JOINERY PLAN SCALE 1:50

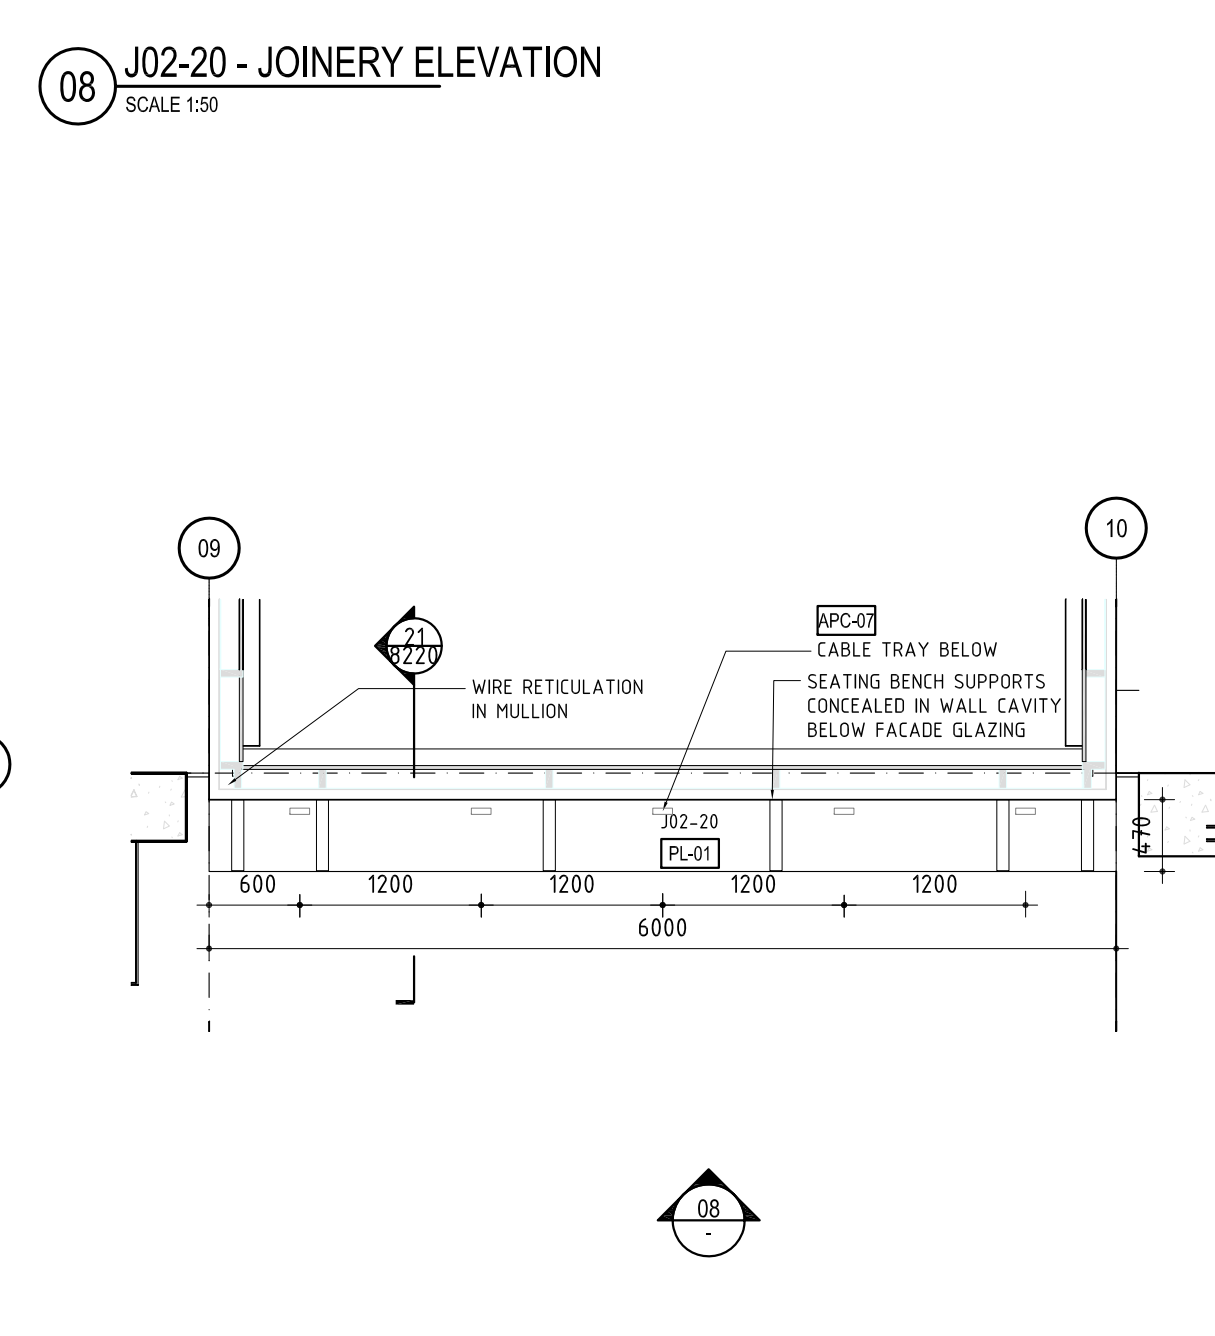


02 J02-20 - SEATING BENCH - JOINERY PLAN SCALE 1:50

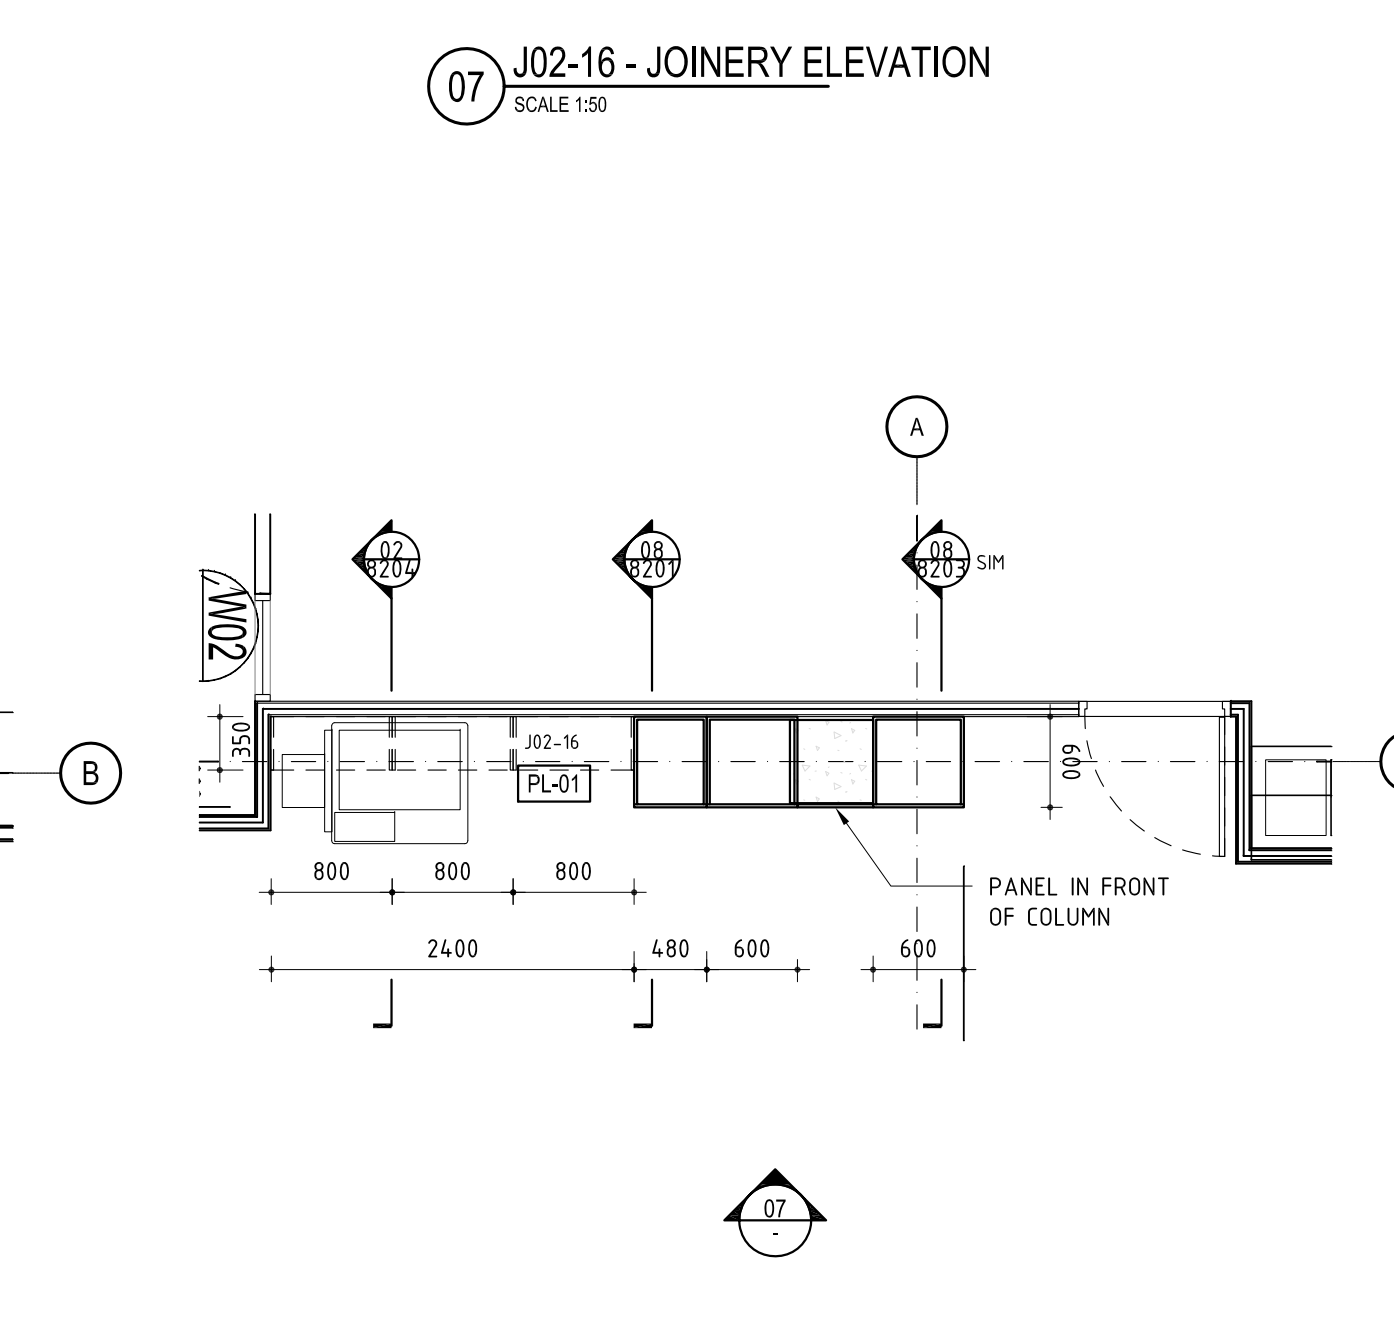

01 J02-16 - JOINERY PLAN SCALE 1:50

Rev	Issue	Revision Description	Amt	Date
E	SG	UPDATE AS CLOUDED	-	15.04.14
D	SG	UPDATE AS CLOUDED	-	05.04.14
C	SG	UPDATE AS CLOUDED	-	17.03.14
B	SG	UPDATE AS CLOUDED	-	17.03.14
A	SG	CONSTRUCTION ISSUE	-	18.12.13
04	SG	VALUE MANAGEMENT ISSUE	-	28.03.13
03	JC	100% CD - TENDER ISSUE	-	07.09.12
02	JC	90% CD ISSUE	-	10.06.12
01	JC	75% CD ISSUE	-	13.07.12

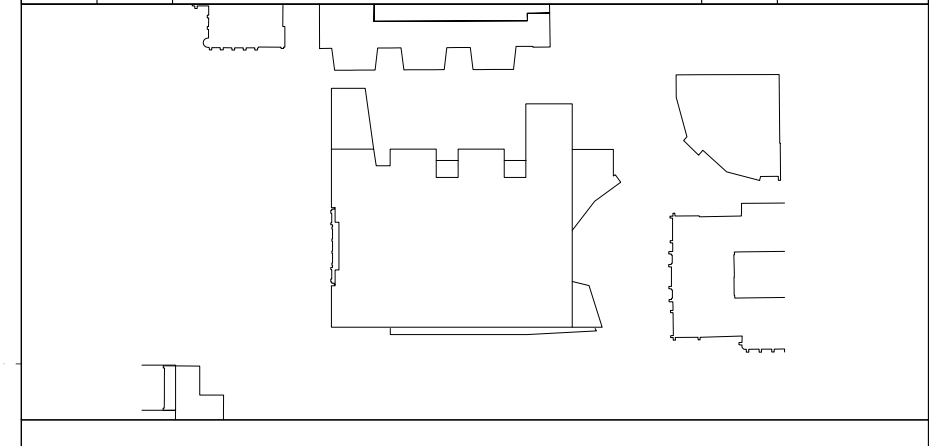

NADAAA
 NADAAA
 +1 520 442 2232
 Street No.2
 Boston
 Massachusetts
 02118 USA
 Telephone
 +1 617 442 2232
 Fax
 +1 617 442 1417
 Email
 nad@nadaaa.com

John Wardle Architects
 25 Rokeby Street, Collingwood Victoria 3066 Australia
 Tel: +61 3 8662 0400 www.johnwardlearchitects.com
 © 2014 John Wardle Architects ABN 83 006 814 268

Client	University of Melbourne Parkville Campus		
Project	Faculty of Architecture Building and Planning		
Title	JOINERY PLANS & ELEVATIONS L02		
Project No.	0913	Scale	1:50 @ A0
Drawing No.	AR8102	Revision	E
Date	APR 2014	Drawn	JJ
Co-Ord	AC	Chk	SG
FILENAME	-0000		
FOR CONSTRUCTION			