


THIS DRAWING IS AN UNCONTROLLED COPY UNLESS STAMPED OTHERWISE

CONTRACTORS SHALL VERIFY JOB DIMENSIONS BEFORE ANY JOB COMMENCES
ALL SHOP DRAWINGS SHALL BE SUBMITTED TO THE SUPERINTENDENT AND MANUFACTURER
SHALL NOT COMMENCE PRIOR TO THE RETURN OF DIMANDED SHOP DRAWINGS
BY THE CONSULTANT. FOUND DIMENSIONS SHALL TAKE PRECEDENCE OVER THESE. THIS
DRAWING SHOULD BE READ IN CONJUNCTION WITH ALL RELEVANT CONTRACT SPECIFICATIONS
AND DRAWINGS COPYRIGHT OF THIS DRAWING IS VESTED IN WARDLE

General Notes

DRAWING SUPERCEDED -
REFER TO AR-8263

C	SG	DRAWING SUPERCEDED REFER TO AR-8263	-	07.04.14
B	SG	UPDATE AS CLOUDED	-	03.03.14
A	SG	CONSTRUCTION ISSUE	-	19.12.13
04	SG	VALUE MANAGEMENT ISSUE	-	28.03.13
03	JC	100% CD - TENDER ISSUE	-	07.09.12
02	JC	90% CD ISSUE	-	10.06.12
01	JC	75% CD ISSUE	-	13.07.12

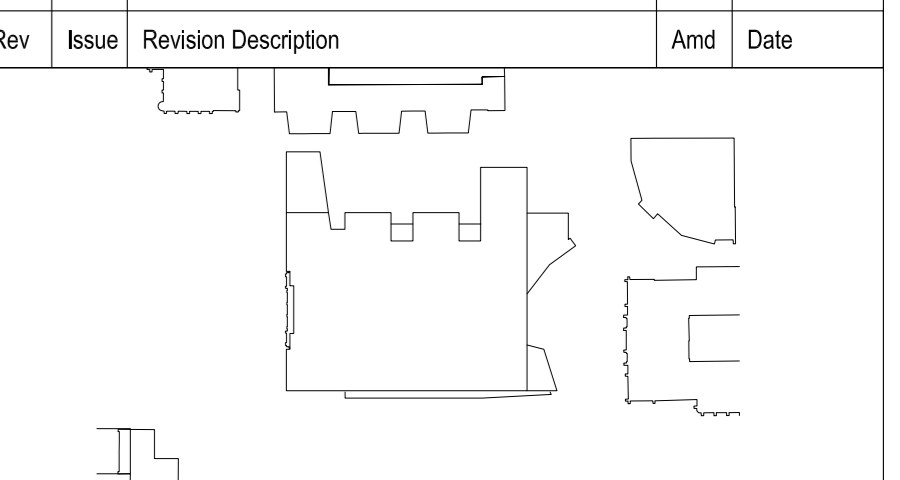

NADAAA

NADAAA
1520 Washington
Street No.2
Boston
Massachusetts
02118 USA

Telephone
+1 617 442 6232
Facsimile
+1 604 442 1417
Email
nadaa@nadaaa.com

John Wardle Architects

25 Rokeby Street, Collingwood Victoria 3066 Australia
Tel : +61 3 8662 0400 www.johnwardlearchitects.com
© 2014 John Wardle Architects ABN 63 006 614 268

Client **University of Melbourne
Parkville Campus**

Project **Faculty of Architecture
Building and Planning**

Title **JOINERY DETAILS
STUDIO**

Project No.	0913	Scale	1:10, 1:5
Drawing No.	AR8105	Revision	C

Date APR 2014 Dwnn JJ Co-Ord AC Chk SG

FILENAME:####

FOR CONSTRUCTION