




14 PLAN - JOB-01 READING TABLE SCALE 1:20

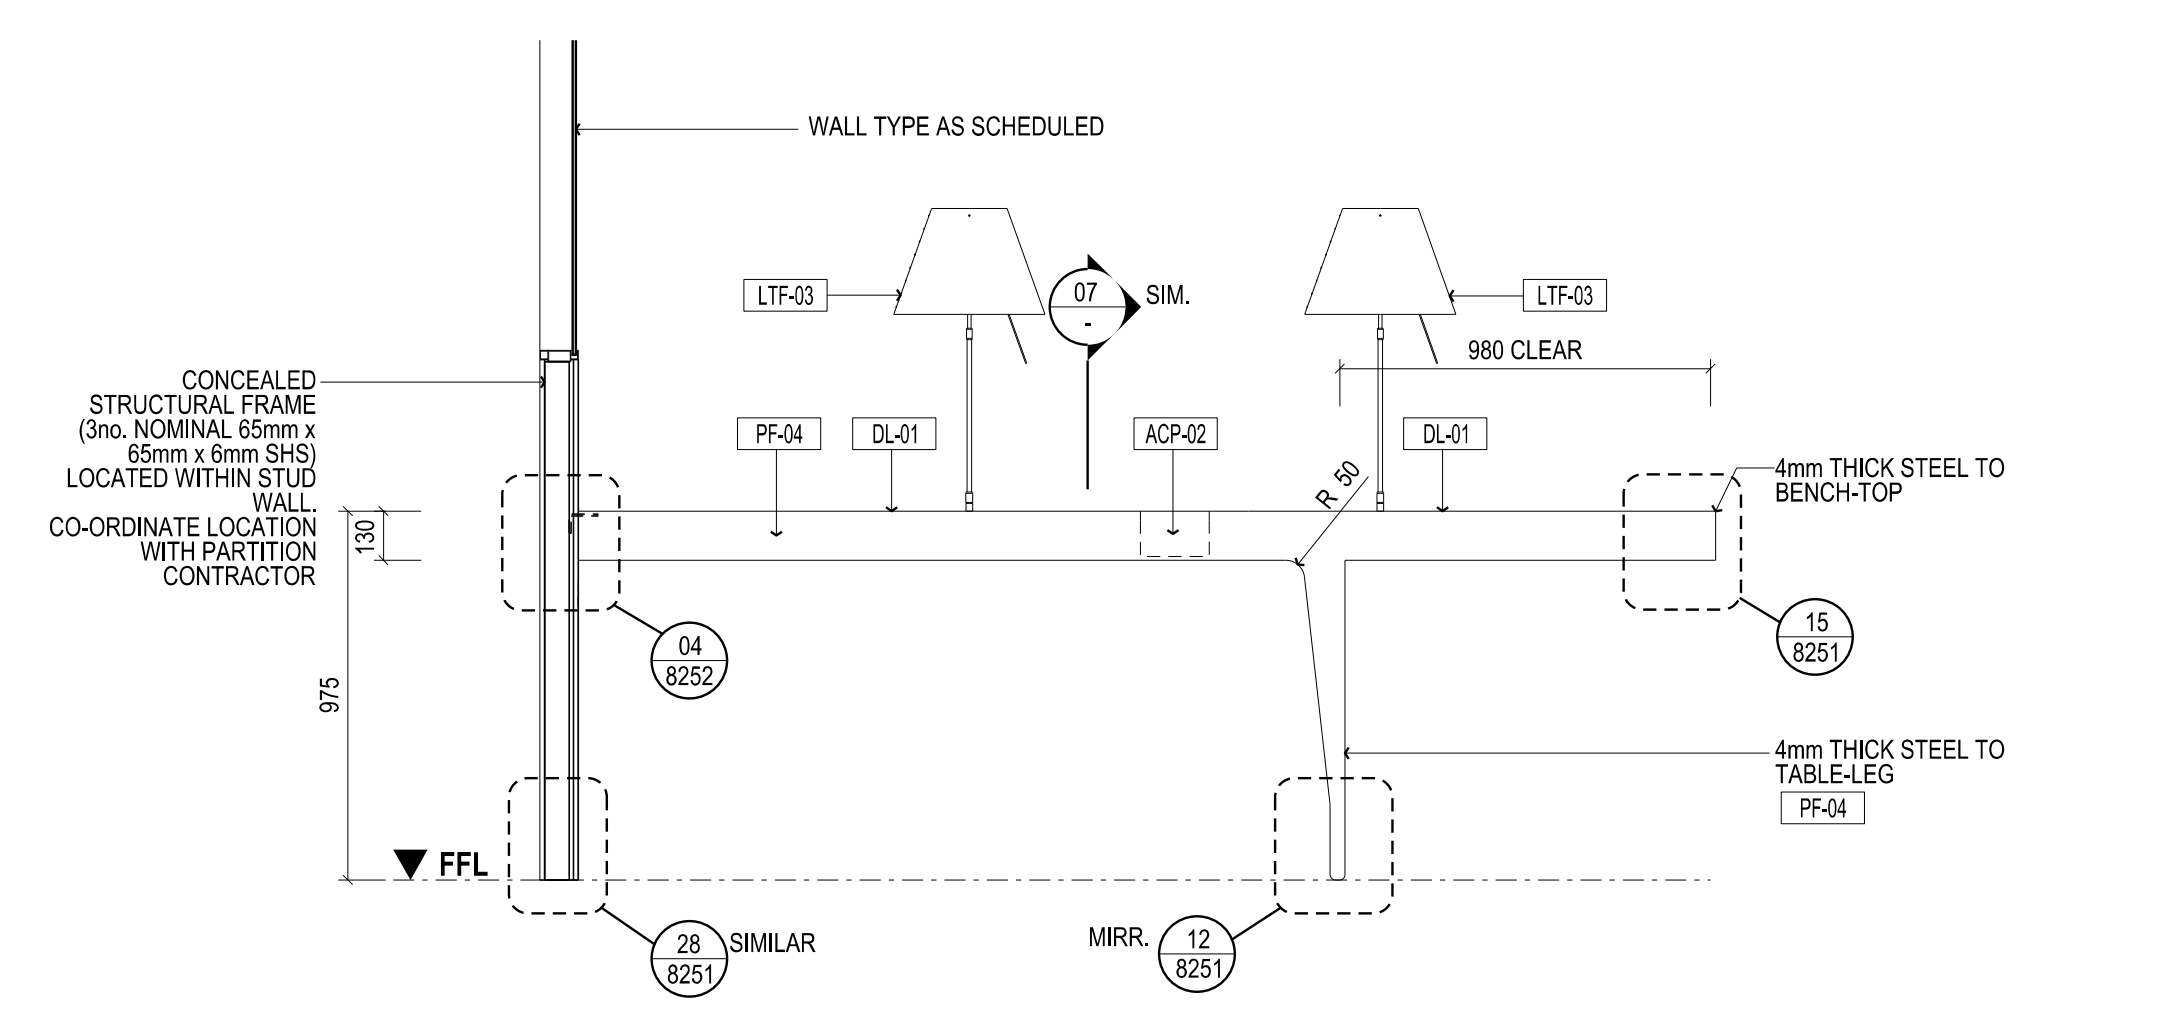


15 ELEVATION - JOB-01 READING TABLE SCALE 1:20

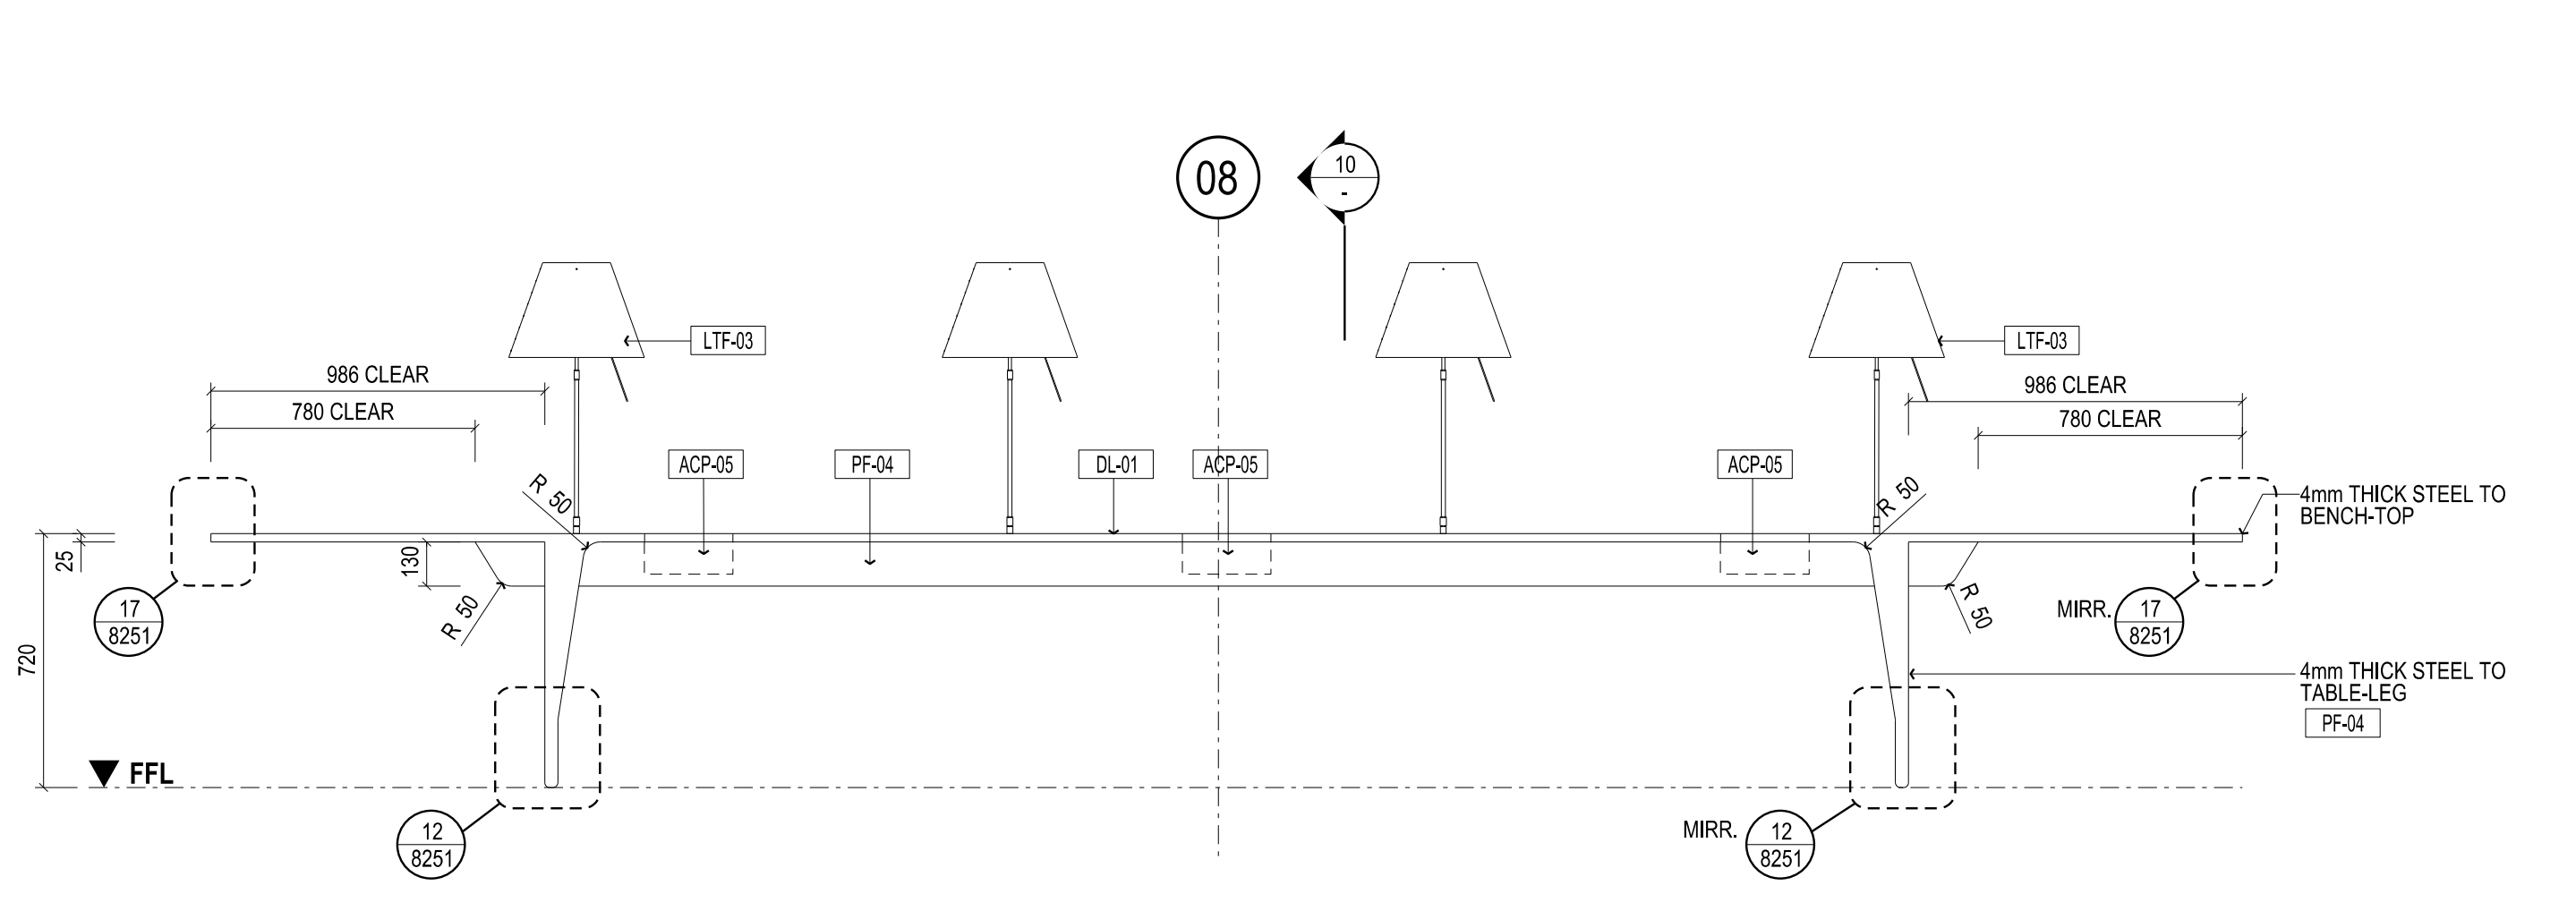


16 ELEVATION - JOB-14 LARGE READING AND COLLABORATIVE TABLES SCALE 1:20

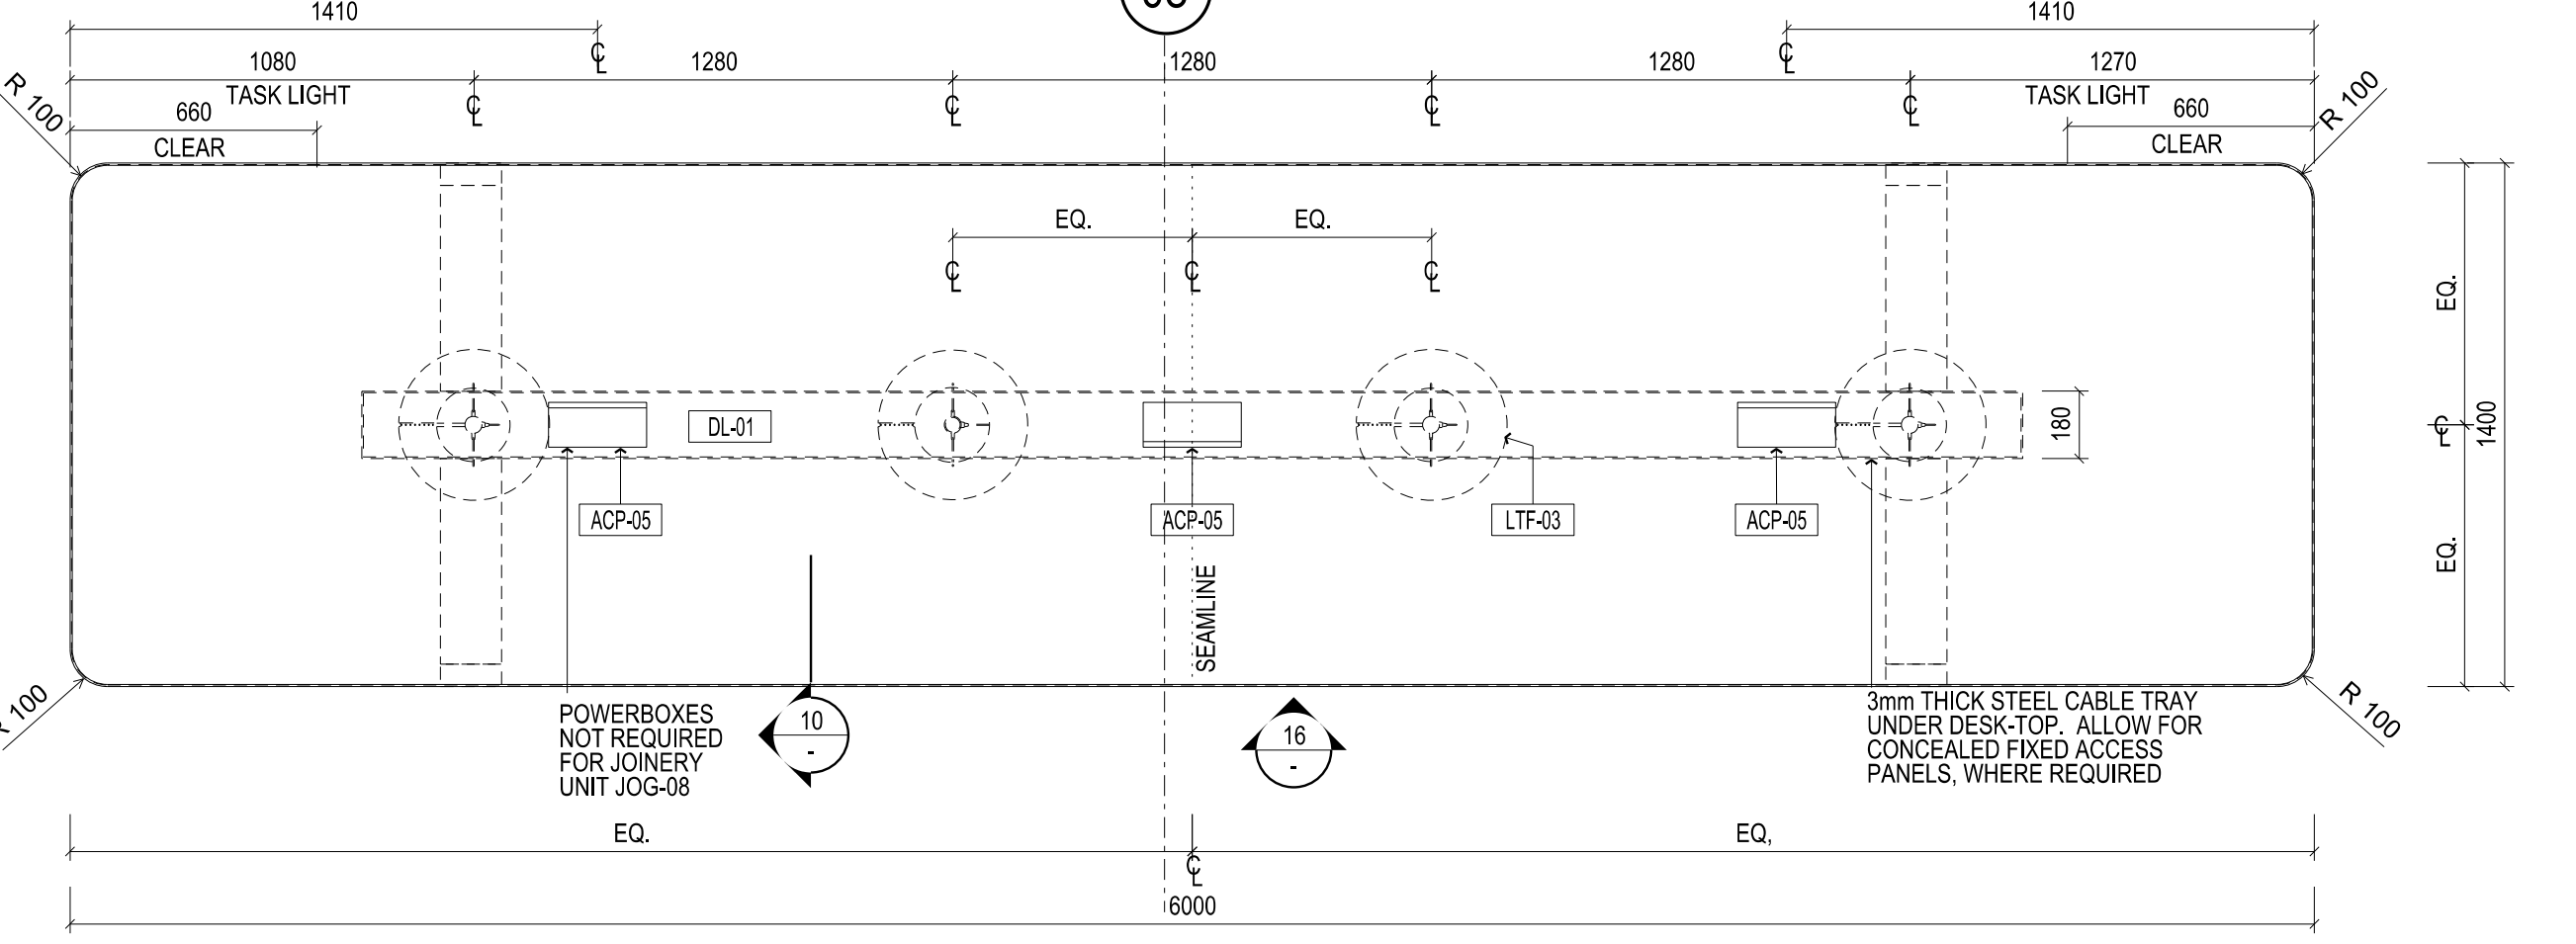


13 PLAN - JOB-14 AND JOB-08 LARGE READING AND COLLABORATIVE TABLES SCALE 1:20

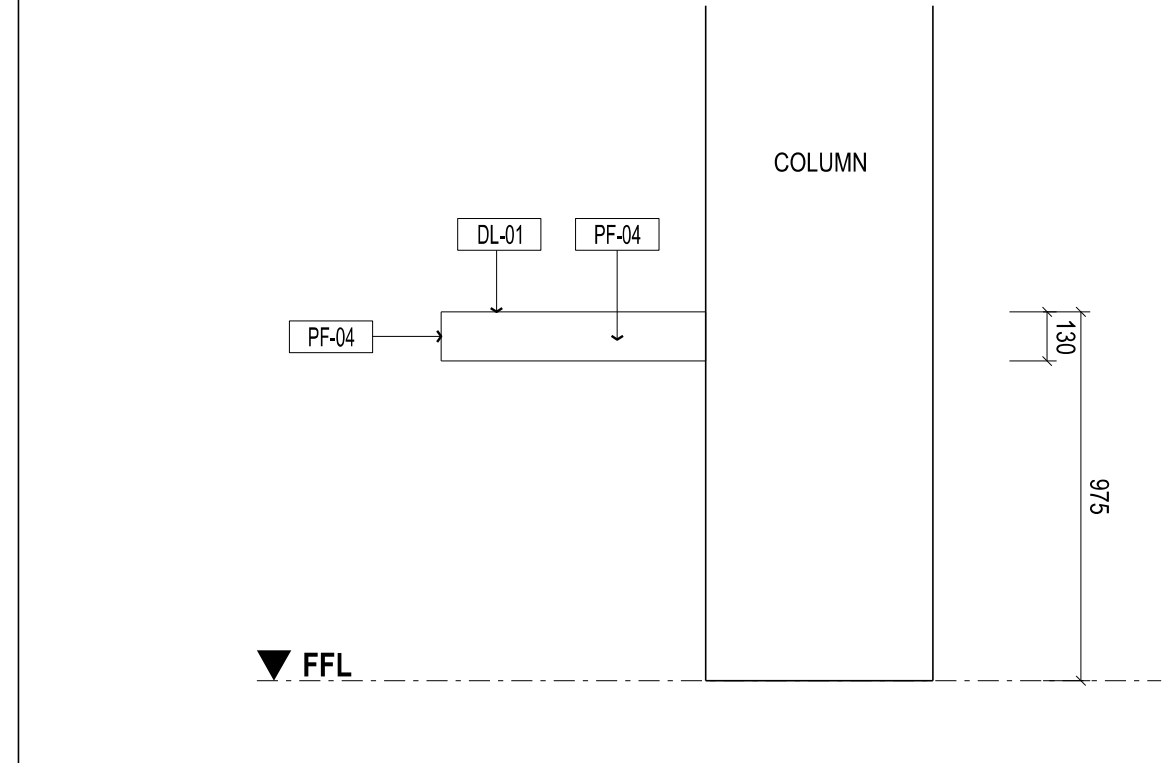


06 ELEVATION - JOB-04 QUICK ACCESS SCALE 1:20

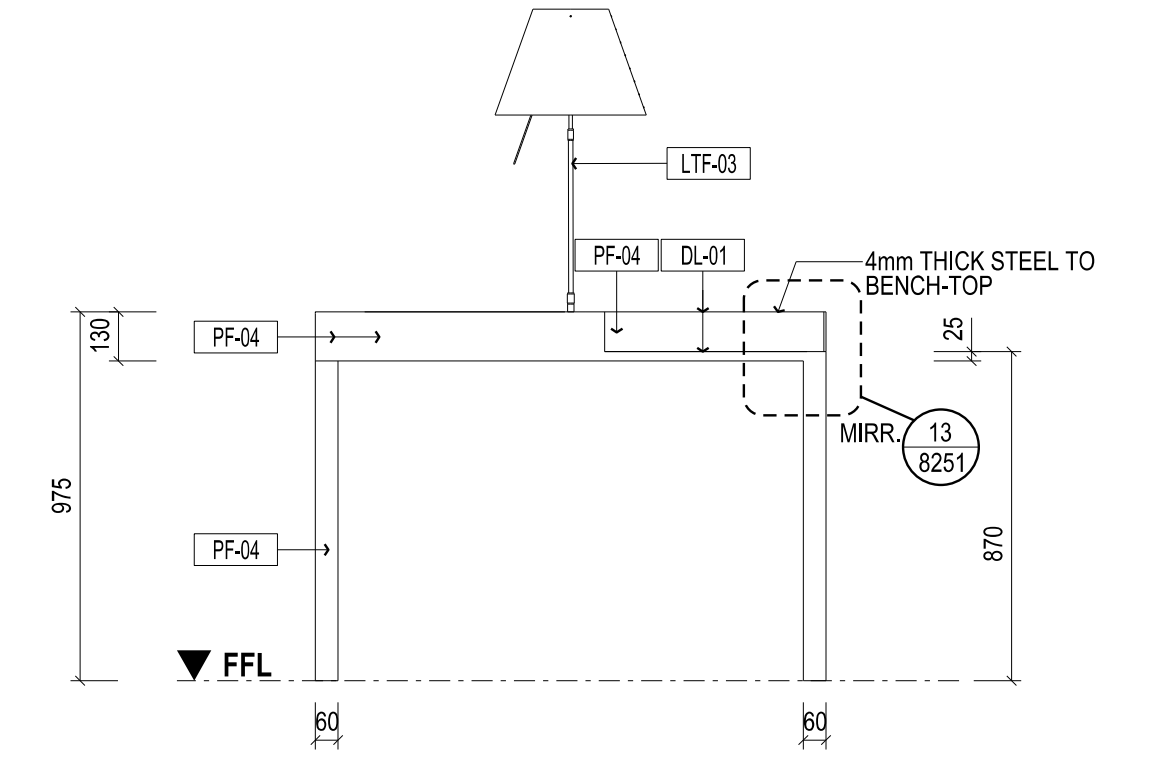


08 ELEVATION - JOB-04 QUICK ACCESS SCALE 1:20

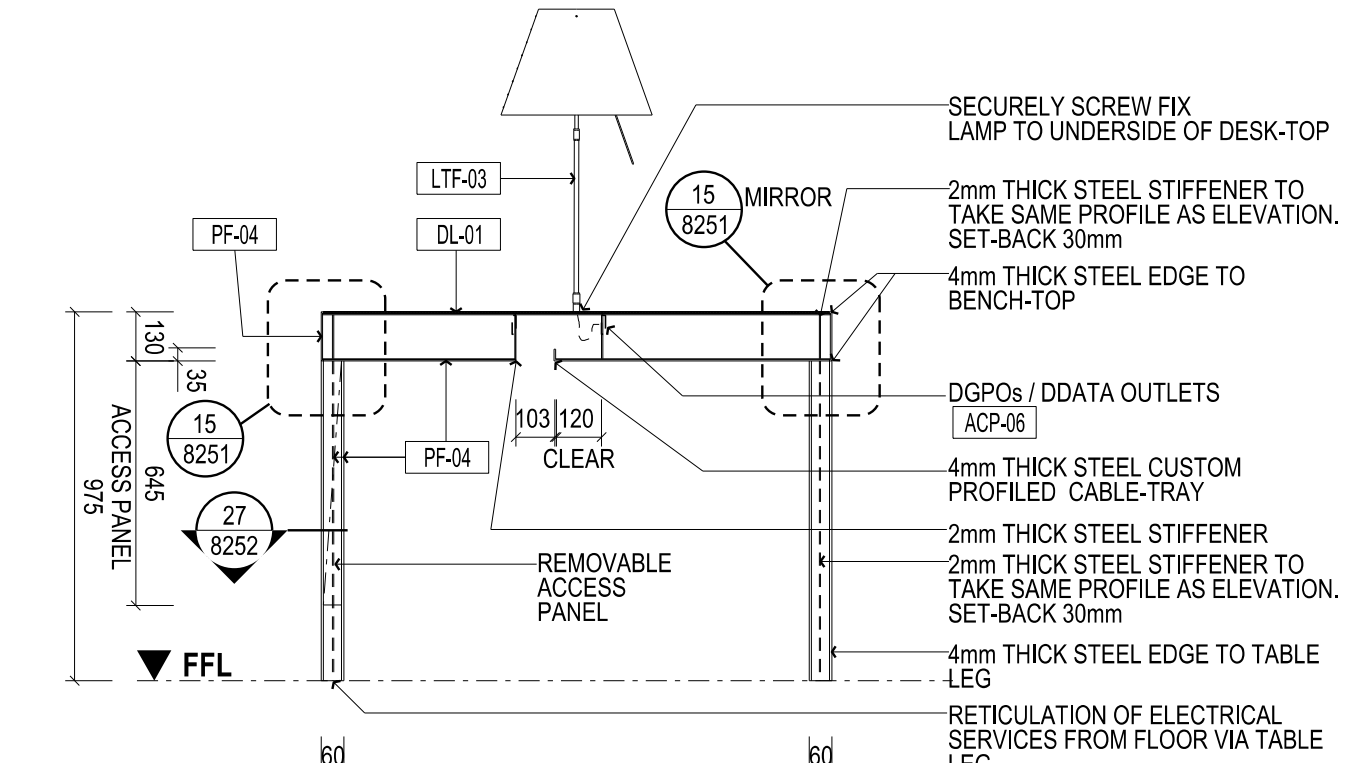


07 SECTION - JOB-04 QUICK ACCESS SCALE 1:20

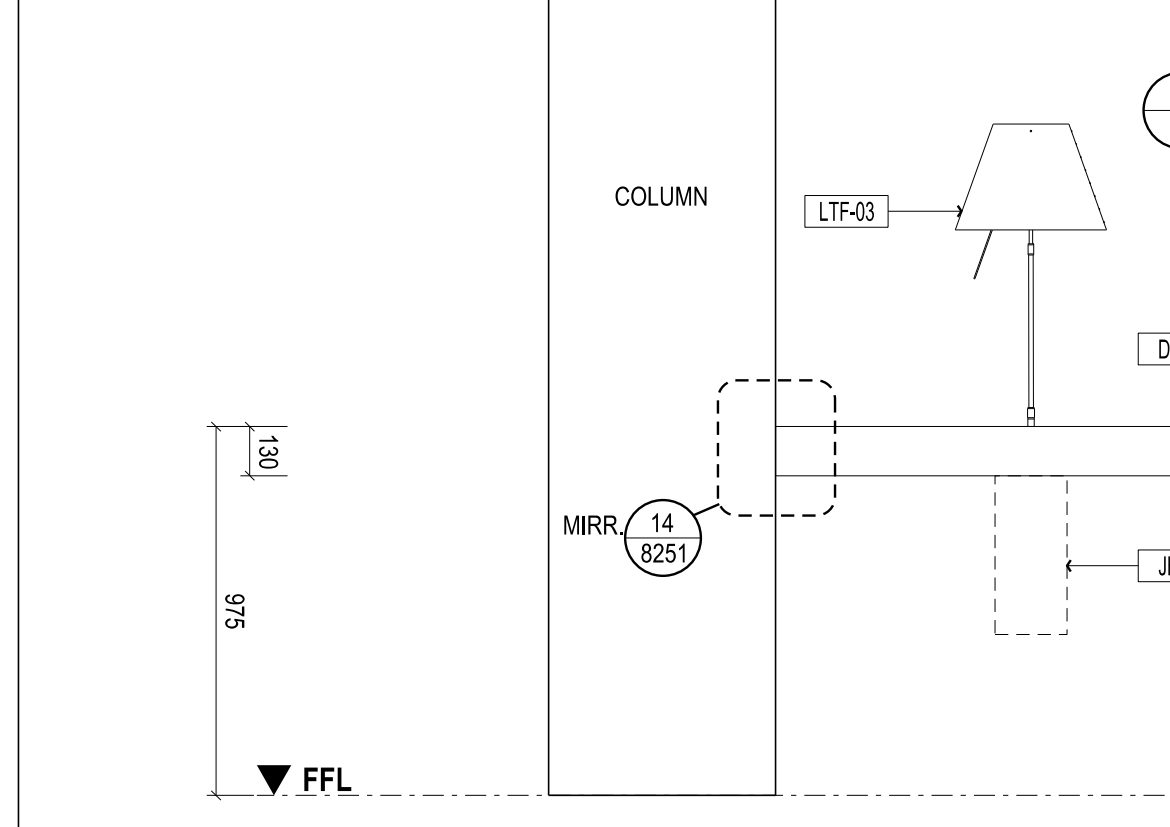


03 ELEVATION - JOB-04 QUICK ACCESS SCALE 1:20

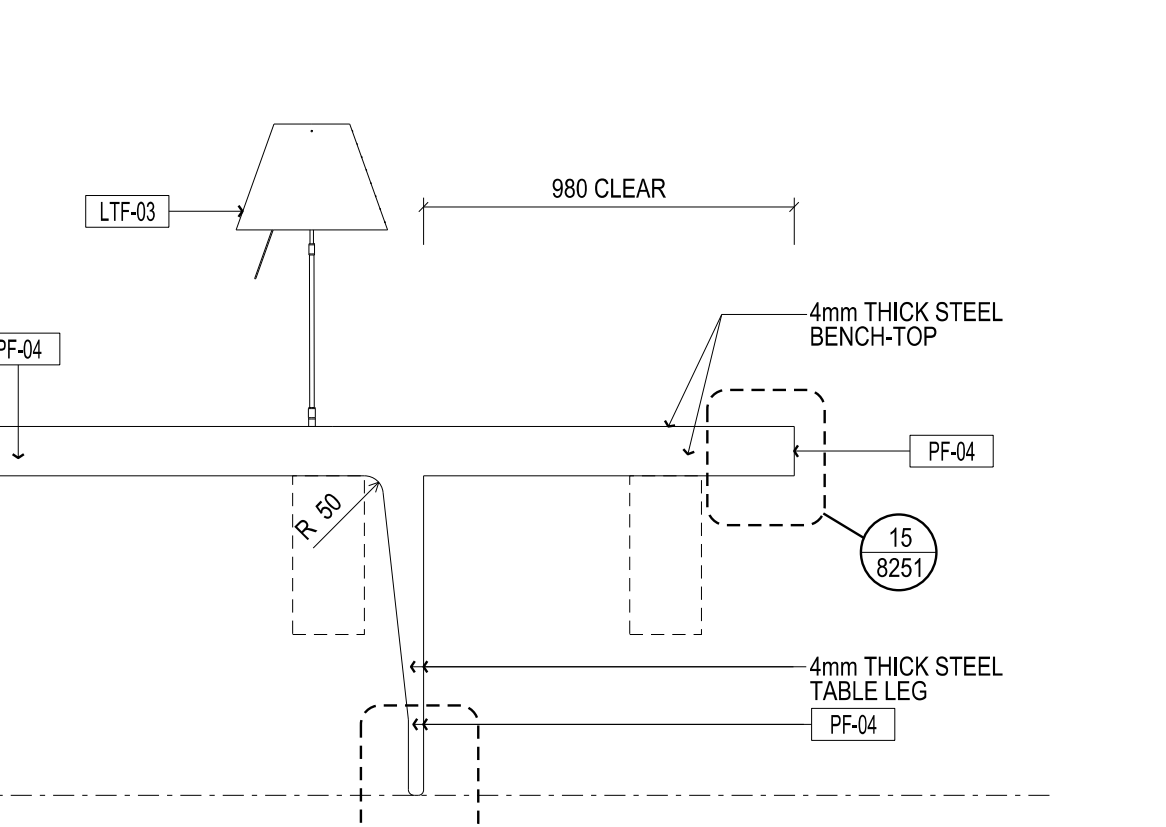


05 ELEVATION - JOB-04 QUICK ACCESS SCALE 1:20

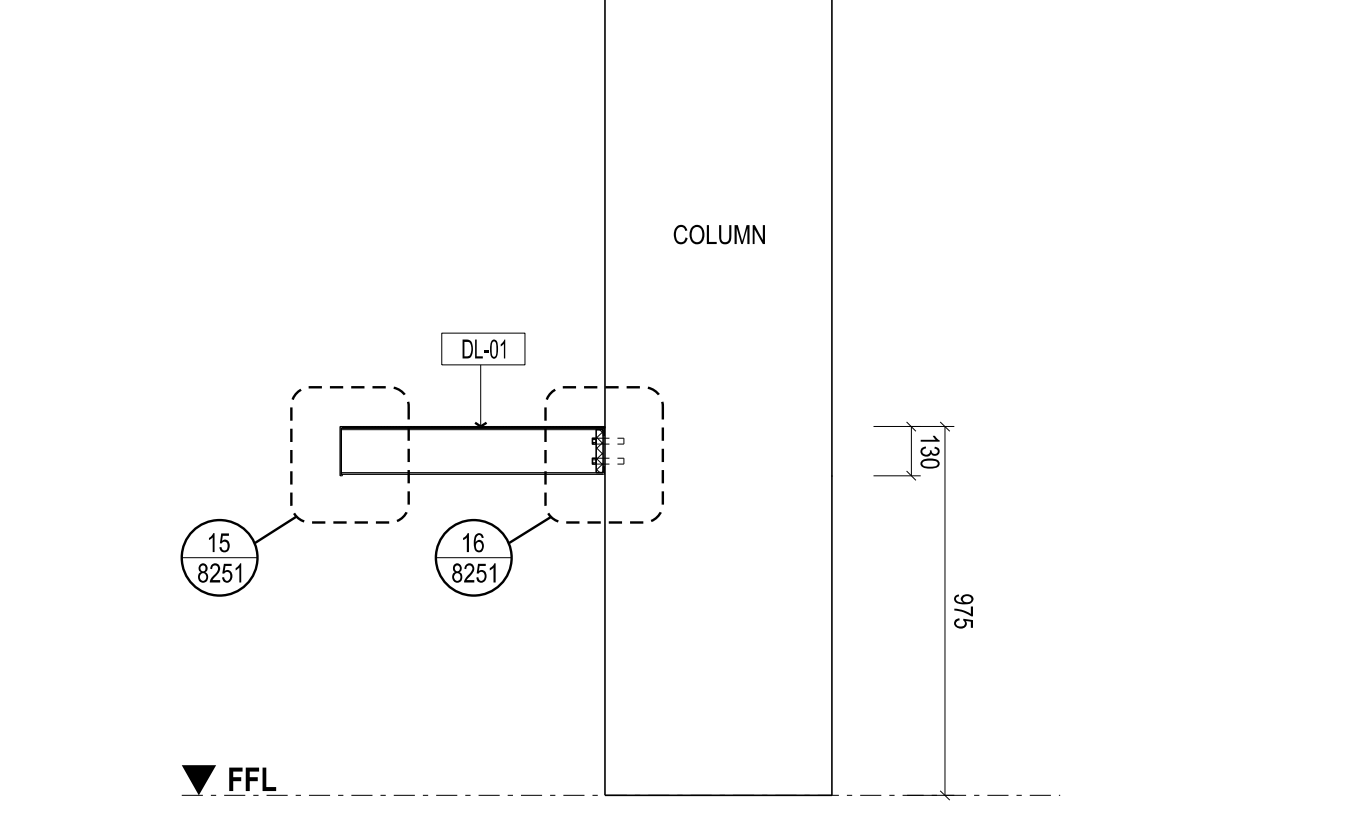


04 SECTION - JOB-04 QUICK ACCESS SCALE 1:20

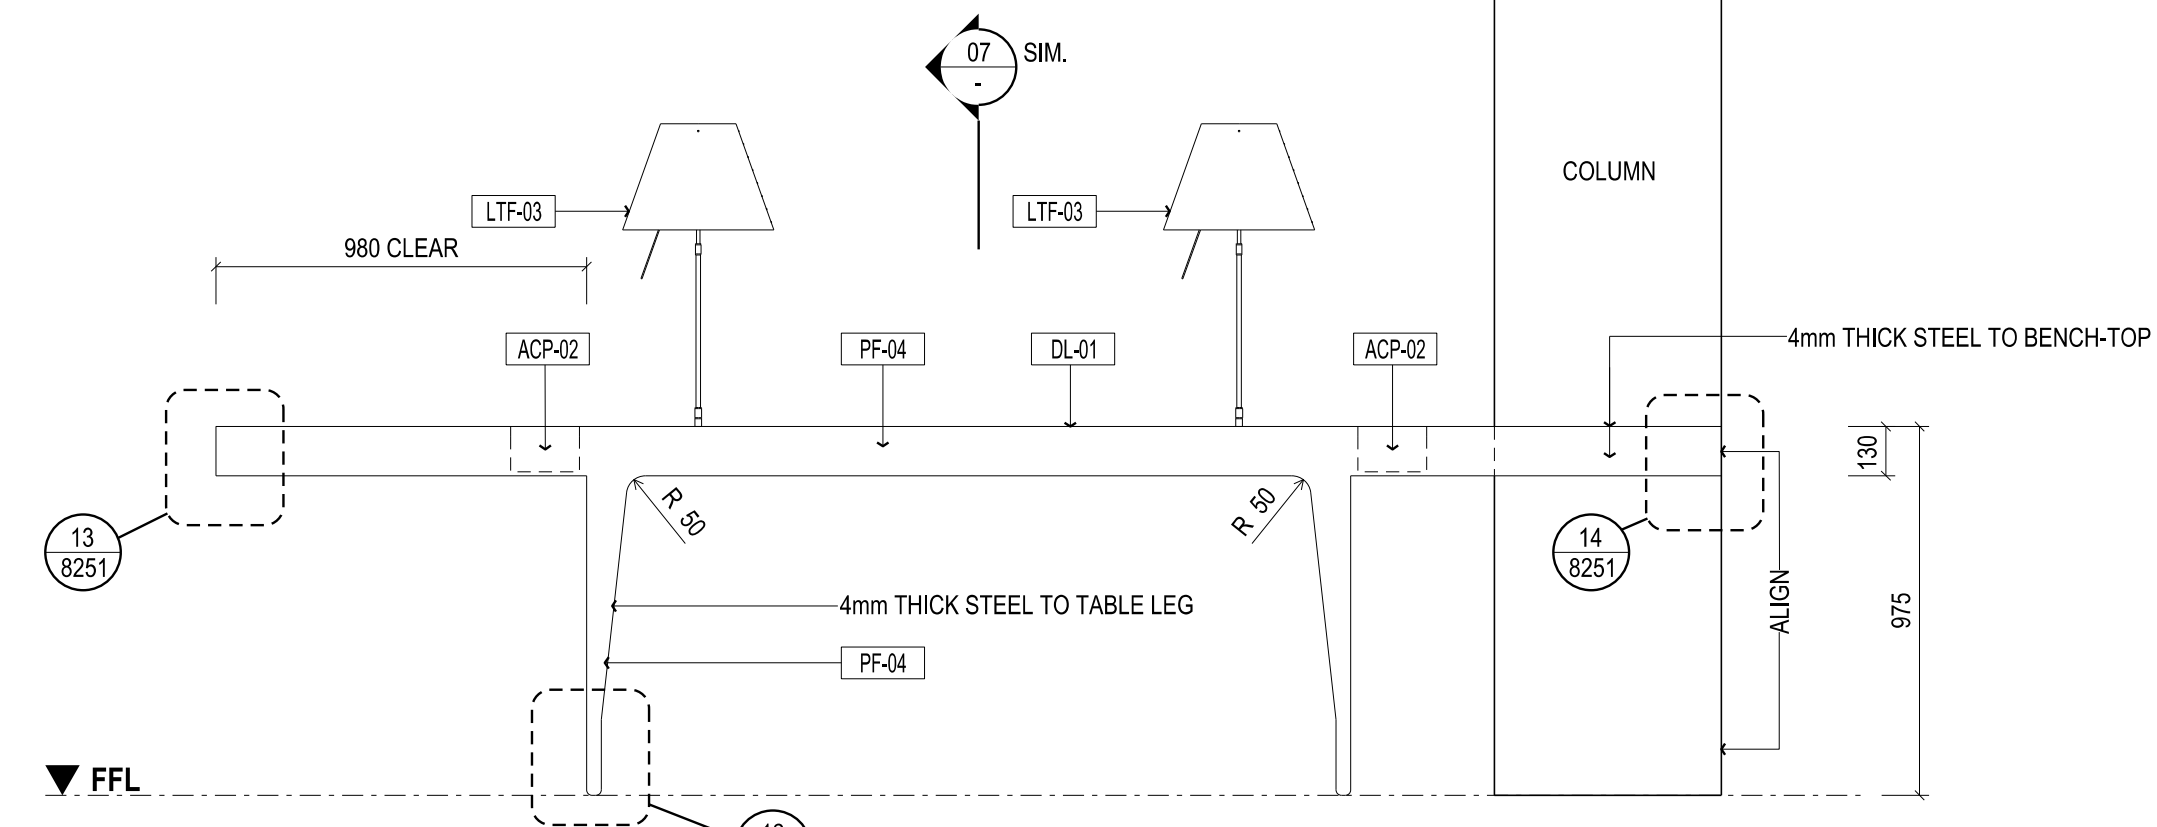


12 ELEVATION - JOB-06 LAYOUT BENCH SCALE 1:20

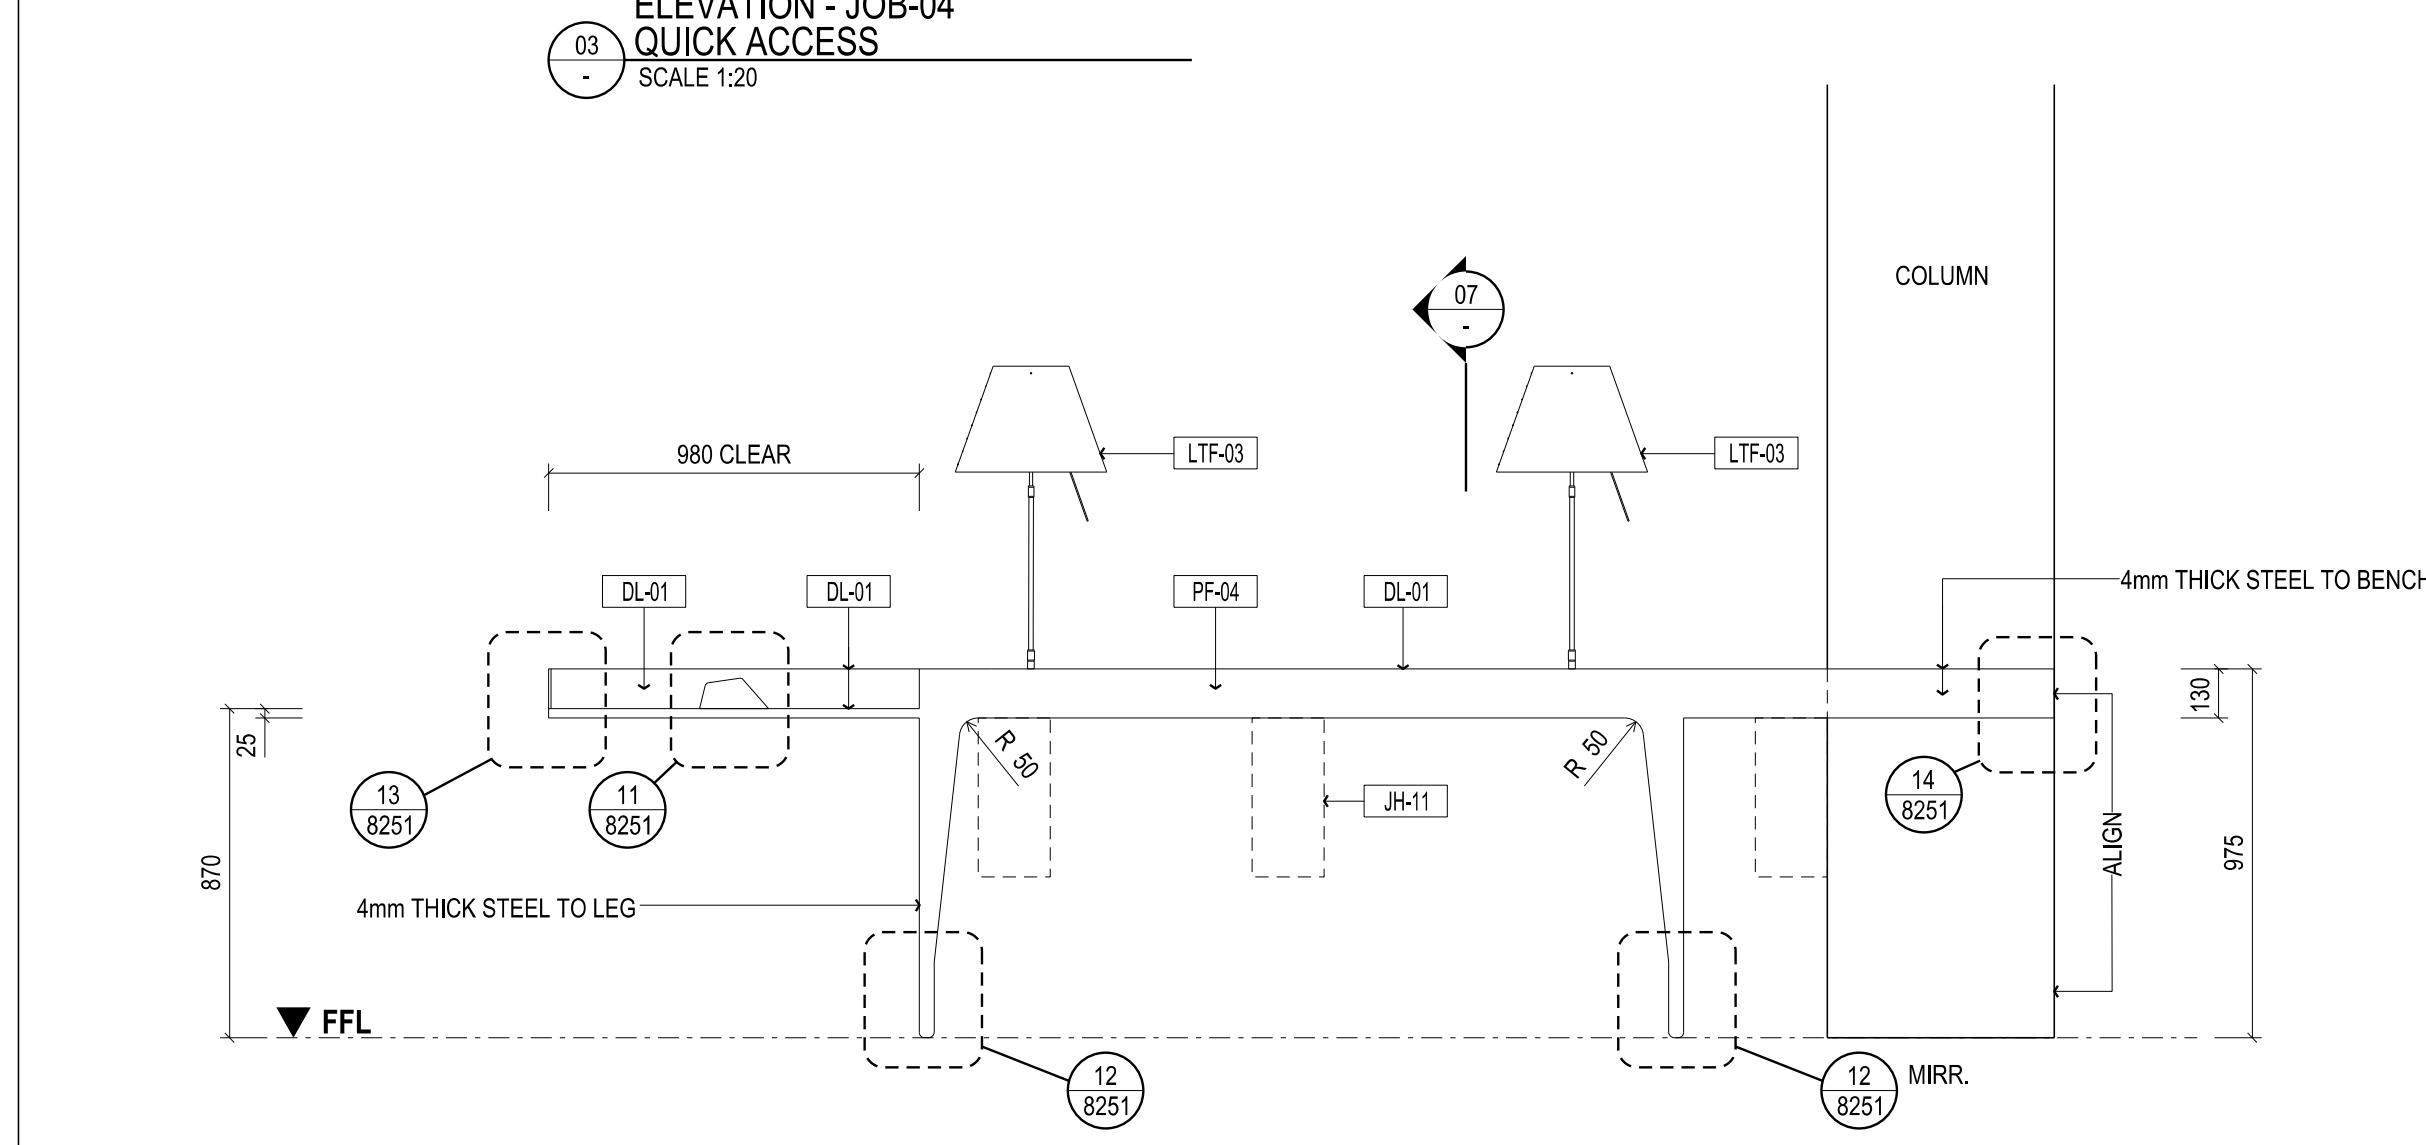


02 ELEVATION - JOB-04 QUICK ACCESS SCALE 1:20

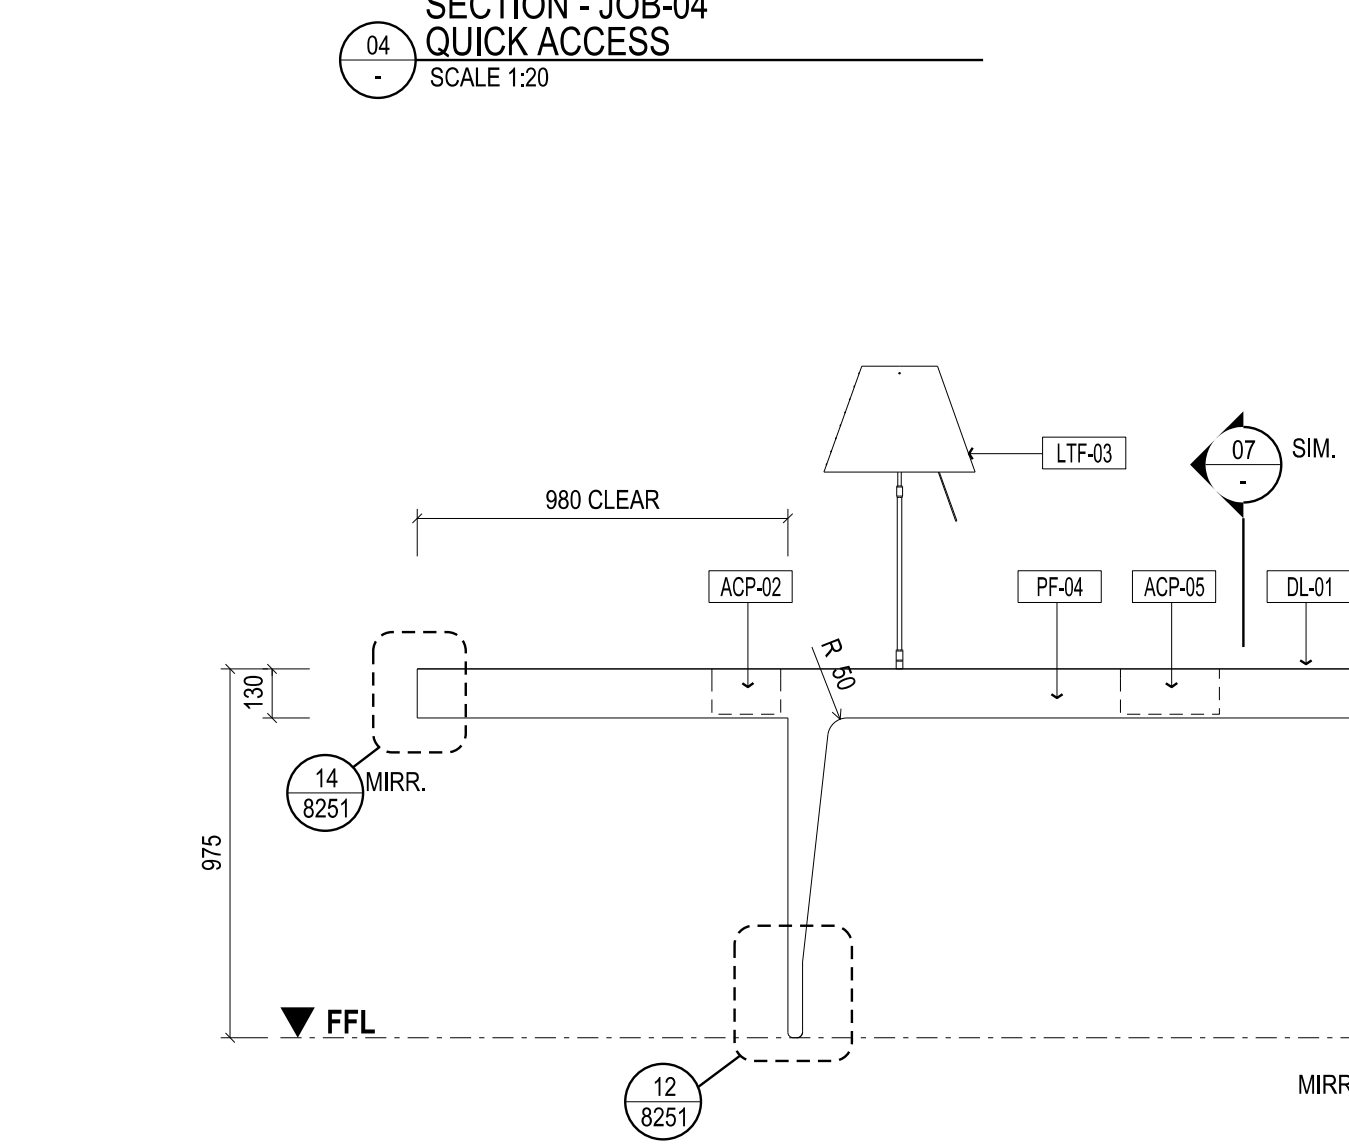


09 ELEVATION - JOB-05 READING TABLE SCALE 1:20

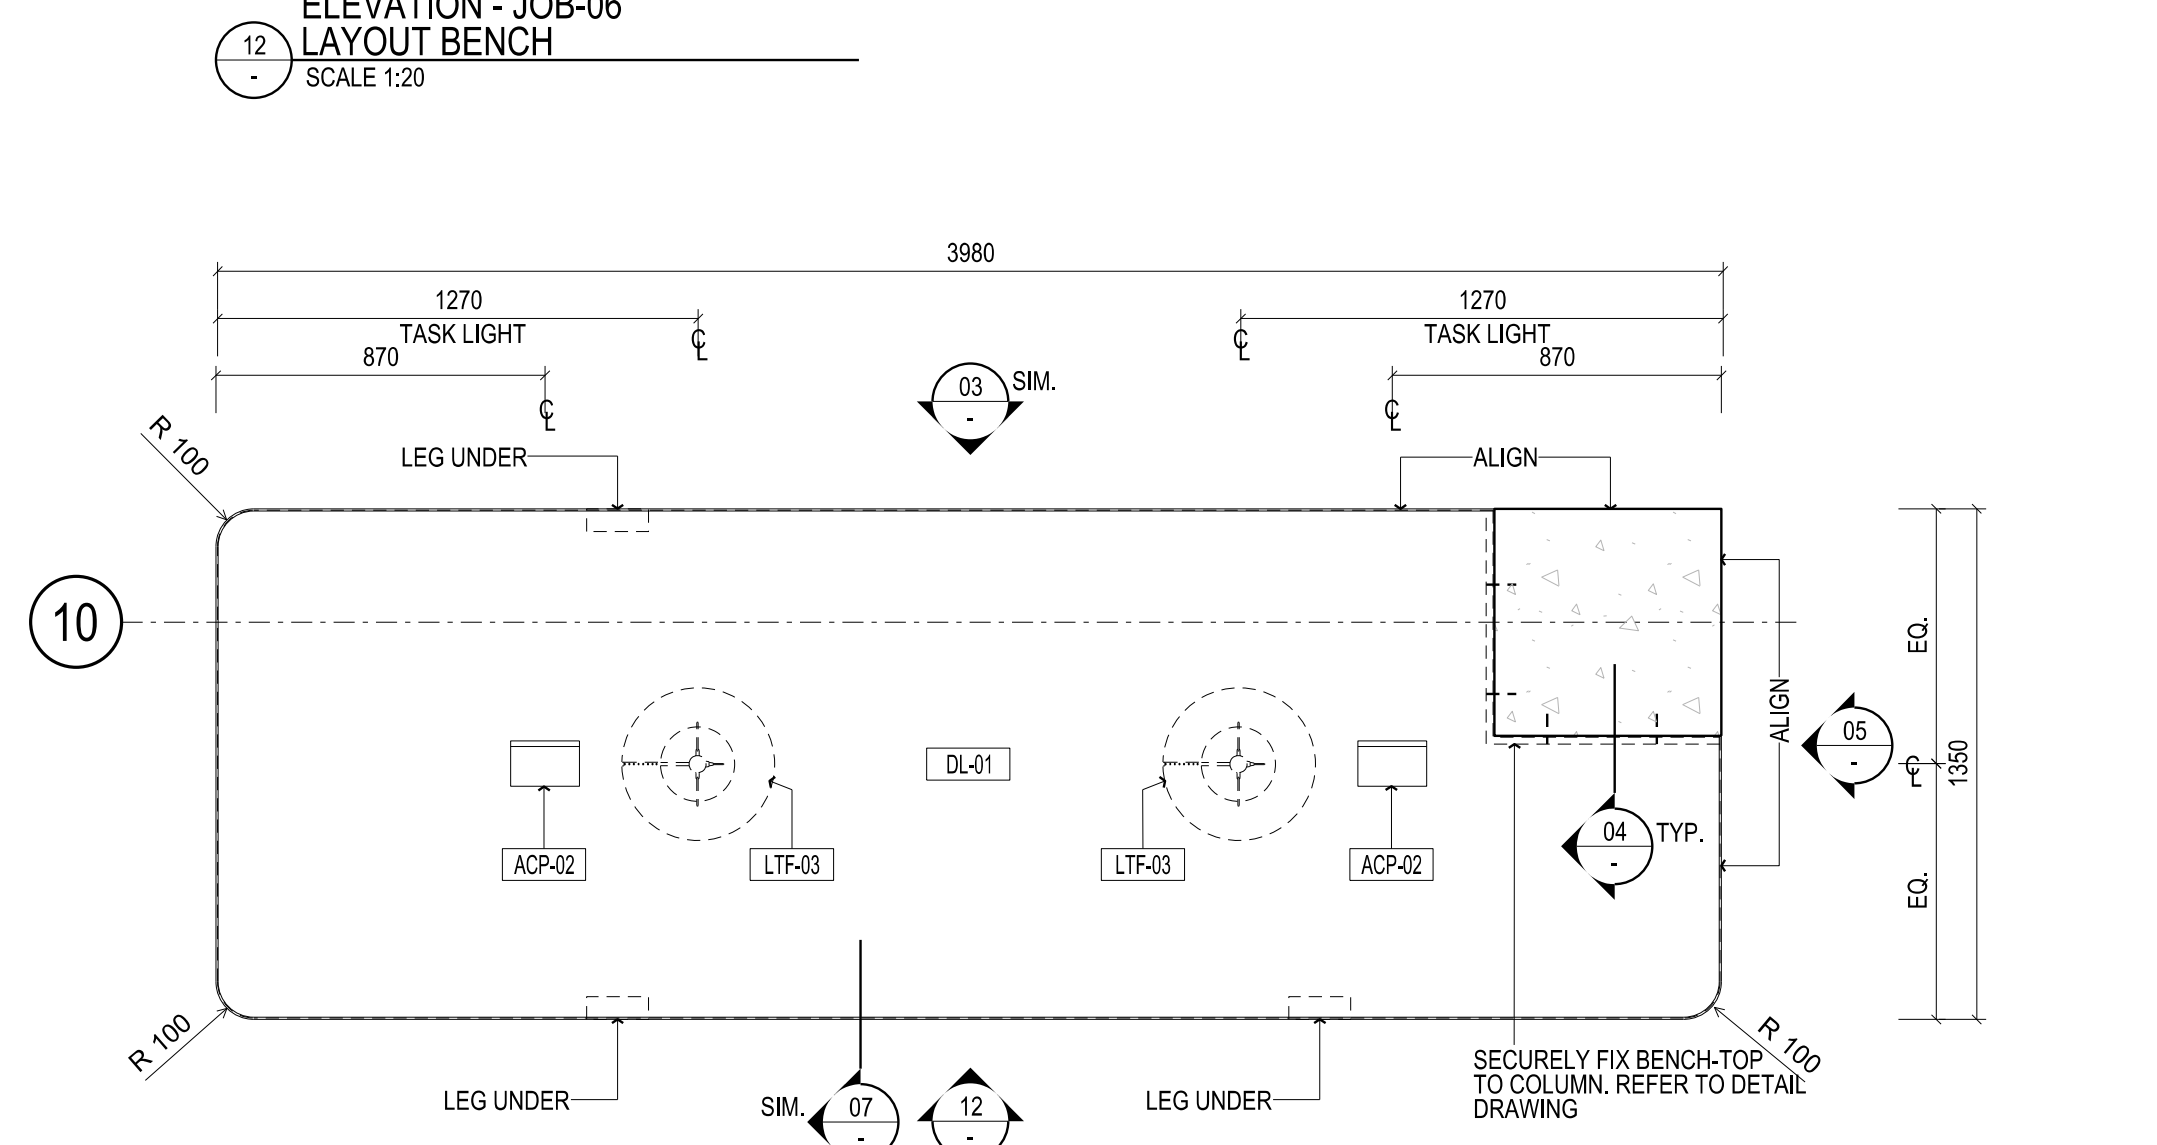


11 PLAN - JOB-06 LAYOUT BENCH SCALE 1:20

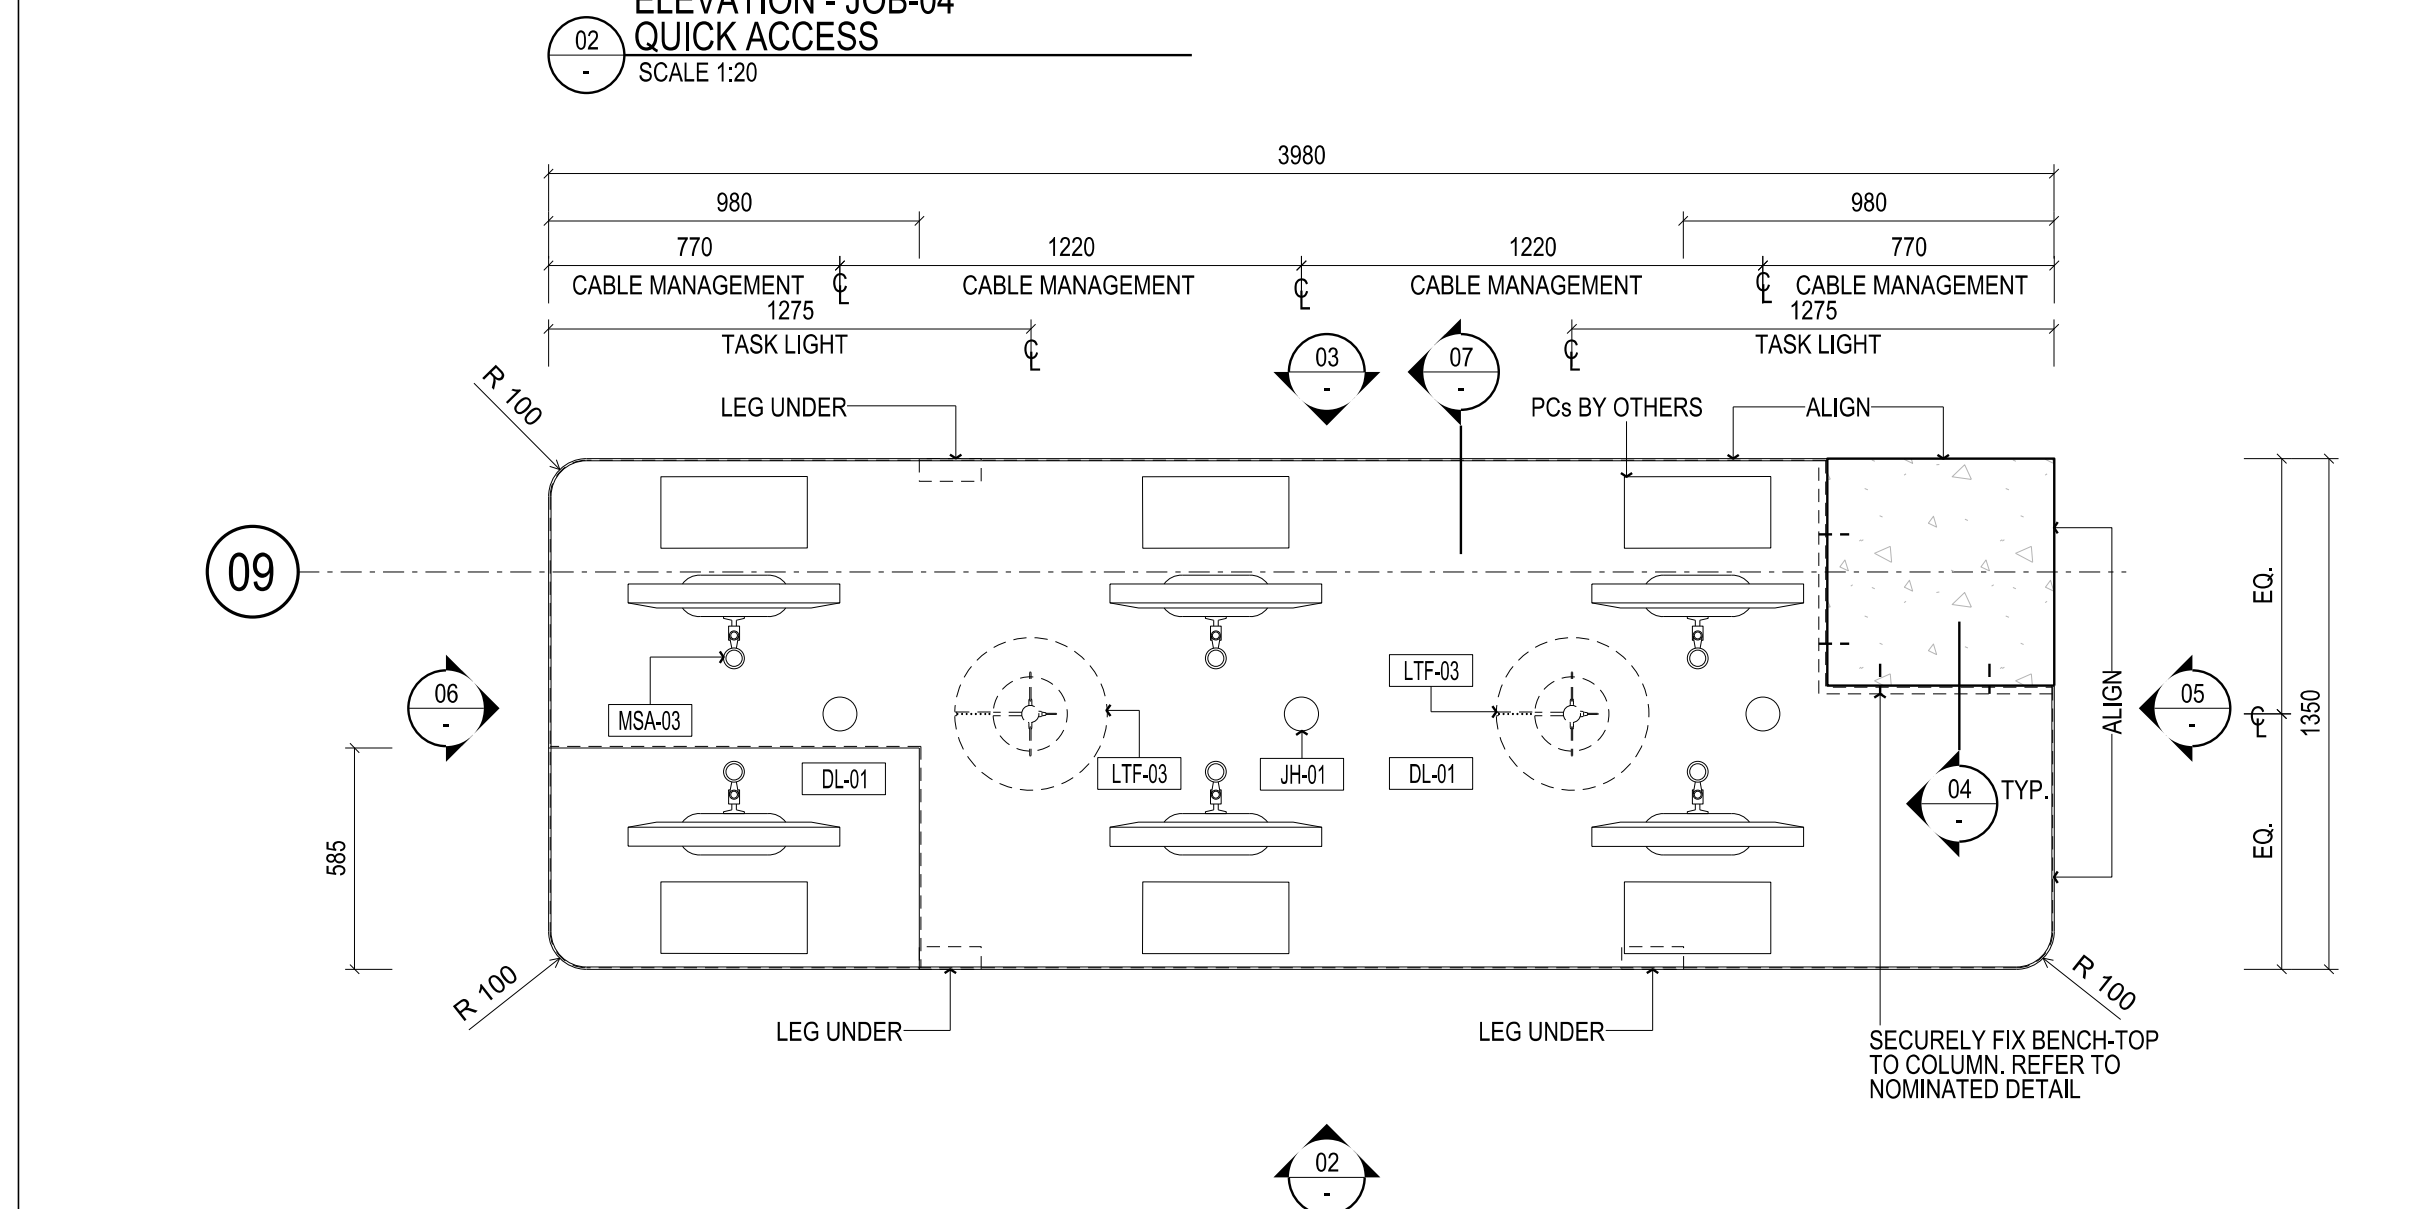

01 PLAN - JOB-04 QUICK ACCESS SCALE 1:20

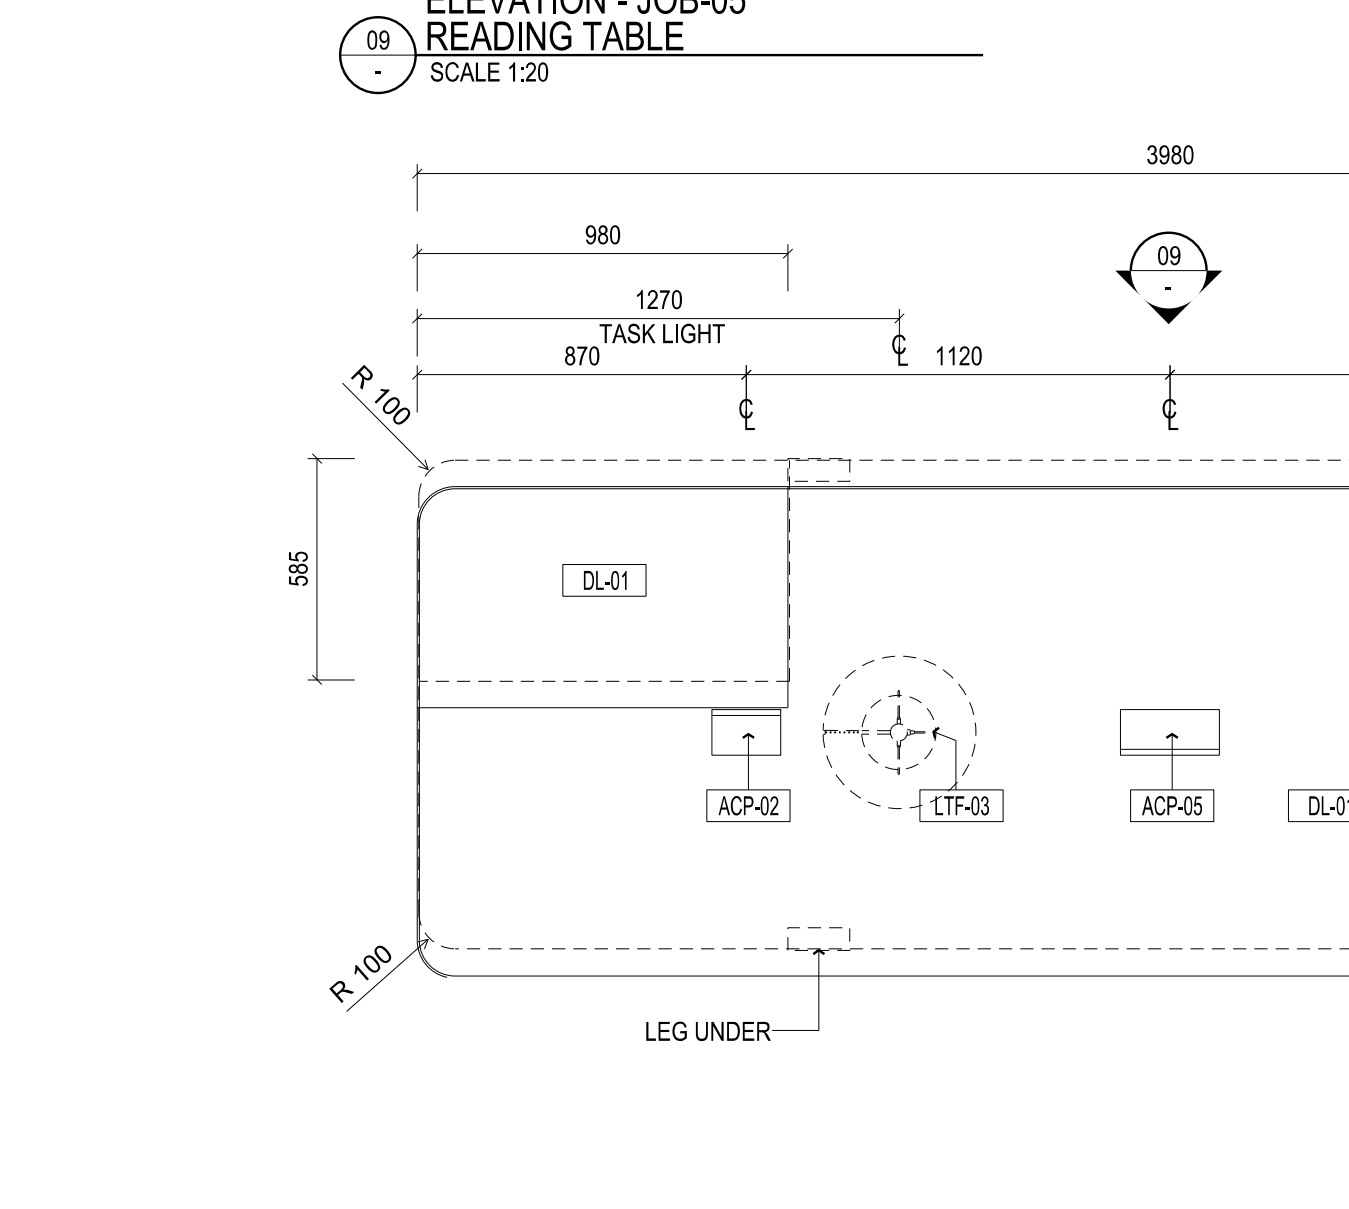

10 PLAN - JOB-05 READING TABLE SCALE 1:20

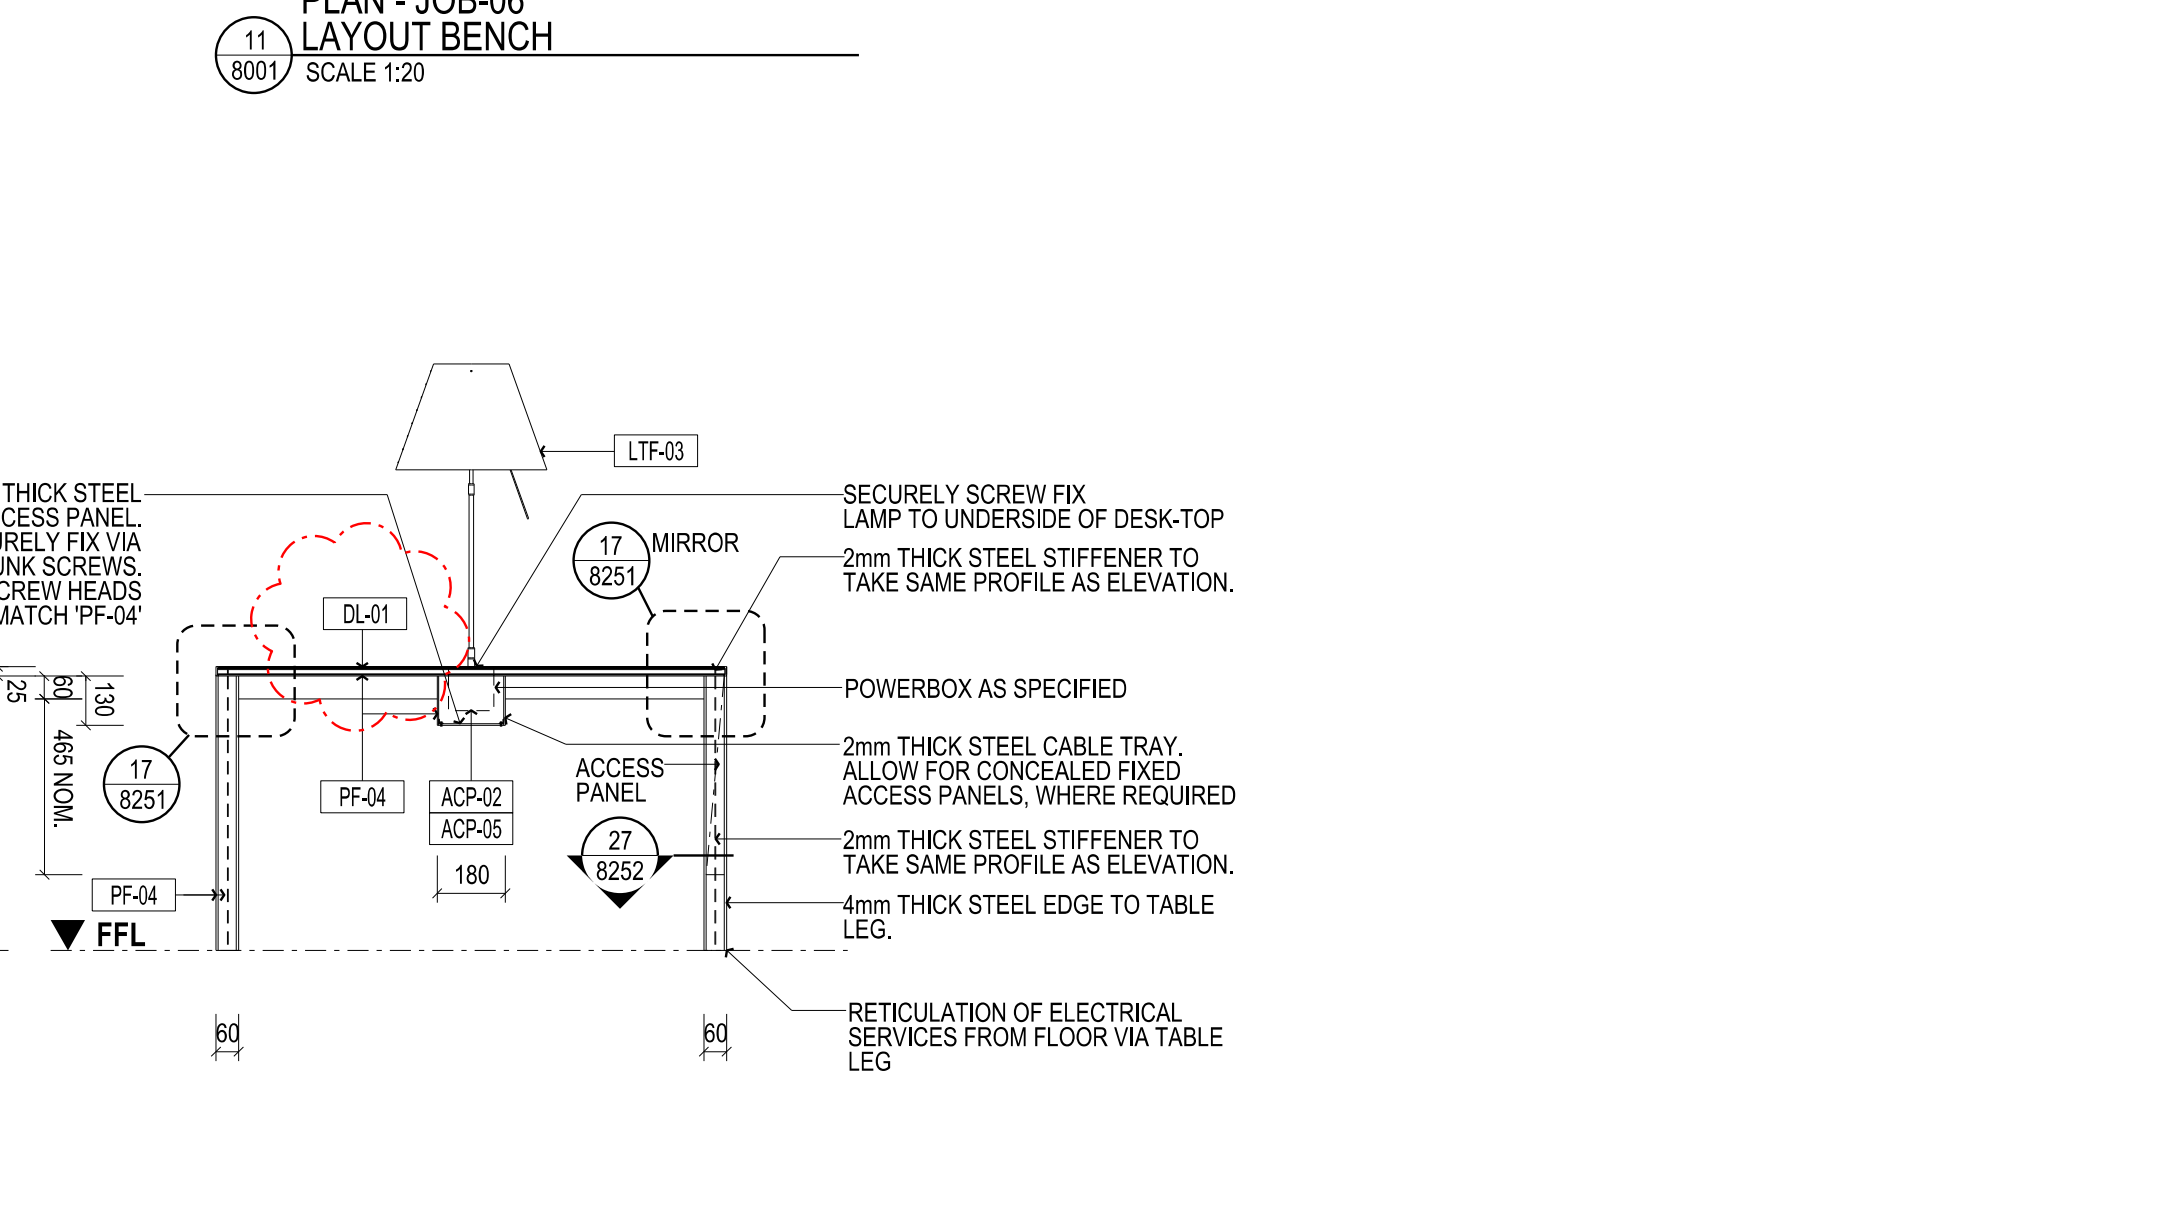

10 SECTION - JOB-14 READING TABLE SCALE 1:20

THIS DRAWING IS AN UNCONTROLLED COPY UNLESS STAMPED OTHERWISE

CONTRACTORS SHALL VERIFY JOB DIMENSIONS BEFORE ANY JOB COMMENCES. ALL SHOP DRAWINGS SHALL BE SUBMITTED TO THE SUPERINTENDENT AND MANUFACTURER SHALL NOT COMMENCE PRIOR TO THE RETURN OF APPROVED SHOP DRAWINGS. BY THE CONSULTANT. DIMENSIONS SHALL TAKE PRECEDENCE OVER SCALES. THIS DRAWING SHALL BE READ IN CONJUNCTION WITH ALL RELEVANT CONTRACT SPECIFICATIONS AND DRAWINGS COPYRIGHT OF THIS DRAWING IS VESTED IN NADAAA.

**General Notes**

18mm E1 MDF CARCASS THROUGHOUT UNLESS OTHERWISE NOTED.

ALL NON EXPOSED CARCASS TO BE MATCHING LAMINATE UNLESS OTHERWISE NOTED.

ALL NON EXPOSED CARCASS TO BE BLACK LAMINATE TO JOINERY RECEIVING TIMBER VENEER FINISH. REFER MATERIALS SCHEDULE [ PL.05 ]

ALL NON EXPOSED CARCASS TO BE WHITE LAMINATE TO JOINERY RECEIVING STAINLESS STEEL CLADDING. REFER MATERIALS SCHEDULE [ PL.01 ]

ALL EXPOSED EDGES TO TIMBER VENEER PANELS TV-01 TO RECEIVE 3mm THK MATCHING SOLID EDGES UNLESS OTHERWISE NOTED.

SPLIT BATTENS TO BE 12mm UNLESS OTHERWISE NOTED.

APPLY MATCHING LAMINATE ABS EDGING TO LAMINATED BENCHTOPS UNLESS OTHERWISE NOTED.

REFER TO '1300 - MATERIALS SCHEDULE' FOR A DESCRIPTION OF THE MATERIAL CODES AS SHOWN ON THIS DRAWING. [ TV.00 ]

REFER TO '1400 - FIXTURES, FITTINGS & EQUIPMENT SCHEDULE' FOR A DESCRIPTION OF THE FFAE CODES AS SHOWN ON THIS DRAWING. [ JH.00 ]

ALL JOINERY LOCKS TO BE [ JH.02 ] UNLESS OTHERWISE NOTED.

REFER TO DRAWING AR7300 FOR MOUNTING HEIGHTS FOR ALL SERVICES FIXTURES UNLESS OTHERWISE DIMENSIONED ON THE JOINERY ELEVATIONS.

ALL CORNER JUNCTIONS TO BE MITRED UNLESS OTHERWISE NOTED.

ALL UPHOLSTERY STITCHING TOO MATCH FABRIC COLOUR UNLESS OTHERWISE NOTED.

DRAWINGS TO BE READ IN CONJUNCTION WITH AR1200 SERIES INTERNAL ARRANGEMENT PLANS TO COORDINATE FIXINGS INTO PARTITIONS WHERE NECESSARY.

FS = FIXED SHELF  
AS = ADJUSTABLE SHELF  
FP = FIXED PANEL  
PJ = PANEL JOIN MAXIMUM WIDTH 2mm

C.O.S = CHECK ON SITE - DIMENSIONS MUST BE VERIFIED ON SITE BY CONTRACTOR PRIOR TO COMMENCEMENT OF CONSTRUCTION.

NCM = NOMINAL  
TYP. = TYPICAL  
SIM. = SIMILAR  
MIRR. = MIRROR  
FCL = FINISHED CEILING LEVEL  
FFL = FINISHED FLOOR LEVEL  
SSL = STRUCTURAL SLAB LEVEL  
C = CENTRELINE  
DIRECTION OF GRAIN / FINISH

Rev	Issue	Revision Description	And	Date
A	SG	ISSUE FOR CONSTRUCTION	-	19.12.13
10	SG	VALUE MANAGEMENT ISSUE	-	28.03.13
09	SG	TENDER AGENDUM NO. 5	-	17.10.12
08	SG	100% CD - TENDER ISSUE	-	07.09.12
07	SG	90% CD ISSUE	-	10.08.12
06	SG	75% CD ISSUE	-	13.07.12
05	SG	50% CD ISSUE	-	01.06.12
04	SG	25% CD ISSUE	-	20.04.12
03	SG	FINAL DD ISSUE	-	24.02.12
WIDTH OF DESK DECREASED				
PLUMBING REMOVED FROM TEAPOINT				
02	SG	DD UPDATE	-	20.01.12
01	SG	DESIGN DEVELOPMENT ISSUE	-	22.12.11



**NADAAA**

NADAAA  
1320 Wellington Street No.2  
Boston  
Massachusetts  
02115 USA

Telephone  
+1 617 442 8232  
Facsimile  
+1 688 442 1417  
Email  
nad@nadaaa.com

**John Wardle Architects**

25 Rokeby Street, Collingwood, Victoria 3066 Australia  
Tel: +61 3 8662 0400 www.johnwardlearchitects.com  
© 2012 John Wardle Architects ABN 83 006 814 268

Client **University of Melbourne Parkville Campus**

Project **Faculty of Architecture Building and Planning**

Title **JOINERY DETAILS B01 AND G01 LIBRARY**

Project No.	<b>0913</b>	Scale	1:20 @ A0 1:40 @ A2
Drawing No.	<b>AR8151</b>	Revision	<b>A</b>

Date: Dec 2011 Drawn: KW Co-Ord: SG Chk: JA

FILENAME - SFRS

**FOR CONSTRUCTION**