

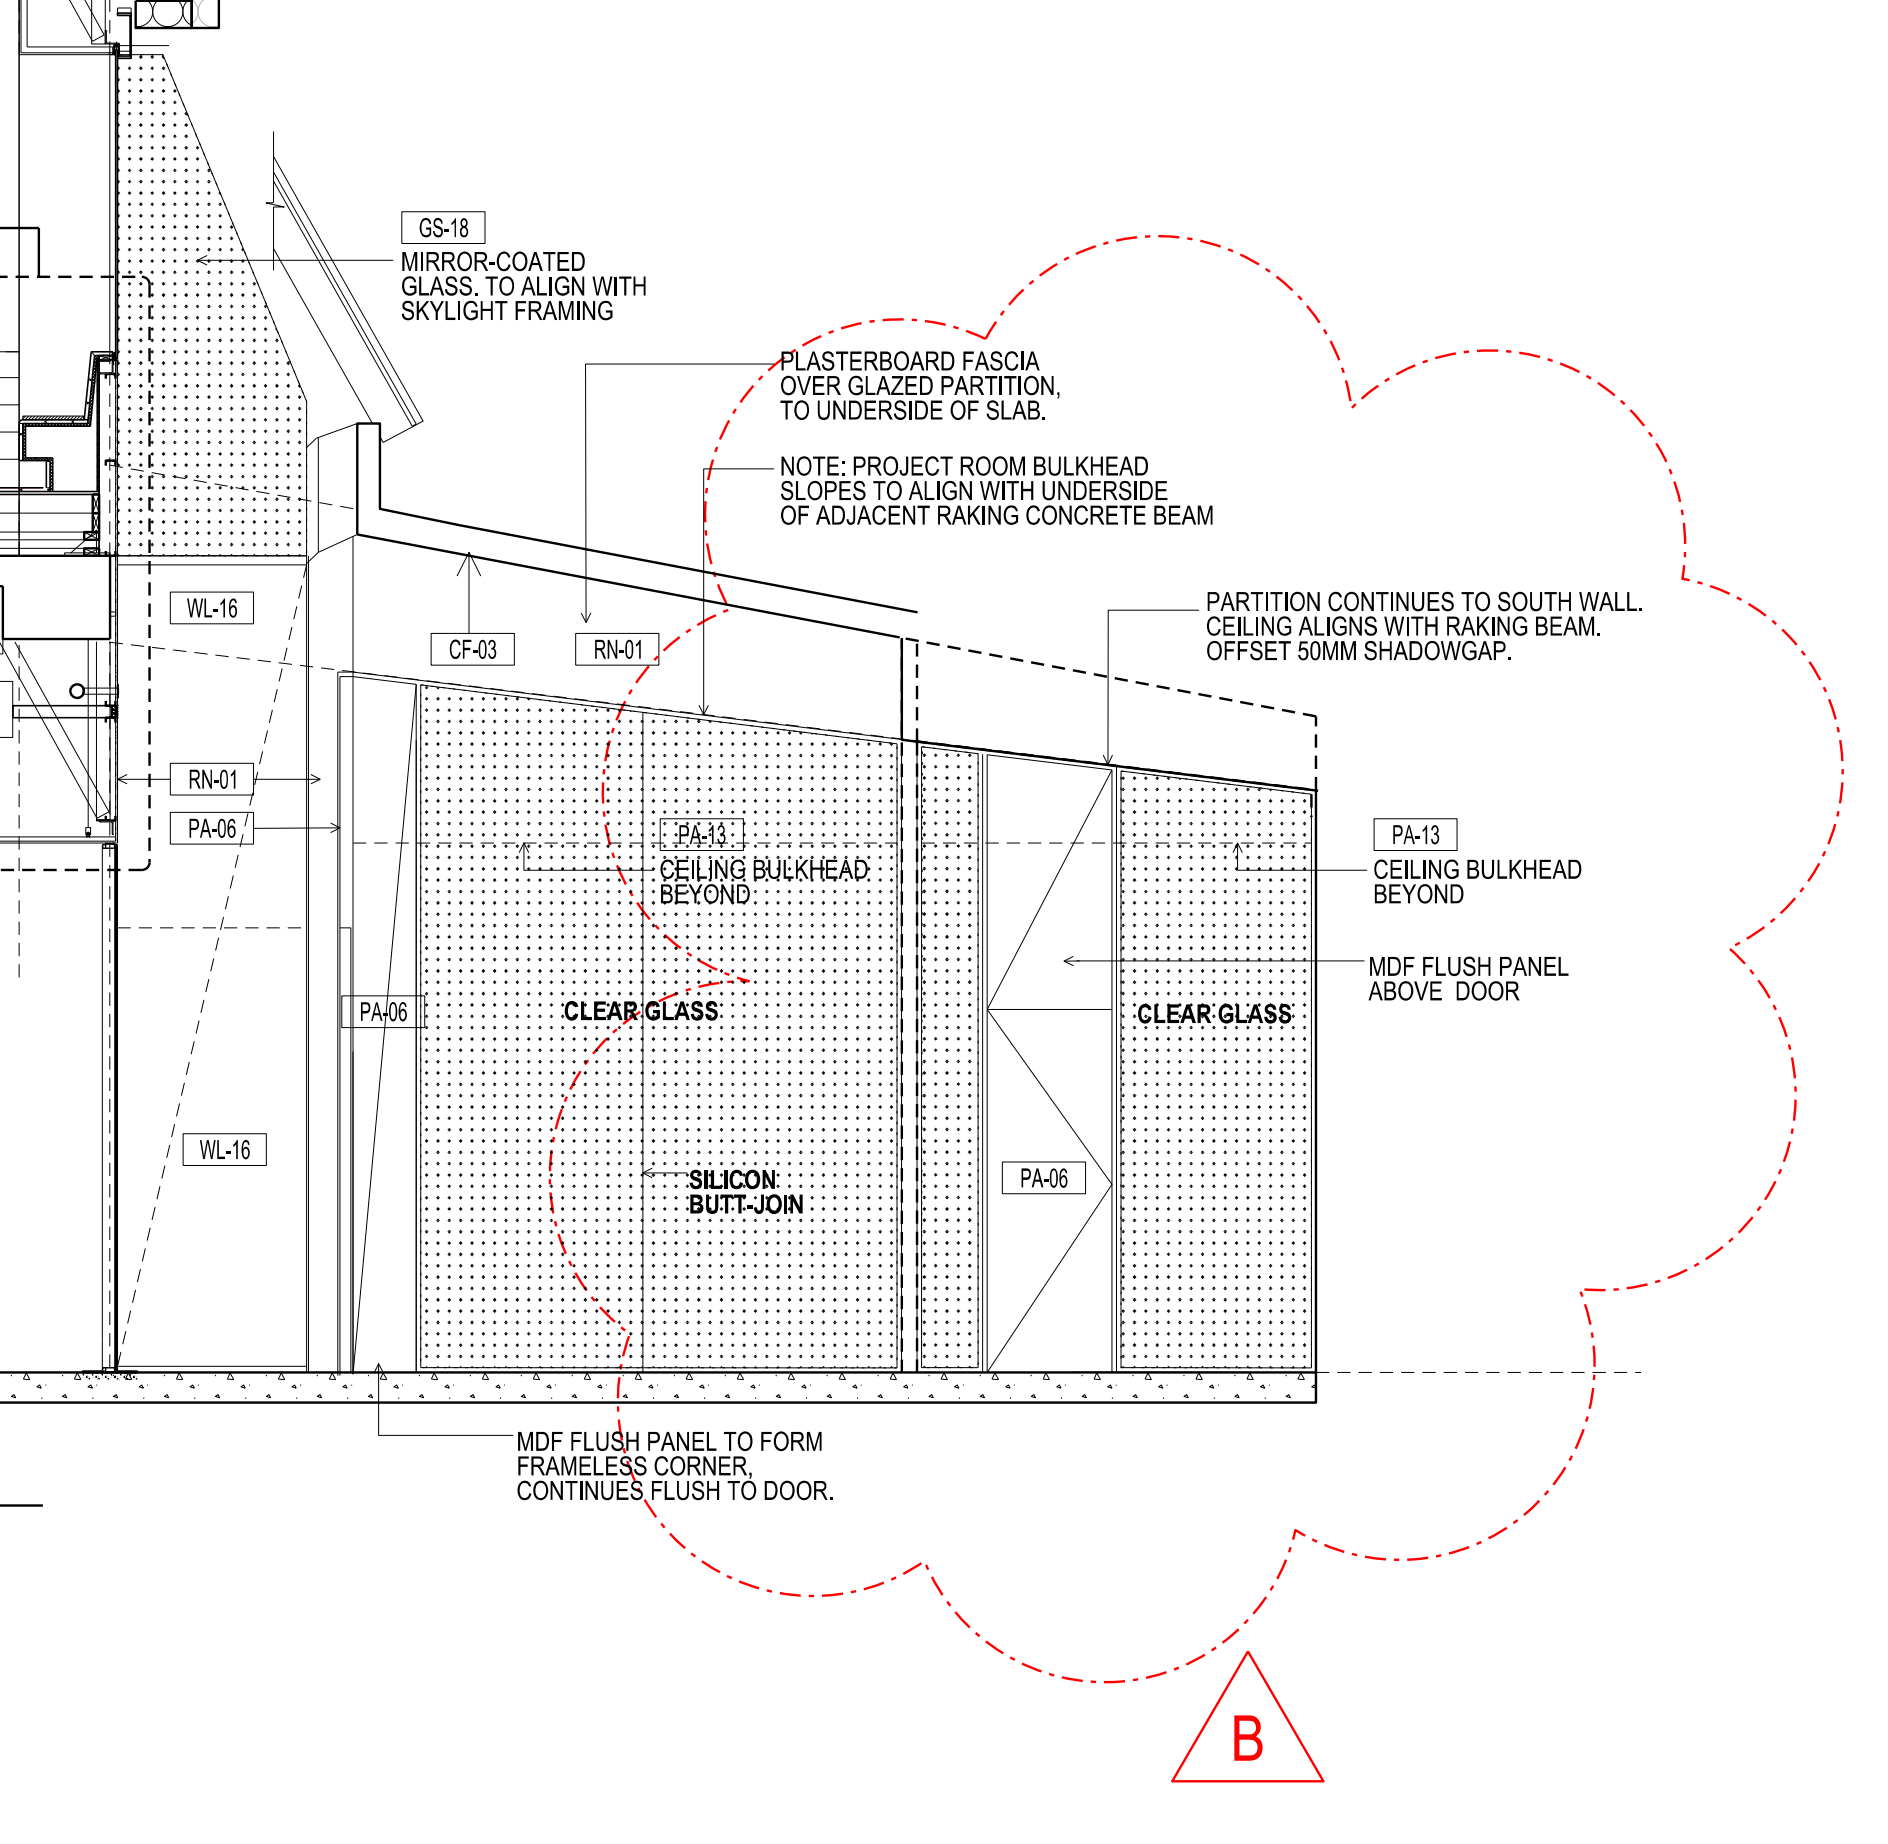
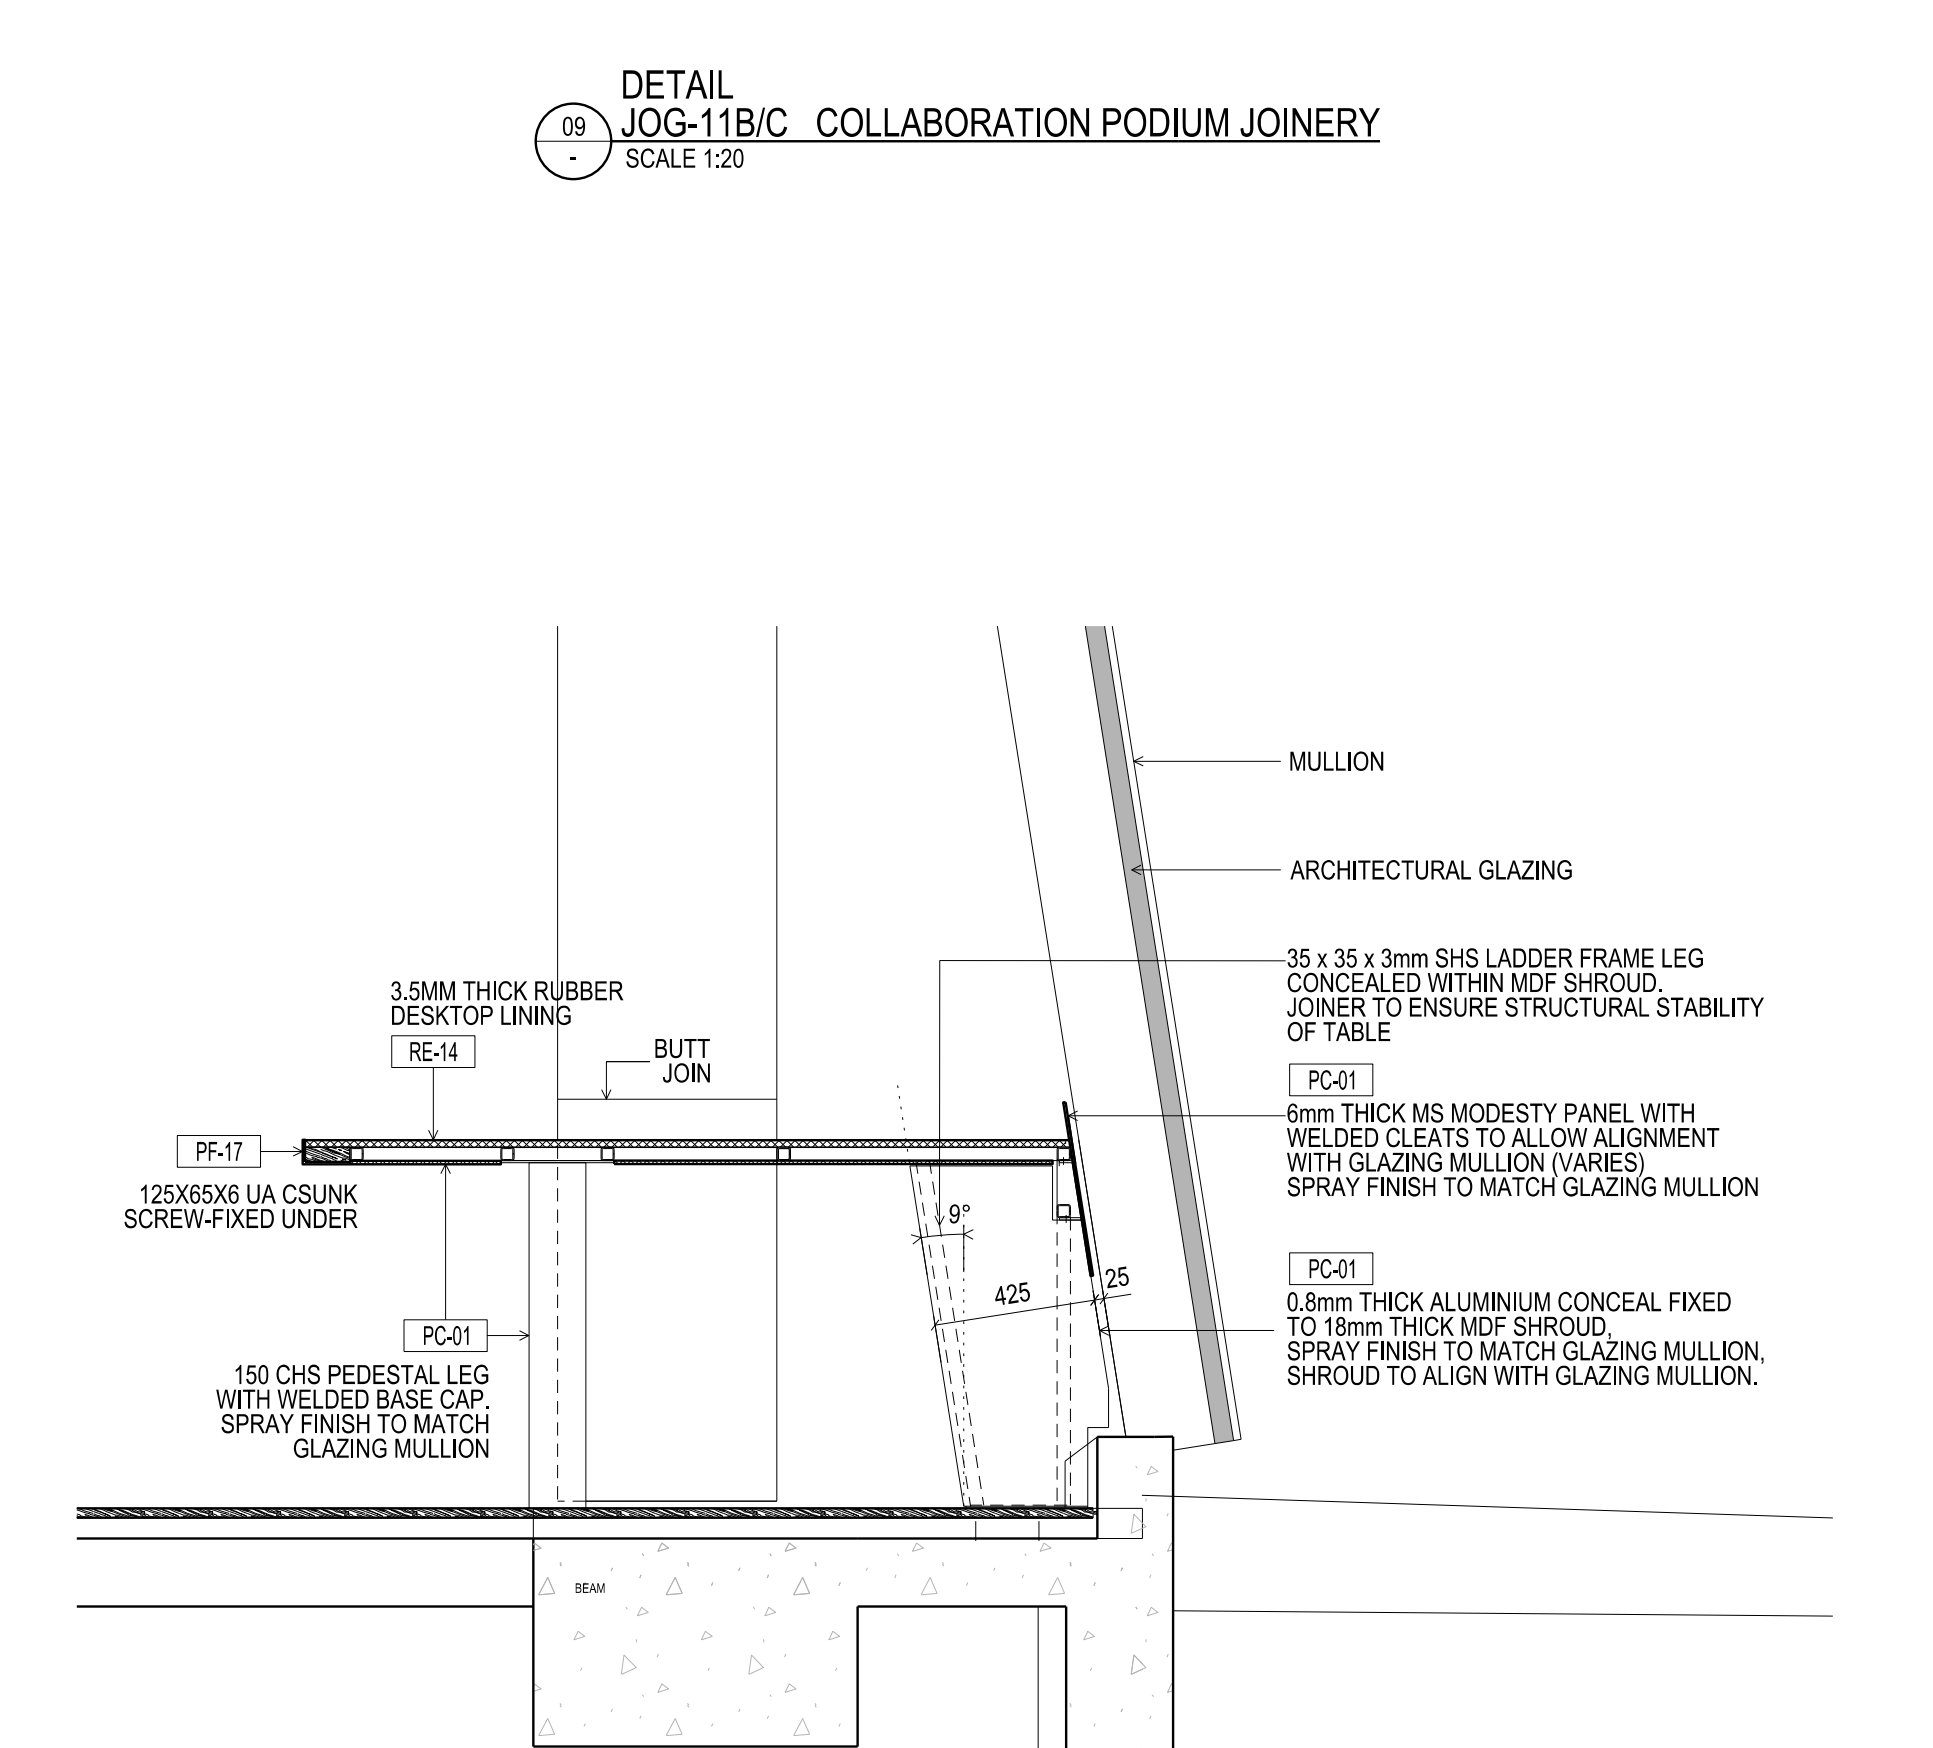
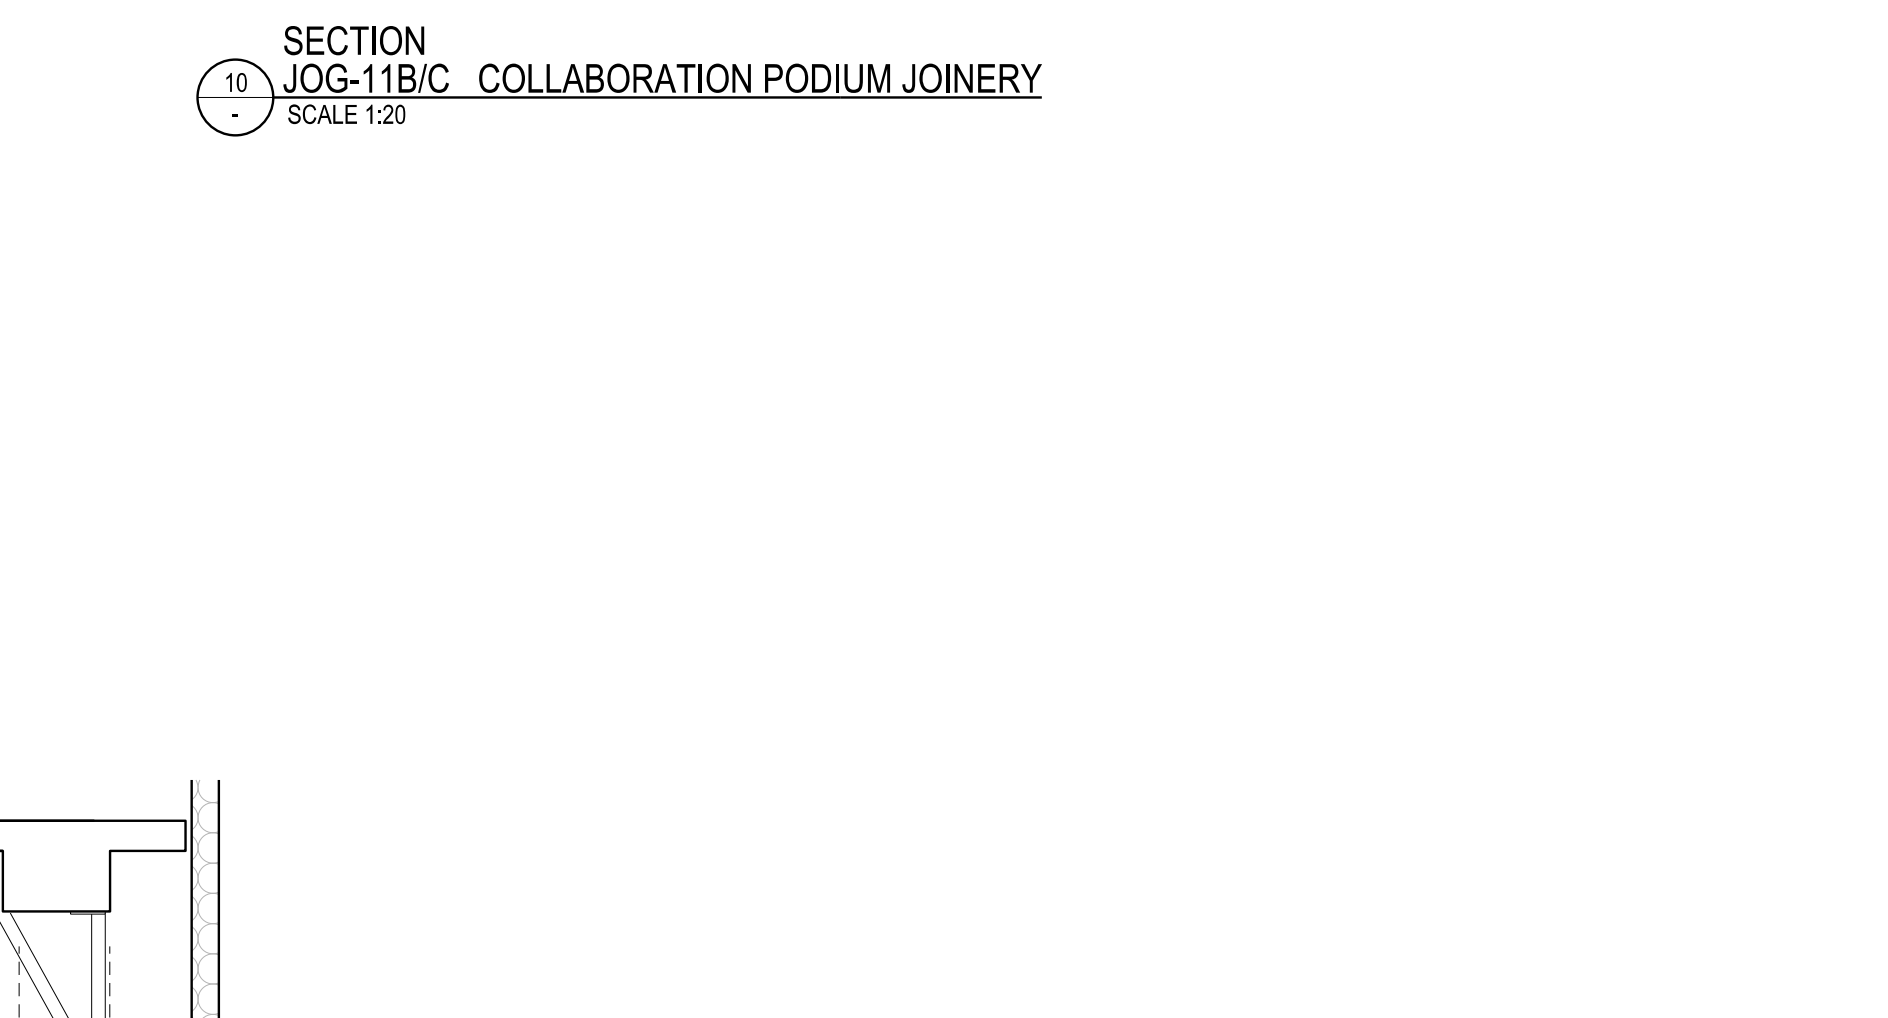
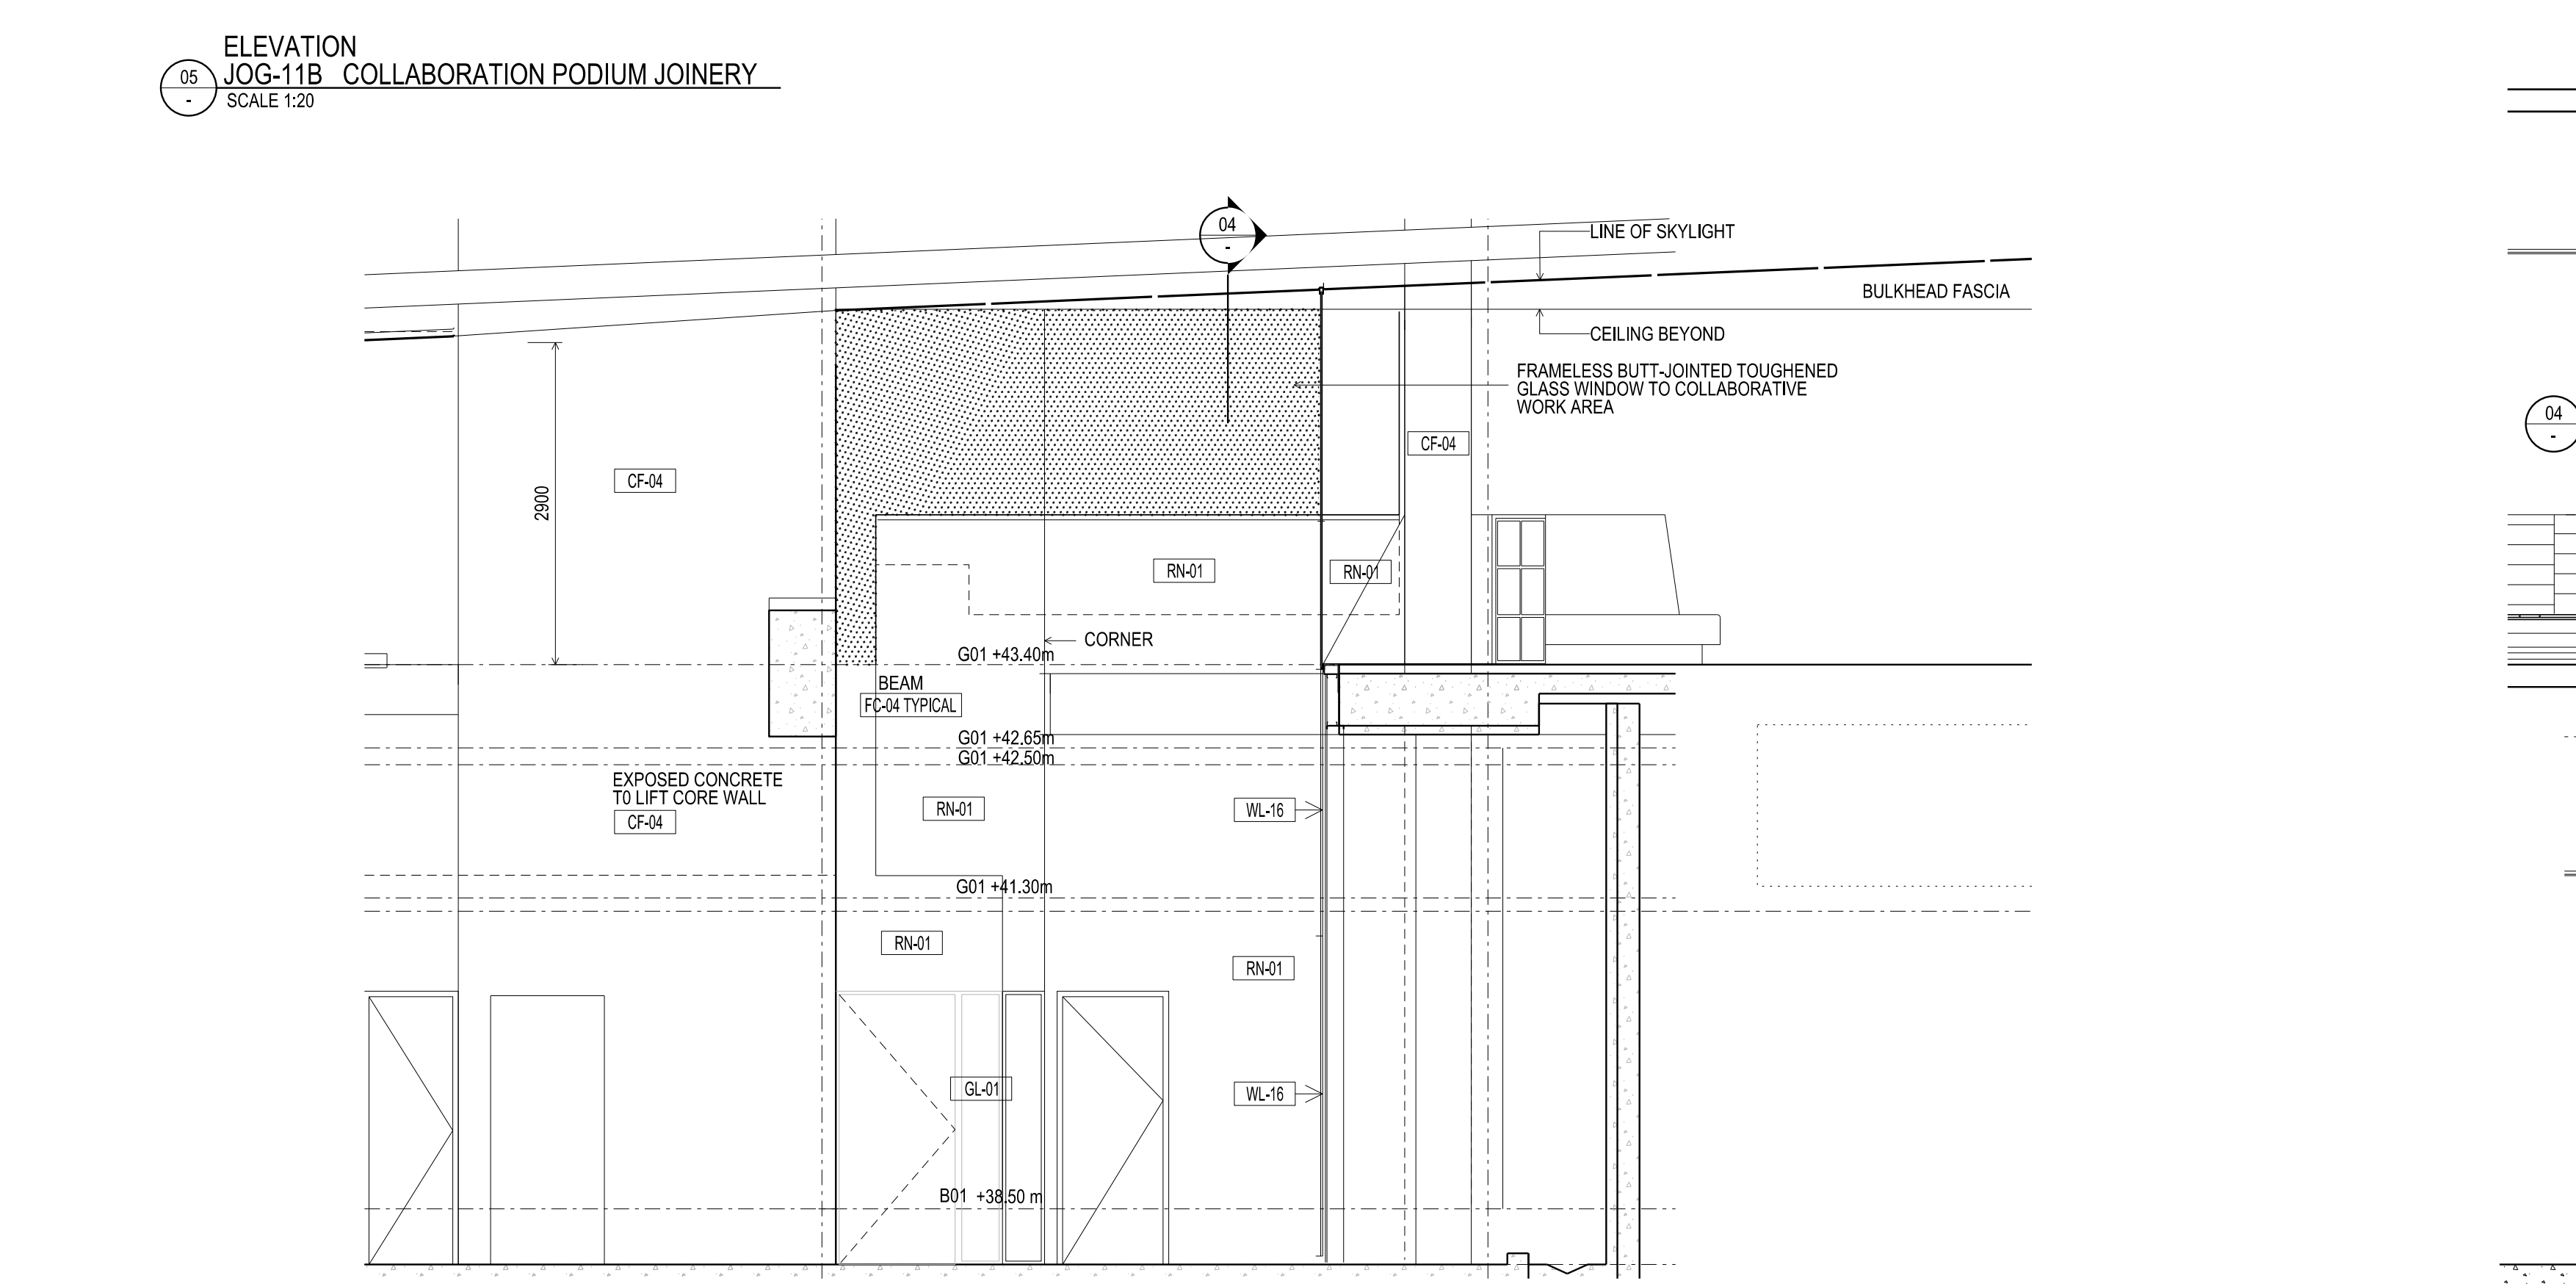
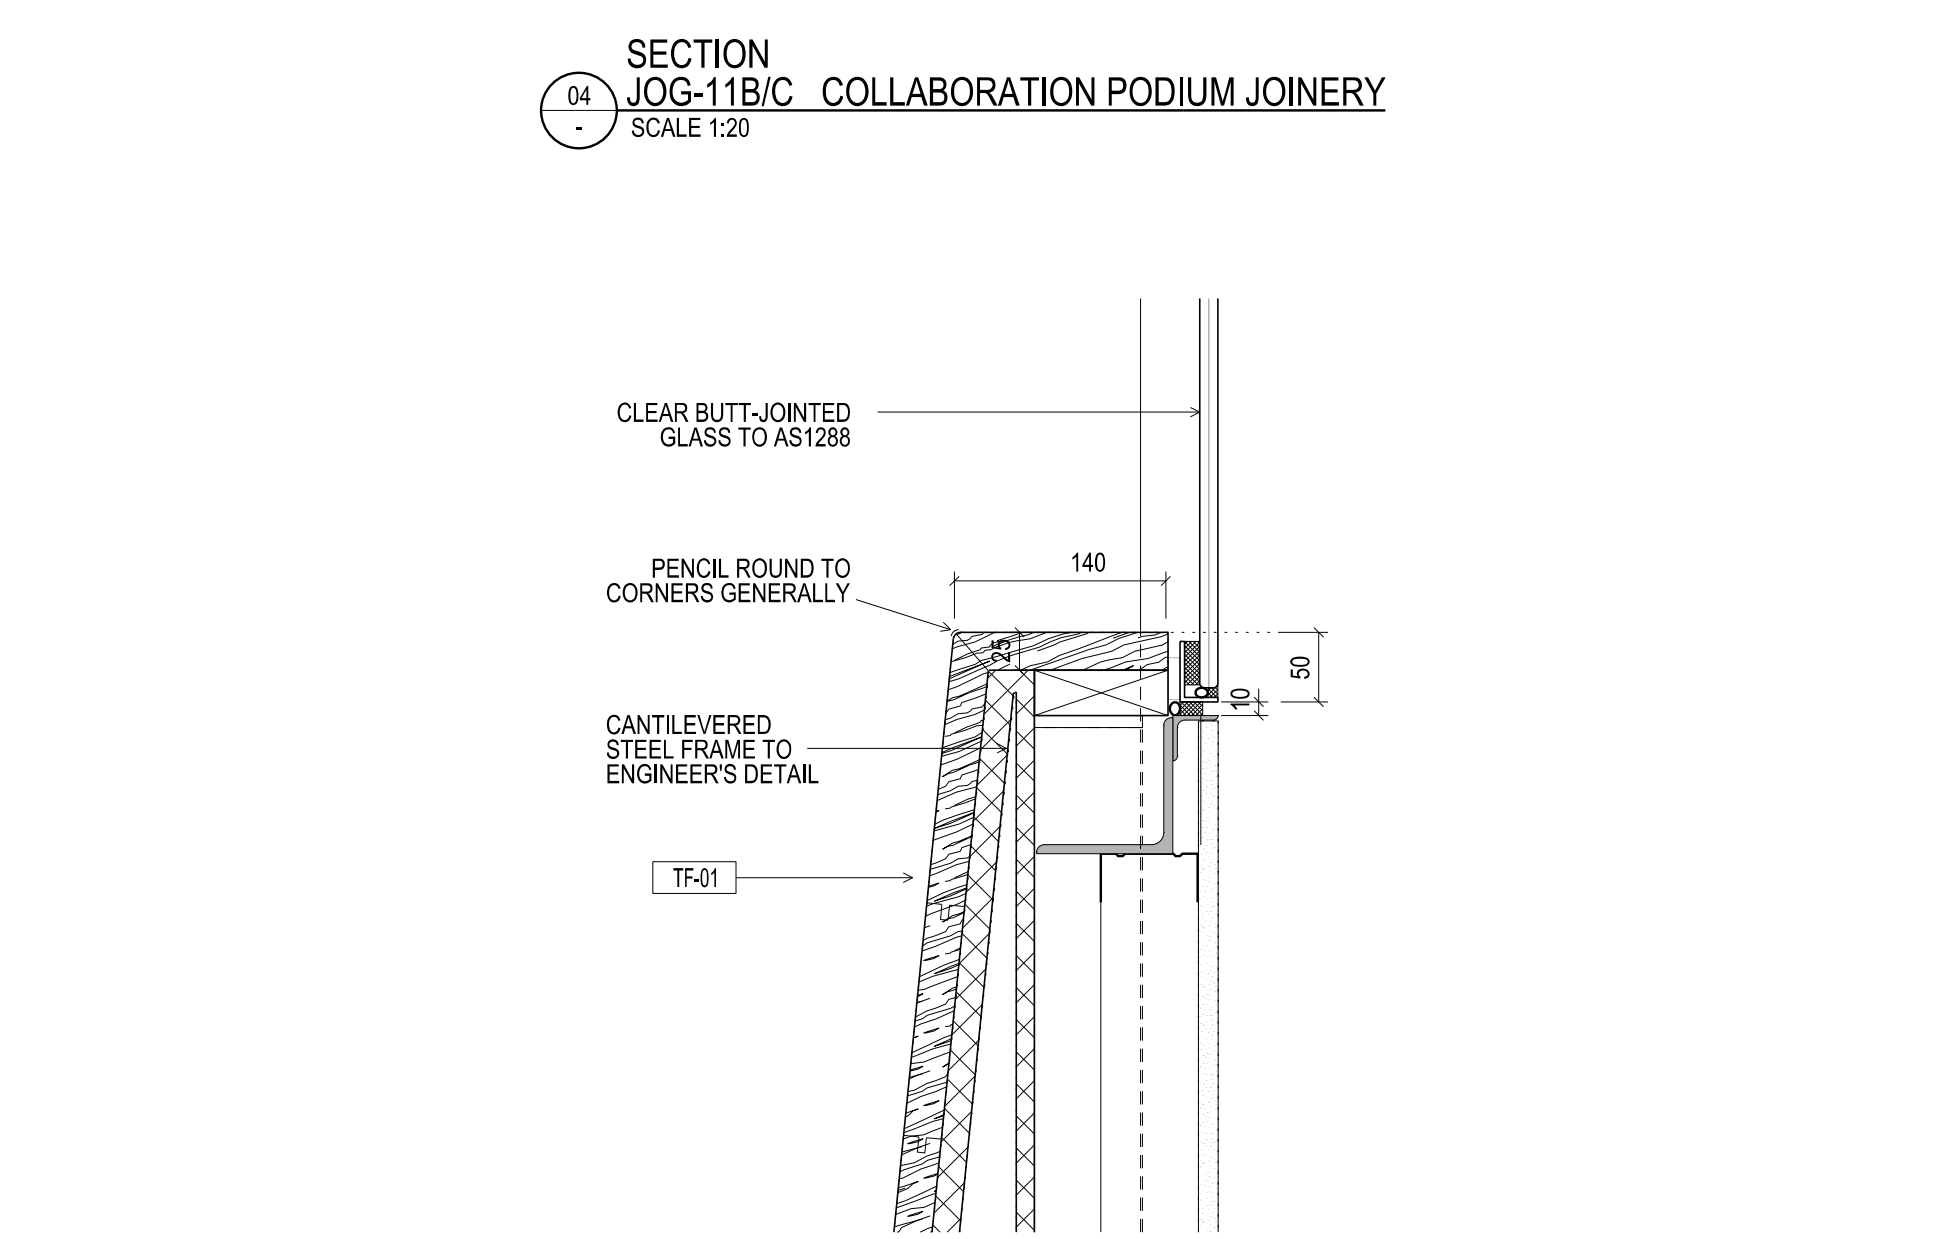
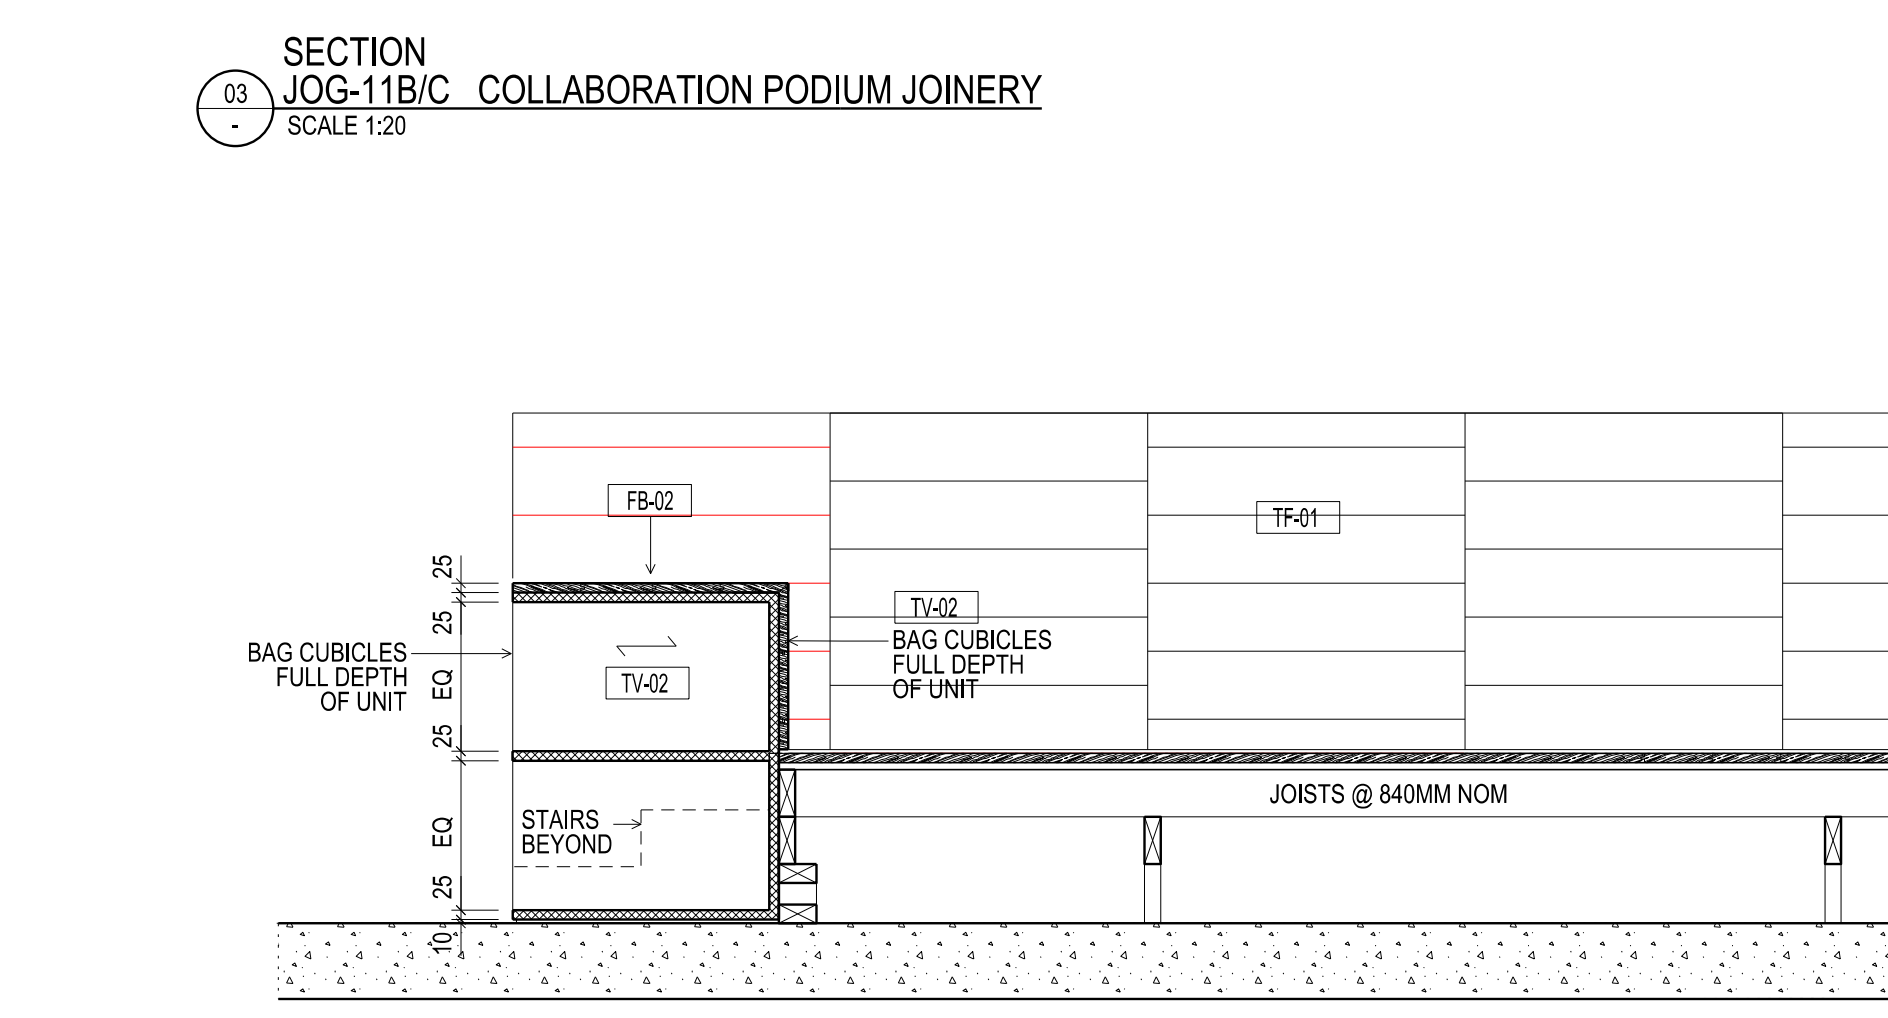
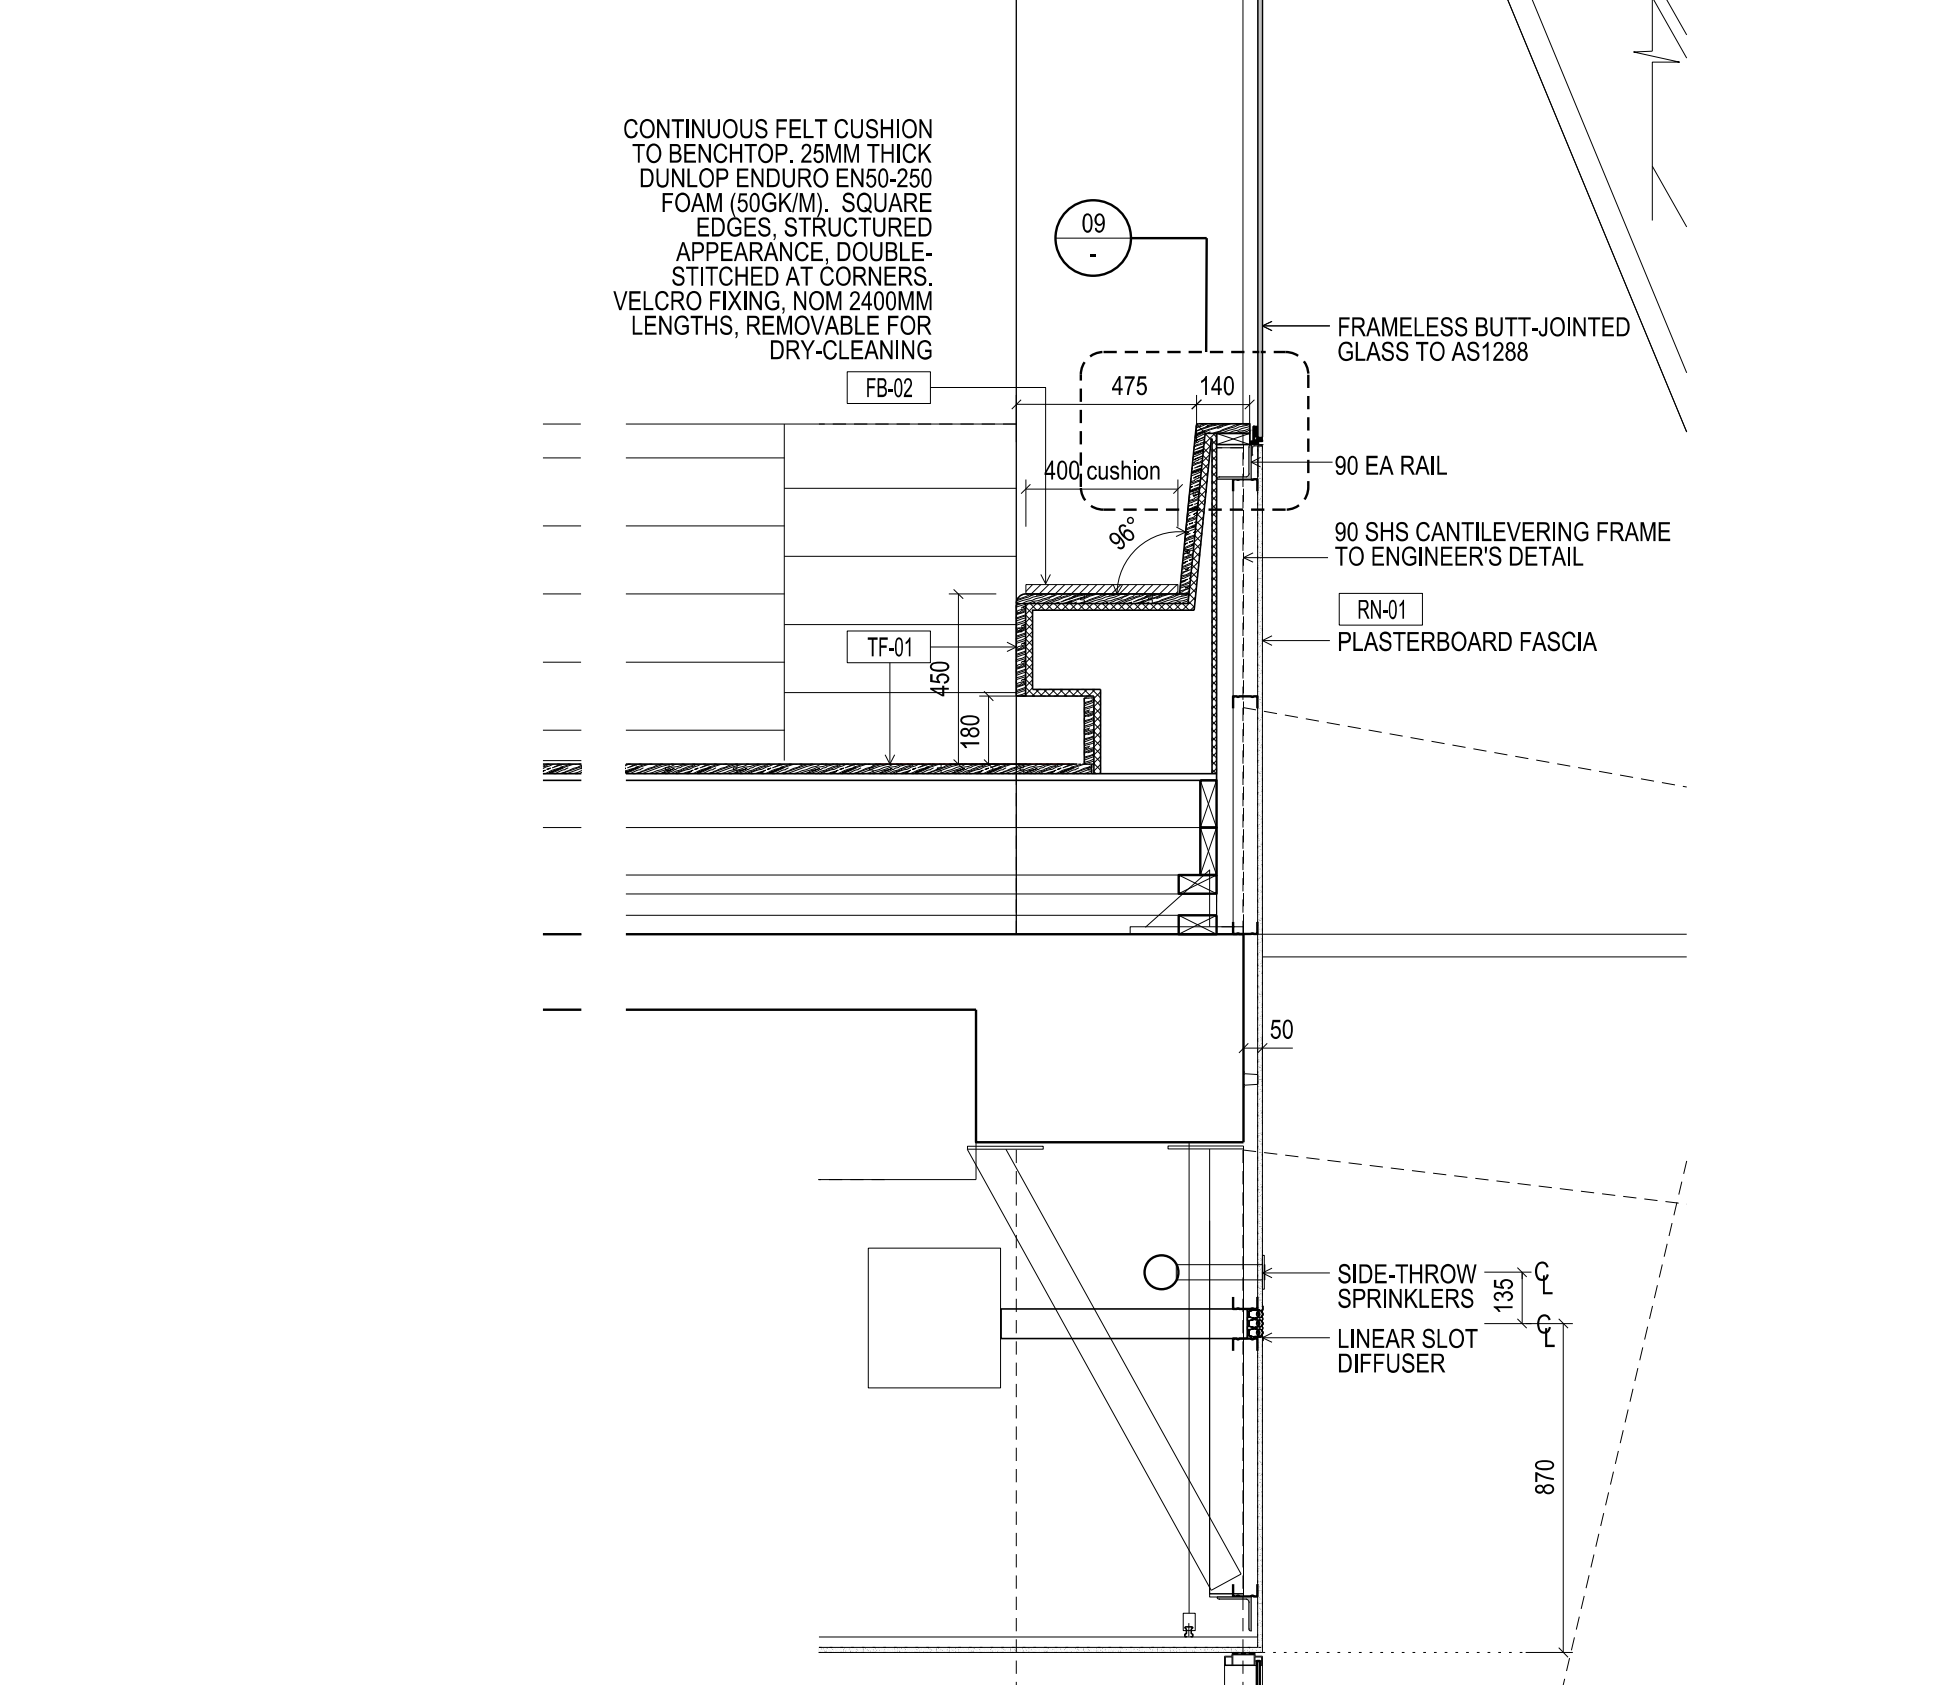
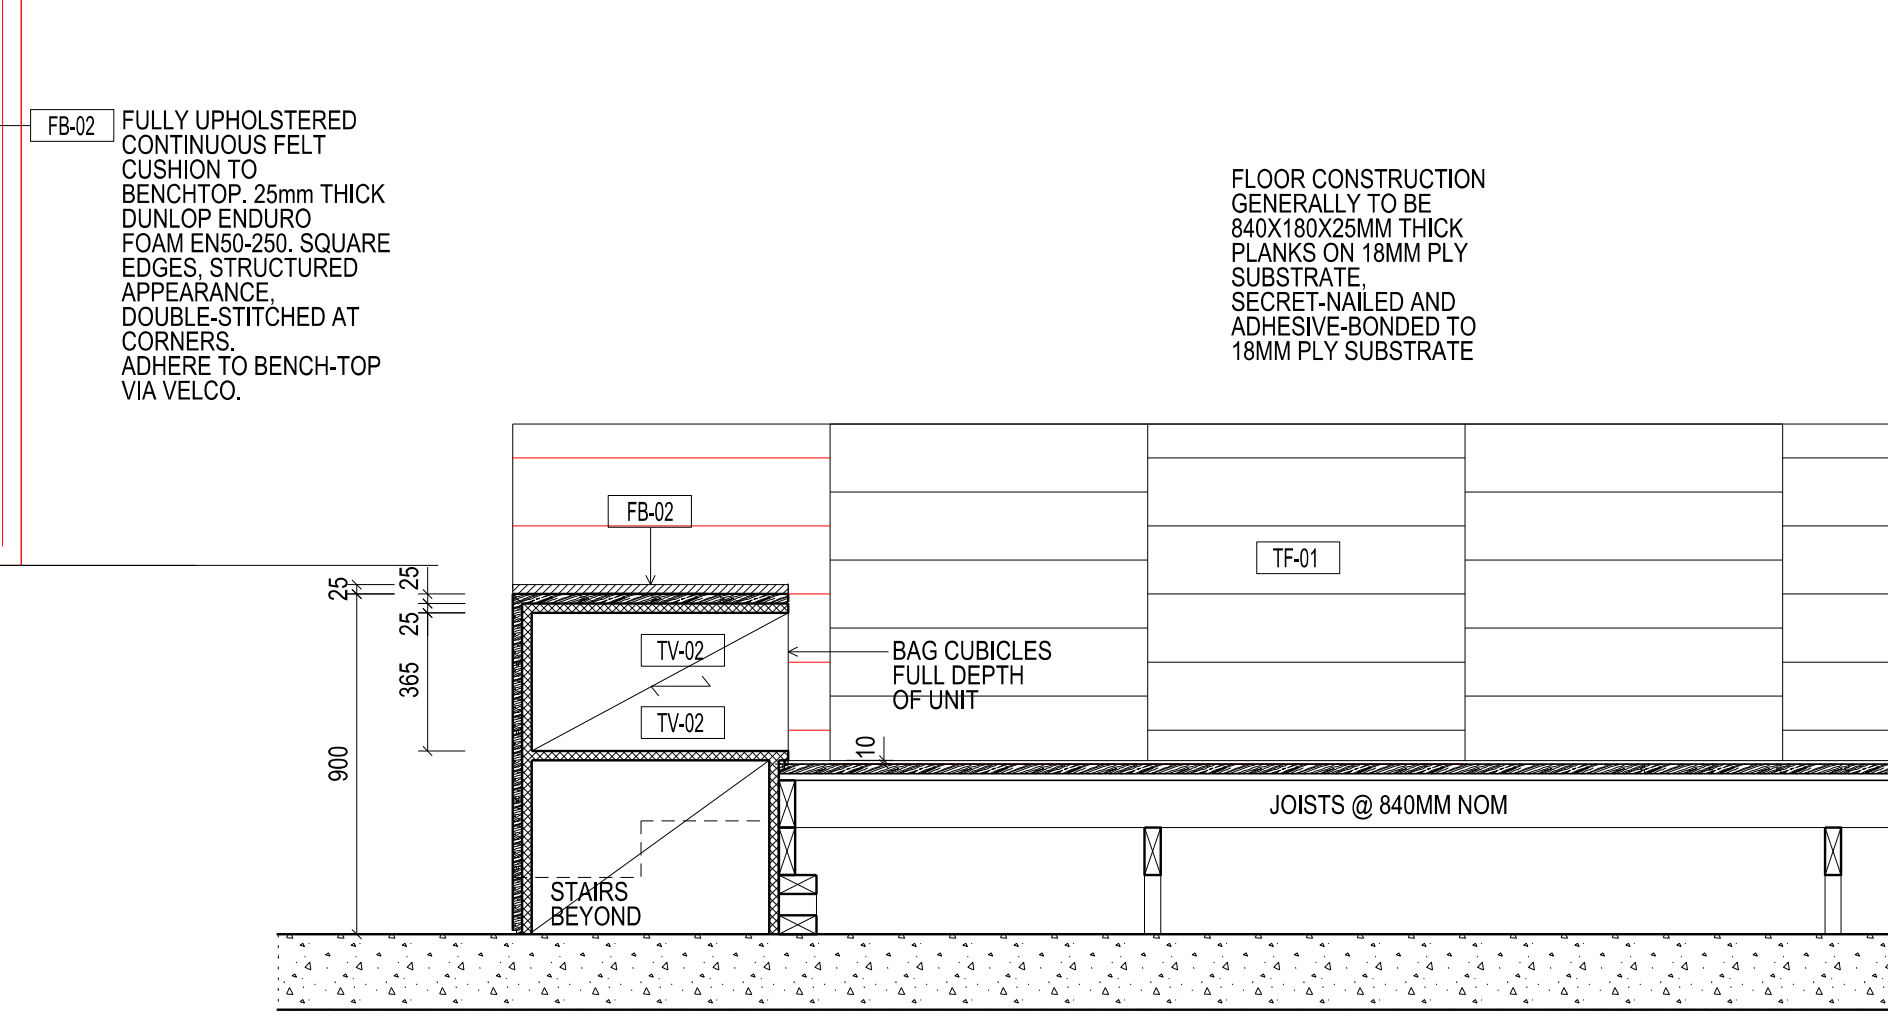
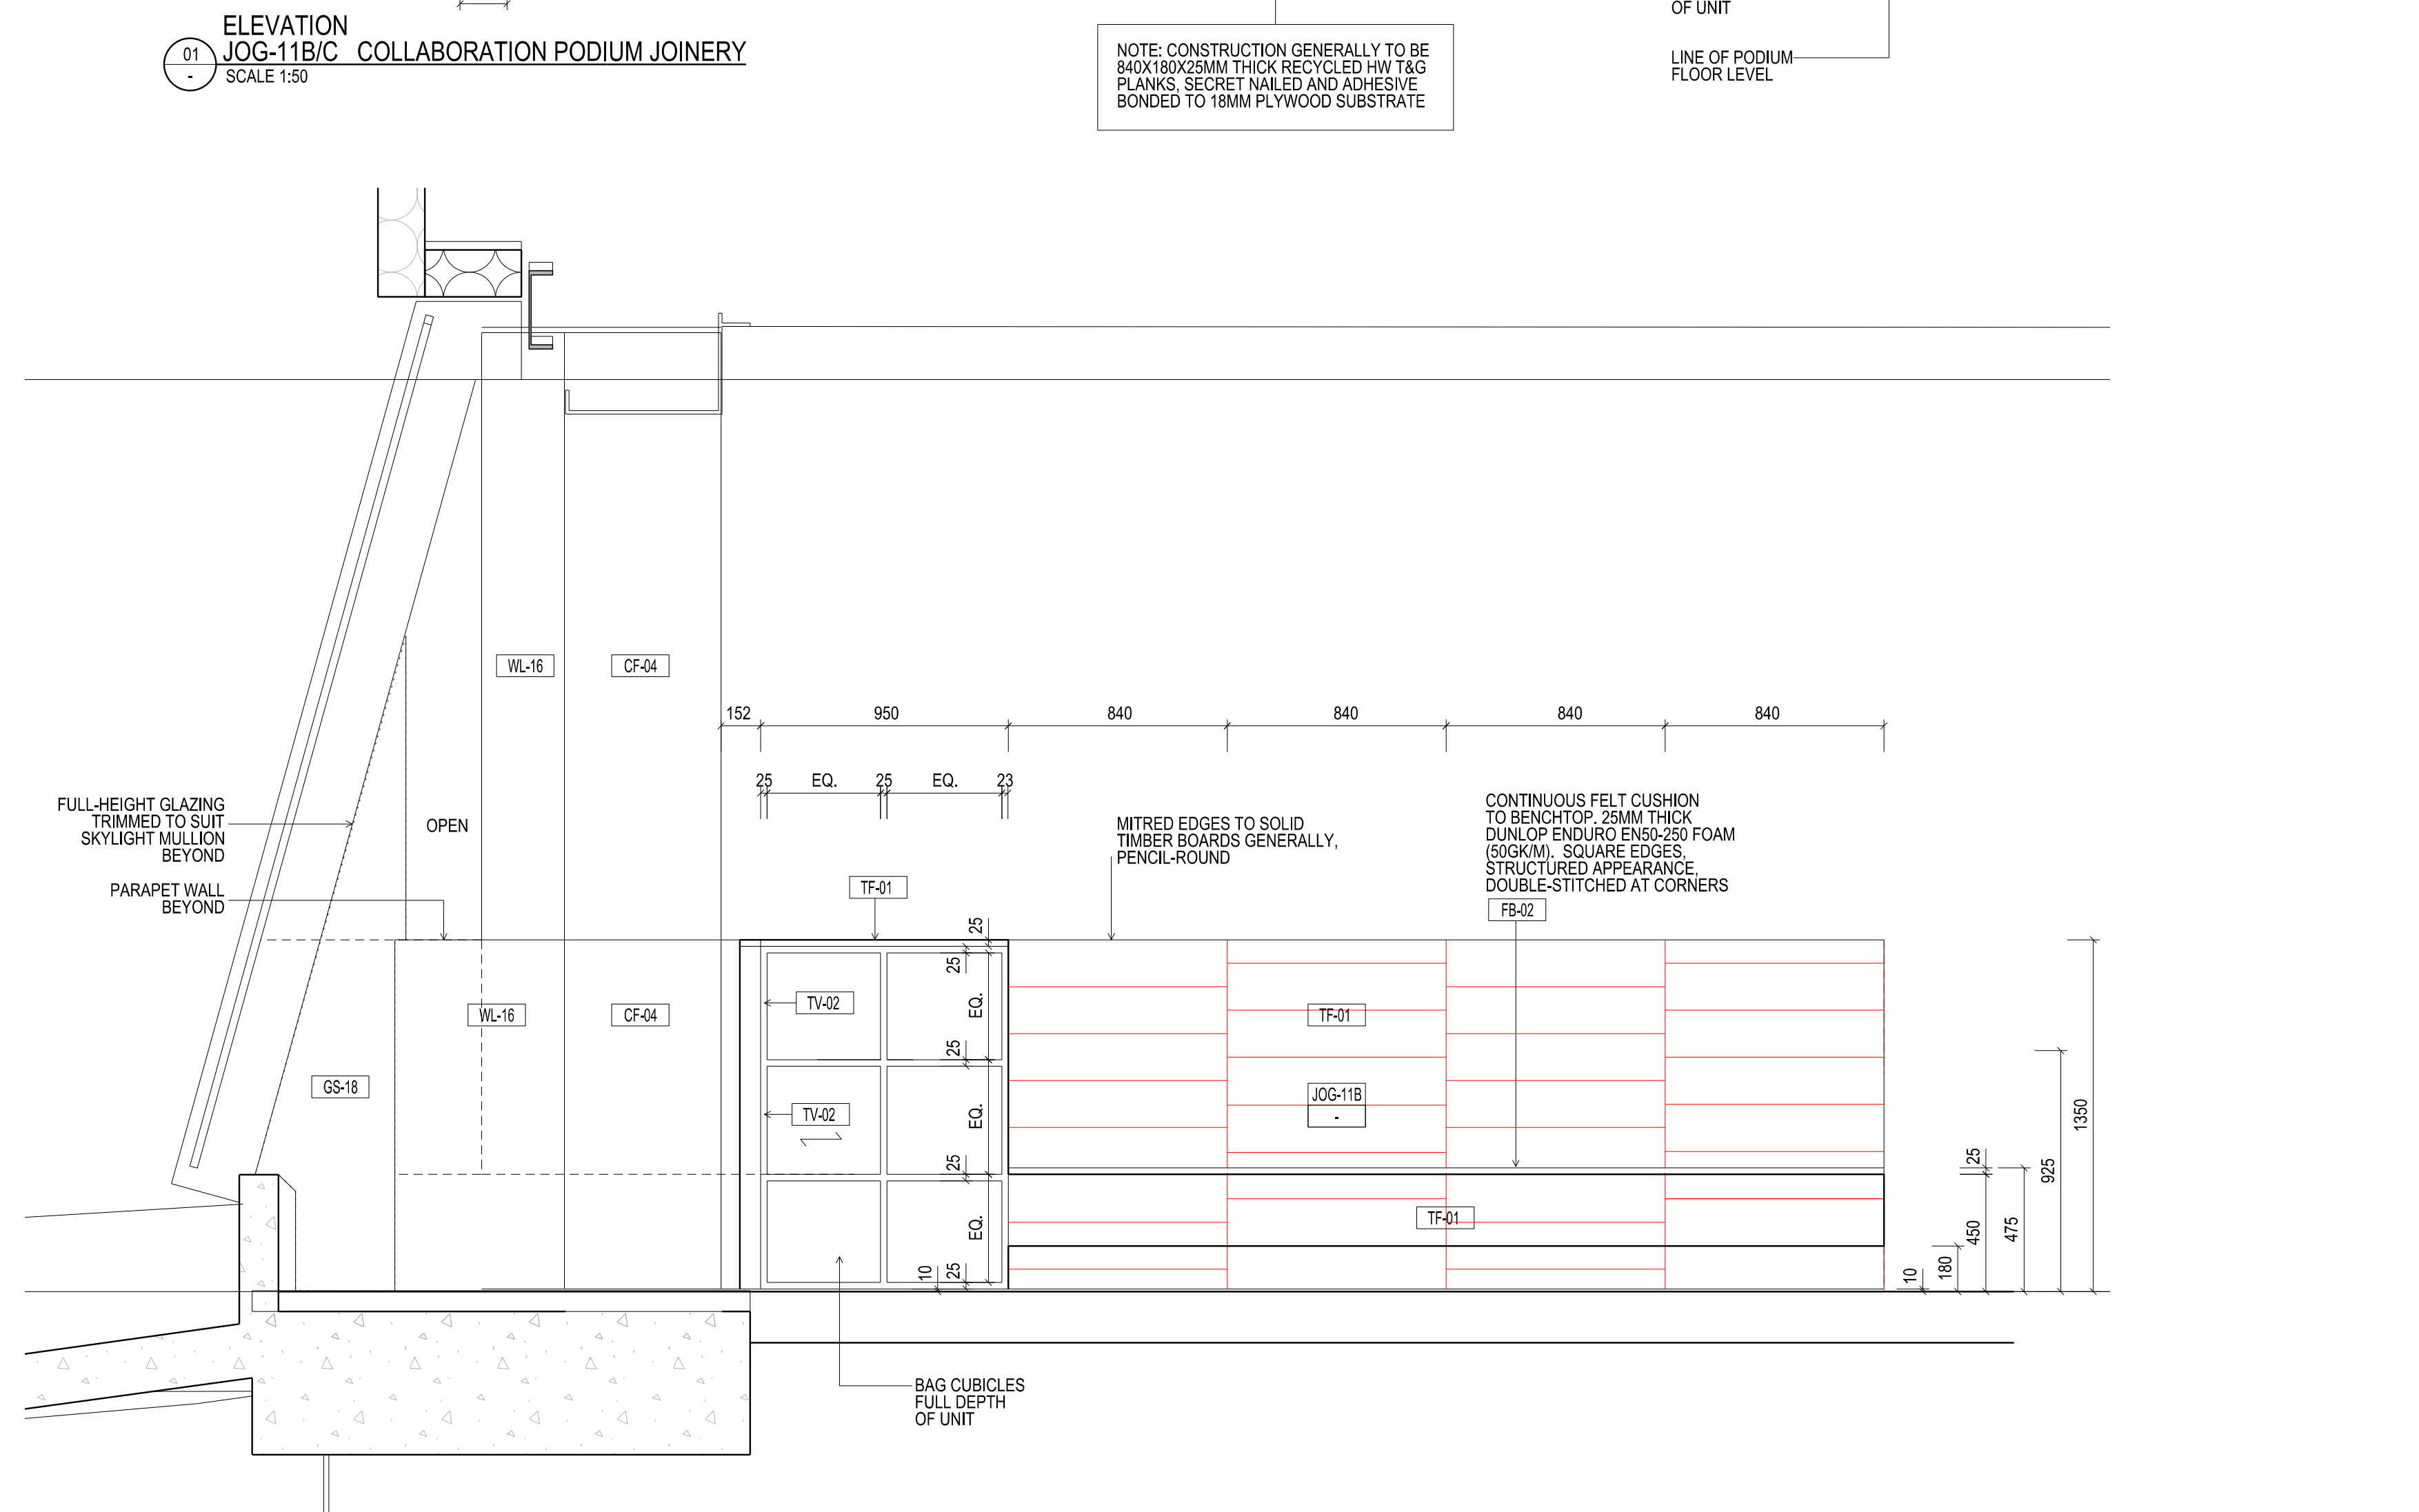


CONTRACTORS SHALL VERIFY JOB DIMENSIONS BEFORE ANY JOB COMMENCES. ALL SHOP DRAWINGS SHALL BE SUBMITTED TO THE SUPERINTENDENT AND MANUFACTURE SHALL NOT COMMENCE PRIOR TO THE RETURN OF QUANTIFIED SHOP DRAWINGS. THE CONTRACTOR SHALL BE RESPONSIBLE FOR THE PRELIMINARY OVERSIGHT. THE DRAWING SHOULD BE READ IN CONJUNCTION WITH ALL RELEVANT CONTRACT SPECIFICATIONS AND DRAWING COPYRIGHT OF THIS DRAWING IS VESTED IN WARDLE.

General Notes

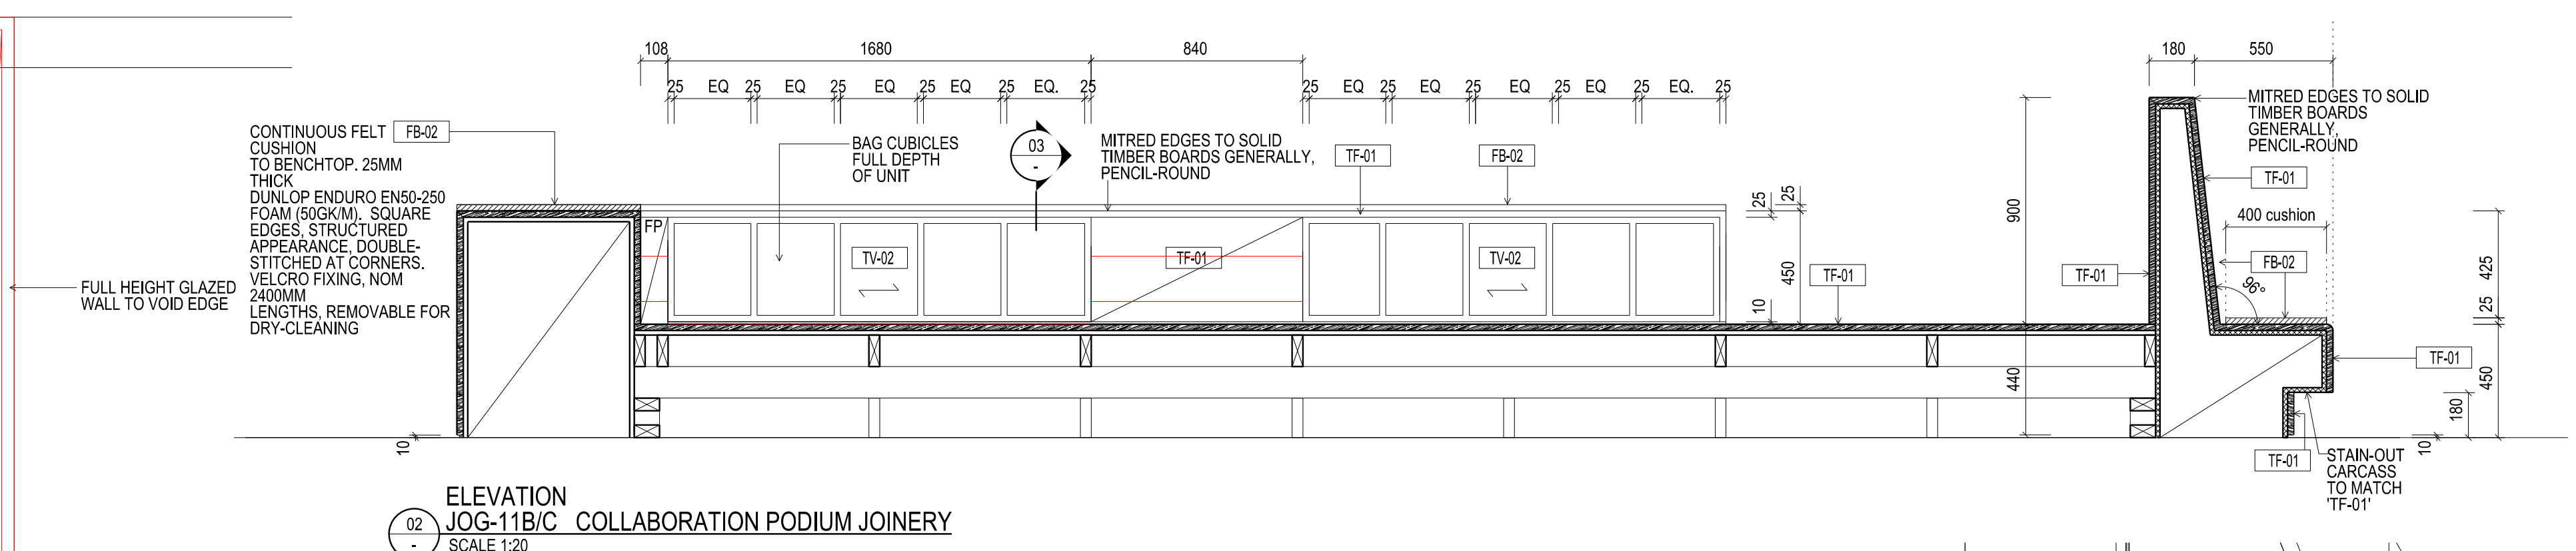

Rev	Issue	Revision Description	Amd	Date
B	JA	PROJECT ROOM GLAZING AMENDED		20.02.14
A	JA	SEAT DIM ADJ. DELETE CUSHION BACK		20.12.13
05	SG	VALUE MANAGEMENT ISSUE		28.03.13
04	SG	100% CD - TENDER ISSUE - UPDATE		12.09.12
03	SG	100% CD - TENDER ISSUE		07.09.12
02	SG	75% CD ISSUE		13.07.12
01	SG	25% CD ISSUE		20.04.12

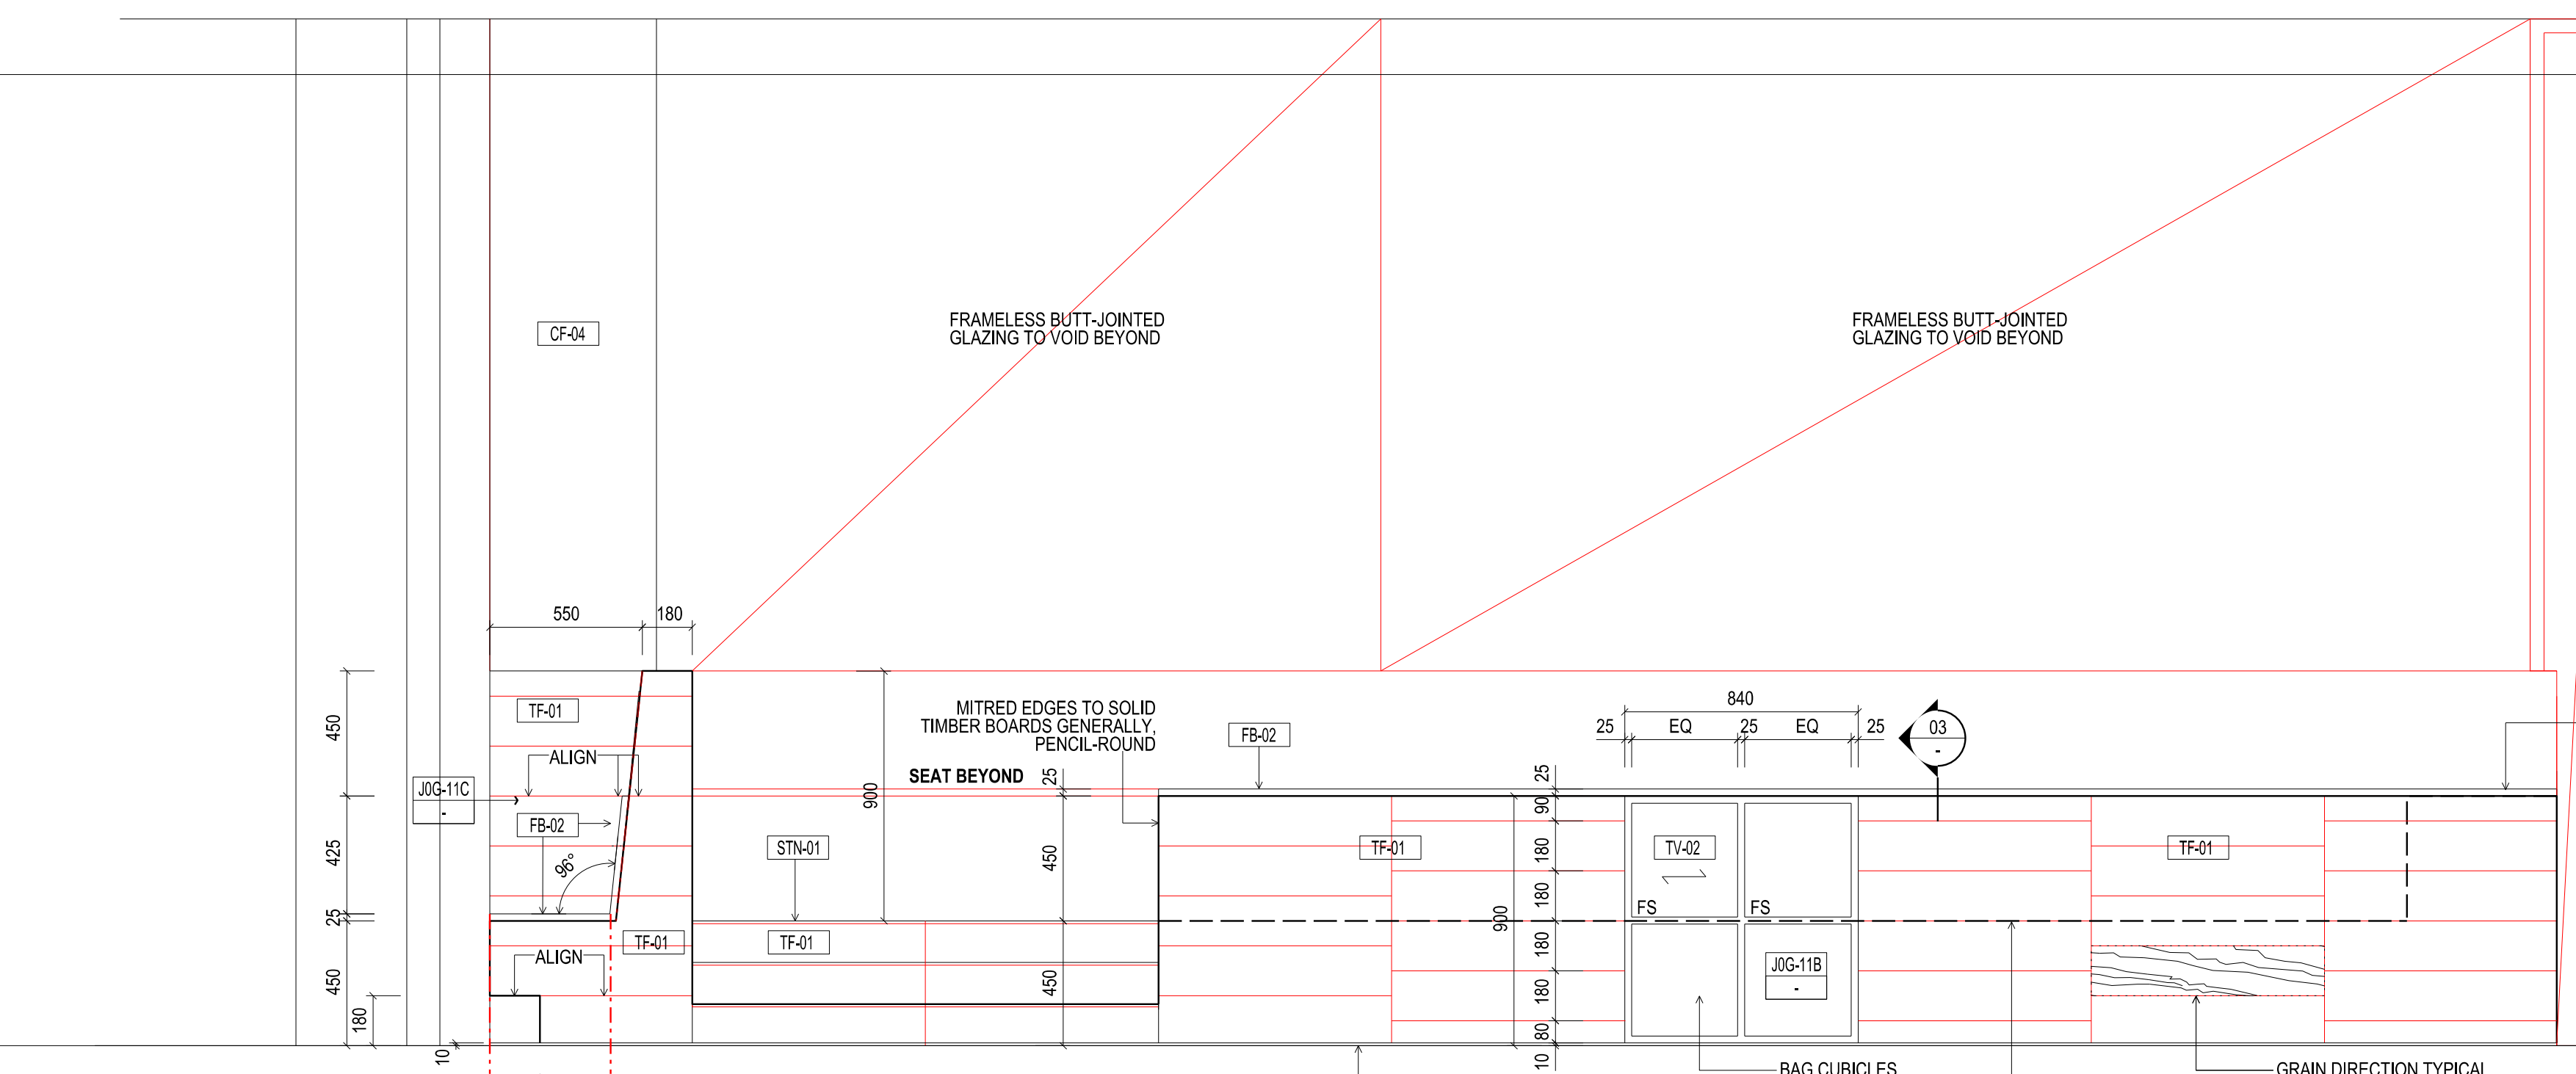

Client: University of Melbourne
Parkville Campus

Project: Faculty of Architecture
Building and Planning

Title: JOINERY DETAILS

Project No.	0913	Scale	1:20 @ A0 1:40 @ A2
Drawing No.	AR8163	Revision	B
Date	Dec 2011	Dwn	
Co-Ord		Chk	

FOR CONSTRUCTION